

**City of Oakley**  
**ADDENDUM NO. 4 to contract documents for**  
**CIP 255 – Cypress Grove Pump Station Project**

**BID OPENING DATE: December 1, 2022 2:00 PM**

Notice is hereby given that the following clarifications and revisions are made to the above referenced contract documents:

**Updates to the Plans and Specifications:**

This Addendum address questions that were asked at the last on-site meeting on 11-8-22 and emails received from contractors.

Attached

- 1) Response to questions from Pace Water
- 2) Cypress Grove Pump Station As-Builts

All bidders shall acknowledge receipt and acceptance of Addendum No. 4 by signing in the space provided at the end of this Addendum and submitting the signed addendum with their proposal.



Jason Kabalin  
Capital Projects Engineer  
November 16, 2022

\_\_\_\_\_  
Contractor Signature

\_\_\_\_\_  
Date

\_\_\_\_\_  
Company Name



November 15, 2022,

Jason Kabalin  
City of Oakley

Re: **Comments on the Rebid Addendum**

#8138E

Dear Jason,

**Pacific Advanced Civil Engineering, Inc. (PACE)** is pleased to provide the following responses to the Cypress Grove Storm Water Pump Station Upgrades comments received from the various contractors bidding on the project. The responses from PACE are as follows:

### **BLOCKA CONSTRUCTION**

1. Drawing A2.1 Keynote 15.6 calls for a roof top exhaust what spec and/or schedule to follow for this?

***PACE RESPONSE: The roof exhaust is a typical mushroom style roof vent that attaches to an 8 inch vent pipe. The generator exhaust and vent is currently existing. Contractor shall ensure the exhaust pipe and vent is properly sealed and replace if required.***

2. Drawing A2.1 cites detail 9/A3.1 where the MAXX AIR 36-IN Exhaust fans are to be installed. Detail 9/A3.1 is a detail for installing metal wall louvers at CMU wall. MAXX AIR 36-IN Exhaust Fans installation will not allow louvers to be installed as shown in detail 9/A3.1. Please clarify if louvers are necessary where the MAXX AIR 36-IN Exhaust Fans are to be installed.

***PACE RESPONSE: The 36" maxx air fan has an integrated shutter and no louver is required. There is a typical blockout in the masonry wall needed for the fan in these locations. Please refer to the manufacturer's installation instructions for further details***

### **VALENTINE CORPORATION**

1. Specification 46000 – Irrigation and Lake Recirculation Prefabricated Pumping Skid System

- a. This specification is listed in the TOC, but it is not included in the current specifications. Please provide this specification
- b. Where is this skid shown on the plans?

***PACE RESPONSE: There is no irrigation pump skid on the project and this should be removed from the table of contents***

2. Plan Sheet G2 – Furnish 12 each air diffusers

- a. Is there a specification and proposed manufacturer of the pond diffusers here?
- b. Do we just furnish them here, but do not install them?

***PACE RESPONSE: The air diffuser specs are listed in the equipment list on sheet M0.1, these diffusers are in the lake. They are existing and need to be replaced along with the weighted aeration hoses. Please see the lake as built for locations of the existing aeration piping and junction boxes. 1500 LF should be sufficient for the weighted hose.***

3. Plan Sheet M0.1, Mechanical Equipment List

- a. WELLMATE Pressure Tank x 264 Gallon – quantity = 2
  - i. I only see one new pressure tank on plan Sheet M1?

**PACE RESPONSE: There is only quantity one (1) pressure tank, this was a typo**

- b. Kasco Air Diffuser – quantity = 12 each
  - i. Where is this work shown on the plan set?

**PACE RESPONSE: The air diffuser specs are listed in the equipment list on sheet M0.1, these diffusers are in the lake. They are existing and need to be replaced along with the weighted aeration hoses. Please see the lake as built for locations of the existing aeration piping and junction boxes. 1500 LF should be sufficient for the weighted hose.**

- c. Exhaust Vent Fan – quantity = 2 each
  - i. I see one each 36” shown on the architectural plans (at wall louver), but fan is not shown on mechanical plans & any mounting details – Where is the second one?
  - ii. I see 1 each roof mounted fan, but it is not called out on the mechanical equipment list.
  - iii. Can a detail for the roof fan be provided?

**PACE RESPONSE: There are 2 wall mounted fans on the north wall. There is no roof mounted fan, this was removed on a previous revision. All references should be removed.**

4. Plan Sheet M1
  - i. Do you have a detail for Note 6 – New thermal venting with mushroom cap?

**PACE RESPONSE: The roof exhaust is a typical mushroom style roof vent that attaches to an 8 inch vent pipe. The generator exhaust and vent is currently existing. Contractor shall ensure the exhaust pipe and vent is properly sealed and replace if required.**

5. Plan Sheet C1 – 6” thick exterior sidewalk is shown as 4” wide. I am assuming this should be 4’ wide?

**PACE RESPONSE: The side walk should be 4’ (feet) , not inches, this was a typo.**

#### **CAIRO BUILDER**

1. The main contract docs only call for a 1-year warranty. Where we run into some issues, however, is in Specs Part III which are the Technical Specs for this job.

This is the big one, at 417 pages, so I simply searched by keyword of “warranty” and at first things were looking good. But then I hit page 179, which is the section for Sheet Metal Roofing, and saw that they are requiring a 5yr warranty. And then on page 197, the specs call for a 10 year warranty on the Sectional Door.

My initial thought was that these might just be poorly written specs and that these were intended to be manufacturer warranties, however as I continued to go through the specs I saw that they were actually very diligent in specifying when the warranties were meant for the manufacturer (see pages 212, 244, 364, 384, 396, 402, 407, and 413). That leaves us no choice but to

interpret the lack of specificity on the Roofing & Door warranties to mean that it applies directly to Cairo, and unfortunately those are both well beyond what we'd be able to support.

***PACE RESPONSE: The 10-year warranty for the sectional door is referring to the paint finish. This warranty shall be provided by the MANUFACTURE. The sheet metal roofing shall be backed by a MANUFACTURE warranty against degradation of metal finish for a minimum of five (5) years. The contractor shall warrant against defective workmanship for a minimum of one (1) year.***

**Jason Ezell**


*Design Engineer*

**D (714) 481-1776 C (714) 514-8813**

**E [jezell@pacewater.com](mailto:jezell@pacewater.com)**



# CYPRESS GROVE LAKE & STORM WATER PUMP STATION CONSTRUCTION PLANS

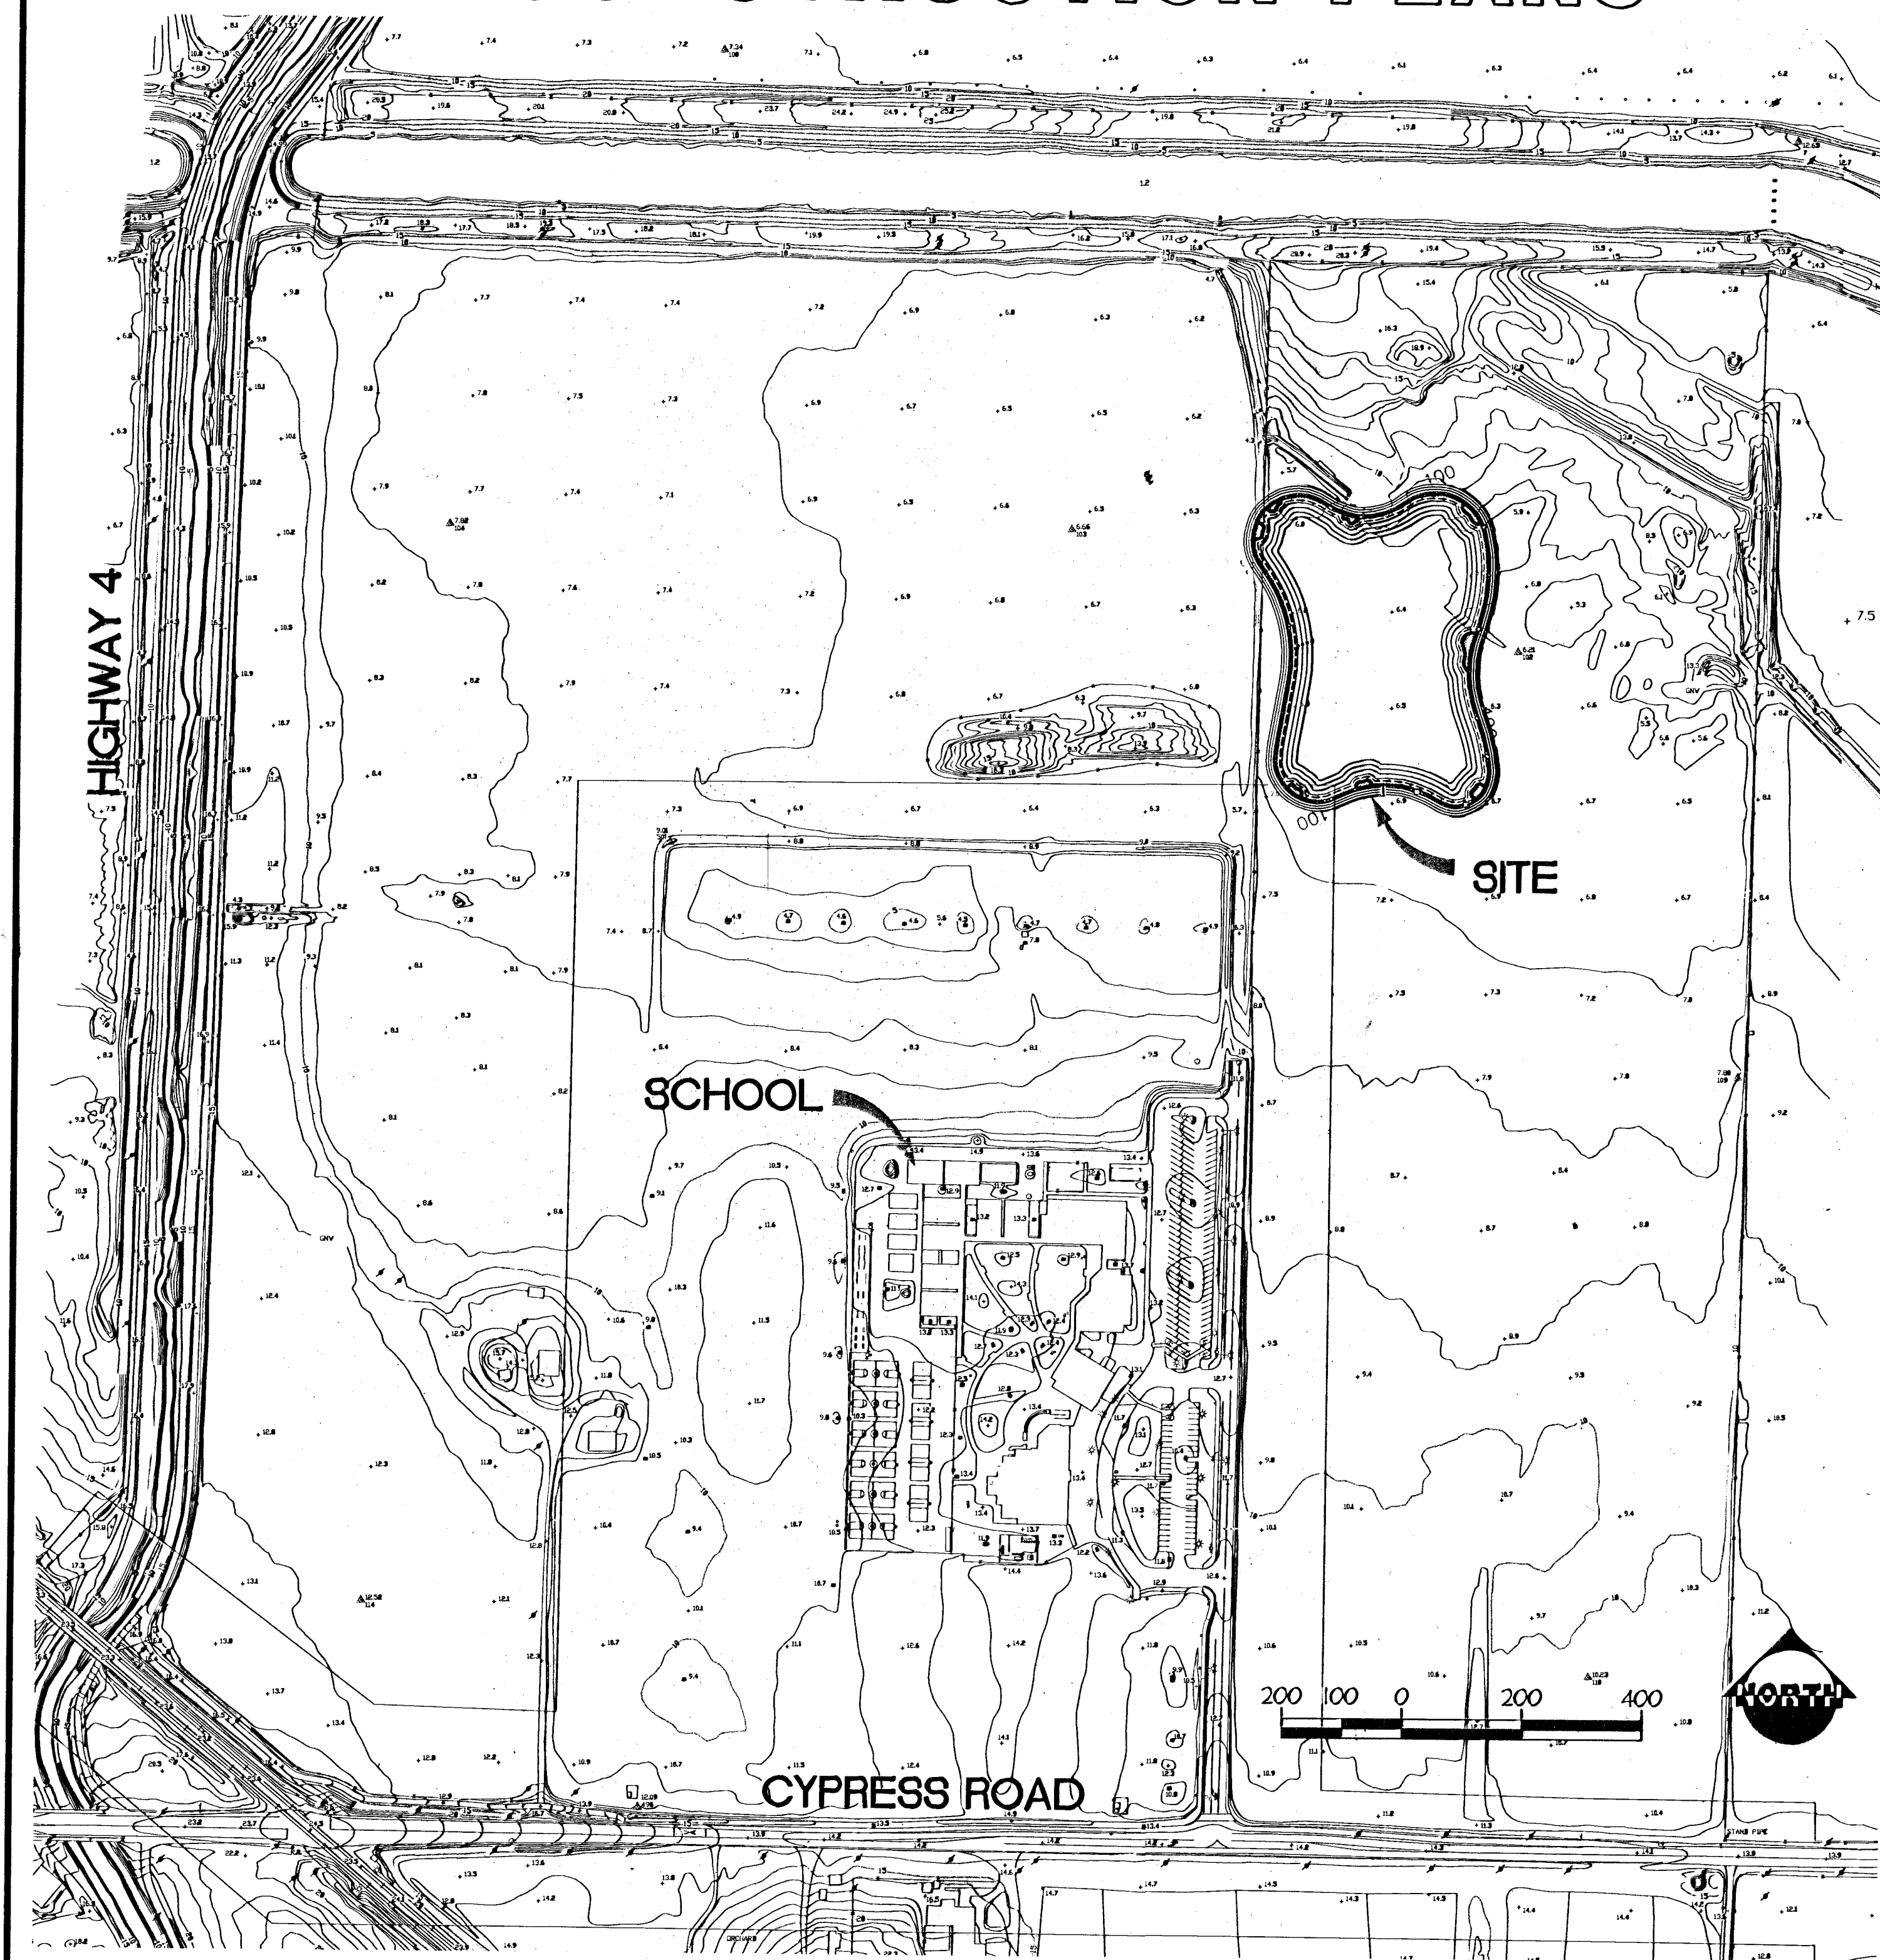

### LAKE NOTES:

- THESE PLANS ARE INTENDED FOR WATER FEATURE CONSTRUCTION USE ONLY. SEE DRAWINGS BY RESPECTIVE DESIGNERS FOR OTHER ASPECTS OF CONSTRUCTION.
- ALL RECIRCULATION PIPE SHALL BE INSTALLED SO THE FLOW IS SLIGHTLY OFF LEVEL OR UPHILL TO PREVENT AIR TRAPS AND SHALL HAVE A 3'-0" (MIN) COVER OUTSIDE WATER FEATURE LIMITS AND A 1'-0" (MIN) COVER WITHIN UNLESS OTHERWISE NOTED.
- ALL PVC PIPE SHALL BE PER THE FOLLOWING SCHEDULE UNLESS OTHERWISE NOTED:
 

30" AND LARGER	80 PSI PLASTIC IRRIGATION PIPE (P.I.P.)
15" - 27"	80 PSI PLASTIC IRRIGATION PIPE (P.I.P.)
10" - 12"	100 PSI PLASTIC IRRIGATION PIPE (P.I.P.)
8"	RING-TITE (RT) CLASS 160 SCHEDULE 40 IPS
6" AND SMALLER	
- THE MEMBRANE LINER SHALL BE 30 MIL PVC-SEE LINER SPECIFICATIONS FOR ADDITIONAL INFORMATION.
- WATER LEVELS SHOWN INDICATE AVERAGE SURFACE ELEVATIONS DURING OPERATION. ELEVATIONS MAY DIFFER DURING SHUTDOWN CONDITIONS.
- ALL MANUFACTURER PRODUCT CALLOUTS SHOWN IN THESE PLANS SHALL BE CONSIDERED "OR APPROVED EQUAL" UNLESS OTHERWISE NOTED.
- THE LAKE CONTRACTOR SHALL VERIFY THE AVAILABLE ELECTRICAL POWER PRIOR TO PURCHASING EQUIPMENT.
- REFER TO SPECIFICATIONS FOR COLOR, TYPE OF BOULDERS TO BE USED, AND INSTALLATION REQUIREMENTS. THE LAKE CONTRACTOR SHALL FURNISH AND INSTALL BOULDERS SUBJECT TO APPROVAL OF THE OWNER. NOTIFY OWNER'S REPRESENTATIVE PRIOR TO SETTING ANY BOULDERS.
- PAINT ALL EXPOSED PVC PIPE WITHIN THE LAKE AREA AND VISIBLE FROM THE SHORELINE WITH BLACK OR DARK BLUE PAINT SUITABLE FOR PLASTIC SURFACES.
- TOP OF CONCRETE SHORELINE & CONTROL WEIR ELEVATIONS SHALL BE INSTALLED + .05' OF ELEVATION AS SHOWN ON PLANS.
- CONCRETE FOR LAKE CONSTRUCTION UNLESS OTHERWISE SPECIFIED ON PLANS SHALL BE 6 SAC MINIMUM PEA GRAVEL PUMP MIX AND SHALL BE ABLE TO BE PUMPED AT A 3' SLUMP W/ A TRAILER MOUNTED GROUT PUMP WITH A 2" HOSE.
- A MINIMUM OF 2'-0" CLEARANCE BETWEEN WATER OR SEWER LINES AND RECIRCULATION LINES IS REQUIRED. IF CLEARANCE IS LESS THEN 2'-0" CONCRETE ENCASUREMENTS OR DUCTILE IRON PIPE WITH MECHANICAL OR RESTRAINED JOINTS.

### LEGEND:

- INDICATES SHORELINE W/ CONC. VENEER
  - SHADED AREA INDICATES LIMIT OF CONCRETE
  - INDICATES SHORELINE W/ EXPOSED LINER
  - INDICATES BOULDERS WITH GRADUATED SIZES
  - INDICATES RIVER COBBLE SHELL
  - INDICATES DISCHARGE RISER
  - INDICATES RECIRCULATION PIPE & SIZE-SEE GENERAL NOTES #2 & #3
  - INDICATES 1/2" WEIGHTED AERATION TUBING
  - INDICATES RECIRCULATION INTAKE PIPE AND SIZE
  - INDICATES TOTAL EFFECTIVE WEIR LENGTH  
INDICATES TOP OF WEIR ELEVATION
  - INDICATES RECIRCULATION FLOW IN GALLONS PER MINUTE & 25% (FOR PHASE I SYSTEM)
  - INDICATES WATER SURFACE ELEVATION  
INDICATES FINISH BOTTOM ELEVATION
  - INDICATES DETAIL LETTER DESIGNATION  
INDICATES SHEET LOCATION  
FOOT INDICATES SECTION DIRECTION
  - INDICATES AERATION POD
  - INDICATES 100 YEAR STORM LINE
- NOTE: NOT ALL SYMBOLS MAY BE USED.

NOTE: DETAIL 1-4 PRIOR TO APPROVAL TO CONSTRUCT

RECORD DRAWINGS

GENERAL NOTES AND SITE PLAN

W6 CYPRESS GROVE

PACIFIC ADVANCED CIVIL ENGINEERING

SHEET L01 OF 07 SHEETS

### SHEET INDEX:

	90% SUBMITTAL FOR BID	100% SUBMITTAL FOR REVIEW 1	100% SUBMITTAL FOR REVIEW 2	100% SUBMITTAL FOR APPROVAL
<b>LAKE PLANS</b>				
L01	GENERAL NOTES AND SITE PLAN	1/08/05	4/08/05	4/21/05
L02	OVERALL WATER FEATURE & LAKE PIPING PLAN	1/08/05	4/08/05	4/21/05
L03	WATER FEATURE DETAILS	1/08/05	4/08/05	4/08/05
L04	WATER FEATURE DETAILS	1/08/05	4/08/05	4/08/05
L05	WATER FEATURE DETAILS	1/08/05	4/08/05	4/21/05
<b>PUMP STATION PLANS</b>				
C01	CIVIL SITE PLAN	1/08/05	4/08/05	4/21/05
C02	CIVIL GRADING PLAN	1/08/05	4/08/05	4/21/05
C03	CIVIL DETAILS	1/08/05	4/08/05	4/08/05
A0	NOTES	1/08/05	4/08/05	4/08/05
A01	ARCHITECTURAL SECTIONS	1/08/05	4/08/05	4/08/05
A02	ARCHITECTURAL PLAN	1/08/05	4/08/05	4/08/05
A03	ARCHITECTURAL ROOFING	1/08/05	4/08/05	4/08/05
AD1	ARCHITECTURAL DETAILS	1/08/05	4/08/05	4/08/05
AD2	ARCHITECTURAL DETAILS	1/08/05	4/08/05	4/08/05
M01	MECHANICAL PLAN	1/08/05	4/08/05	4/08/05
M02	MECHANICAL SECTIONS	1/08/05	4/08/05	4/08/05
M03	MECHANICAL DETAILS	1/08/05	4/08/05	4/08/05
M04	MECHANICAL DETAILS	1/08/05	4/08/05	4/08/05
M05	MECHANICAL DETAILS	1/08/05	4/08/05	4/08/05
I0	PIED INDEX	1/08/05	4/08/05	4/08/05
I01	PIED	1/08/05	4/08/05	4/08/05
EI0	COVER SHEET	1/08/05	4/08/05	4/08/05
EI1	SINGLE LINE	1/08/05	4/08/05	4/21/05
EI2	ELECTRICAL PLANS SITE	1/08/05	4/08/05	4/21/05
EI3	ELECTRICAL PLANS DETAILS	1/08/05	4/08/05	4/21/05
EI4	ELECTRICAL PLANS SCHEMATICS	1/08/05	4/08/05	4/21/05
<b>WELL PLANS</b>				
W01	PLAN & SECTION	1/08/05	4/08/05	4/21/05
W02	DETAILS	1/08/05	4/08/05	4/21/05
W03	CONTROL & SES	1/08/05	4/08/05	4/21/05
W04	ONE LINE DIAGRAM	1/08/05	4/08/05	4/21/05
W05	WELL PHID	1/08/05	4/08/05	4/21/05

RECORD DRAWINGS  
12/22/05  
#67428

FIELD REVISIONS

- M1, M2
- L5
- L2, L3, L5

BENCH MARK:  
CONTRA COSTA COUNTY BENCH MARK NO. 3095 LOCATED ON THE NORTH SIDE OF CYPRESS ROAD BRIDGE CROSSING OF MARSH CREEK. ELEVATION 22.993.

PLAN APPROVAL  
REVIEWED FOR CONFORMANCE WITH CITY OF OAKLEY STANDARDS AND REQUIREMENTS. APPROVAL FOR CONSTRUCTION IS SUBJECT TO THE INFORMATION SHOWN HEREIN. THE CITY OF OAKLEY AND THE UNDERSIGNED ARE NOT RESPONSIBLE FOR ANY ERRORS OR OMISSIONS THAT MAY EXIST ON THESE PLANS.

JASON VOGAN  
JASON VOGAN, C.E.P. ENGINEER  
R.C.E. NO. 59299  
DATE: 5/26/2005  
EXPIRES: 06/30/07

### ABBREVIATIONS:

AR	AIR RELEASE	DIP	DUCTILE IRON PIPE	GPM	GALLONS PER MINUTE	PH	PHASE	SPECS	SPECIFICATIONS
AIR/VAC	AIR RELEASE AND VACUUM RELIEF	EH	EACH WAY	GV	GATE VALVE	PUE	PUBLIC UTILITY EASEMENT	SF	SQUARE FEET
APP EQ	APPROVED EQUAL	EOP	EDGE OF PAVEMENT	HP	HORSE POWER	PVC	POLYVINYL CHLORIDE	THK	THICK
BL	BALL VALVE	EL	ELEVATION	HP	HORSE POWER	PSF	POUNDS PER SQUARE FOOT	TOP	TOP OF FOOTING
BLDG	BUILDING	ENG	ENGINEERING	IE	INVERT ELEVATION	PSI	POUNDS PER SQUARE INCH	TOP	TOP OF PAVEMENT
BV	BUTTERFLY VALVE	EQ	EQUALIZER	IRR	IRRIGATION	PS	PUMP STATION	TOS	TOP OF SLAB
CV	CHECK VALVE	FF	FINISH FLOOR	MFR	MANUFACTURER	RB	REDUCER BUSHING	TOW	TOP OF WALL
CONC	CONCRETE	FG	FINISH GRADE	MAX	MAXIMUM	REINF	REINFORCED	TDH	TOTAL DYNAMIC HEAD
CONT	CONTINUOUS	FLG	FLANGE	MG	MILLION GALLON	RCP	REINFORCED CONCRETE PIPE	TYP	TYPICAL
DIA	DIAMETER	GAL	GALLONS	MIN	MINIMUM	R/W	RIGHT OF WAY	V	VOLTS
		GA	GAUGE	OC	ON CENTER	SCH	SCHEDULE	WS	WATER SURFACE

W6 LAKE DEASSING PUMP STA.

717106

PREPARED BY: SCARLY O. SIM, PROJECT ENGINEER, R.C.E. NO. 58816, EXP. 12/31/05

DATE: 04/27/05

REASONS: 5-19-05

NO. BY DATE

DATE APP.

RECORD DRAWINGS

W6 CYPRESS GROVE

PACIFIC ADVANCED CIVIL ENGINEERING  
1750 NEWDALE STREET, SUITE 200  
OAKLAND, CA 94612  
PH (714) 481-7300 FAX (714) 481-7299

SHEET L01 OF 07 SHEETS

JOB NO. 8117-E


THESE DRAWINGS ARE THE PROPERTY OF PACIFIC ADVANCED CIVIL ENGINEERING AND SHALL NOT BE REPRODUCED IN ANY MANNER NOR BE USED FOR CONSTRUCTION UNLESS STAMPED "ISSUED FOR CONSTRUCTION"









**LAKE ROUGH GRADE  
(BY ROUGH GRADING  
CONTRACTOR)**

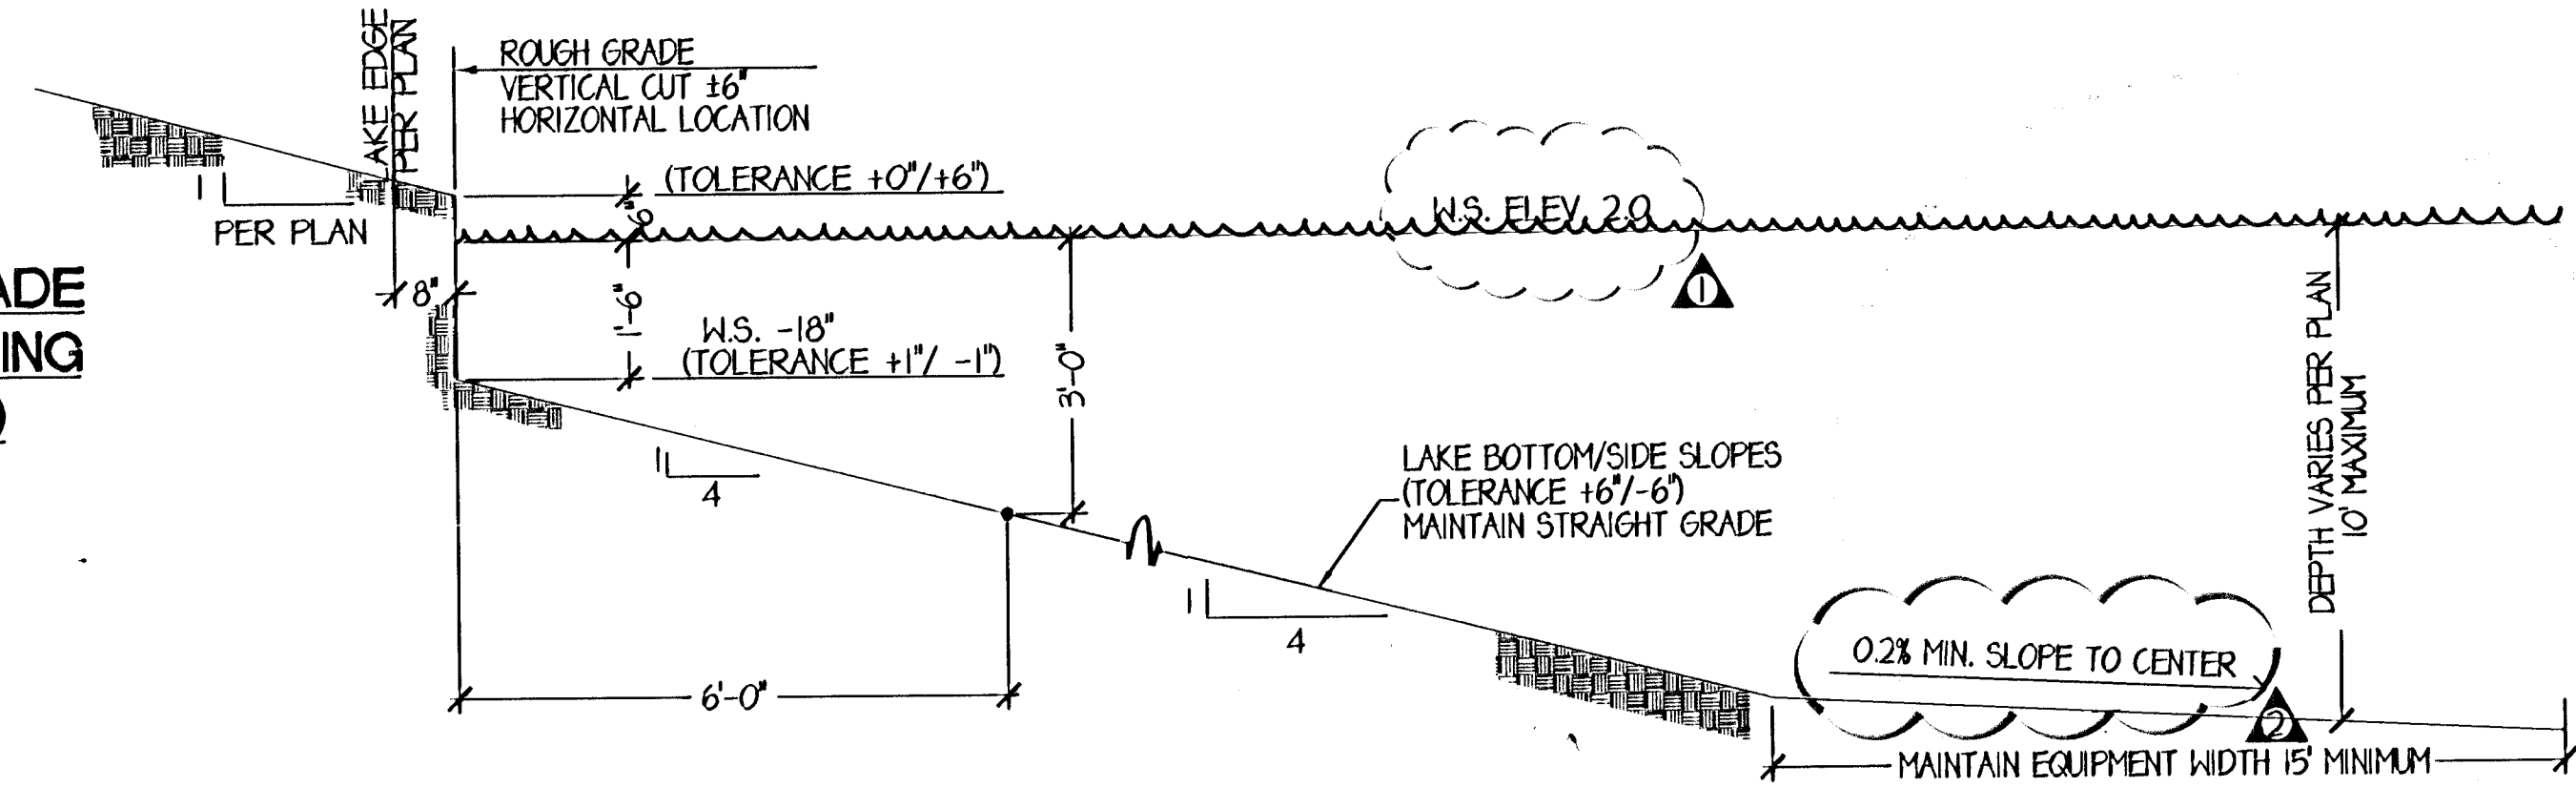

**LAKE GRADING /  
SHAPING (BY LAKE  
CONTRACTOR)**

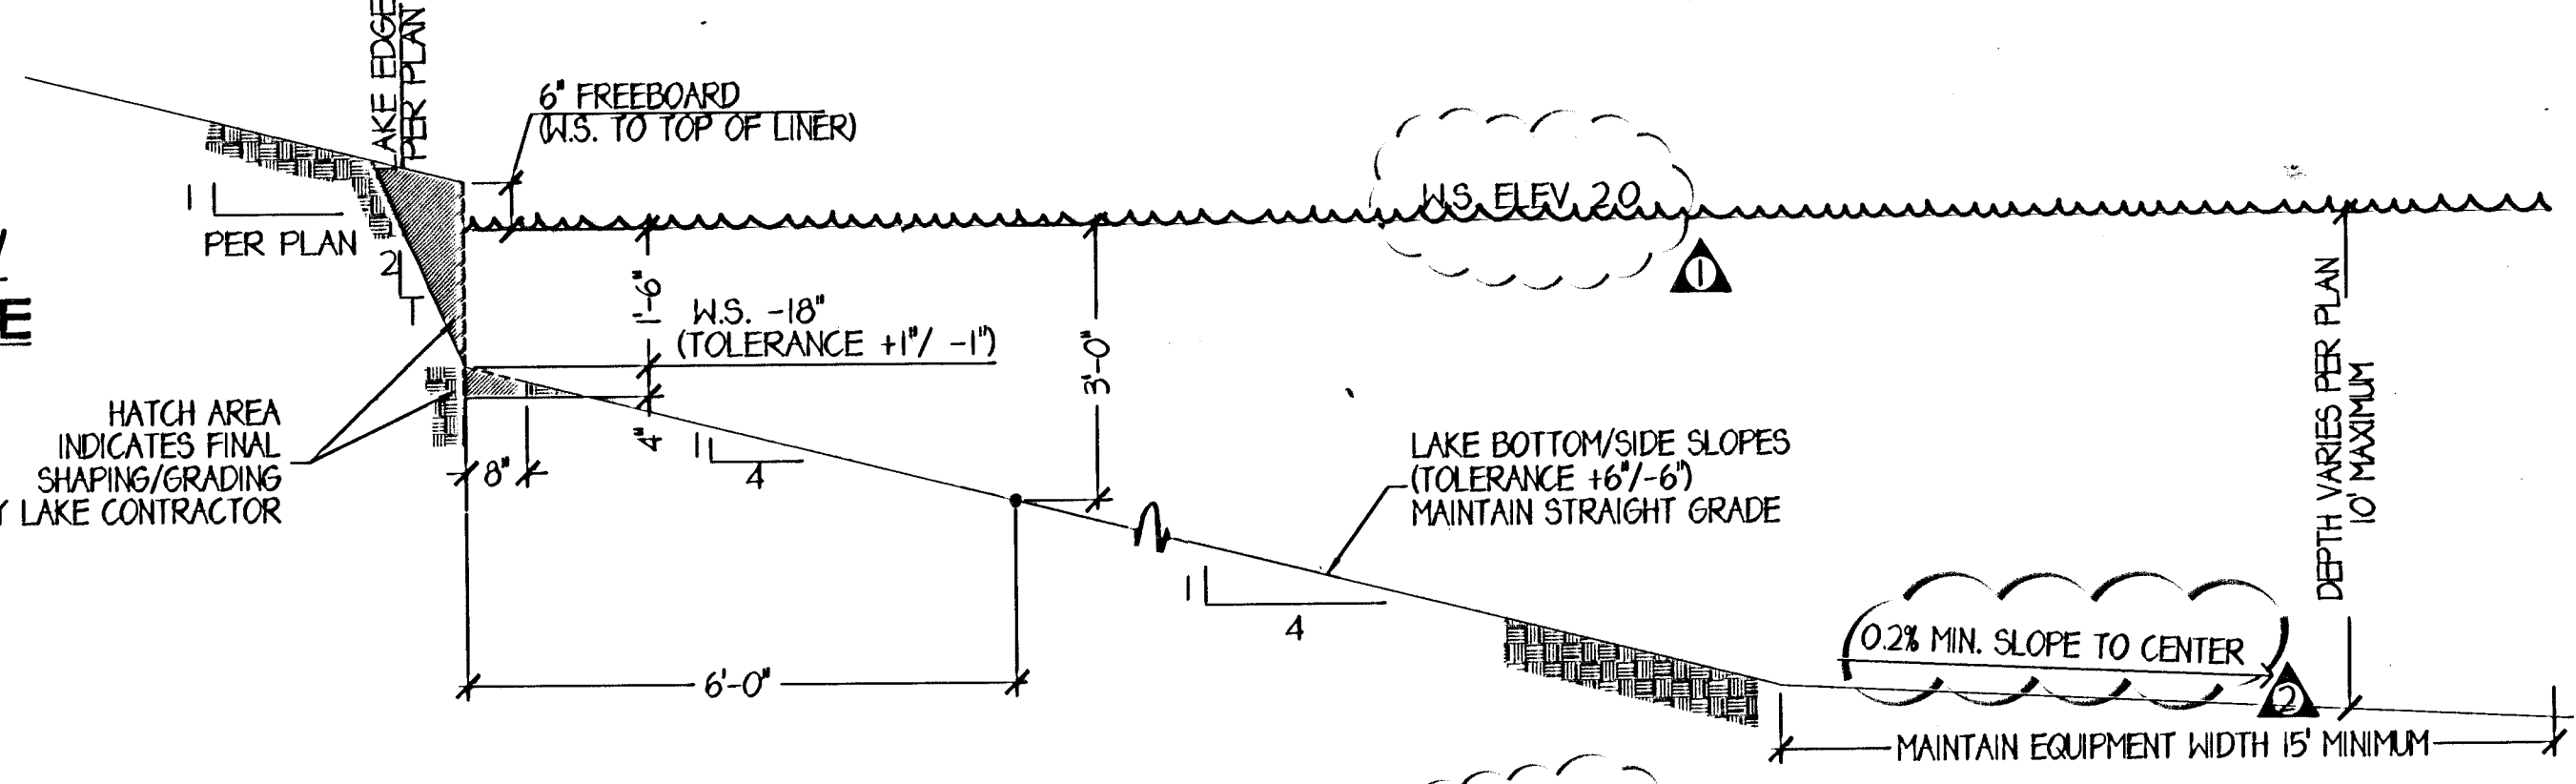


**FINAL SHORELINE  
INSTALLATION  
(BY LAKE CONTRACTOR)**

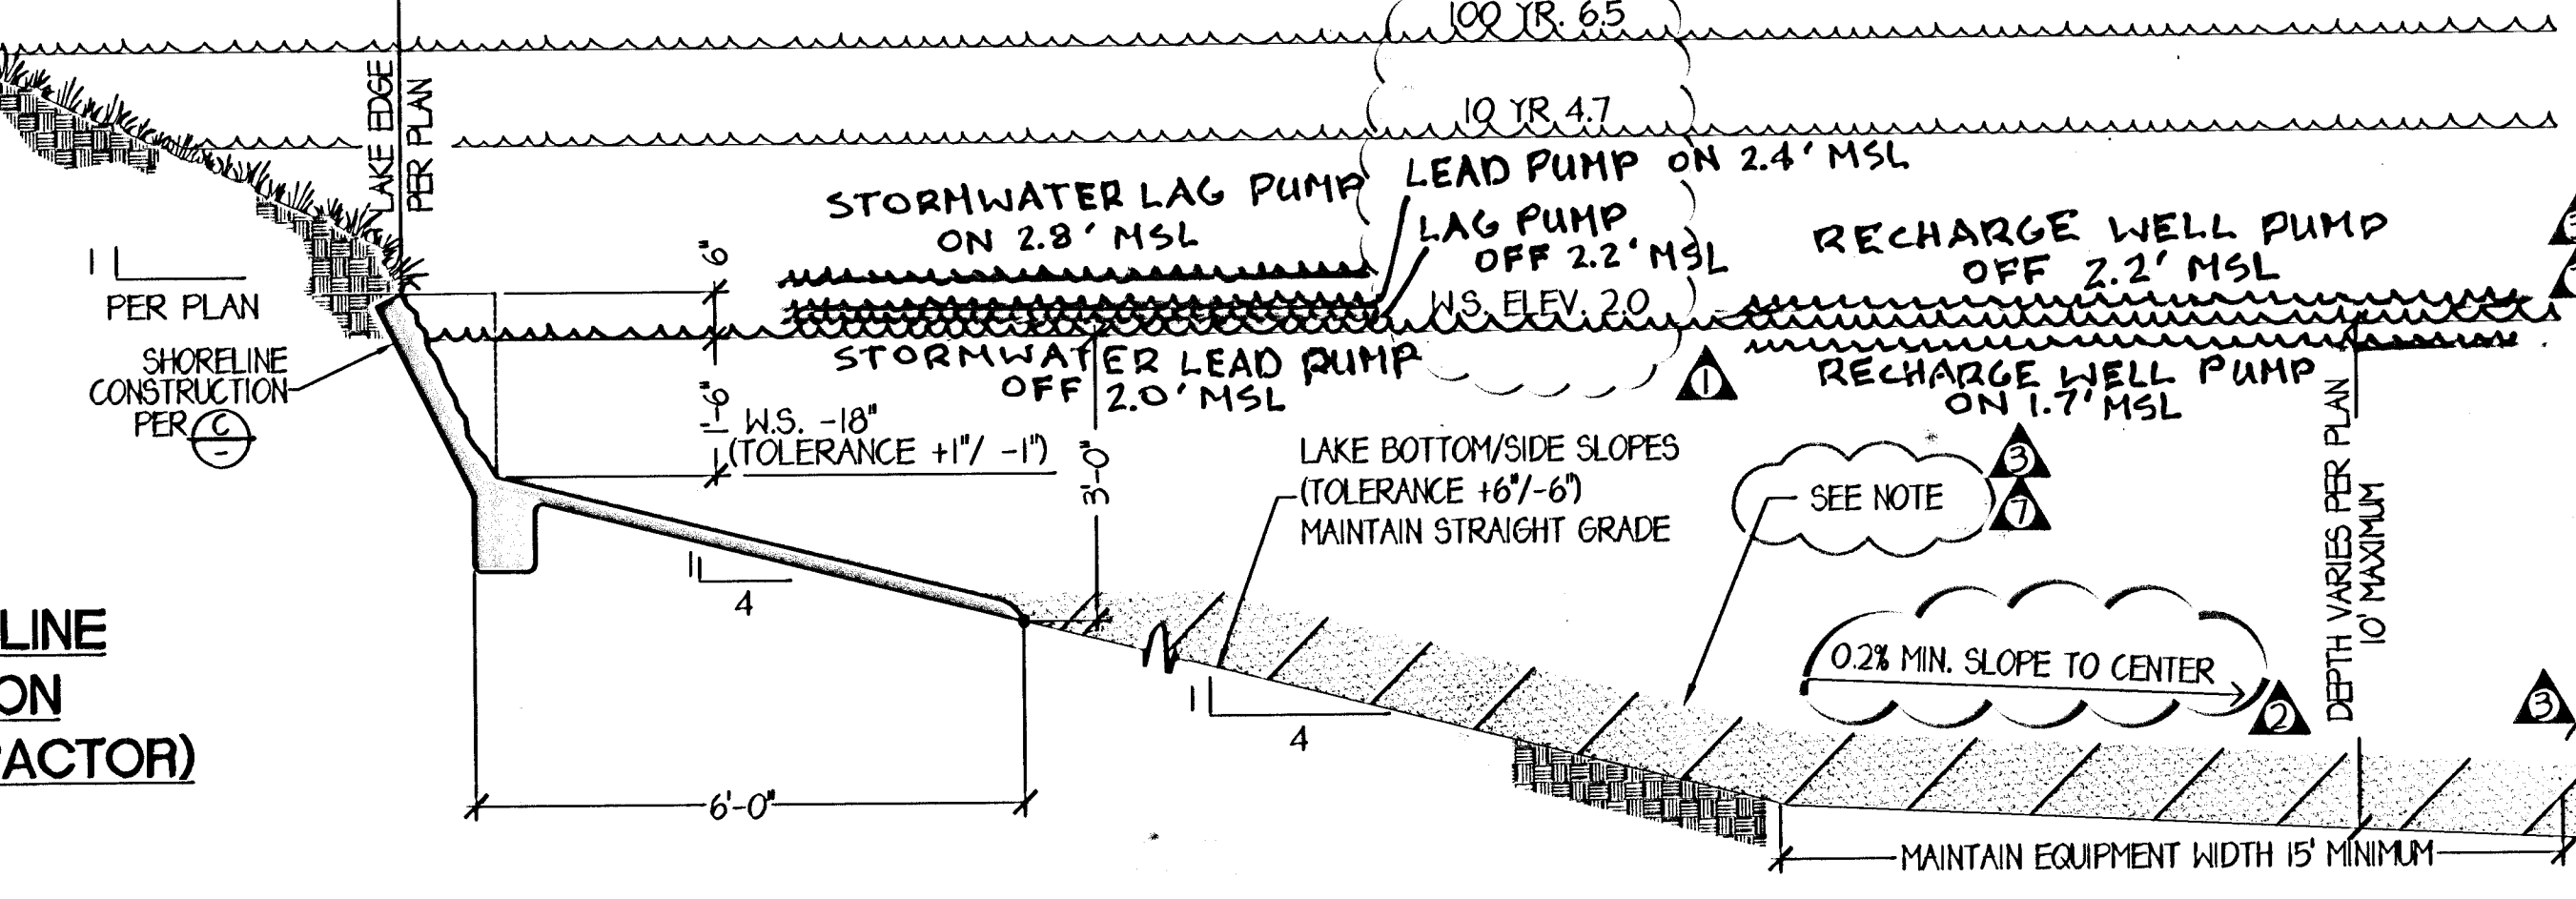


**NOTE:** THE SOIL SHALL BE COARSE SANDY LOAM. SELECT MATERIAL. SOIL COVER SHALL BE FREE FROM LUMPS OR BALLS OF CLAY AND SHALL NOT CONTAIN EXCESSIVE AMOUNTS OF CALCAREOUS OR CLAY COATINGS, AND SHALL NOT CONTAIN ANY CALICHE, DEBRIS, SYNTHETIC MATERIALS, DELETERIOUS OR FOREIGN SUBSTANCES. IN ADDITION SOIL COVER SHALL MEET THE FOLLOWING GRADATION CRITERIA: NO MORE THAN 50% OF THE MATERIAL SHALL BE FINES (PASS THE NO. 200 SIEVE), AND THE FINE CLAY FRACTION SHALL NOT BE MORE THAN 20% LEAVING AT LEAST 30% AS SILT. THE SOIL COVER PLASTICITY INDEX (PI) SHALL BE LESS THAN 10.

**ERODED CONCRETE SHORELINE**

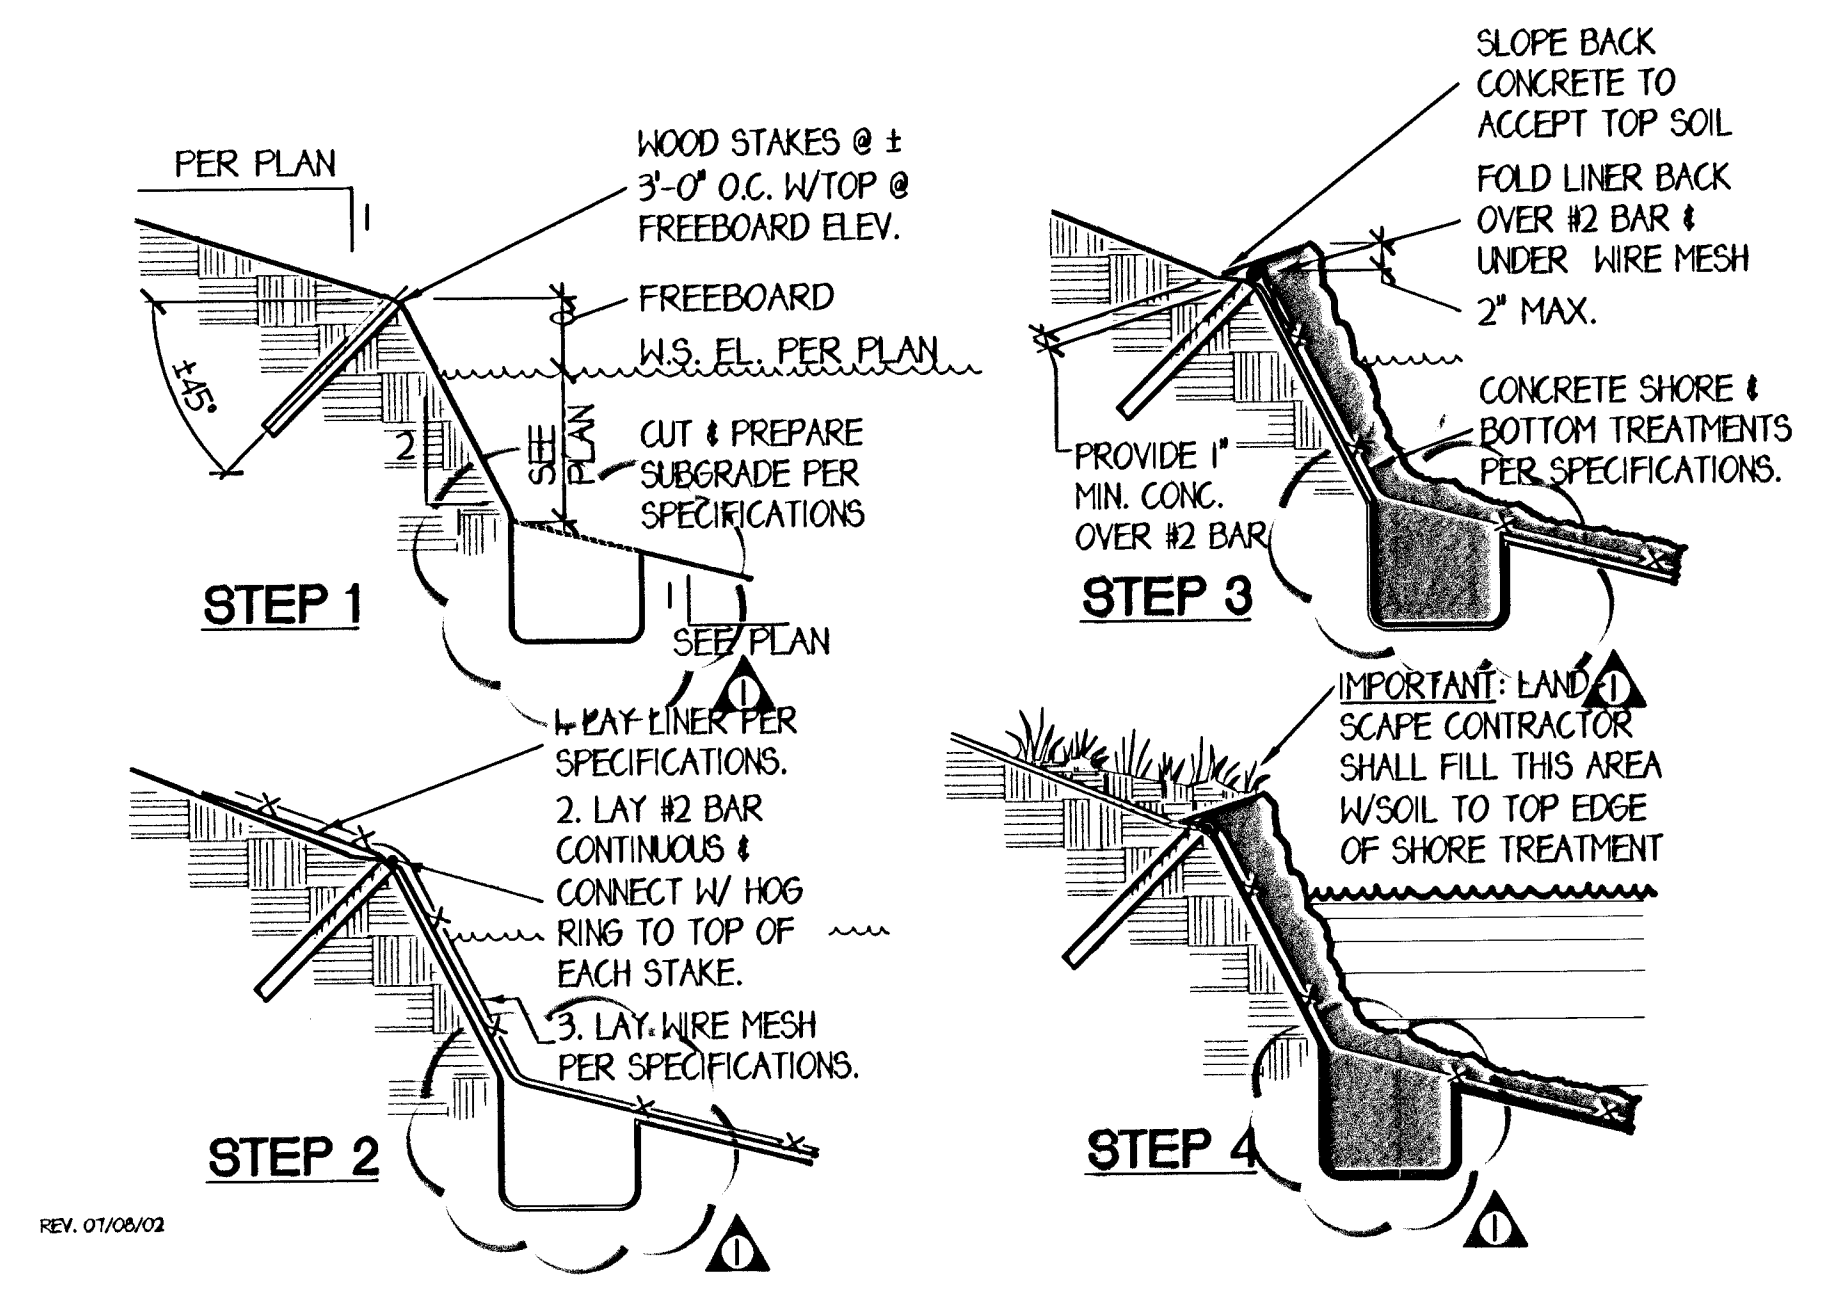


**LAKE SHORELINE GRADING & INSTALLATION PROCEDURE**

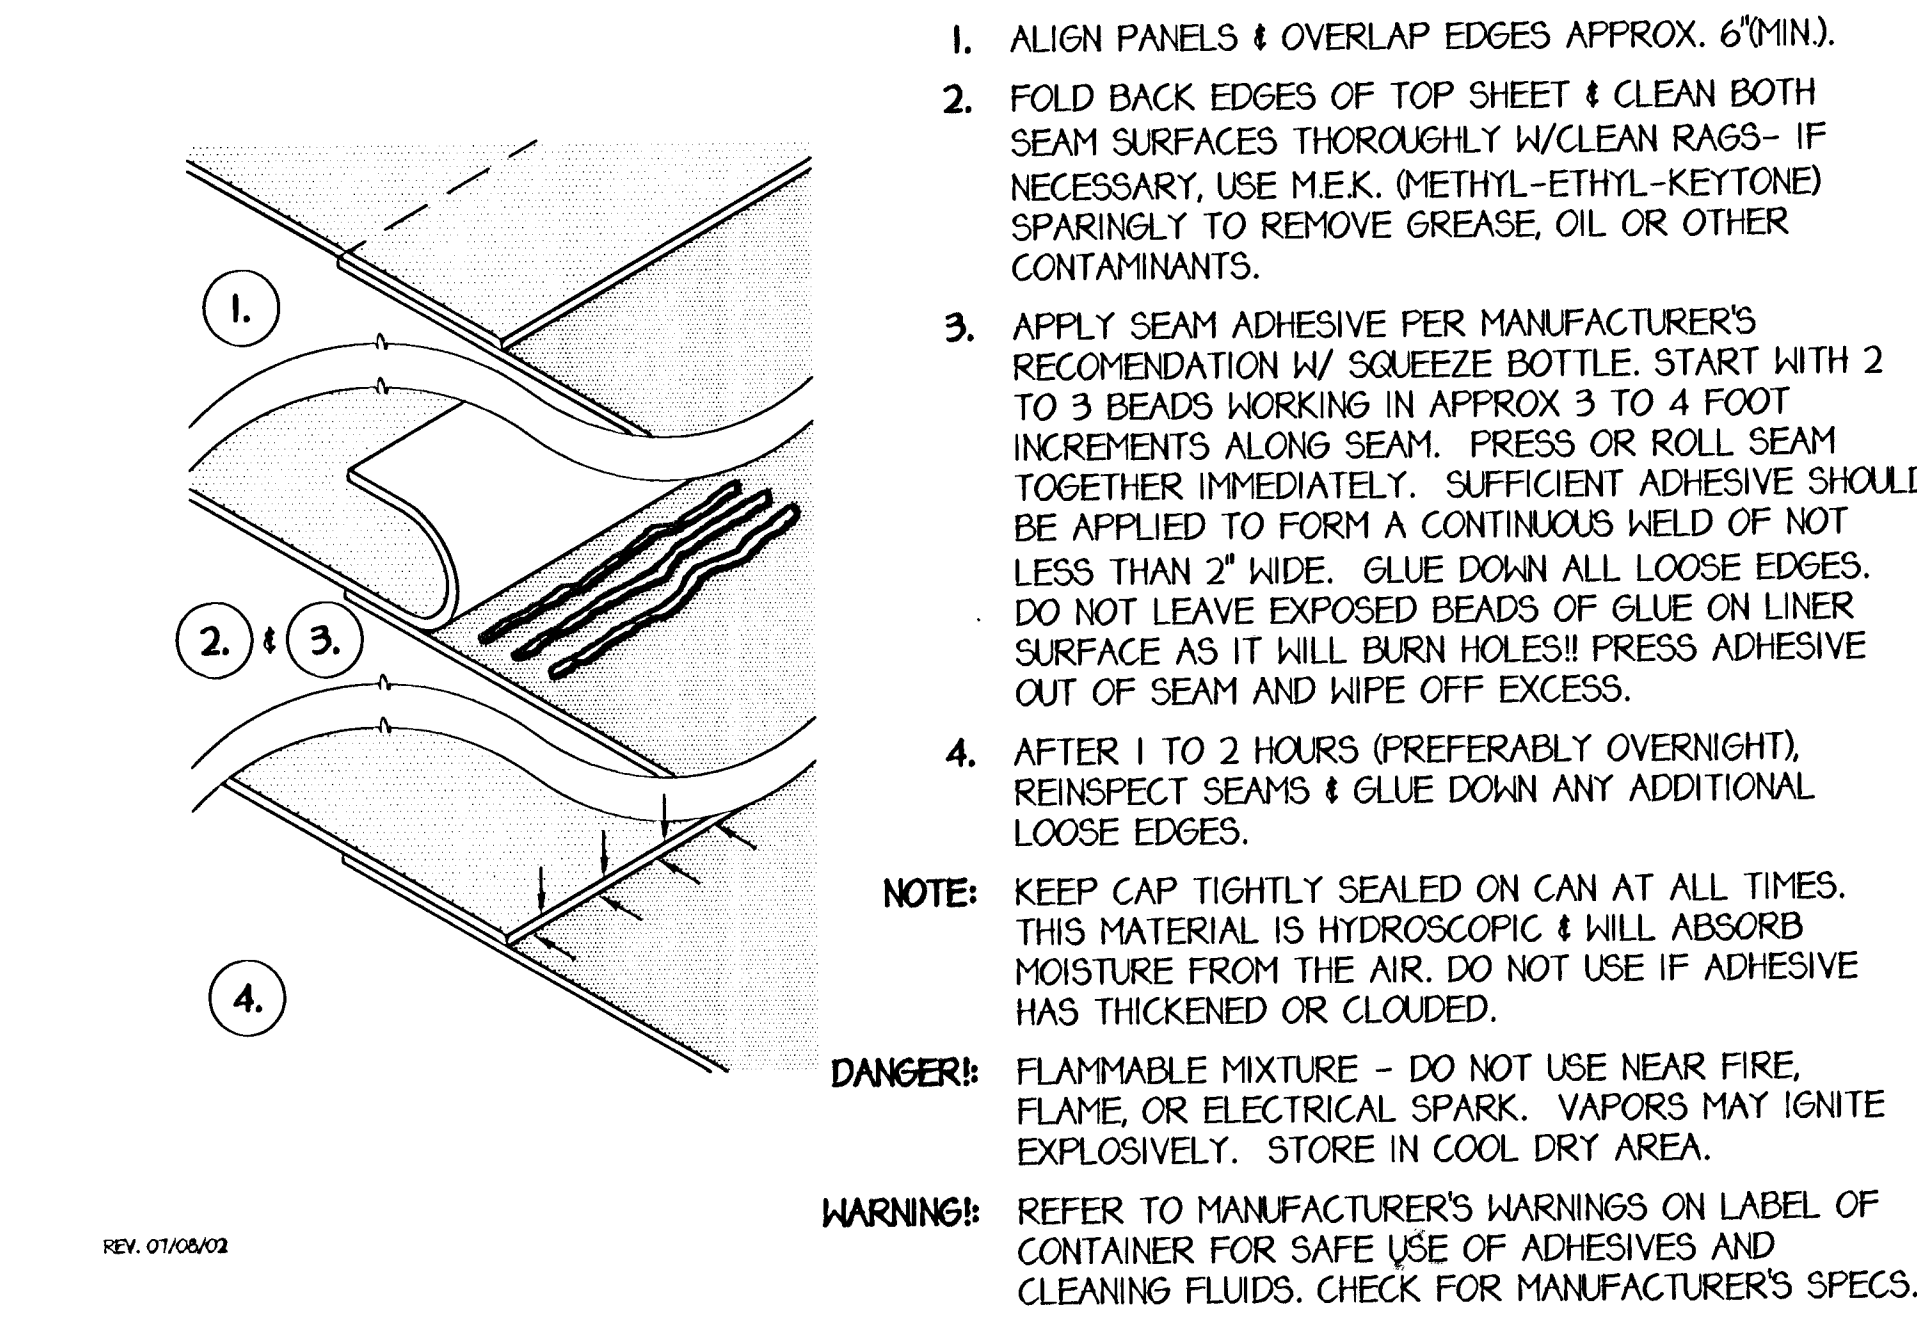

1. ALIGN PANELS & OVERLAP EDGES APPROX. 6" (MIN).
  2. FOLD BACK EDGES OF TOP SHEET & CLEAN BOTH SEAM SURFACES THOROUGHLY W/ CLEAN RAGS- IF NECESSARY, USE M.E.K. (METHYL-ETHYL-KETONE) SPARINGLY TO REMOVE GREASE, OIL OR OTHER CONTAMINANTS.
  3. APPLY SEAM ADHESIVE PER MANUFACTURER'S RECOMMENDATION W/ SQUEEZE BOTTLE. START WITH 2 TO 3 BEADS WORKING IN APPROX 3 TO 4 FOOT INCREMENTS ALONG SEAM. PRESS OR ROLL SEAM TOGETHER IMMEDIATELY. SUFFICIENT ADHESIVE SHOULD BE APPLIED TO FORM A CONTINUOUS WELD OF NOT LESS THAN 2" WIDE. GLUE DOWN ALL LOOSE EDGES. DO NOT LEAVE EXPOSED BEADS OF GLUE ON LINER SURFACE AS IT WILL BURN HOLES!! PRESS ADHESIVE OUT OF SEAM AND WIPE OFF EXCESS.
  4. AFTER 1 TO 2 HOURS (PREFERABLY OVERNIGHT), REINSPECT SEAMS & GLUE DOWN ANY ADDITIONAL LOOSE EDGES.
- NOTE:** KEEP CAP TIGHTLY SEALED ON CAN AT ALL TIMES. THIS MATERIAL IS HYDROSCOPIC & WILL ABSORB MOISTURE FROM THE AIR. DO NOT USE IF ADHESIVE HAS THICKENED OR CLOUDED.
- DANGER!** FLAMMABLE MIXTURE - DO NOT USE NEAR FIRE, FLAME, OR ELECTRICAL SPARK. VAPORS MAY IGNITE EXPLOSIVELY. STORE IN COOL DRY AREA.
- WARNING!** REFER TO MANUFACTURER'S WARNINGS ON LABEL OF CONTAINER FOR SAFE USE OF ADHESIVES AND CLEANING FLUIDS. CHECK FOR MANUFACTURER'S SPECS.

**LAKE SHORELINE GRADING & INSTALLATION PROCEDURE**

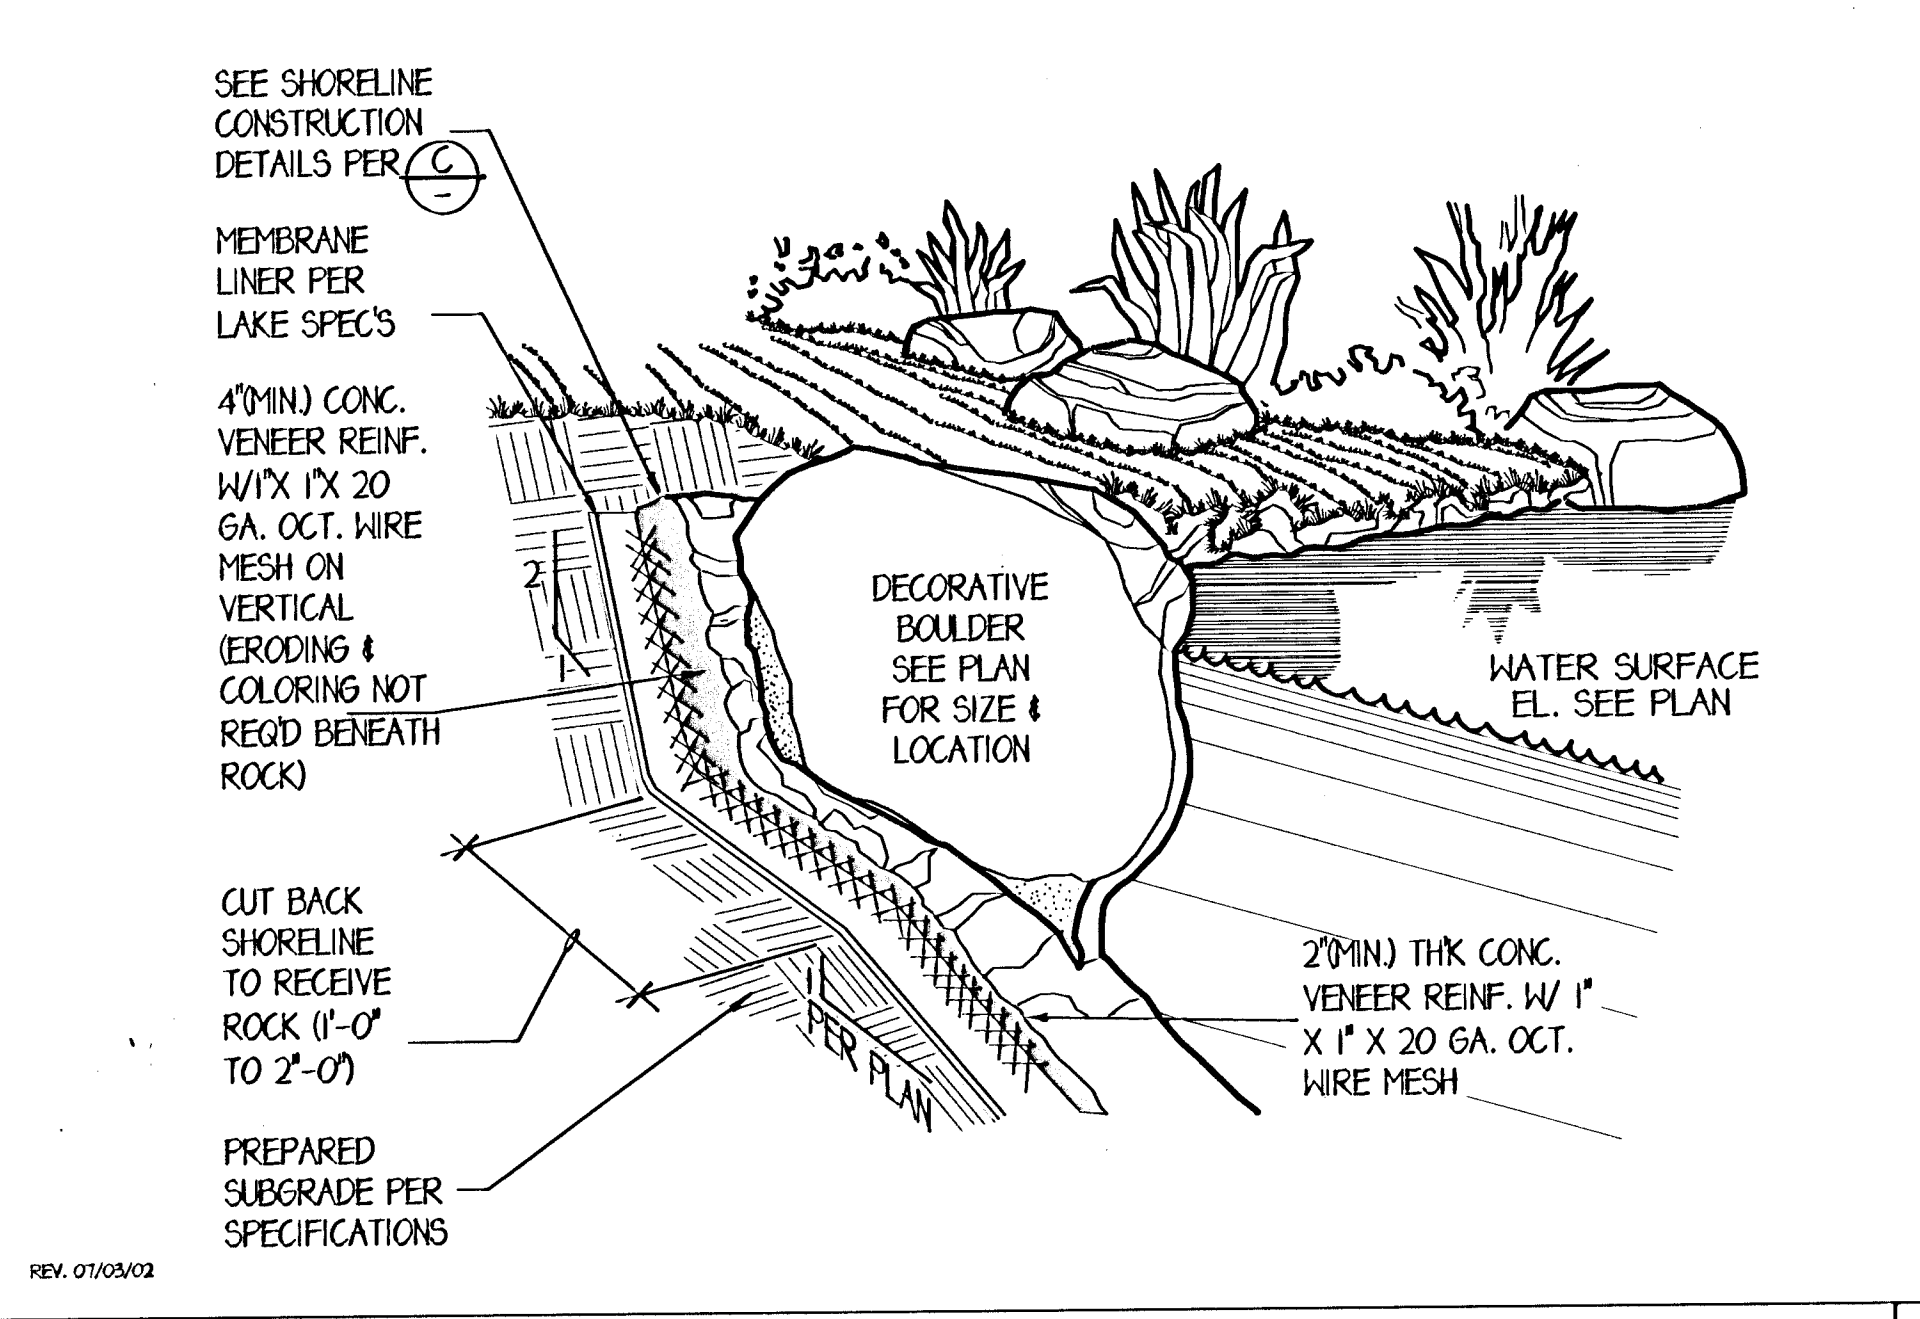

SEE SHORELINE CONSTRUCTION DETAILS PER (C)

MEMBRANE LINER PER LAKE SPECS

4" (MIN) CONC. VENEER REINF. W/ 1" X 1" X 20 GA. OCT. WIRE MESH ON VERTICAL (ERODING & COLORING NOT REQ'D BENEATH ROCK)

CUT BACK SHORELINE TO RECEIVE ROCK (1'-0" TO 2'-0")


PREPARED SUBGRADE PER SPECIFICATIONS

DECORATIVE BOULDER SEE PLAN FOR SIZE & LOCATION

WATER SURFACE EL. SEE PLAN

2" (MIN) THK CONC. VENEER REINF. W/ 1" X 1" X 20 GA. OCT. WIRE MESH

**SHORELINE CONSTRUCTION**

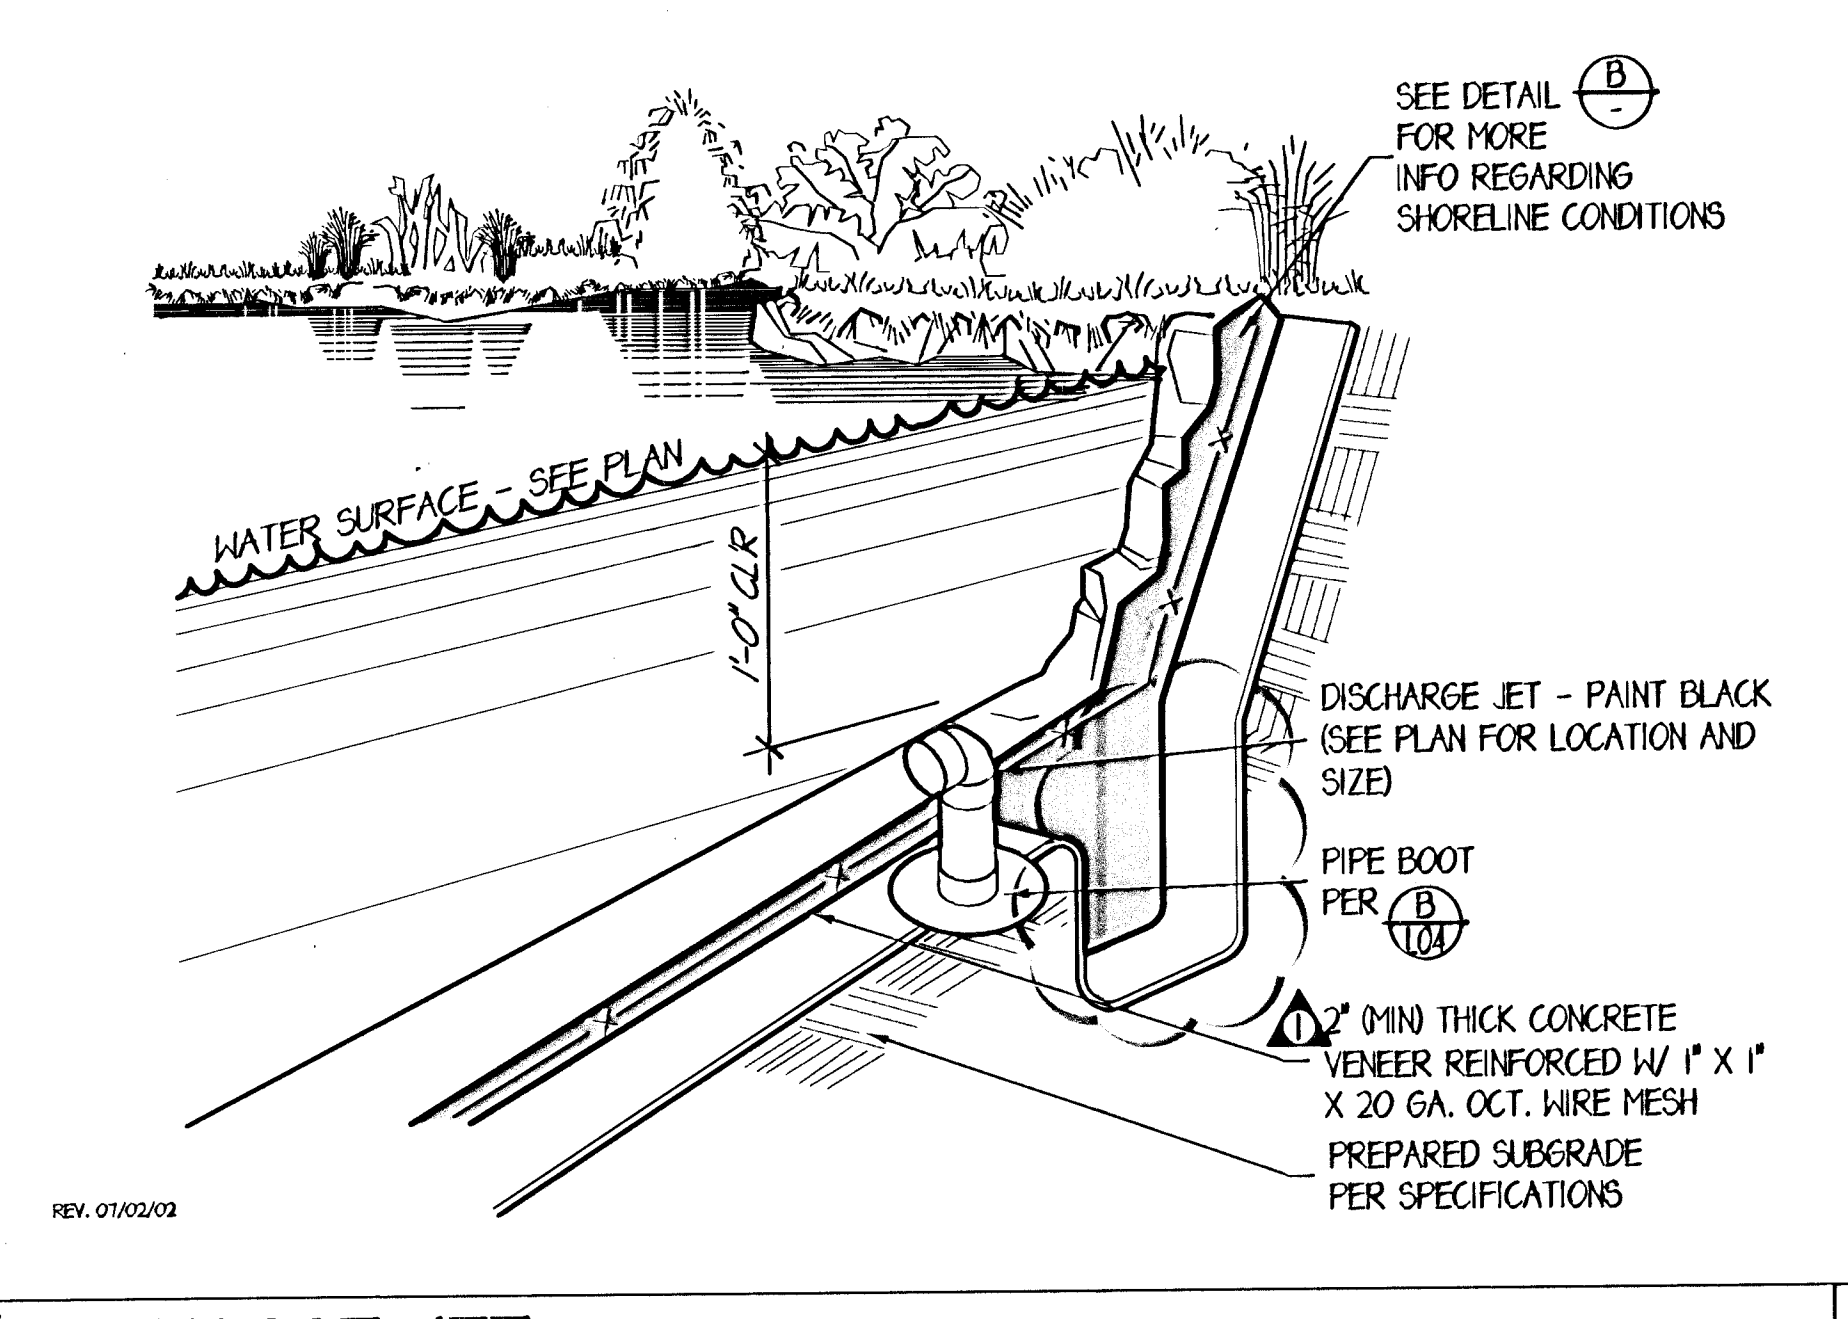

SEE DETAIL (B) FOR MORE INFO REGARDING SHORELINE CONDITIONS

DISCHARGE JET - PAINT BLACK (SEE PLAN FOR LOCATION AND SIZE)

PIPE BOOT PER (B)

2" (MIN) THICK CONCRETE VENEER REINFORCED W/ 1" X 1" X 20 GA. OCT. WIRE MESH

PREPARED SUBGRADE PER SPECIFICATIONS

**LINER SEAMING PROCEDURE**

**BOULDER POCKET**

**DISCHARGE JET**

REV.	DATE	BY	CHKD.	DESCRIPTION
1	04/27/05	SW	SW	ISSUED FOR CONSTRUCTION
2	04/27/05	SW	SW	REVISIONS
3	04/27/05	SW	SW	REVISIONS
4	04/27/05	SW	SW	REVISIONS
5	04/27/05	SW	SW	REVISIONS
6	04/27/05	SW	SW	REVISIONS
7	04/27/05	SW	SW	REVISIONS
8	04/27/05	SW	SW	REVISIONS
9	04/27/05	SW	SW	REVISIONS
10	04/27/05	SW	SW	REVISIONS

NO.	DATE	BY	CHKD.	DESCRIPTION
1	04/27/05	SW	SW	ISSUED FOR CONSTRUCTION
2	04/27/05	SW	SW	REVISIONS
3	04/27/05	SW	SW	REVISIONS
4	04/27/05	SW	SW	REVISIONS
5	04/27/05	SW	SW	REVISIONS
6	04/27/05	SW	SW	REVISIONS
7	04/27/05	SW	SW	REVISIONS
8	04/27/05	SW	SW	REVISIONS
9	04/27/05	SW	SW	REVISIONS
10	04/27/05	SW	SW	REVISIONS

**WATER FEATURE DETAILS**

**CYPRESS GROVE**




**PACIFIC ADVANCED CIVIL ENGINEERING**

**LO3**

Xref: 3624/40g  
 Date: 04/27/05  
 Title: LAKE SHORELINE GRADING & INSTALLATION PROCEDURE  
 Project: CYPRESS GROVE  
 Location: 17520 NEWPORT STREET, SUITE 200, FOUNTAIN VALLEY, CA 92708  
 Phone: (714) 461-7300  
 Fax: (714) 461-7299  
 Email: info@pacificadvanced.com  
 Website: www.pacificadvanced.com

THESE DRAWINGS ARE THE PROPERTY OF PACIFIC ADVANCED CIVIL ENGINEERING AND SHALL NOT BE REPRODUCED IN ANY MANNER NOR BE USED FOR CONSTRUCTION UNLESS STAMPED "ISSUED FOR CONSTRUCTION".






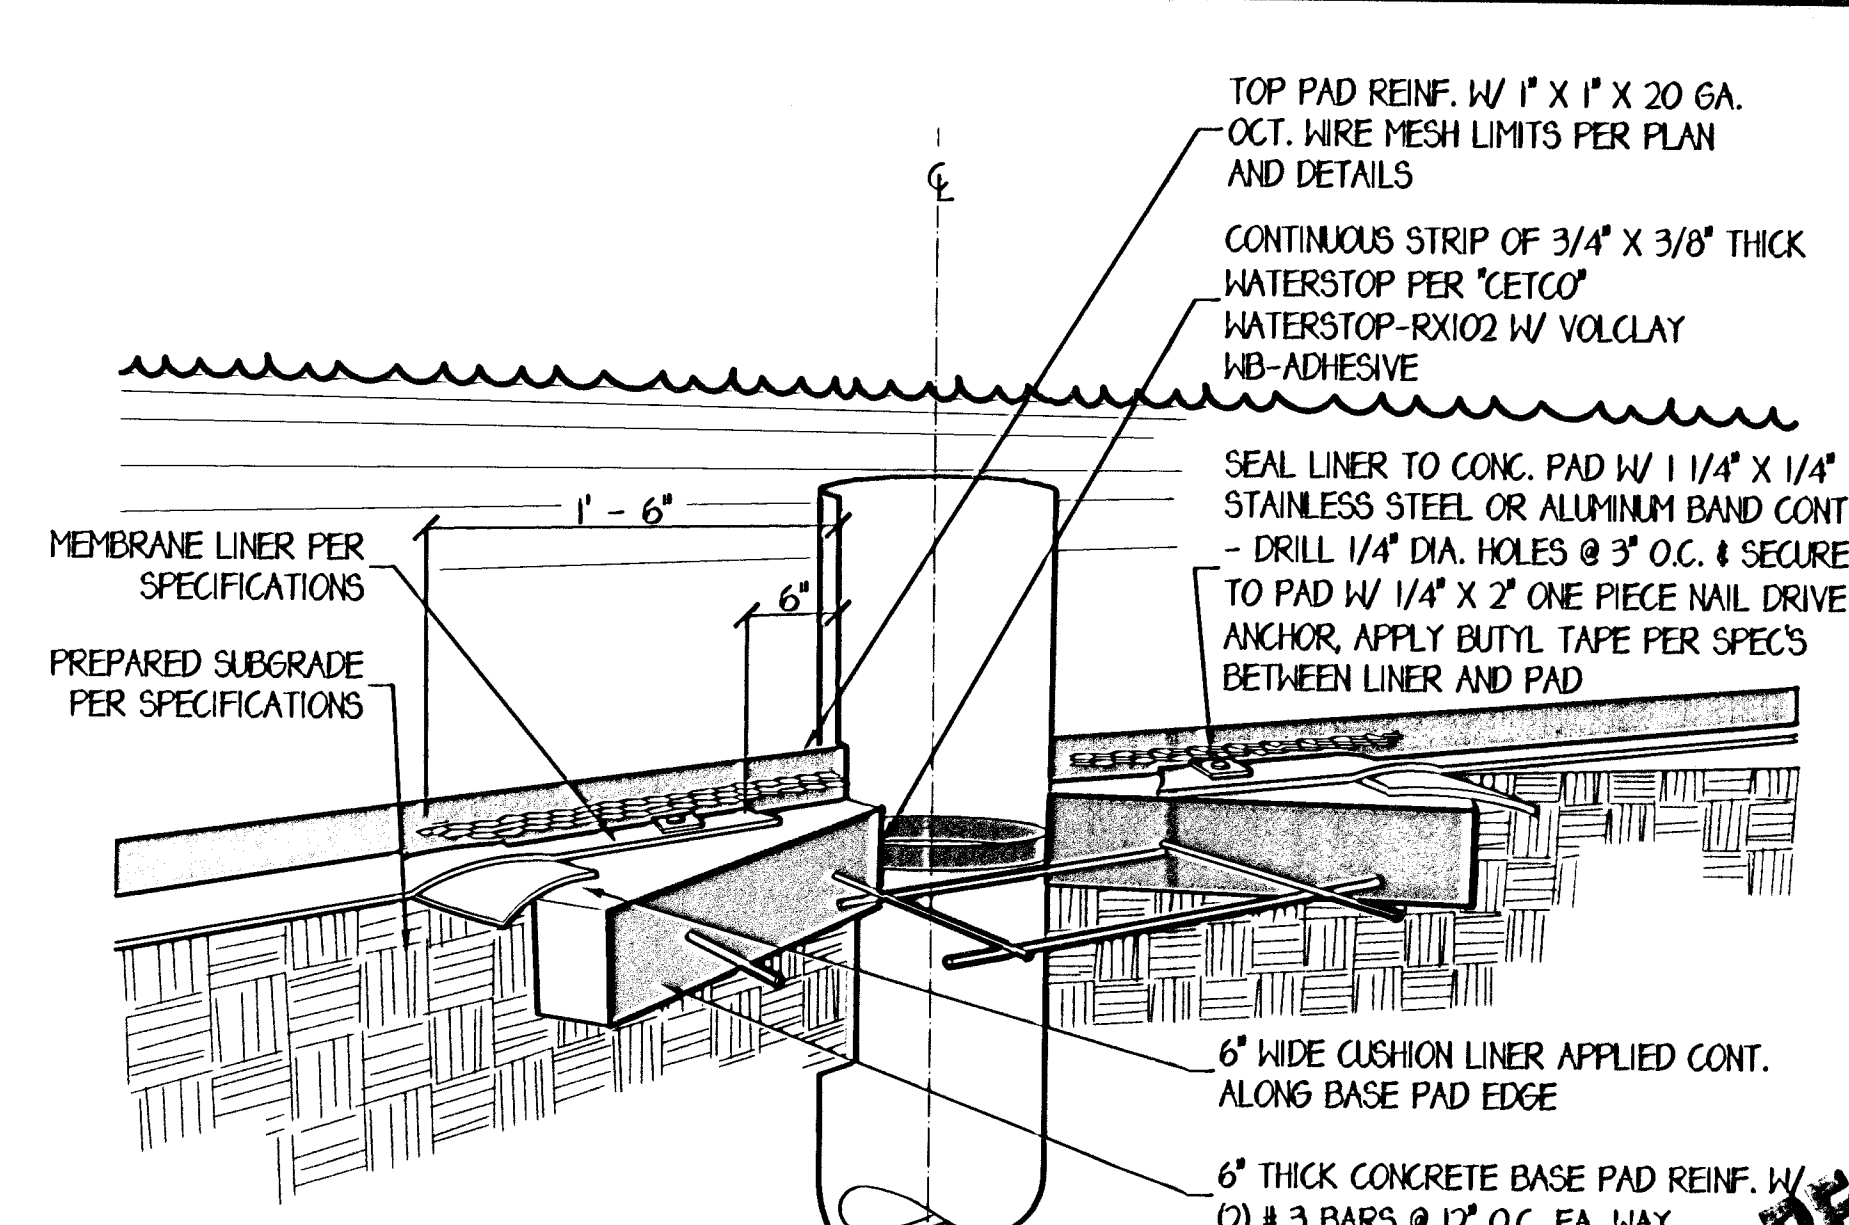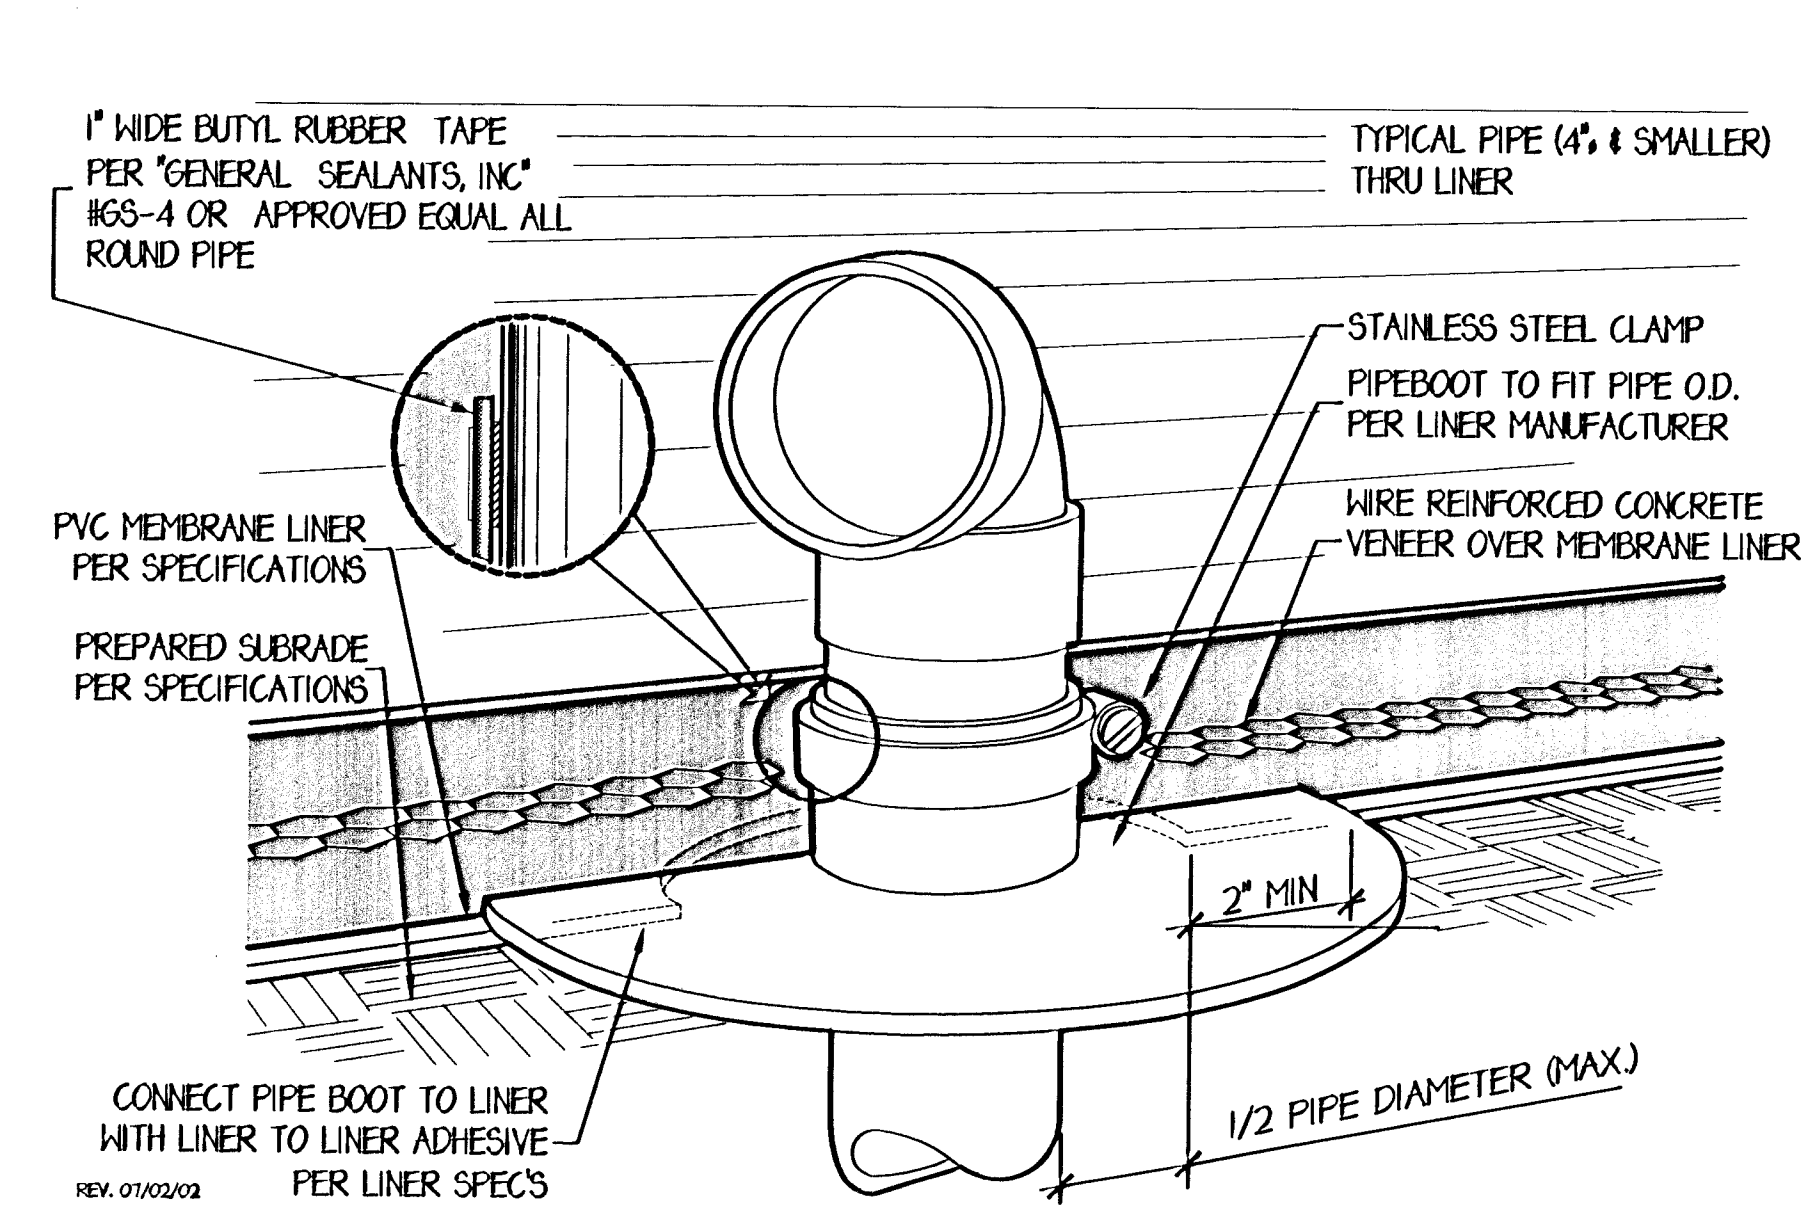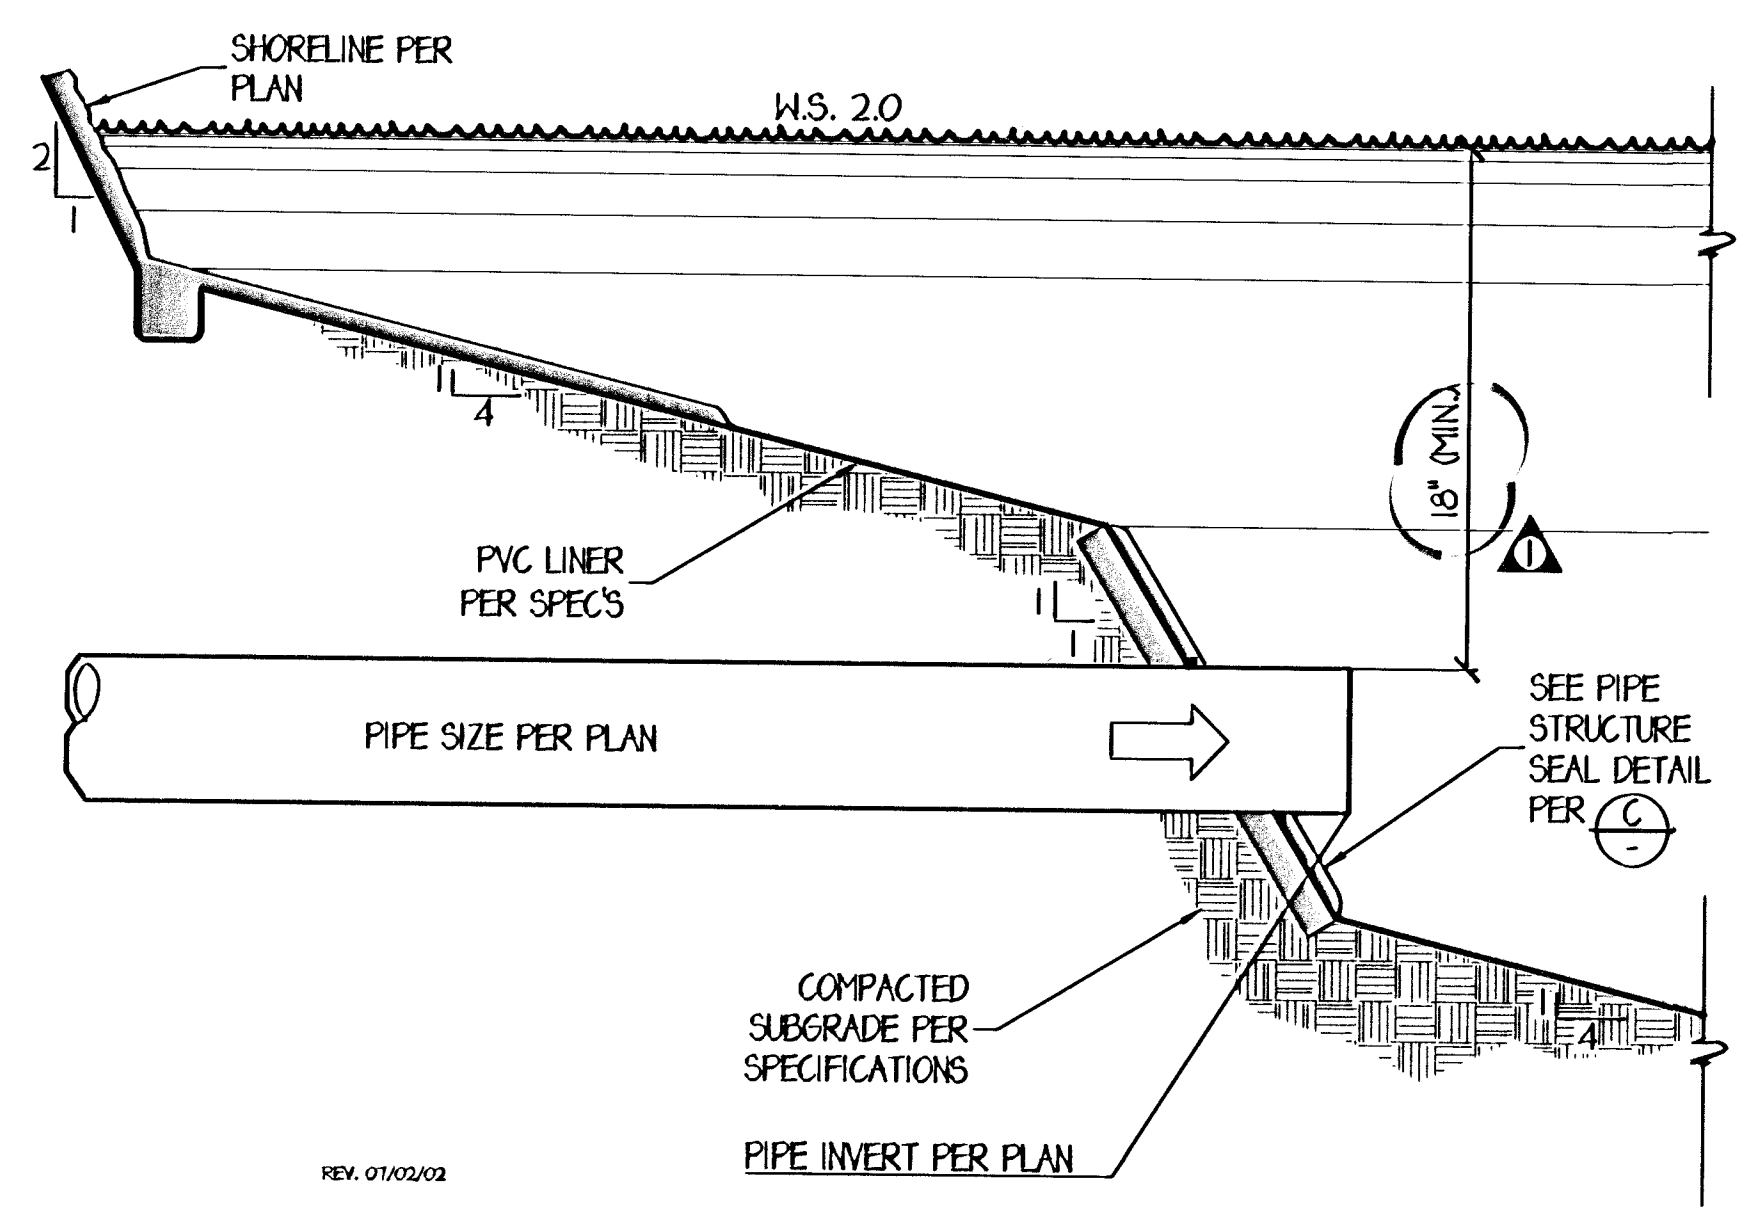

**DISCHARGE PIPE**

**PIPE BOOT**




**PIPE STRUCTURE SEAL**

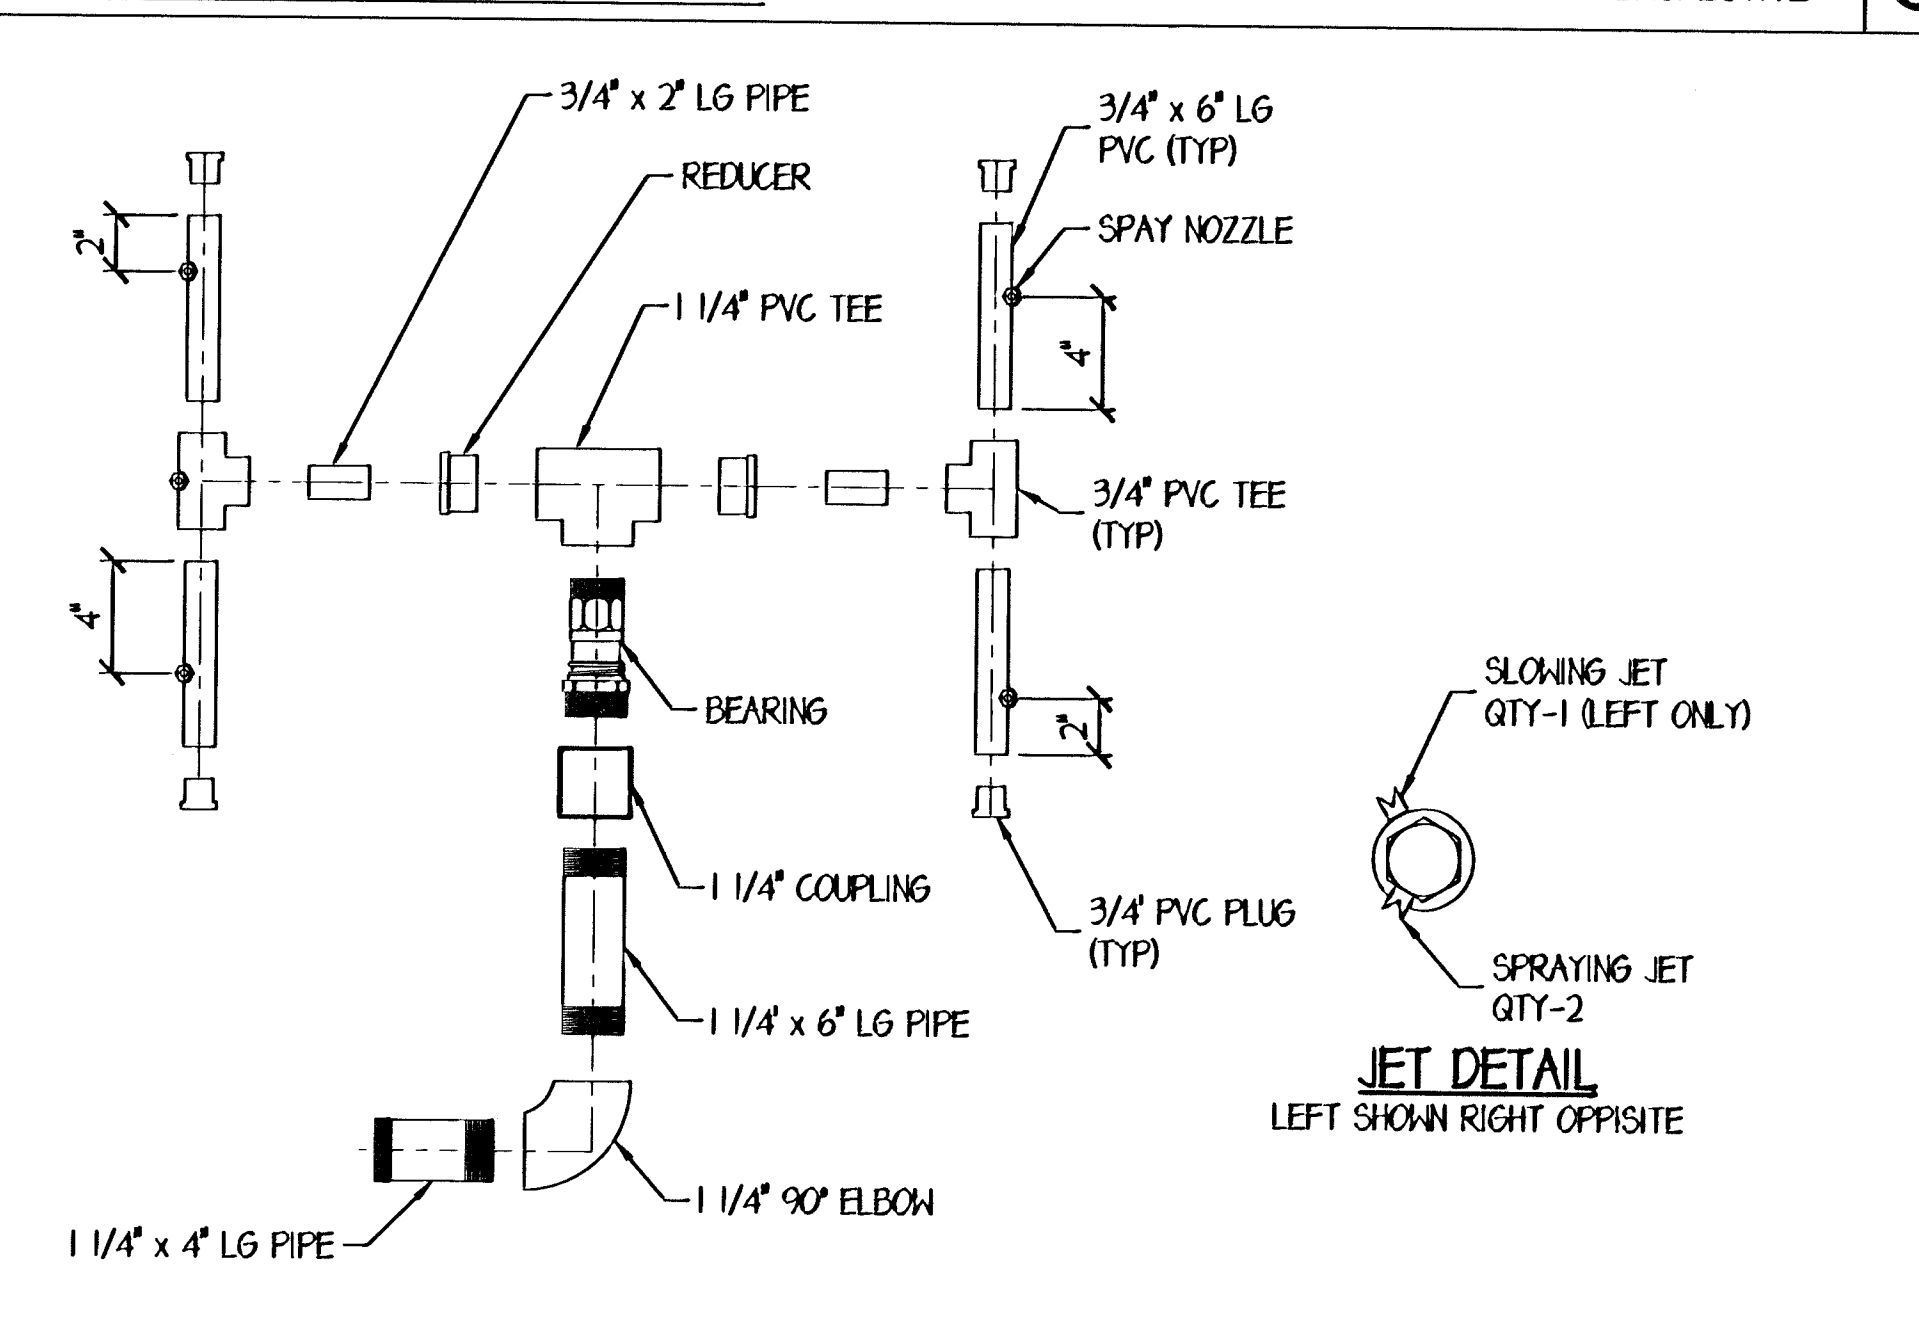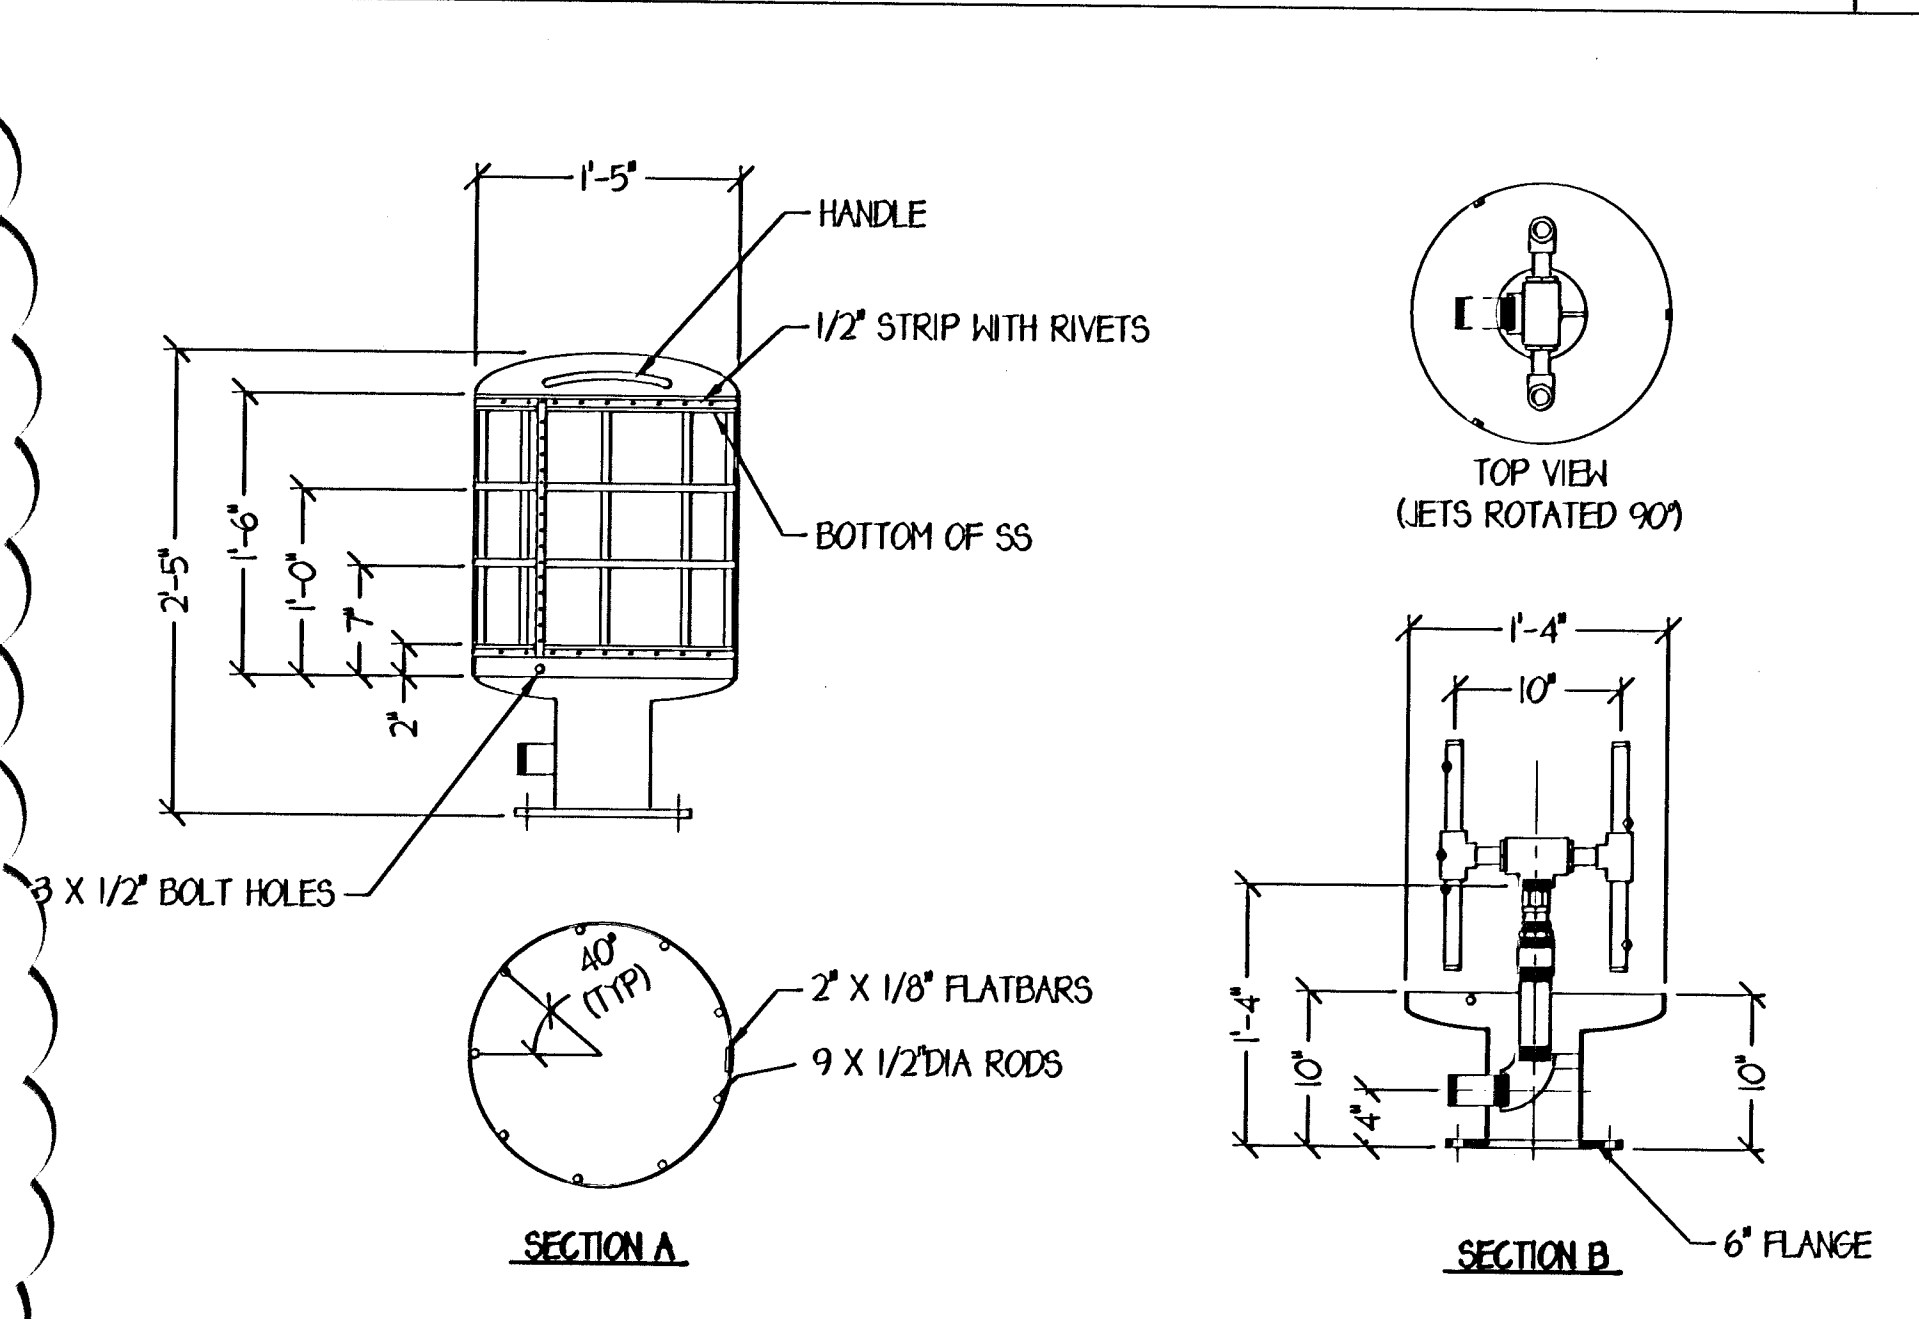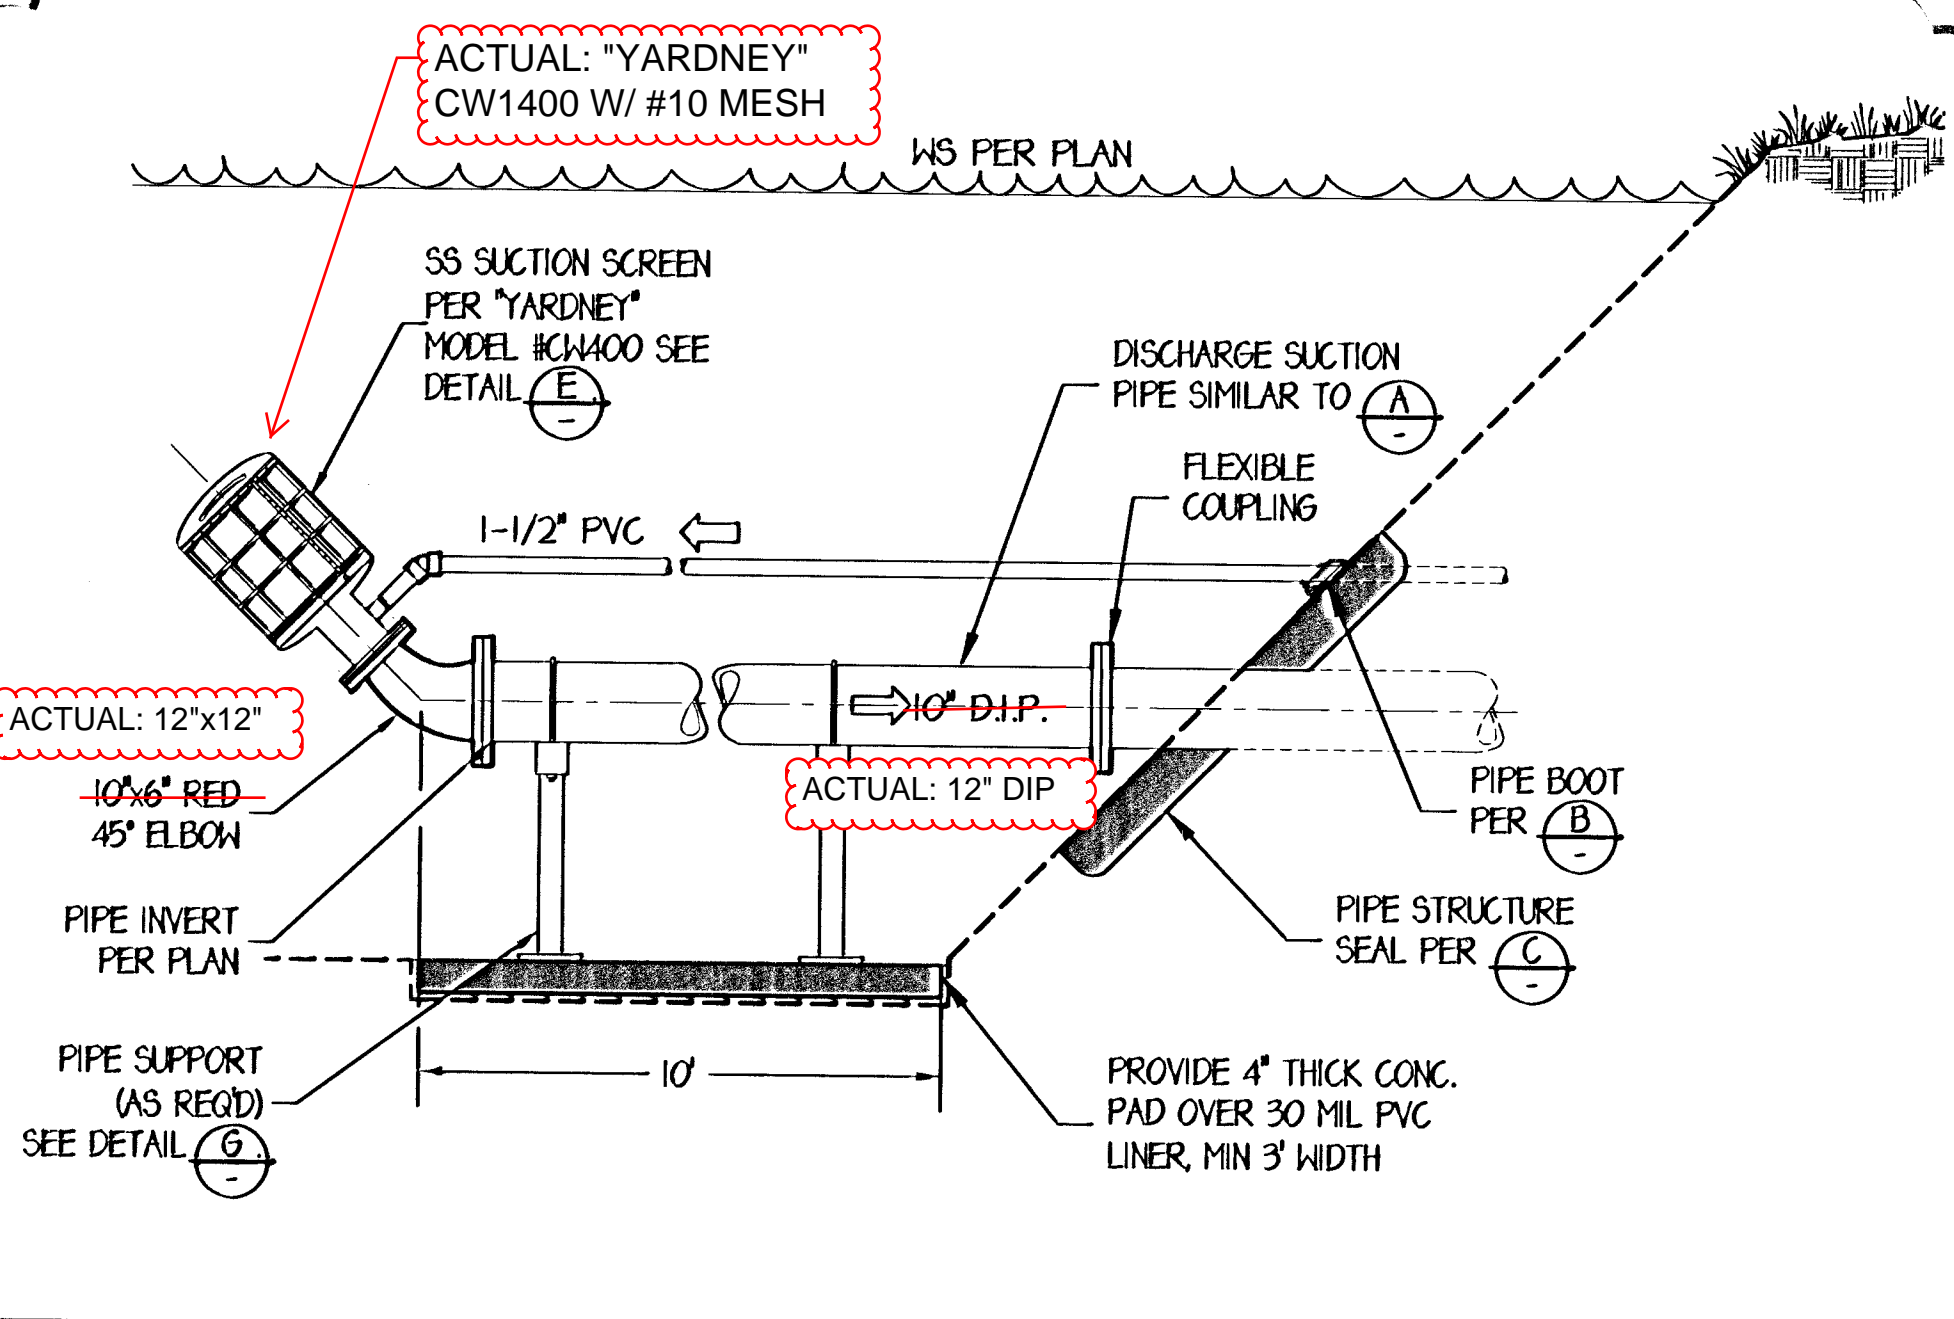

**10\"/>**

**SUCTION SCREEN ASSEMBLY**

**SUCTION SCREEN CW400**

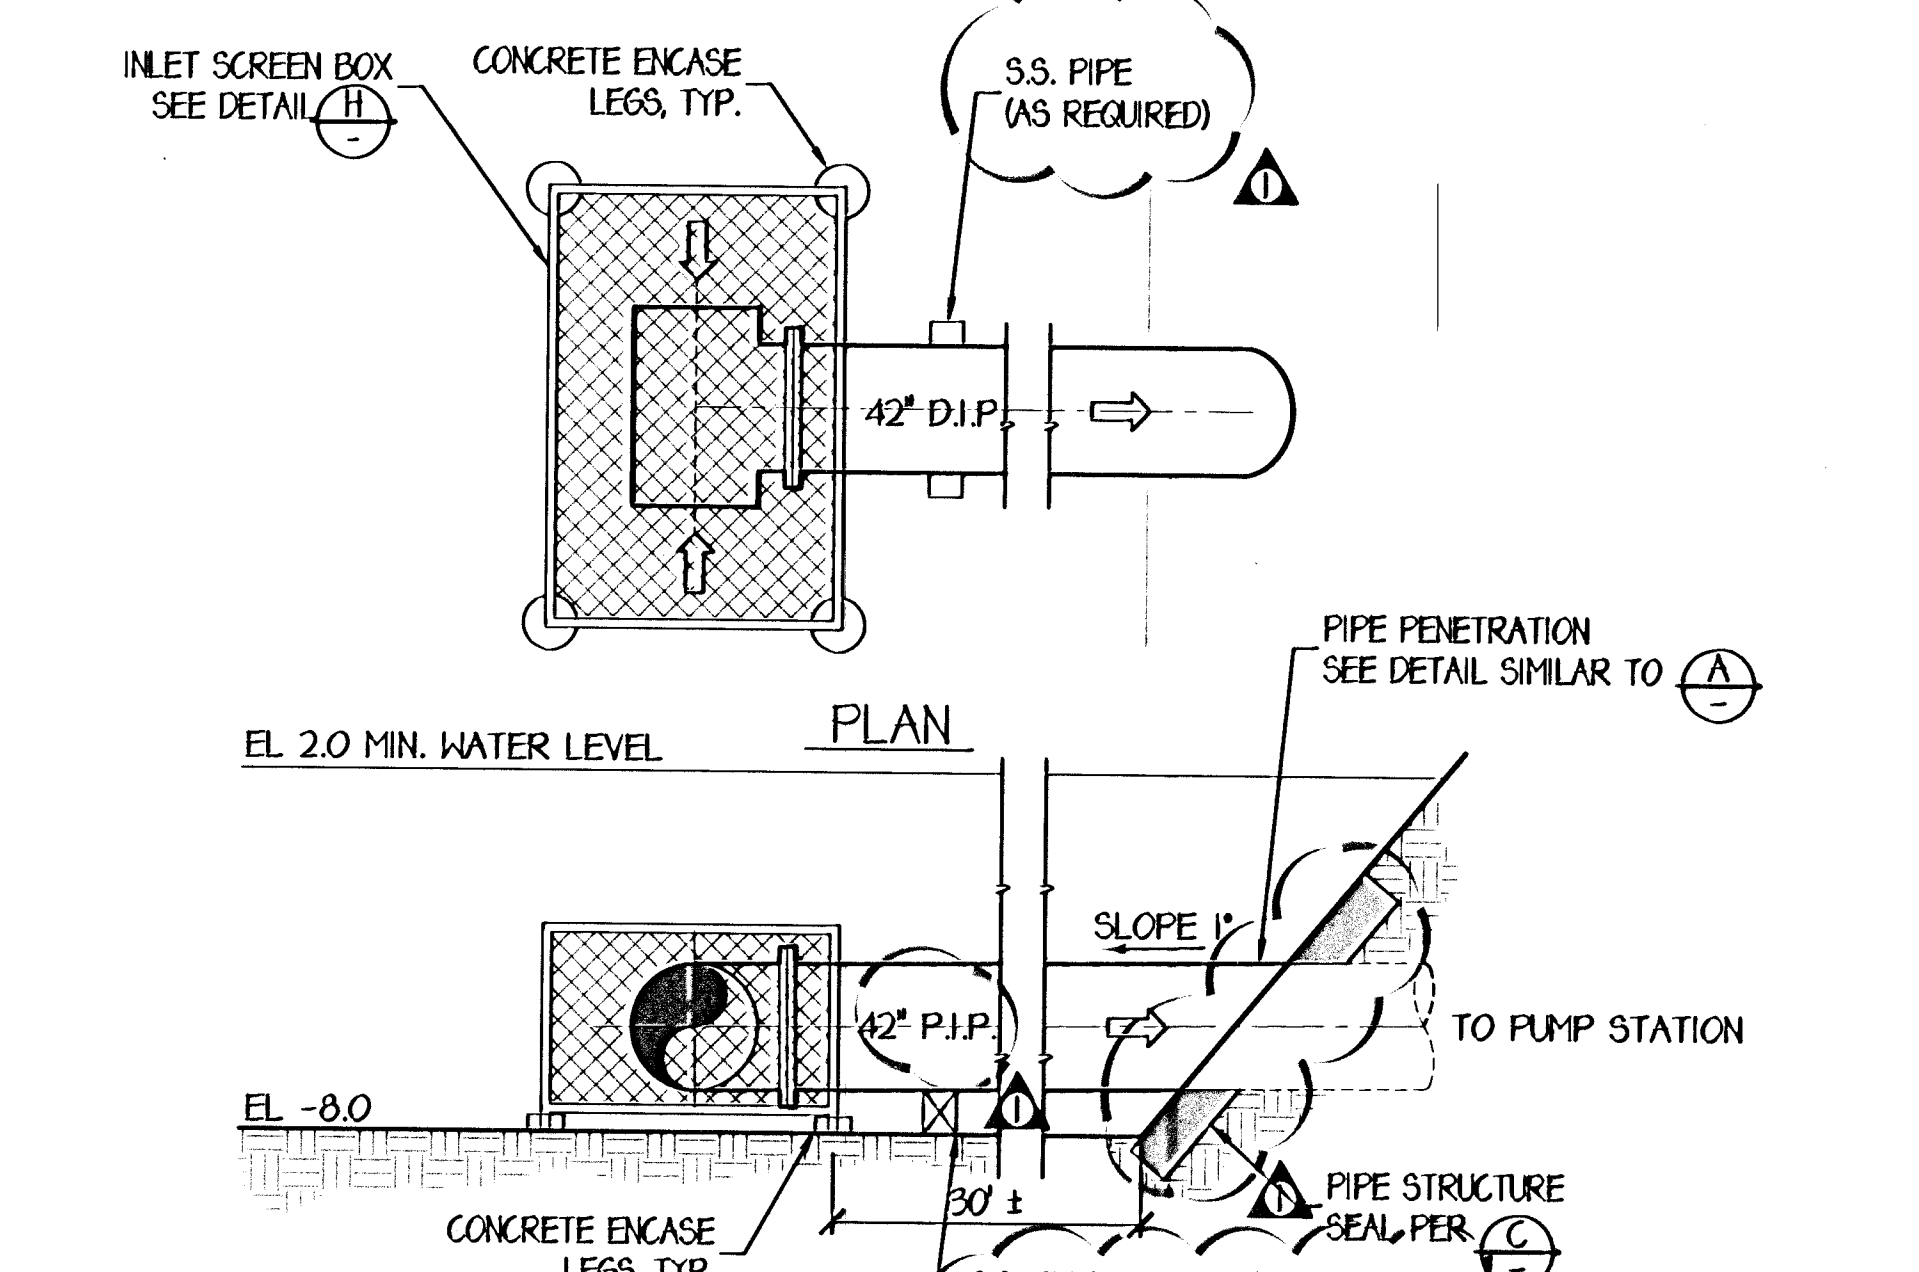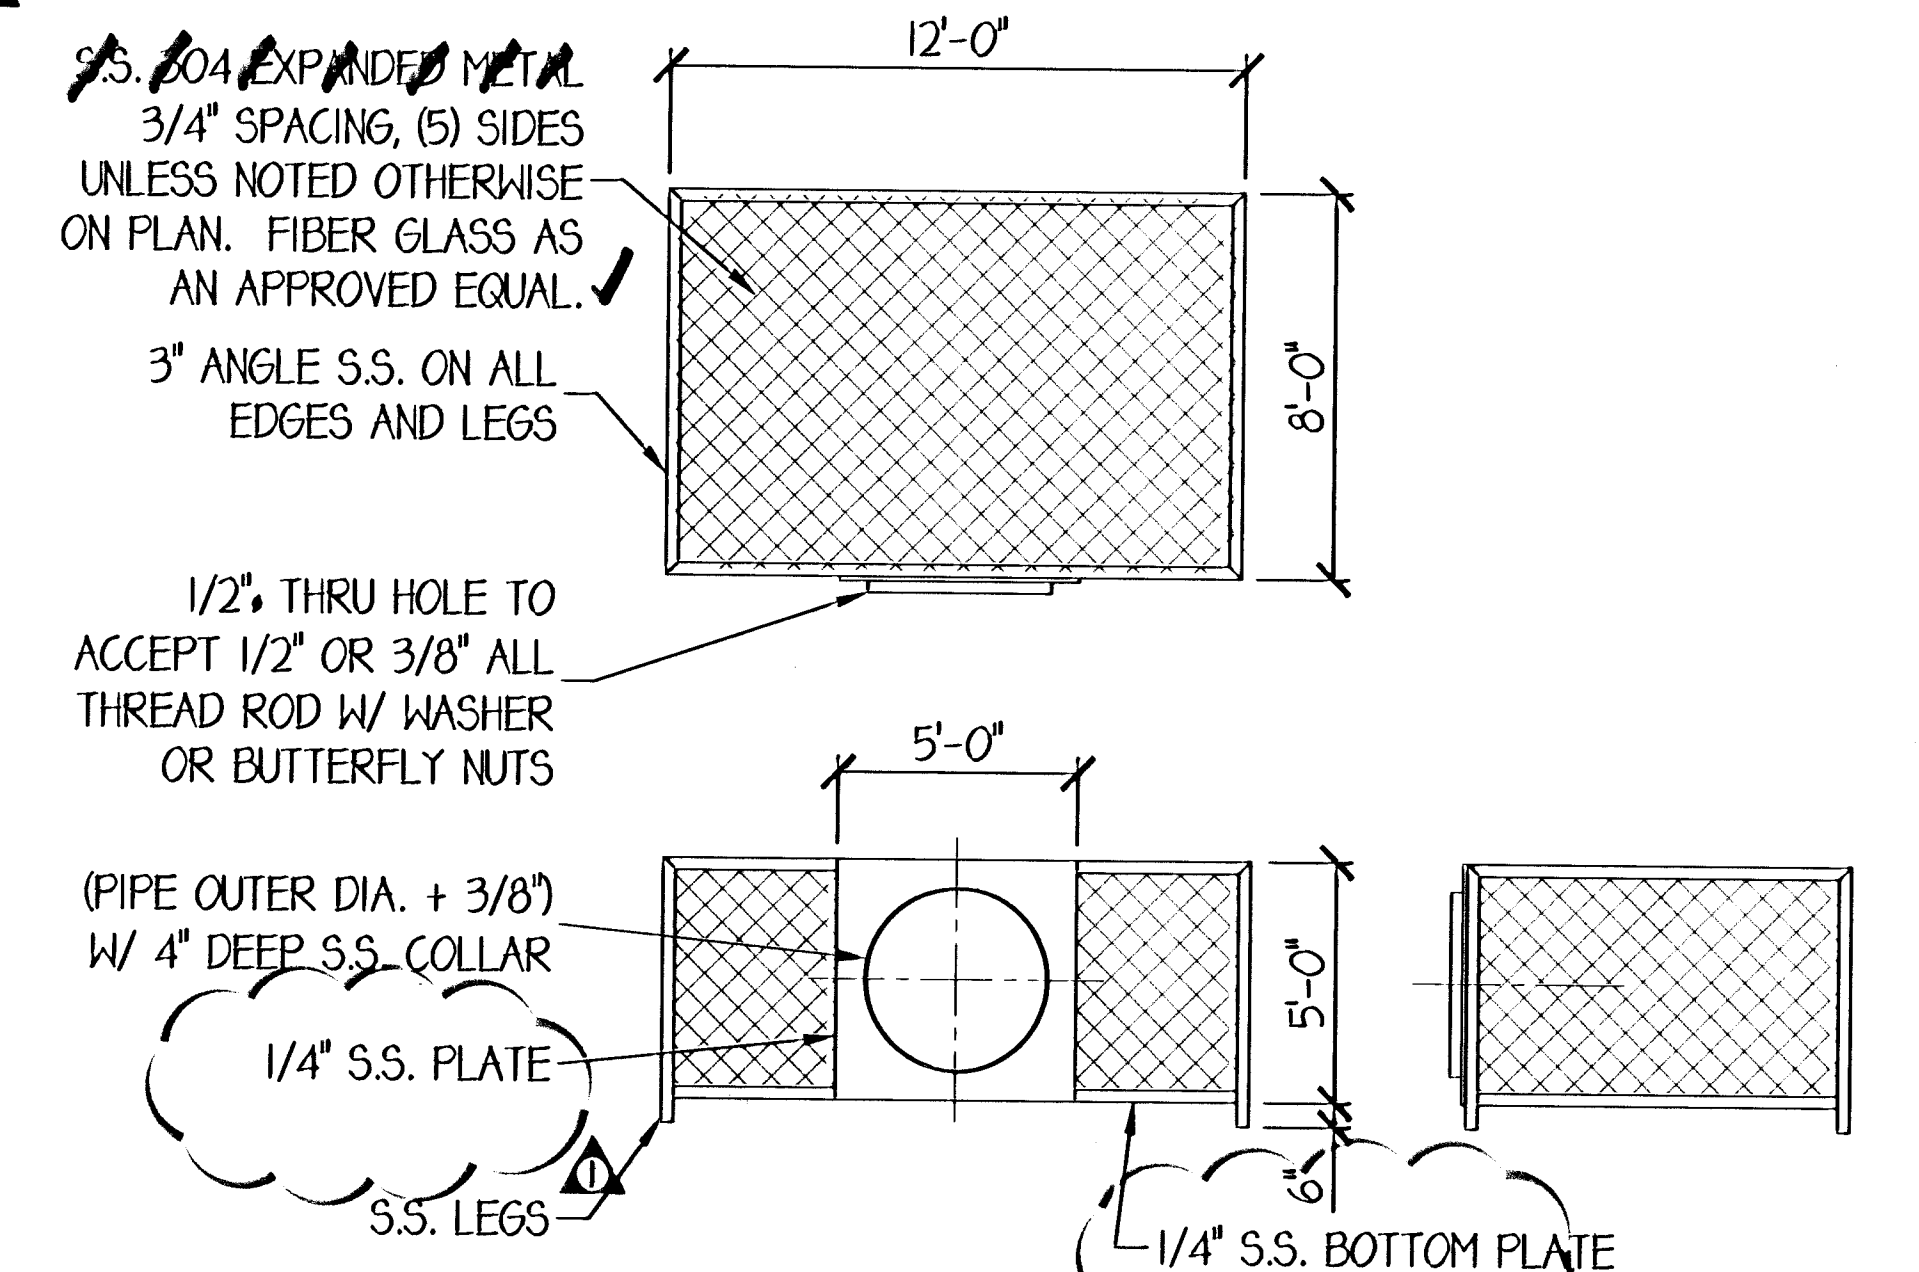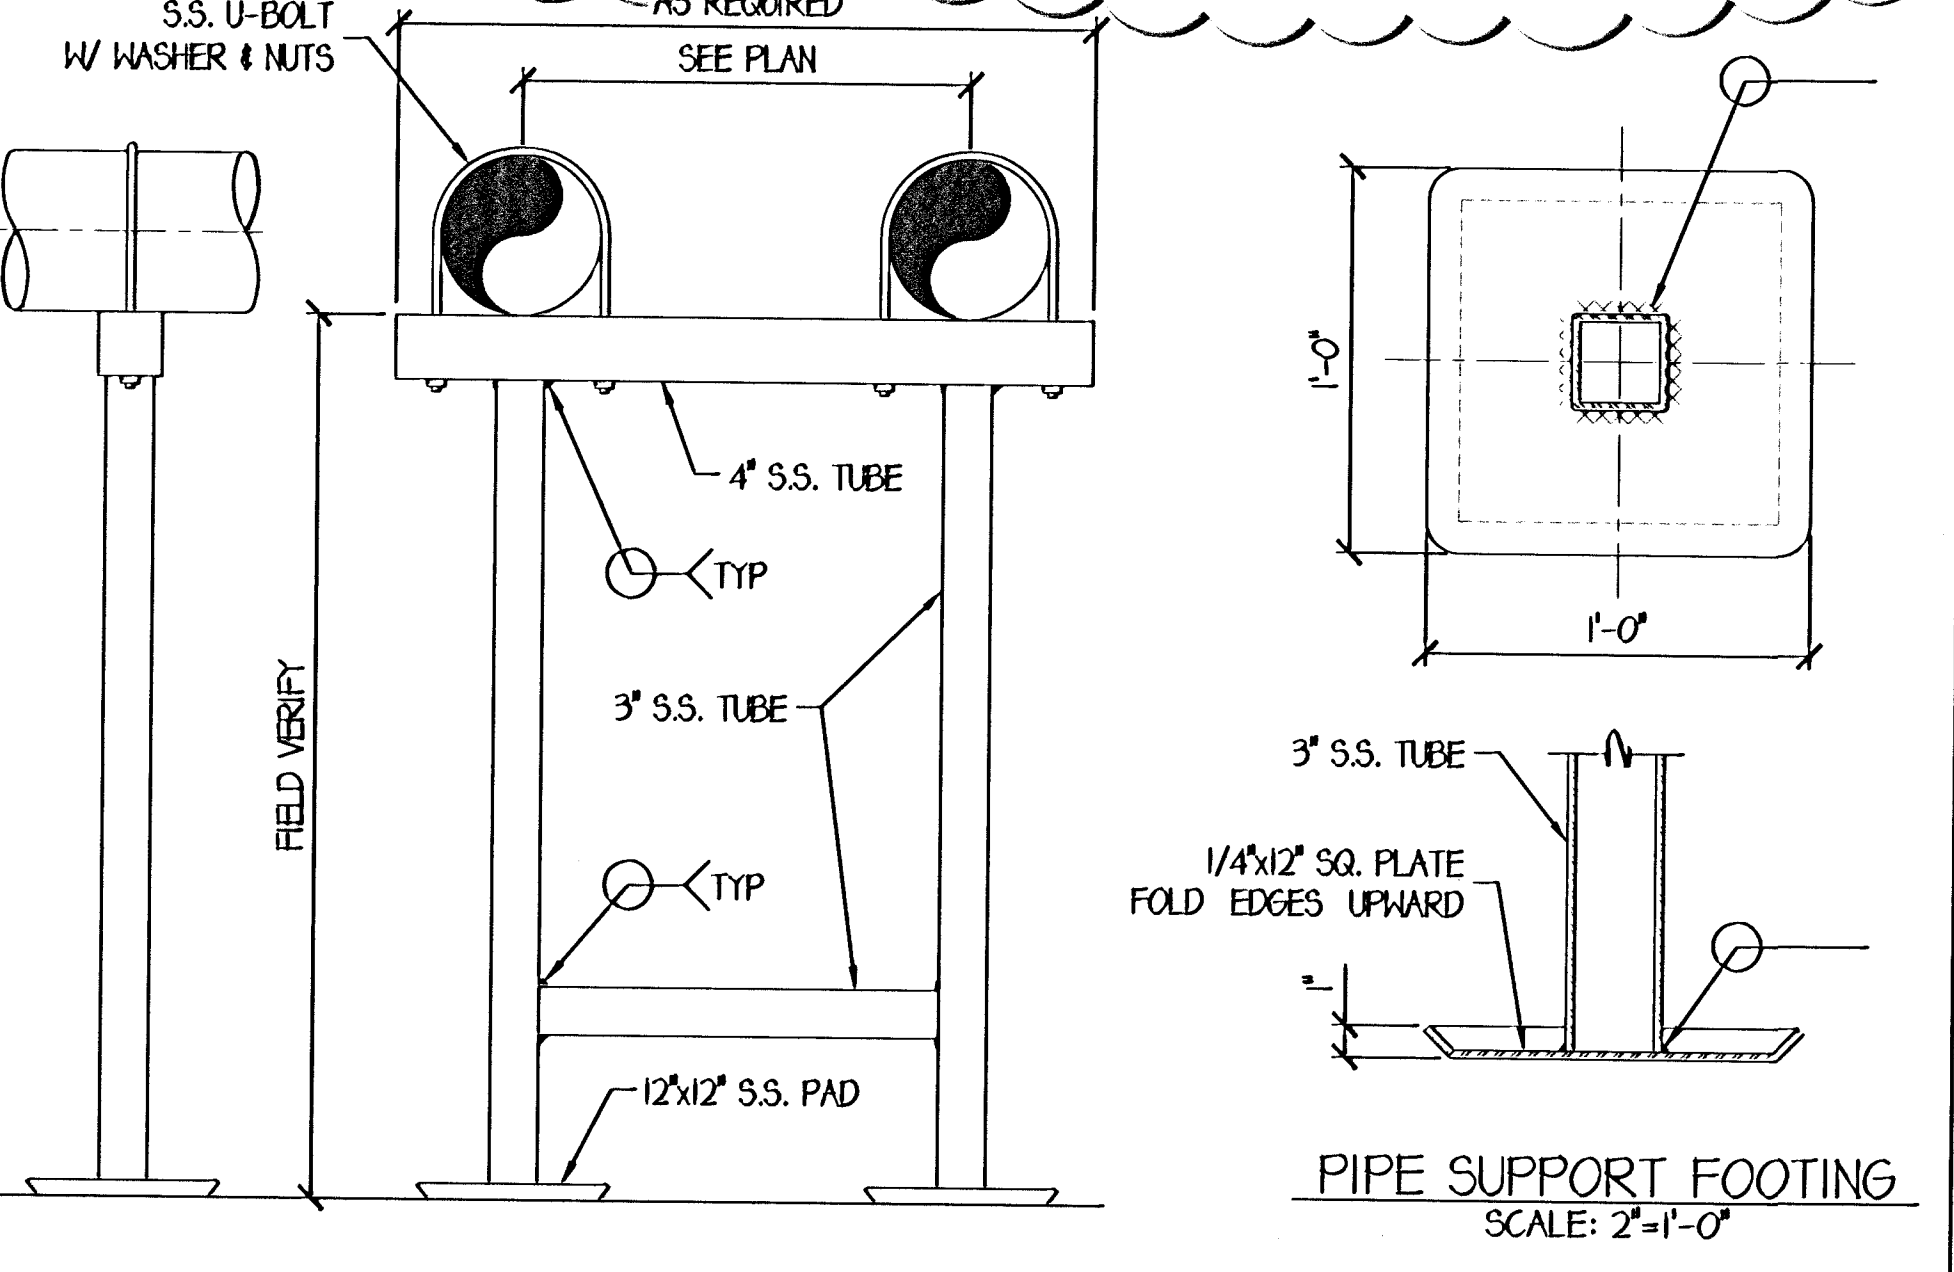

**PIPE SUPPORT**

**INLET SCREEN BOX**

**INTAKE DETAIL**

NO.	BY	DATE	REVISIONS
1	JP	11-27-08	PER CITY COMMENTS
2	JP	11-27-08	PER CITY COMMENTS

PREPARED BY SCANNY O. SIM	PROJECT ENGINEER R.C.E. NO. 11-55816	SCALE AS SHOWN	DATE 04/27/05
EXP. 12/31/05	ISSUED BY S.O.S./J.N.	CHECKED BY S.O.S.	

**WATER FEATURE DETAILS**

**CYPRESS GROVE**


**PRACE**  
PACIFIC ADVANCED CIVIL ENGINEERING  
17520 NEWHOPE STREET, SUITE 200  
PH (714) 481-7299 FAX (714) 481-7299

SHEET **L04** OF 07 SHEETS  
JOB NO. 8117-E


Xrefs: 3524.dwg, Water Quality Filter02.dwg  
 Dimstyle = 1; Ltext = 0.5; Pstyle = 1; Maxtext = 1  
 P:\117E\Engineering\8117E-10\sheet\8117-L04.dwg - Tab: Layout1 By: gilligan on May 04, 2005 at 03:53 pm

THESE DRAWINGS ARE THE PROPERTY OF PRACE AQUASCAPE AND SHALL NOT BE REPRODUCED IN ANY MANNER NOR BE USED FOR CONSTRUCTION UNLESS STAMPED "ISSUED FOR CONSTRUCTION".



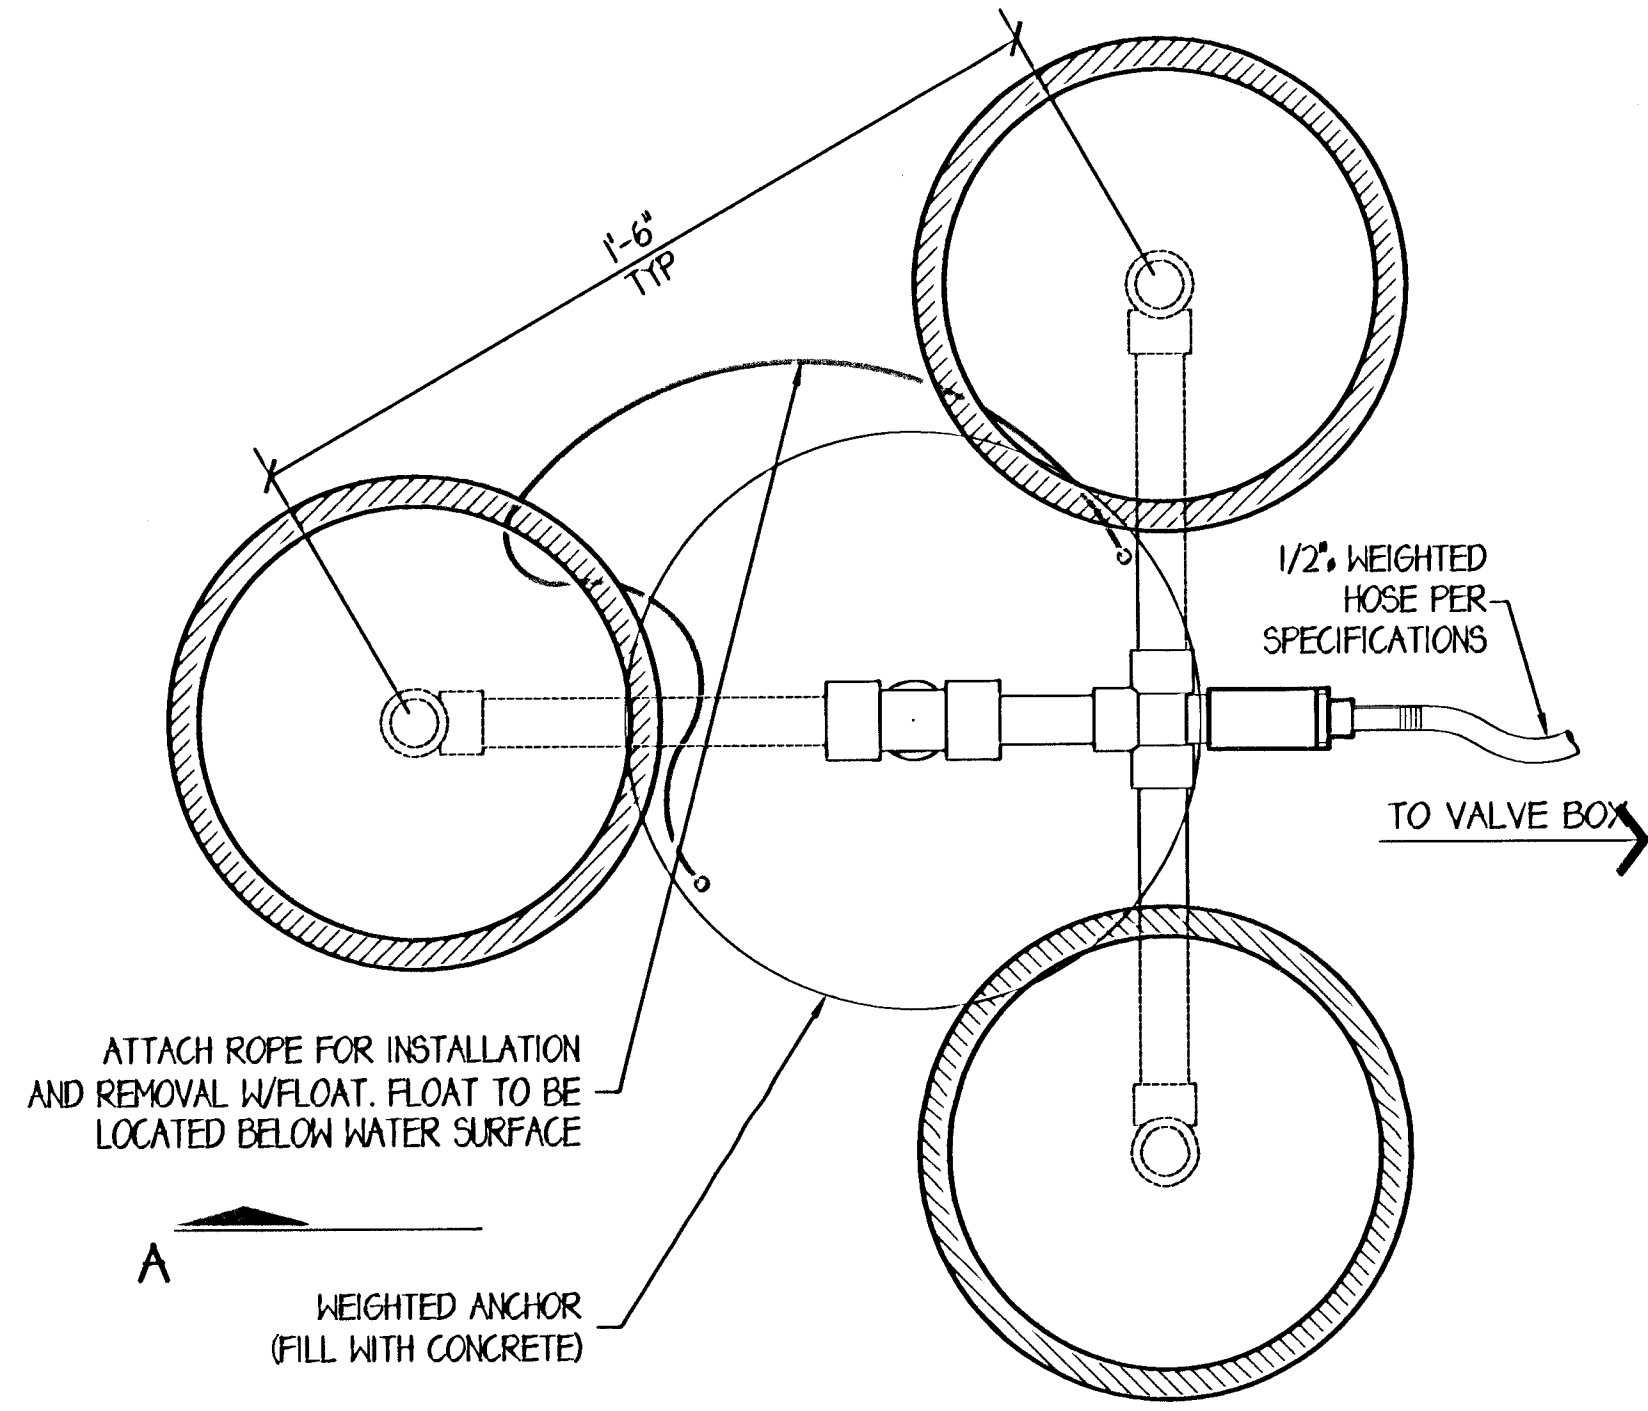


PLAN

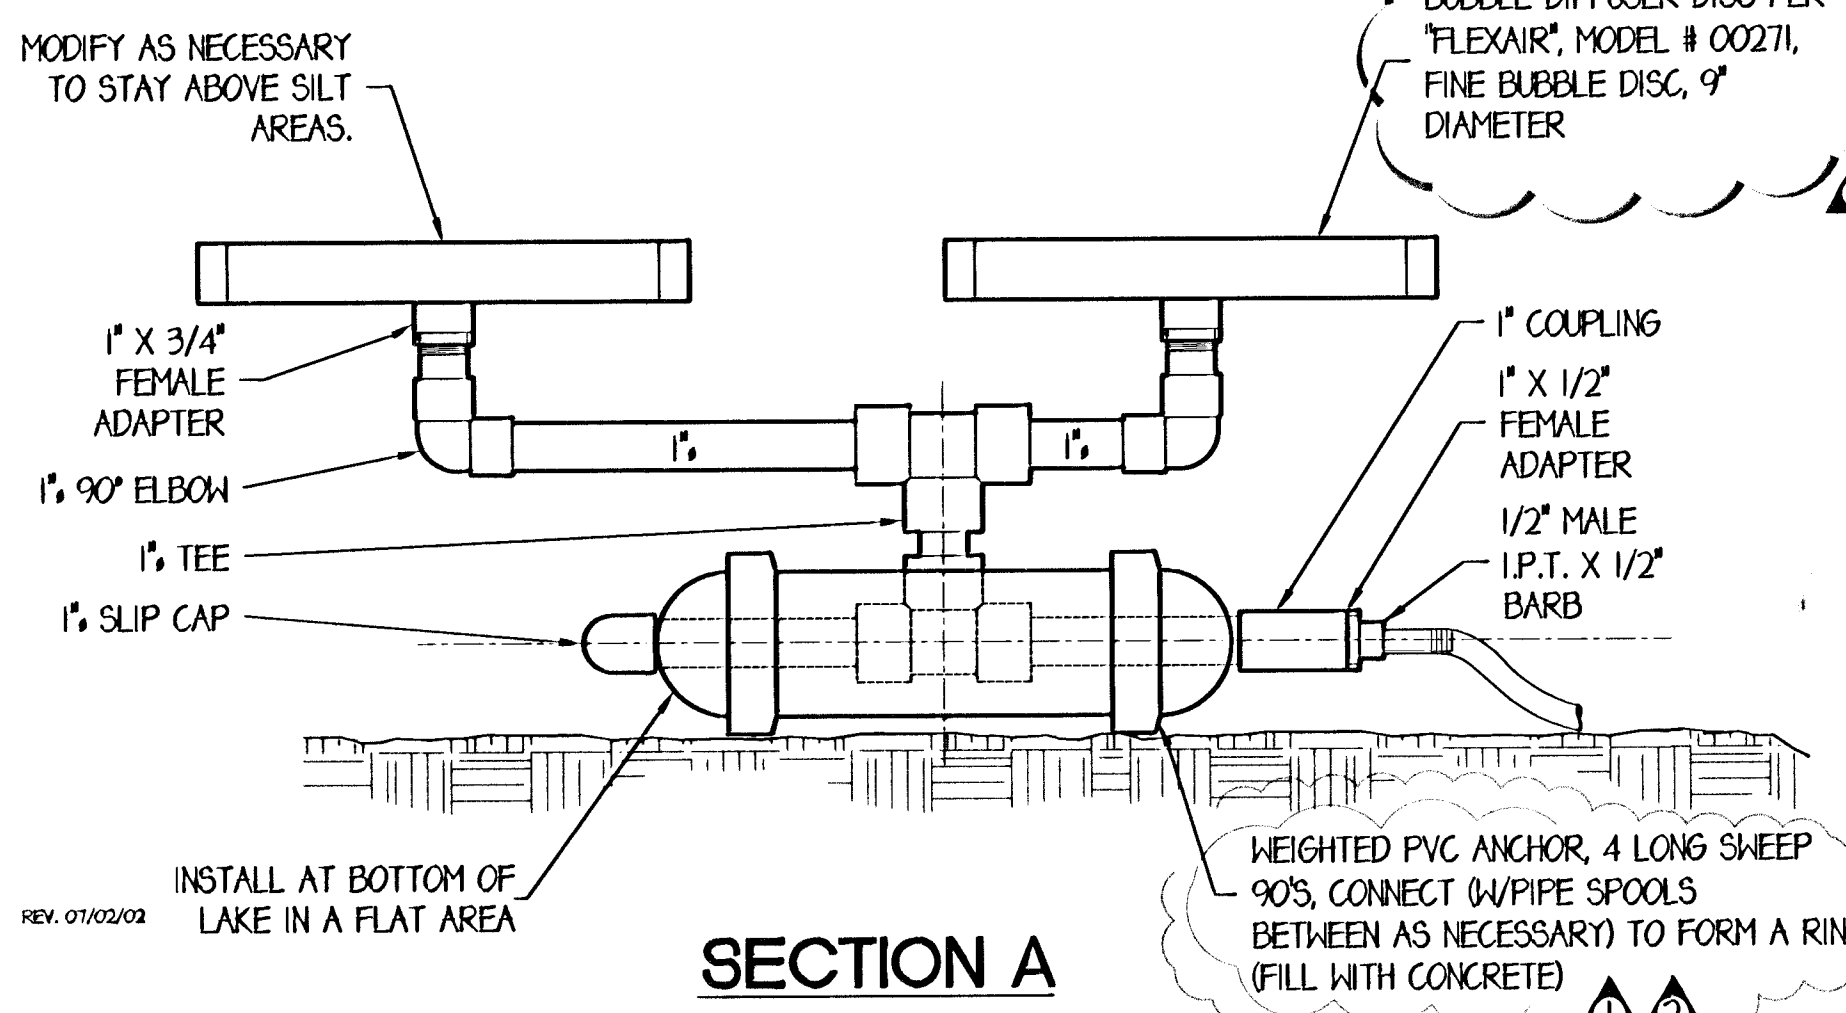


SECTION A

AERATION BUBBLE DIFFUSER 3'-1'-0"

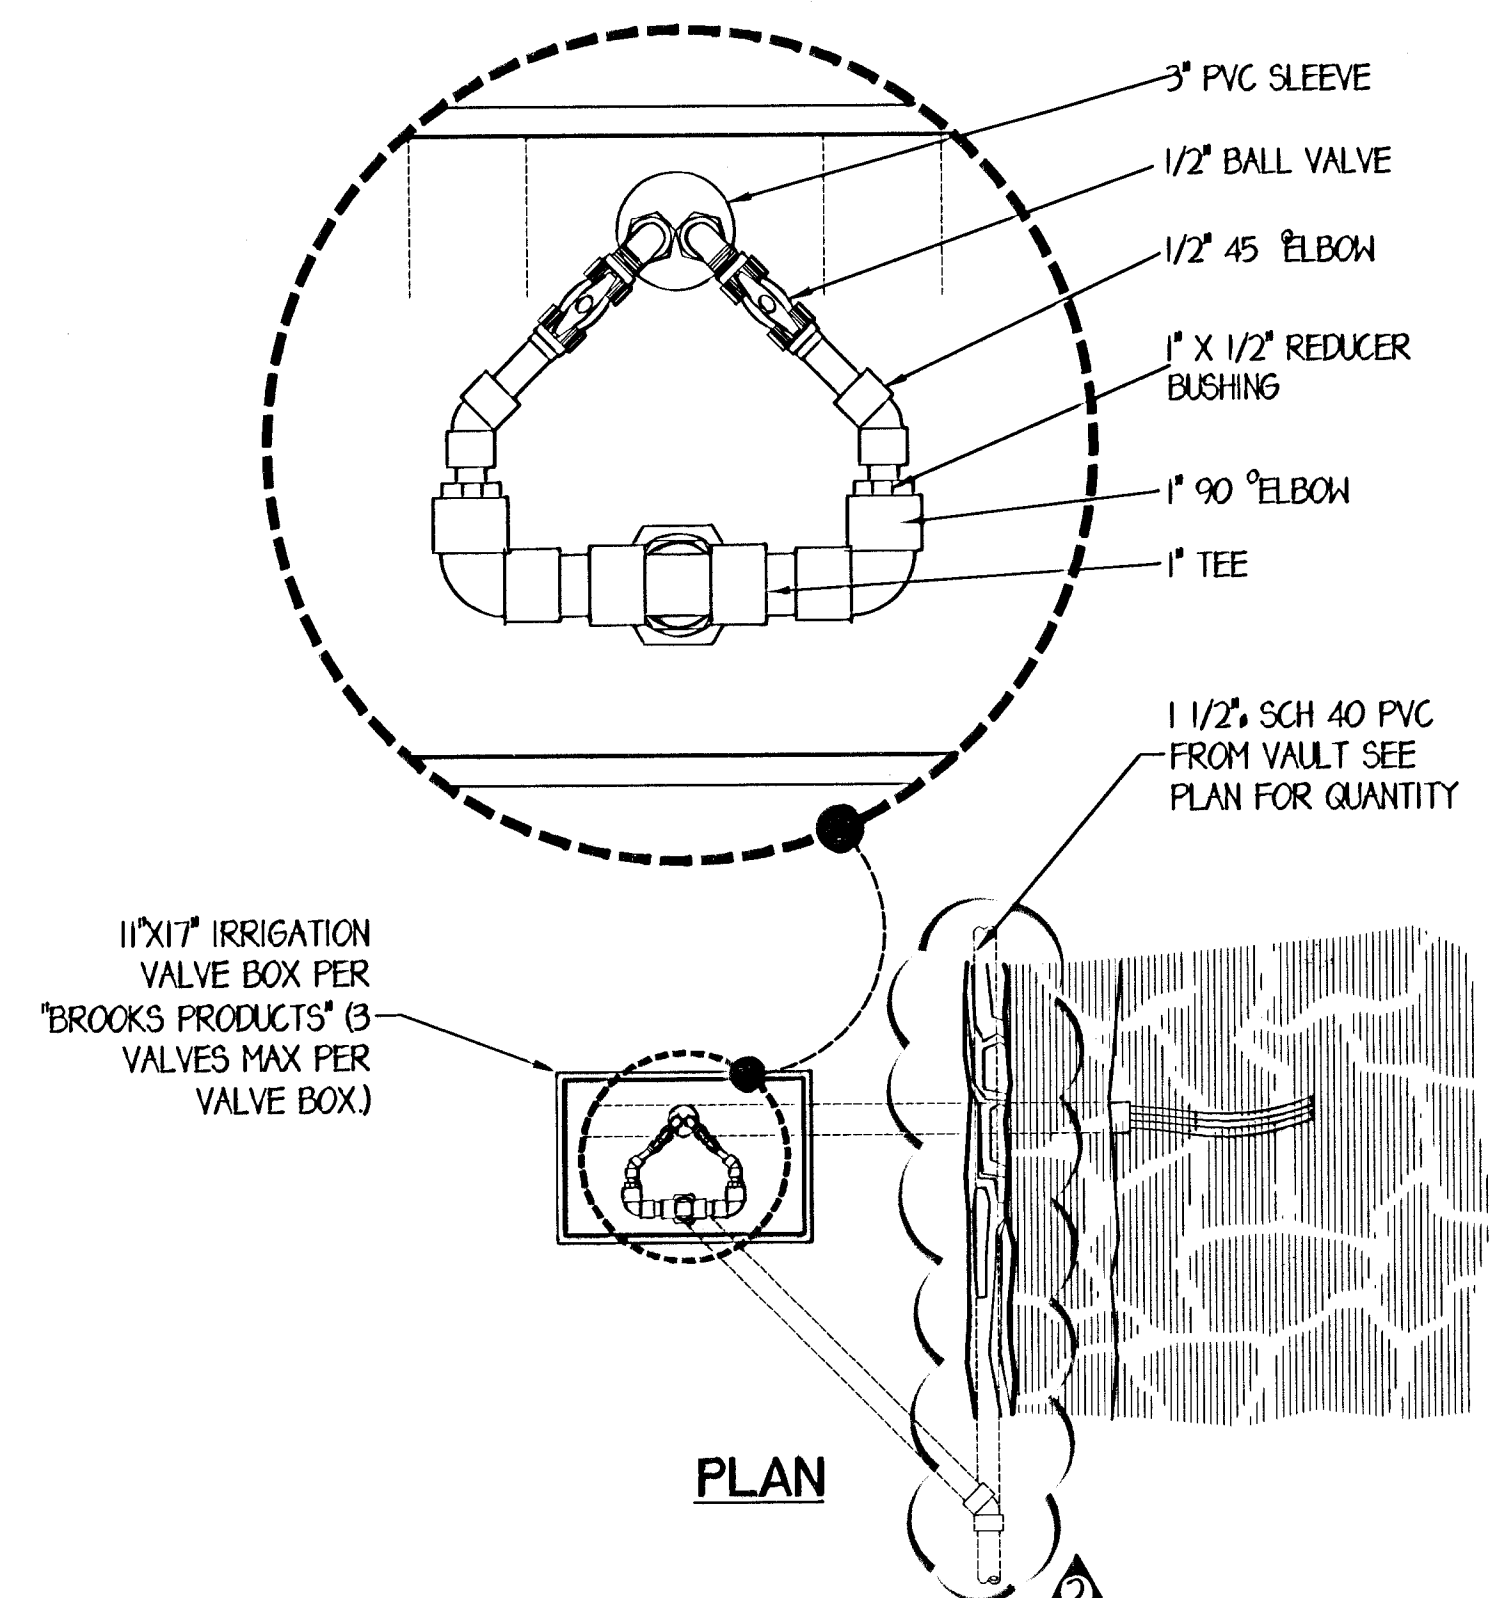


PLAN

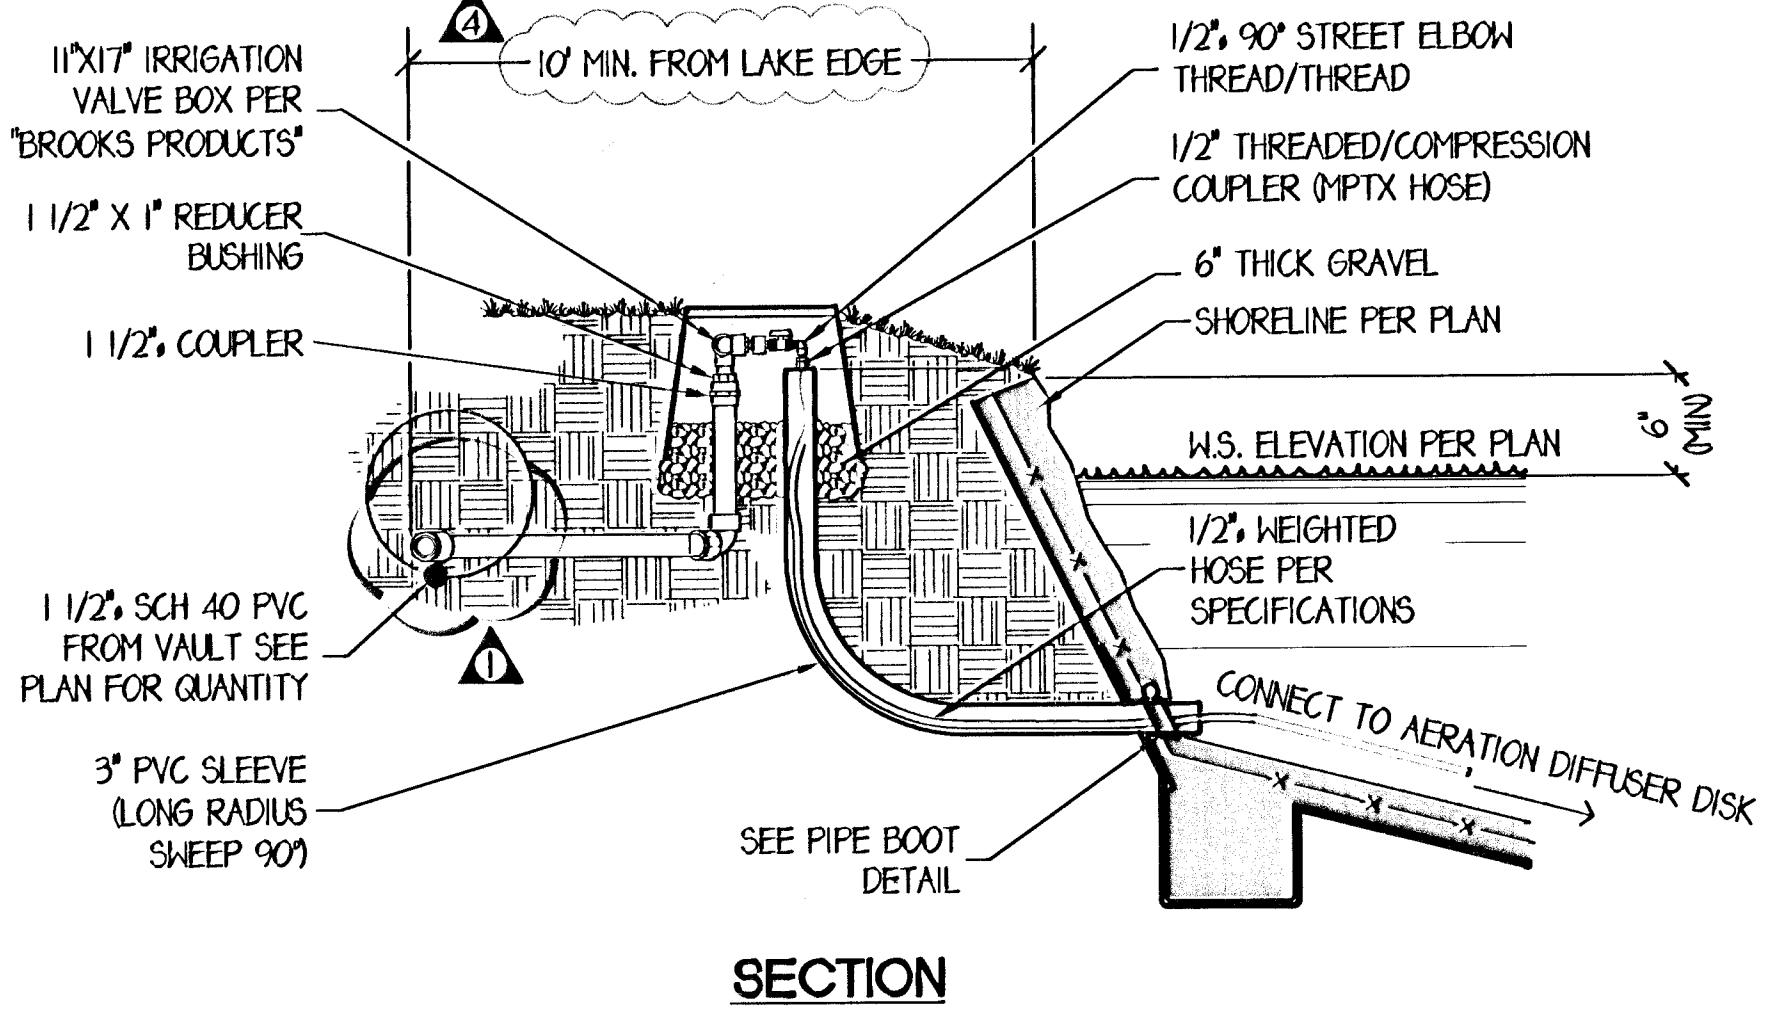


SECTION


AERATION VALVE BOX 1'-1'-0"

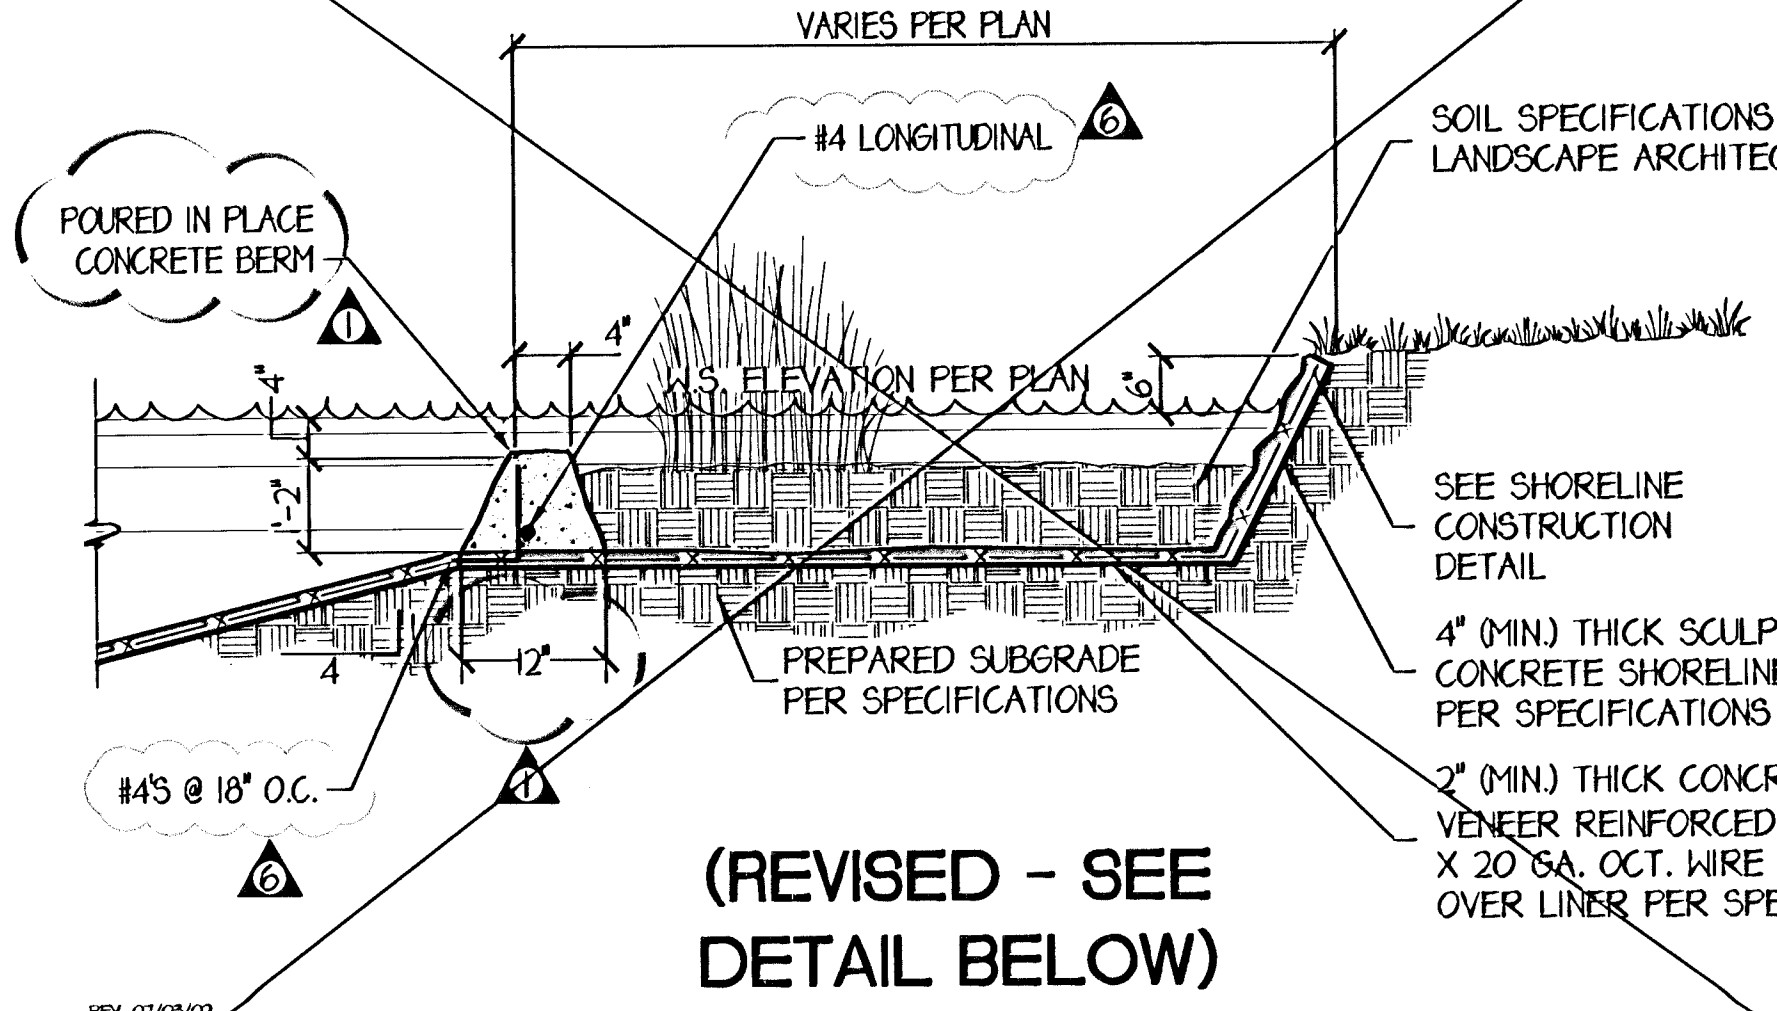


PLANTER SHELF SHORELINE

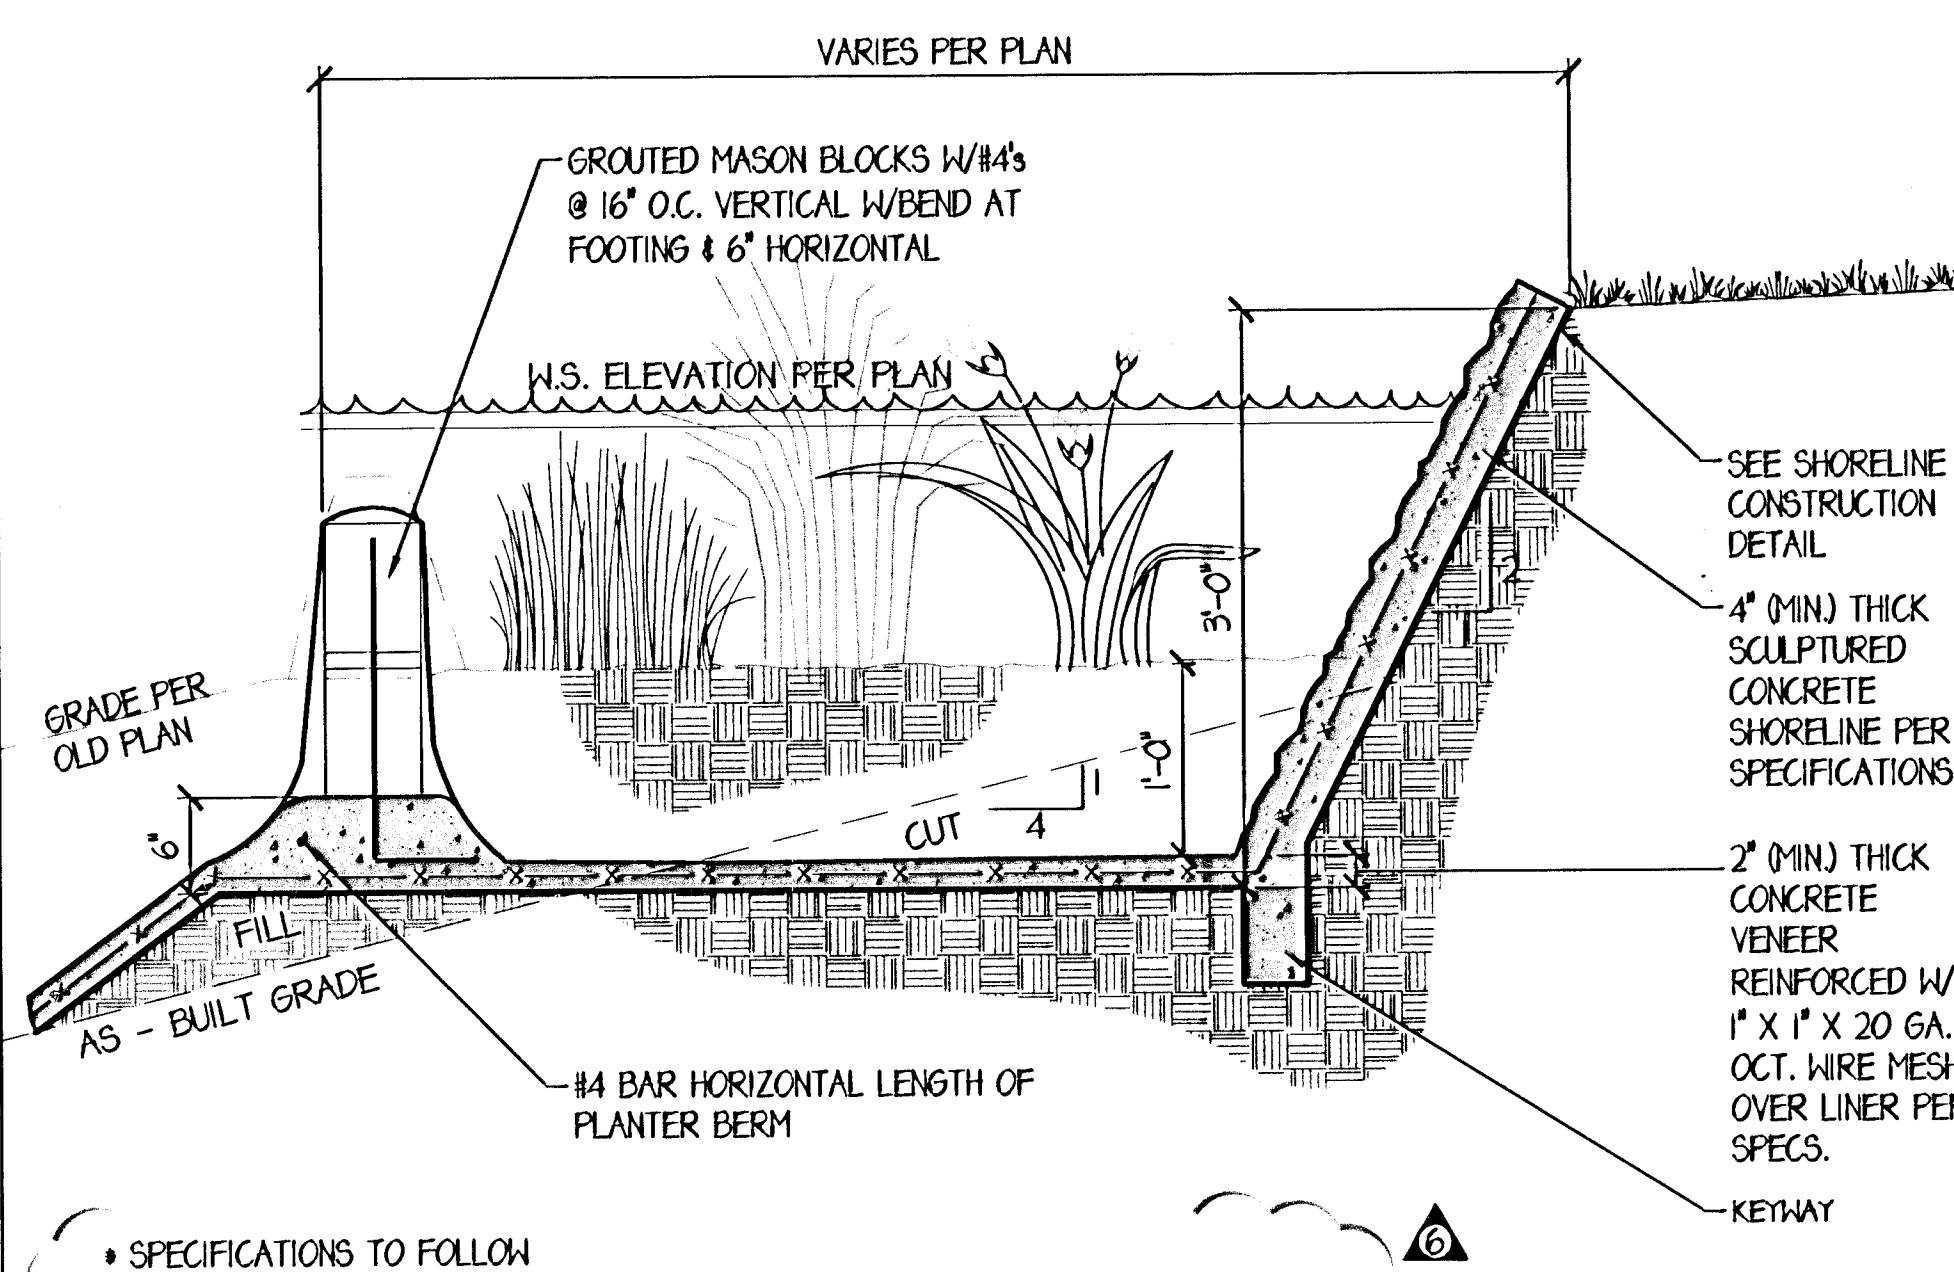

PLANTER SHELF SHORELINE - REVISED 1'-1'-0"

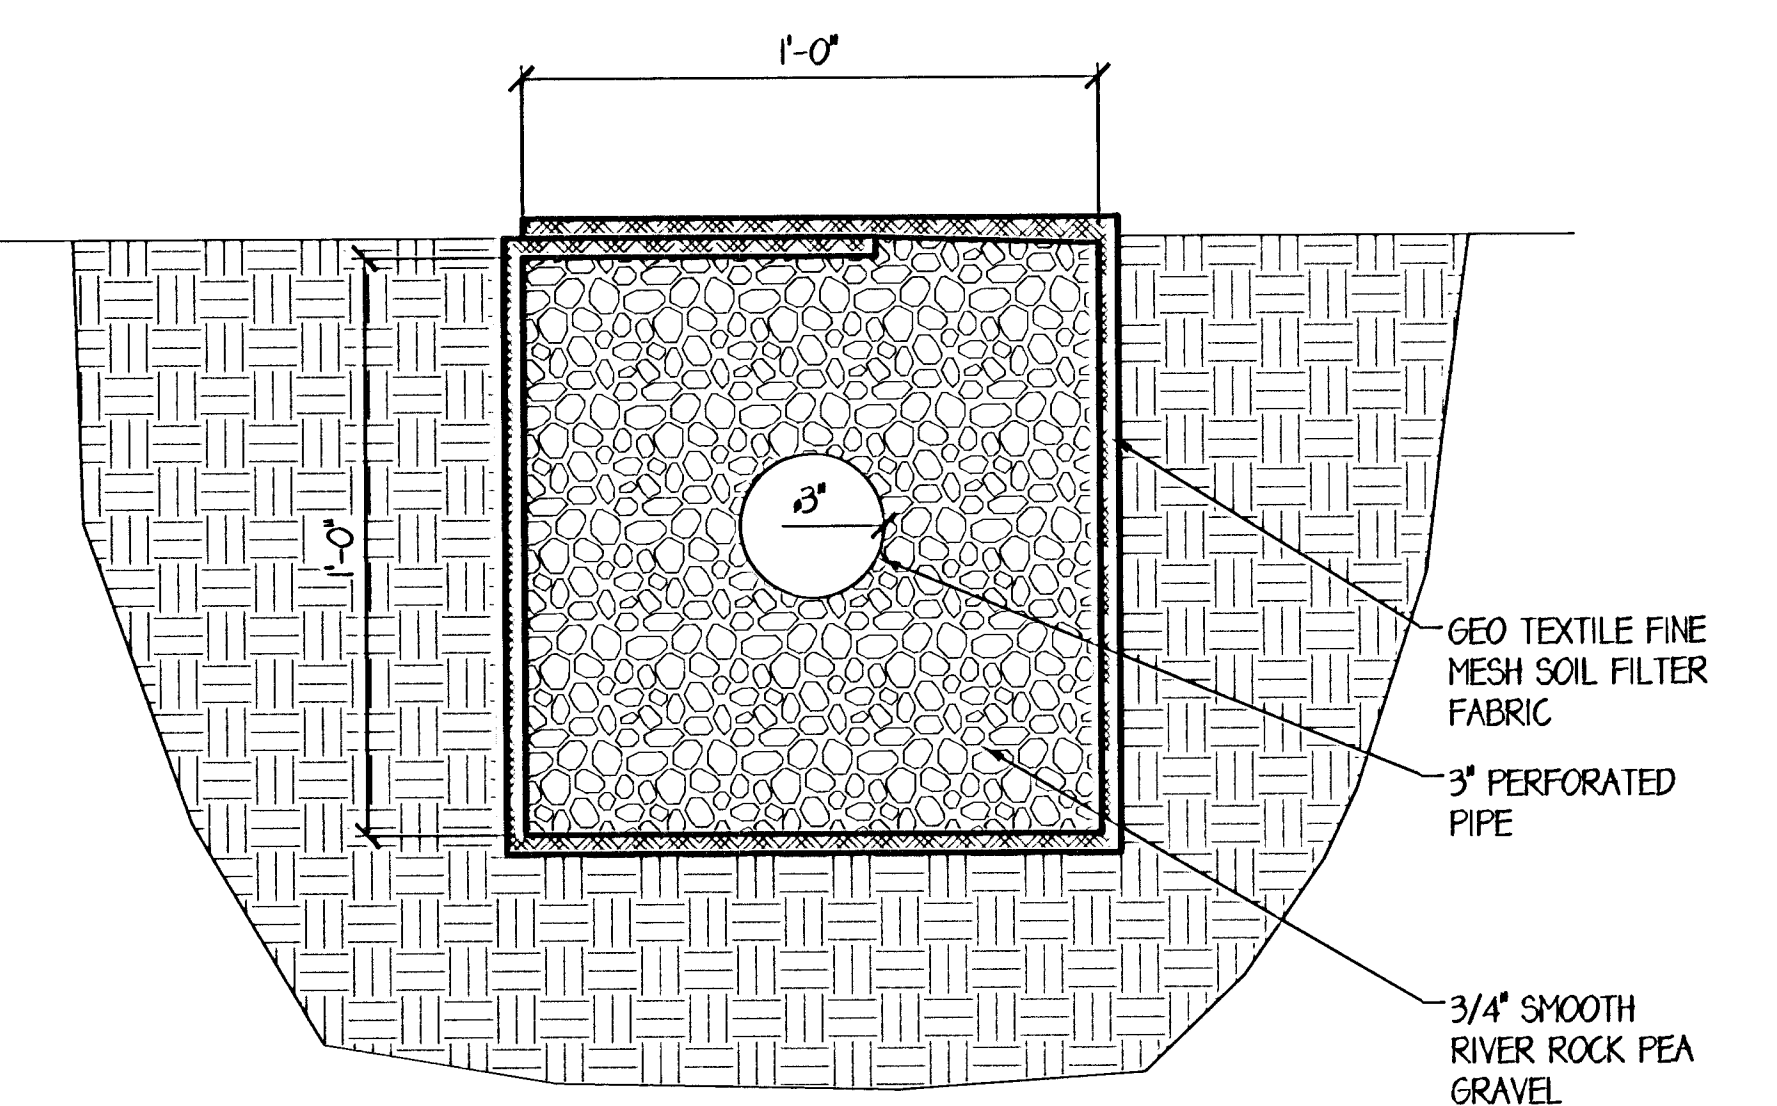

3\"/>

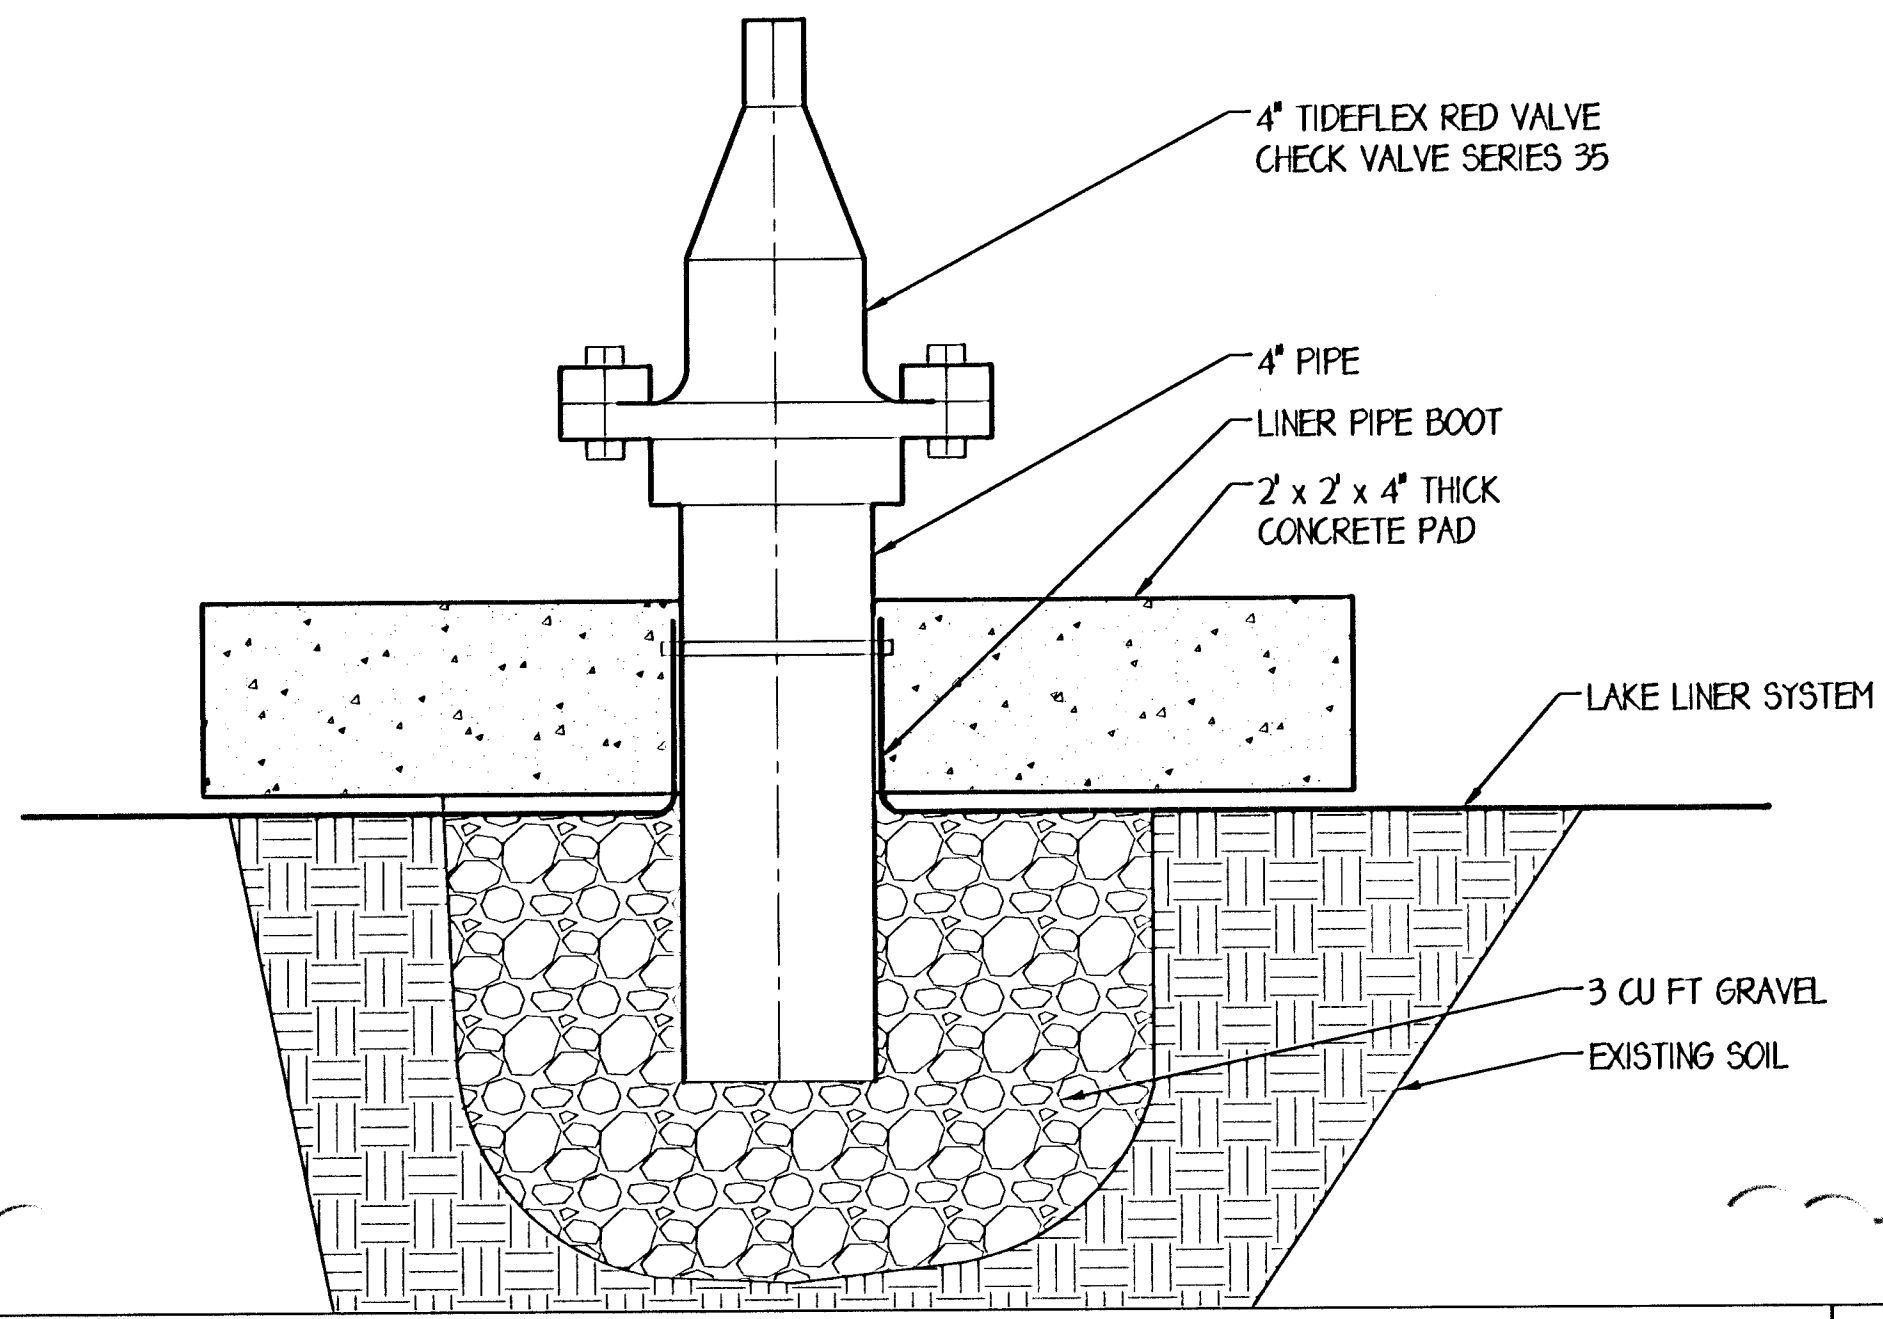

HYDROSTATIC RELIEF VALVE 3'-1'-0"

NOTE: DETAILS A & B NOT SHOWN

PER CITY COMMENTS - PRIOR TO APPROVAL	11/9/05	AP
PER CITY COMMENTS - PRIOR TO APPROVAL	11/27/05	AP
PER CITY COMMENTS - PRIOR TO APPROVAL	5/16/05	DC
PER CITY COMMENTS - PRIOR TO APPROVAL	5/16/05	DC
IRRIGATION FILTER	7/8/05	BR
WETLAND PLANTER	8/7/05	BR
HYDROSTATIC RELIEF	8/26/05	BR
REVISIONS	NO	BY DATE
	11/9/05	AP
	11/9/05	AP

PREPARED BY	SOVIKY O. SIM
PROJECT ENGINEER	R.C.E. NO. --- # 59816
EXP.	12/31/05
SCALE	
DATE	04/27/05

TITLE	WATER FEATURE DETAILS
-------	-----------------------

**CYPRESS GROVE**

AKLEY

**PACIFIC ADVANCED CIVIL ENGINEERING**

11700 MOUNTAIN VALLEY, CA 92706  
 PH (714) 481-7300 FAX (714) 481-7299

SHEET **L05** OF 07 SHEETS


JOB NO. 8117-E

Xrefs: 36024.rdw Dimscale = 1, U'Scale = 1, U'Tocall = 1, U'Locall = 0.5, P'Scale = 1, Acad Ver. = 16.0.6 (LMS Tech), Wrestrain = 1

THESE DRAWINGS ARE THE PROPERTY OF PACIFIC ADVANCED CIVIL ENGINEERING AND SHALL NOT BE REPRODUCED IN ANY MANNER NOR BE USED FOR CONSTRUCTION UNLESS STAMPED "ISSUED FOR CONSTRUCTION".




Xrefs: 8138-10-Tblk.dwg; 8138-x-10p.dwg; 8138-CC.dwg; 8138-SITE.dwg; 8117-ldk.dwg; 8138-PUMP\_SITE.dwg; 8138-UTR66679.dwg; 8138-MECH.dwg; 8138-ARCH.dwg  
 Datecode = 10; Titlecode = 05; PLOTcode = 1; Acad Ver. = 16.06 (LMS Tech); Version = 1

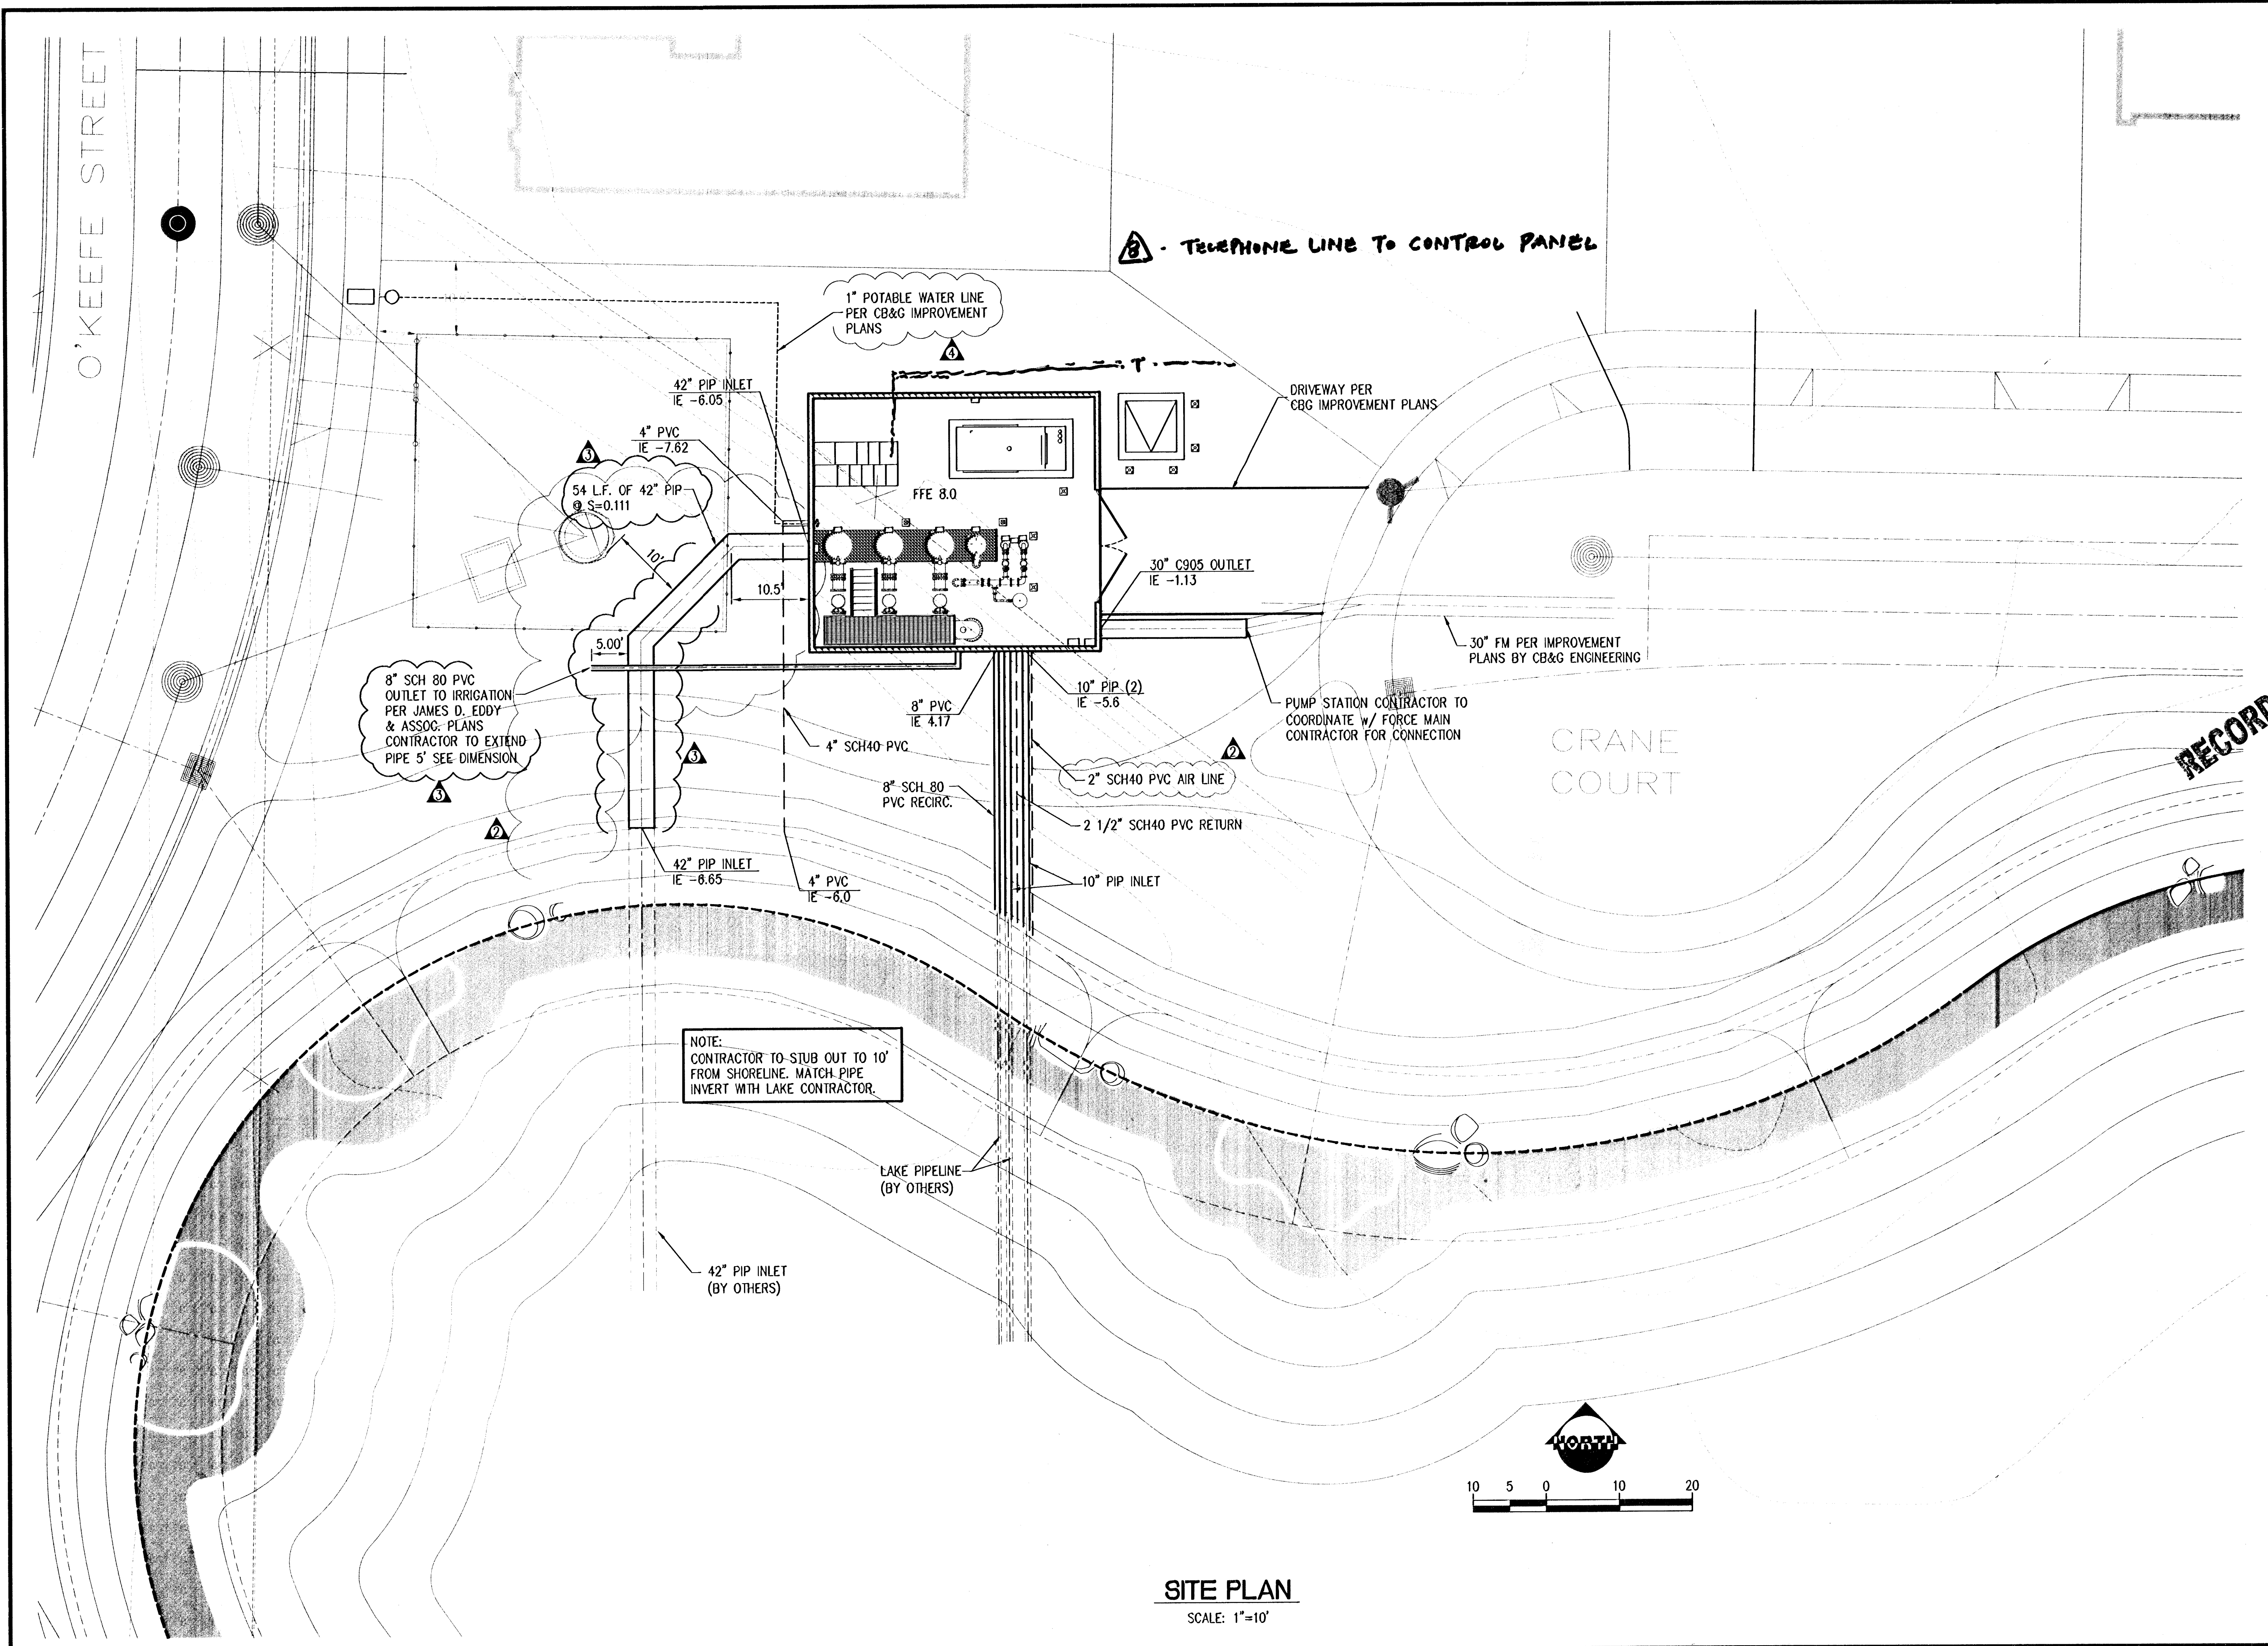

**SITE PLAN**  
SCALE: 1"=10'

NO	BY	DATE	REVISIONS	DATE	APP.
1			4/5/05 PER CITY COMMENTS		
2			4/27/05 PER CITY COMMENTS		
3			5/05/05 PER CITY COMMENTS		
4			5/19/05 PER CITY COMMENTS		

1" POTABLE WATER LINE PER CB&G IMPROVEMENT PLANS  
 DRIVEWAY PER CBG IMPROVEMENT PLANS  
 30" C905 OUTLET IE -1.13  
 30" FM PER IMPROVEMENT PLANS BY CB&G ENGINEERING  
 PUMP STATION CONTRACTOR TO COORDINATE w/ FORCE MAIN CONTRACTOR FOR CONNECTION  
 CRANE COURT  
 8" SCH 80 PVC RECIRC.  
 4" SCH40 PVC  
 8" PVC IE 4.17  
 10" PIP (2) IE -5.6  
 2" SCH40 PVC AIR LINE  
 2 1/2" SCH40 PVC RETURN  
 10" PIP INLET  
 4" PVC IE -6.0  
 42" PIP INLET IE -6.65  
 4" PVC IE -7.62  
 54 L.F. OF 42" PIP @ S=0.111  
 42" PIP INLET IE -6.05  
 8" SCH 80 PVC OUTLET TO IRRIGATION PER JAMES D. EDDY & ASSOC. PLANS CONTRACTOR TO EXTEND PIPE 5' SEE DIMENSION.  
 NOTE: CONTRACTOR TO STUB OUT TO 10' FROM SHORELINE. MATCH PIPE INVERT WITH LAKE CONTRACTOR.  
 LAKE PIPELINE (BY OTHERS)  
 42" PIP INLET (BY OTHERS)

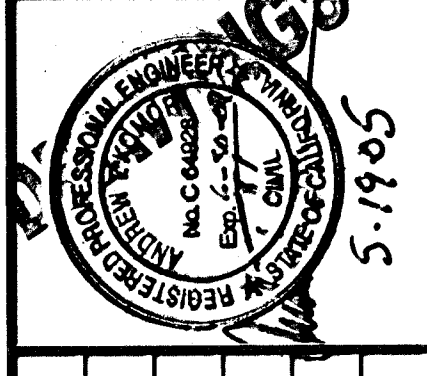

PREPARED BY: ANDREW T. KOMOR  
 PROJECT ENGINEER  
 R.C.E. NO. --- # C 64528  
 EXP. 6/30/07  
 SCALE: ---  
 DRAWN: S.T./A.K.  
 DESIGNED: S.T./A.K.  
 CHECKED: A.K.  
 DATE: APR 2005

**CYPRESS GROVE WATER PUMP STATION YARD PIPING PLAN**  
 RECORD

**PACIFIC ADVANCED CIVIL ENGINEERING**  
 17500 NE WILSON STREET, SUITE 200  
 PORTLAND, OREGON 97229  
 PH (714) 481-7300 FAX (714) 481-7299


SHEET: **G1**  
 JOB NO. 8138-E

P:\8138E\Engineering\8138-10\sheet\8138-10-SHEET-001.dwg - Tab: LAYOUT By: ogilivand on May 19, 2005 at 02:54 pm






Xrefs: 8138-10-Tank.dwg, 8138-MECH.dwg, 8138-ARCH.dwg  
 Datecode = 86; Titlecode = 0.3; Plotcode = 1; Acad Ver. = 16.0a (AutoCAD); Version = 1

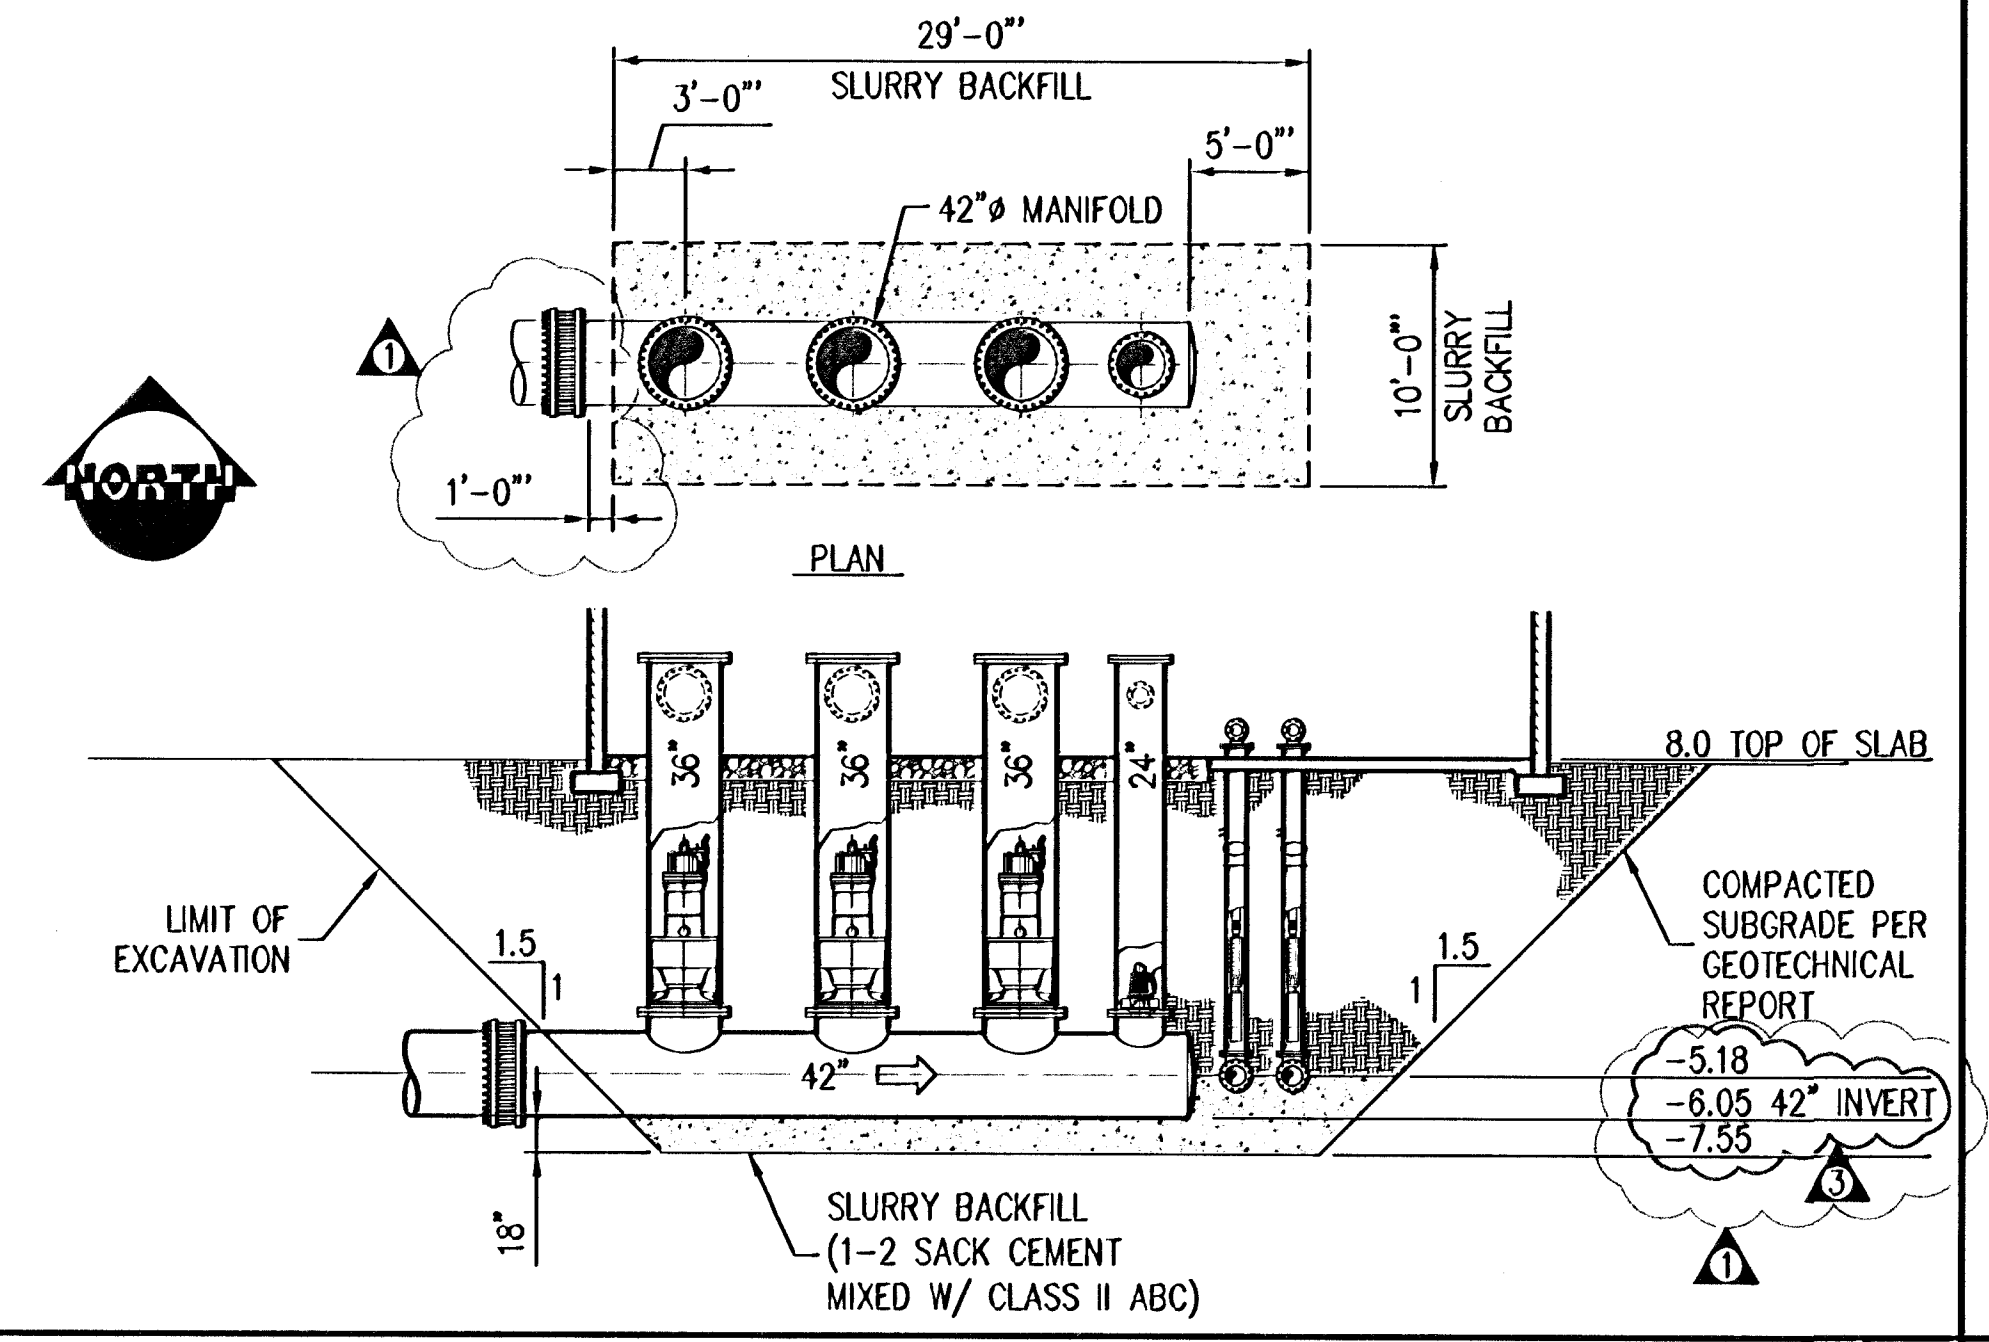

42" INTAKE PIPE DETAIL SCALE: 1/8"=1'-0" A

NO	BY	DATE	REVISIONS	DATE	APP.
1	DS	4/28/05	PER CITY COMMENTS		
2	DS	5/05/05	PER CITY COMMENTS		
3					
4					
5					

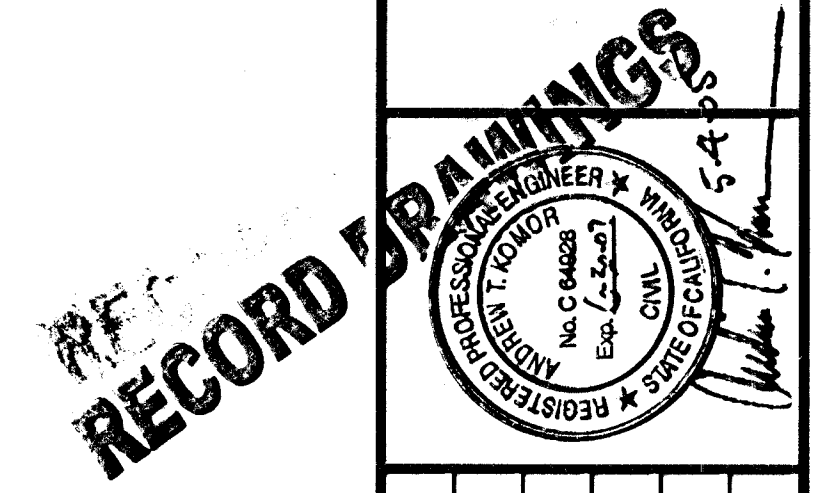

PROJECTED BY	COM/CP	SCALE	DATE
DRAWN	S.L./N.K.	DESIGNED	J.A.M.
CHECKED	A.K.		

**CYPRESS GROVE WATER PUMP STATION**  
**DETAILS**

**PACIFIC ADVANCED CIVIL ENGINEERING**  
 17500 NEWMOORE STREET, SUITE 200  
 PH (714) 481-7300 FAX (714) 481-7299

SHEET **C3**  
 JOB NO. 8138-E



# GENERAL STRUCTURAL NOTES

## STANDARD ABBREVIATIONS

AB.	ANCHOR BOLT
ACI	ALTERNATE AMERICAN CONCRETE INSTITUTE
ACI	ALL COPPER SURFACES
ASCE	AMERICAN INSTITUTE OF STEEL CONSTRUCTION
AISI	AMERICAN INSTITUTE OF STEEL INSTITUTE
ANSI	AMERICAN NATIONAL STANDARDS INSTITUTE
ARCH.	ARCHITECTURAL
ASTM	AMERICAN SOCIETY FOR TESTING AND MATERIALS
B.F.F.	BELOW FINISH FLOOR
BOT.	BOTTOM
BRG.	BEARING
C.J.P.	COMPLETE JOINT PENETRATION
C.	CENTER LINE
CL.	CLEAR DIMENSION TO FACE OF REBAR
COL.	COLUMN
CON.	CONCRETE
DIA.	DIAMETER
DIAG.	DIAGONAL
DWG.	DRAWING
E.F.	EACH FACE
ELEV.	ELEVATION
ELECT.	ELECTRICAL
EQ.	EQUAL
E.W.	EACH WAY
FF.	FINISH FLOOR
F.L.R.	FLOOR
FT.	FOOT
FOOT.	FOOTING
GA.	GAUGE
GLB.	GULLIAM BEAM
GEN.	GENERAL STRUCTURAL NOTES
G.T.R.	GIRDER TRUSS
HORIZ.	HORIZONTAL
H.S.	HOLLOW STRUCTURAL SECTION
IBC.	INTERNATIONAL BUILDING CODE
ID.	INSIDE DIAMETER
INFO.	INFORMATION
JOINT.	JOINT
KIP.	KIP (1000 LBS)
K.	KNOCKOUT
K.S.	KIP PER SQUARE INCH
LLV.	LONG LEG HORIZONTAL
LLV.	LONG LEG VERTICAL
LONG.	LONG
LONG.	LONGITUDINAL
L.V.L.	LAMINATED VENEER LUMBER
MFR.	MANUFACTURER
MAX.	MAXIMUM
MECH.	MECHANICAL
MIN.	MINIMUM
MISC.	MISCELLANEOUS
N.T.S.	NOT TO SCALE
O.C.	ON CENTER
O.P.P.	OPPOSITE
FL.	FLUTE
FLY.	FOUNDS PER LINEAR FOOT
FLY.	FOUNDS PER SQUARE FOOT
P.S.I.	POUNDS PER SQUARE INCH
P.S.I.	PARALLEL STRAND LUMBER
REQD.	REQUIRED
SIM.	SIMILAR
SPEC.	SPECIFICATION
STD.	STANDARD
T & B.	TOP AND BOTTOM
T & G.	TONGUE AND GROOVE
THRU.	THROUGH
T.O.	TOP OF
T.O.D.	TOP OF DECK
T.O.F.	TOP OF FOOTING
T.O.L.	TOP OF LEDGER
T.O.S.	TOP OF STEEL
T.O.W.	TOP OF WALL
TYP.	TYPICAL
UNO.	UNLESS NOTED OTHERWISE
VERT.	VERTICAL
W/.	WITH
W/O.	WITHOUT
WT.	WEIGHT

### A. GENERAL REQUIREMENTS

- THESE DRAWINGS HAVE BEEN PREPARED USING STANDARDS OF PROFESSIONAL CARE AND COMPETENCE NORMALLY EXERCISED UNDER SIMILAR CIRCUMSTANCES BY REPUTABLE STRUCTURAL ENGINEERS IN THIS OR SIMILAR LOCALITIES. THEY ASSUME THAT THE WORK DEPICTED WILL BE PERFORMED BY AN EXPERIENCED CONTRACTOR AND/OR WORKMEN WHO HAVE A WORKING KNOWLEDGE OF THE APPLICABLE CODE STANDARDS AND REQUIREMENTS AND OF INDUSTRY ACCEPTED STANDARD GOOD PRACTICE. AS NOT EVERY CONDITION OR ELEMENT IS (OR CAN BE) EXPLICITLY SHOWN ON THESE DRAWINGS, THE CONTRACTOR SHALL USE INDUSTRY ACCEPTED STANDARD GOOD PRACTICE FOR MISCELLANEOUS WORK NOT EXPLICITLY SHOWN.
- THESE DRAWINGS REPRESENT THE FINISHED STRUCTURE. THEY DO NOT INDICATE THE METHOD OF CONSTRUCTION. THE CONTRACTOR SHALL BE SOLELY RESPONSIBLE FOR CONSTRUCTION MEANS, METHODS, TECHNIQUES, SEQUENCES, PROCEDURES, LAGGING, SHORING, BRACING, FORM-WORK, ETC. AS REQUIRED FOR THE PROTECTION OF LIFE AND PROPERTY DURING CONSTRUCTION. CONSTRUCTION MATERIALS SHALL BE UNIFORMLY SPREAD OUT SUCH THAT DESIGN LIVE LOAD PER SQUARE FOOT AS NOTED HEREIN IS NOT EXCEEDED.
- DESIGN OF NON-PRIMARY STRUCTURAL ITEMS, SUCH AS STAIRS, RAILINGS, NON-STRUCTURAL WALLS AND PREFABRICATED STRUCTURAL ITEMS, SUCH AS FLOOR AND ROOF TRUSSES, IS TO BE PROVIDED BY OTHERS AND SUBMITTED FOR APPROVAL AS A DEFERRED SUBMITTAL UNLESS SPECIFICALLY NOTED ON THESE DRAWINGS.
- THE CONTRACTOR SHALL VERIFY ALL DIMENSIONS, CONDITIONS AND ELEVATIONS WITH ARCHIT. DRAWINGS AND RESOLVE ANY DISCREPANCIES WITH THE ARCHITECT PRIOR TO START OF CONSTRUCTION. CONTRACTOR SHALL ESTABLISH AND VERIFY ALL OPENINGS AND INSERTS FOR ARCHIT., MECH., PLUMBING AND ELECTRICAL WITH APPROPRIATE TRADES, DRAWINGS AND SUBCONTRACTORS PRIOR TO CONSTRUCTION.
- TYPICAL DETAILS AND NOTES SHALL APPLY, THOUGH NOT NECESSARILY INDICATED AT A SPECIFIC LOCATION ON PLANS, WHERE NO DETAILS ARE SHOWN. CONSTRUCTION SHALL CONFORM TO SIMILAR WORK ON THE PROJECT. DETAILS MAY SHOW ONLY ONE SIDE OF CONNECTION OR MAY OMIT INFORMATION FOR CLARITY.
- NOTES AND DETAILS ON DRAWINGS SHALL TAKE PRECEDENCE OVER GENERAL STRUCTURAL NOTES AND TYPICAL DETAILS.

- ALL INSPECTIONS REQUIRED BY THE BUILDING CODES, LOCAL BUILDING DEPARTMENTS, OR BY THESE PLANS SHALL BE PROVIDED BY AN INDEPENDENT INSPECTION COMPANY OR THE BUILDING DEPARTMENT. SITE VISITS BY THE ENGINEER DO NOT CONSTITUTE AN INSPECTION.
- ALL DRAWINGS ARE REVIEWED ONLY FOR GENERAL COMPLIANCE WITH THE STRUCTURAL DRAWINGS. RESPONSIBILITY FOR CORRECTNESS SHALL REST WITH THE CONTRACTOR. ANY CHANGES, SUBSTITUTIONS OR DEVIATIONS FROM CONTRACT DRAWINGS SHALL BE CLOUSED AND SHALL NOT BE CONSIDERED APPROVED AFTER ENGINEER'S REVIEW UNLESS SPECIFICALLY NOTED ACCORDINGLY. SHOP DRAWINGS DO NOT SUPERSEDE OR REPLACE THE CONTRACT DRAWINGS. ONE COPY OF EACH SUBMITTAL WILL BE RETAINED FOR THE ENGINEER'S RECORDS.

- MIN. VERT. REINFORCING UNO. ON PLANS OR DETAILS SHALL BE 5 BAR VERT. 1/4" DIA. IN CENTER OF GROUDED CELL AT ALL WALL INTERSECTIONS, CORNERS, WALL ENDS, JAMBS AT WALL OPENINGS, AND AT EACH SIDE OF CONTROL JOINTS. REFER TO PLAN FOR TYPICAL VERT. WALL REINF. SIZE AND SPACING. DOUVEL ALL VERT. REINFORCING TO FOUNDATION WITH DOUBLES TO MATCH AND LAP VERT. REINFORCING.
- MIN. WALL HORIZ. REINFORCING UNO. ON PLANS OR DETAILS SHALL BE (2) #5 BARS IN CENTER OF 32 INCH DEEP (MIN) CONTINUOUS GROUDED BOND BEAM AT ROOF LINES AND SINGLE #5 BAR IN CENTER OF 16 INCH DEEP CONTINUOUS GROUDED BOND BEAM FREE STANDING WALL AND AT INTERVALS NOT TO EXCEED 48" O.C. PLACE BARS AT ROOF LINES CONTINUOUS THROUGH CONTROL JOINTS. PROVIDE BENT BARS PER TYPICAL DETAILS TO MATCH AND LAP HORIZ. BOND BEAM REINFORCING AT CORNERS AND WALL INTERSECTIONS TO MAINTAIN BOND BEAM CONTINUITY. USE BOND BEAM UNITS AT HORIZ. REINFORCING.

- MIN. WALL HORIZ. REINFORCING UNO. ON PLANS OR DETAILS SHALL BE (2) #5 BARS IN CENTER OF 32 INCH DEEP (MIN) CONTINUOUS GROUDED BOND BEAM AT ROOF LINES AND SINGLE #5 BAR IN CENTER OF 16 INCH DEEP CONTINUOUS GROUDED BOND BEAM FREE STANDING WALL AND AT INTERVALS NOT TO EXCEED 48" O.C. PLACE BARS AT ROOF LINES CONTINUOUS THROUGH CONTROL JOINTS. PROVIDE BENT BARS PER TYPICAL DETAILS TO MATCH AND LAP HORIZ. BOND BEAM REINFORCING AT CORNERS AND WALL INTERSECTIONS TO MAINTAIN BOND BEAM CONTINUITY. USE BOND BEAM UNITS AT HORIZ. REINFORCING.

### D. CONCRETE (CONT.)

- CONCRETE MIXING, PLACEMENT AND QUALITY SHALL BE PER CBC SECTION 1905 AND CBC STANDARD 19-3. MECHANICALLY VIBRATE ALL CONCRETE WHEN PLACED. SLABS ON GRADE NEED BE VIBRATED ONLY AROUND AND UNDER FLOOR DUCTS OR SIMILAR ELEMENTS. REMOVE ALL DEBRIS FROM FORMS BEFORE PLACING CONCRETE. CONCRETE SHALL NOT BE DROPPED THROUGH REINFORCING STEEL 80% TO CAUSE SEGREGATION OF AGGREGATES. UNCONFINED FALL OF CONCRETE SHALL NOT EXCEED 9 FEET.
- ALL ITEMS TO BE CAST IN CONCRETE SUCH AS REINFORCING, DOUELS, BOLTS, ANCHORS, SLEEVES, ETC. SHALL BE SECURELY POSITIONED IN THE FORMS.
- PROTECT CONCRETE FROM DAMAGE OR REDUCED STRENGTH DUE TO COLD OR HOT WEATHER IN ACCORDANCE WITH ACI 308 AND 306. CONTRACTOR SHALL TAKE SPECIAL CURING PRECAUTIONS TO MINIMIZE SHRINKAGE CRACKING OF CONCRETE SLABS.
- PIPES AND ELECTRICAL CONDUITS SHALL NOT BE EMBEDDED IN STRUCTURAL CONCRETE EXCEPT WHERE SPECIFICALLY APPROVED BY THE ENGINEER. EMBEDDED ITEMS SHALL NOT IMPAIR THE STRENGTH OF THE MEMBER.

### E. MASONRY

- SPECIFIED COMPRESSIVE STRENGTH OF MASONRY, F<sub>m</sub>, SHALL BE 1500 PSI. CONTRACTOR SHALL SUBMIT EVIDENCE THAT ALL CONCRETE BLOCK, GROUT AND MORTAR CONFORM TO THE REQUIREMENTS OF EITHER CBC 209.33 OR CBC 209.3.4 TO ACHIEVE THE DESIGN COMPRESSIVE STRENGTH SPECIFIED ABOVE BASED ON ONE HALF ALLOWABLE STRESS.
- STRUCTURAL MASONRY SHALL BE HOLLOW, MEDIUM WEIGHT (16 PCF) LOAD-BEARING CONCRETE MASONRY UNITS CONFORMING TO CBC STANDARD 21-4. ALL BLOCKS SHALL BE PLACED IN RUNNING BOND CONSTRUCTION UNO. WITH ALL VERTICAL CELLS IN ALIGNMENT.
- MORTAR MIX SHALL CONFORM TO REQUIREMENTS OF CBC STANDARD 21-5, TYPE M OR S.
- GROUT SHALL CONFORM TO REQUIREMENTS OF CBC STANDARD 21-3. USE SUFFICIENT WATER FOR GROUT TO FLOW INTO ALL JOINTS OF THE MASONRY WITHOUT SEGREGATION. ONLY SOLID GROUT CELLS WITH REINFORCING UNLESS REQUIREMENT TO SOLID GROUT ENTIRE WALL IS SPECIFICALLY NOTED ON PLANS OR SCHEDULE. HOLD GROUT DOWN 1/2" BELOW TOP OF BLOCK AT GROUT LIFT JOINTS.
- LAP REINFORCING BARS SHALL BE PER CBC 201 OR REBAR LAP SCHEDULE, WHERE PRESENT, UNO.
- REINFORCING SHALL BE SECURED IN ITS PROPER POSITION WITHIN THE CELL TO PREVENT LATERAL DISPLACEMENT PRIOR TO GROUTING PER CBC REQUIREMENTS.

- MIN. WALL VERT. REINFORCING UNO. ON PLANS OR DETAILS SHALL BE 5 BAR VERT. 1/4" DIA. IN CENTER OF GROUDED CELL AT ALL WALL INTERSECTIONS, CORNERS, WALL ENDS, JAMBS AT WALL OPENINGS, AND AT EACH SIDE OF CONTROL JOINTS. REFER TO PLAN FOR TYPICAL VERT. WALL REINF. SIZE AND SPACING. DOUVEL ALL VERT. REINFORCING TO FOUNDATION WITH DOUBLES TO MATCH AND LAP VERT. REINFORCING.
- MIN. WALL HORIZ. REINFORCING UNO. ON PLANS OR DETAILS SHALL BE (2) #5 BARS IN CENTER OF 32 INCH DEEP (MIN) CONTINUOUS GROUDED BOND BEAM AT ROOF LINES AND SINGLE #5 BAR IN CENTER OF 16 INCH DEEP CONTINUOUS GROUDED BOND BEAM FREE STANDING WALL AND AT INTERVALS NOT TO EXCEED 48" O.C. PLACE BARS AT ROOF LINES CONTINUOUS THROUGH CONTROL JOINTS. PROVIDE BENT BARS PER TYPICAL DETAILS TO MATCH AND LAP HORIZ. BOND BEAM REINFORCING AT CORNERS AND WALL INTERSECTIONS TO MAINTAIN BOND BEAM CONTINUITY. USE BOND BEAM UNITS AT HORIZ. REINFORCING.

- MIN. WALL HORIZ. REINFORCING UNO. ON PLANS OR DETAILS SHALL BE (2) #5 BARS IN CENTER OF 32 INCH DEEP (MIN) CONTINUOUS GROUDED BOND BEAM AT ROOF LINES AND SINGLE #5 BAR IN CENTER OF 16 INCH DEEP CONTINUOUS GROUDED BOND BEAM FREE STANDING WALL AND AT INTERVALS NOT TO EXCEED 48" O.C. PLACE BARS AT ROOF LINES CONTINUOUS THROUGH CONTROL JOINTS. PROVIDE BENT BARS PER TYPICAL DETAILS TO MATCH AND LAP HORIZ. BOND BEAM REINFORCING AT CORNERS AND WALL INTERSECTIONS TO MAINTAIN BOND BEAM CONTINUITY. USE BOND BEAM UNITS AT HORIZ. REINFORCING.


- MIN. WALL HORIZ. REINFORCING UNO. ON PLANS OR DETAILS SHALL BE (2) #5 BARS IN CENTER OF 32 INCH DEEP (MIN) CONTINUOUS GROUDED BOND BEAM AT ROOF LINES AND SINGLE #5 BAR IN CENTER OF 16 INCH DEEP CONTINUOUS GROUDED BOND BEAM FREE STANDING WALL AND AT INTERVALS NOT TO EXCEED 48" O.C. PLACE BARS AT ROOF LINES CONTINUOUS THROUGH CONTROL JOINTS. PROVIDE BENT BARS PER TYPICAL DETAILS TO MATCH AND LAP HORIZ. BOND BEAM REINFORCING AT CORNERS AND WALL INTERSECTIONS TO MAINTAIN BOND BEAM CONTINUITY. USE BOND BEAM UNITS AT HORIZ. REINFORCING.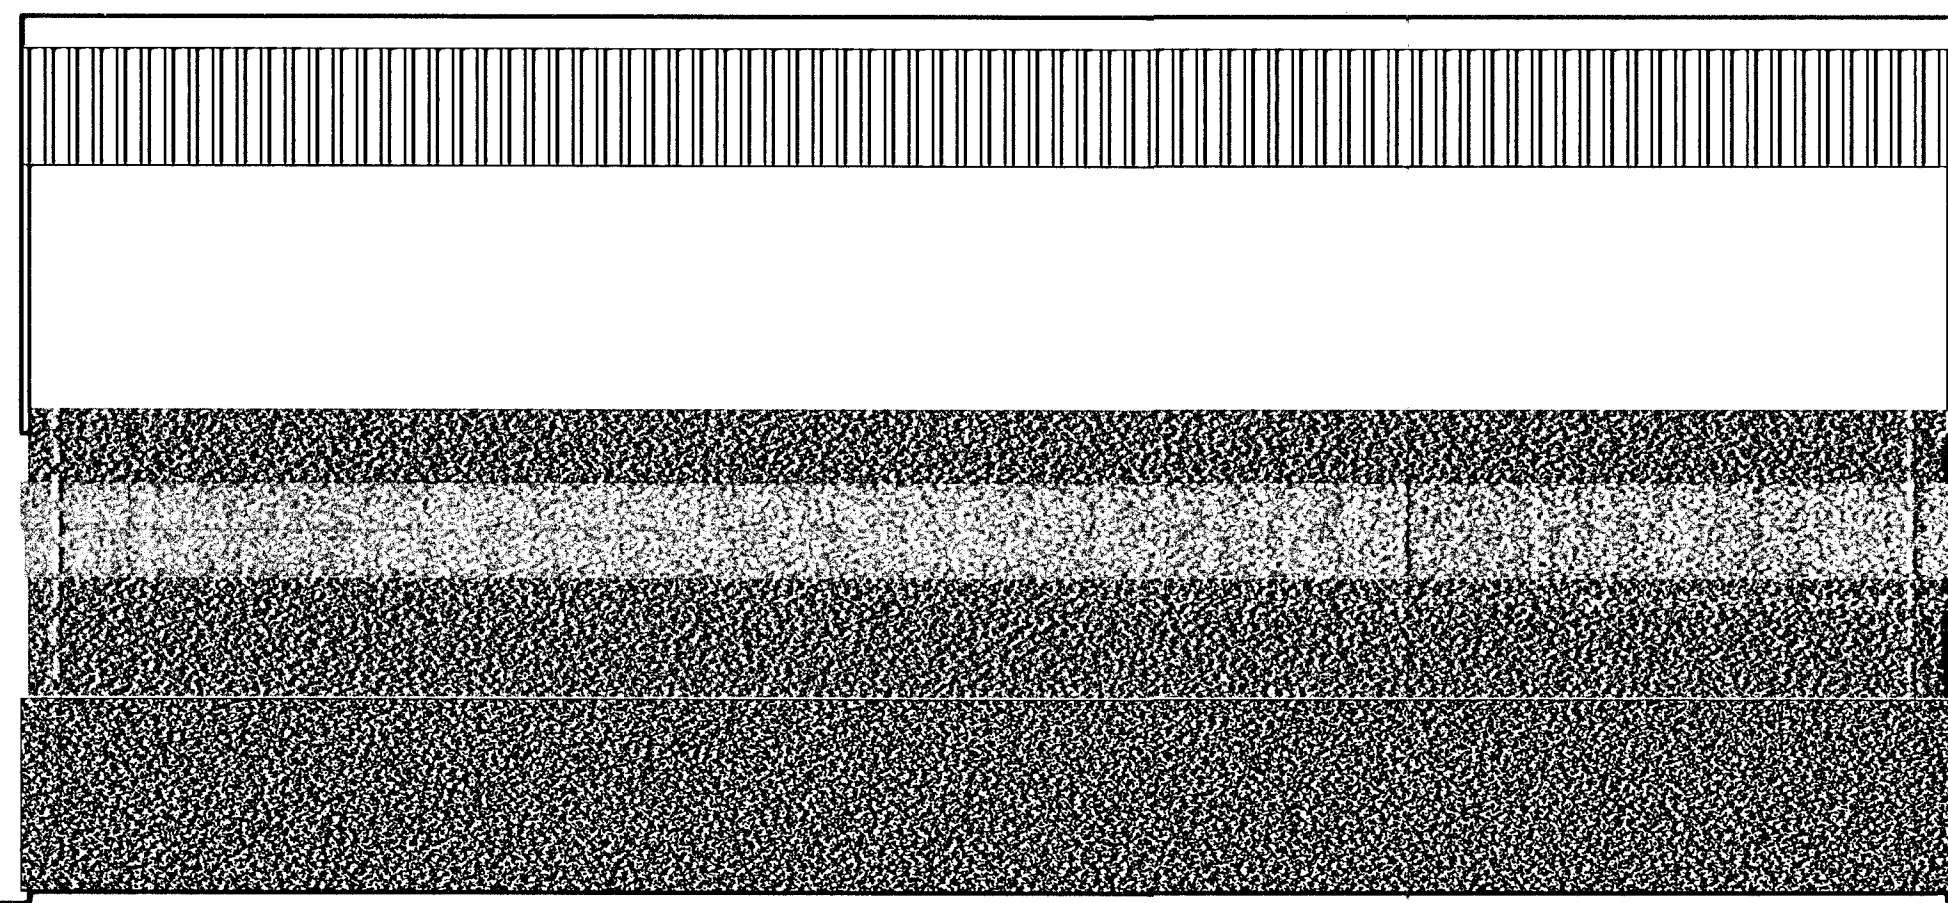

**NORTH ELEVATION**

1/4" = 1'-0"


**PAINTING SPEC:**

1. EXPOSED METAL: PRIME-DEVCOE 224HS; FINISH-DEVCOE 379UVA
2. EXTERIOR BUILDING:
  - A. MAIN BODY - SW# 7038 TONY TAUPE
  - B. 4' BOTTOM - SW# 7039 VIRTUAL TAUPE
  - C. TRIM - SW# 1108 FRAGILE BEAUTY

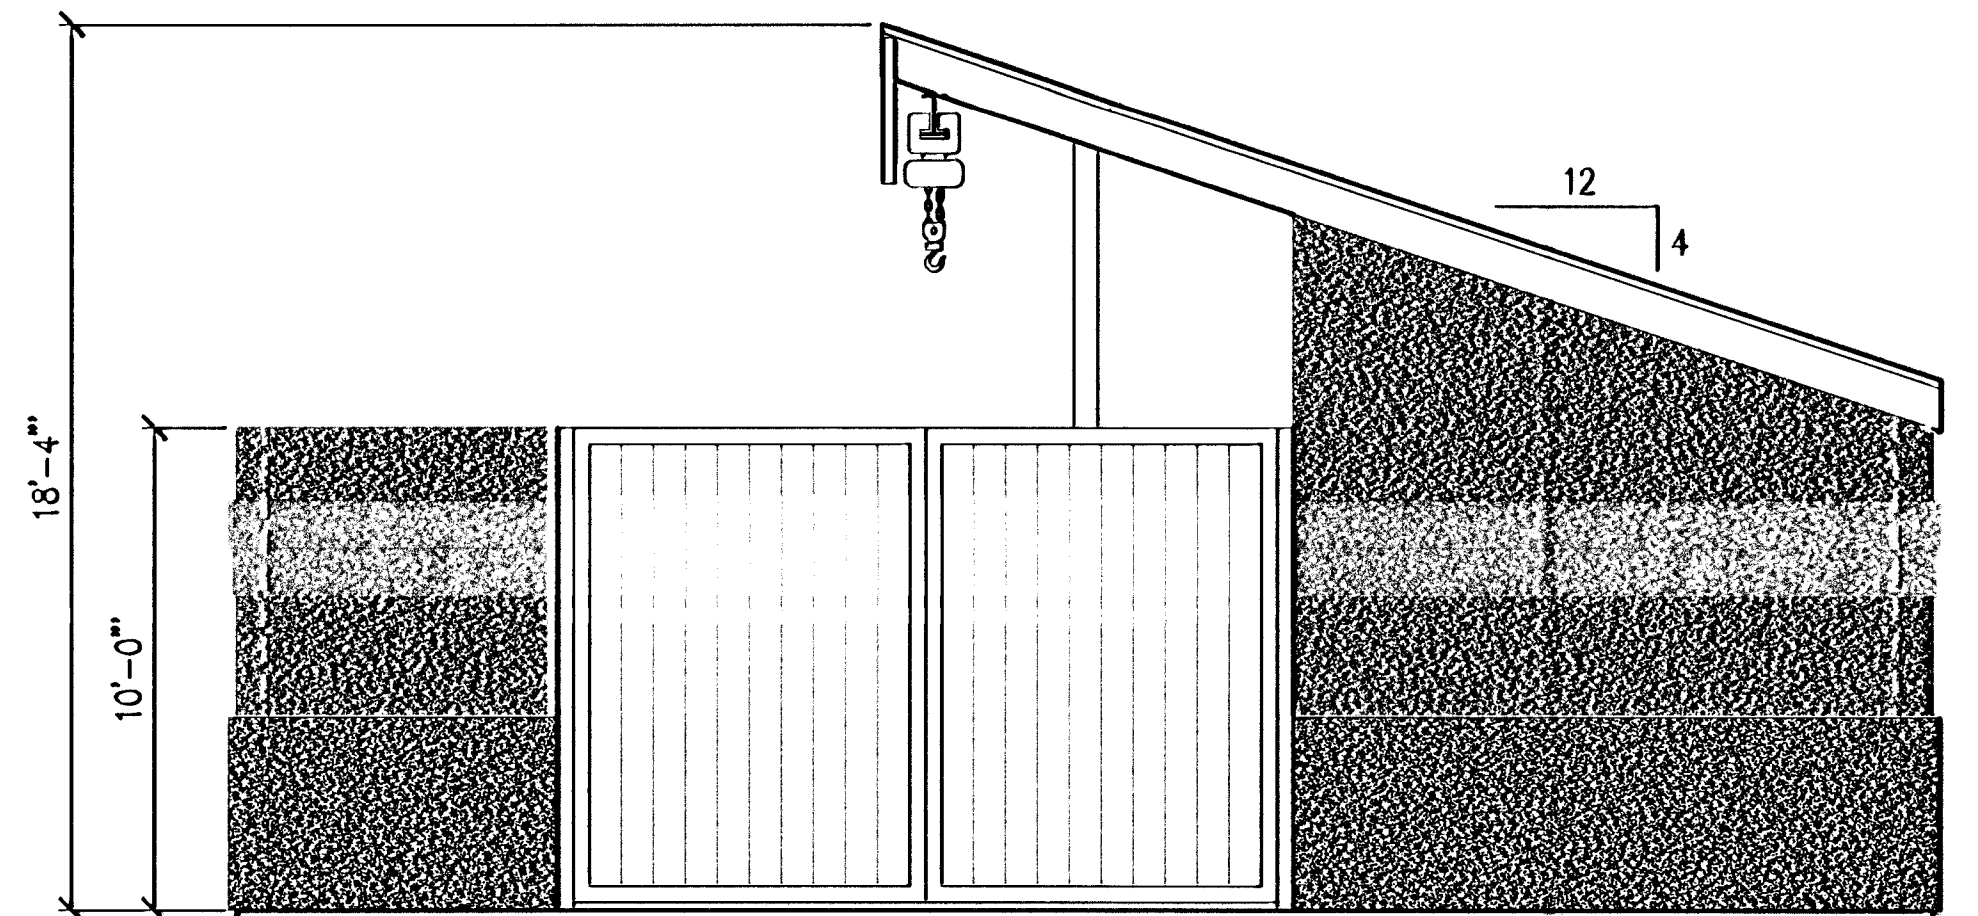


**EAST ELEVATION**

1/4" = 1'-0"

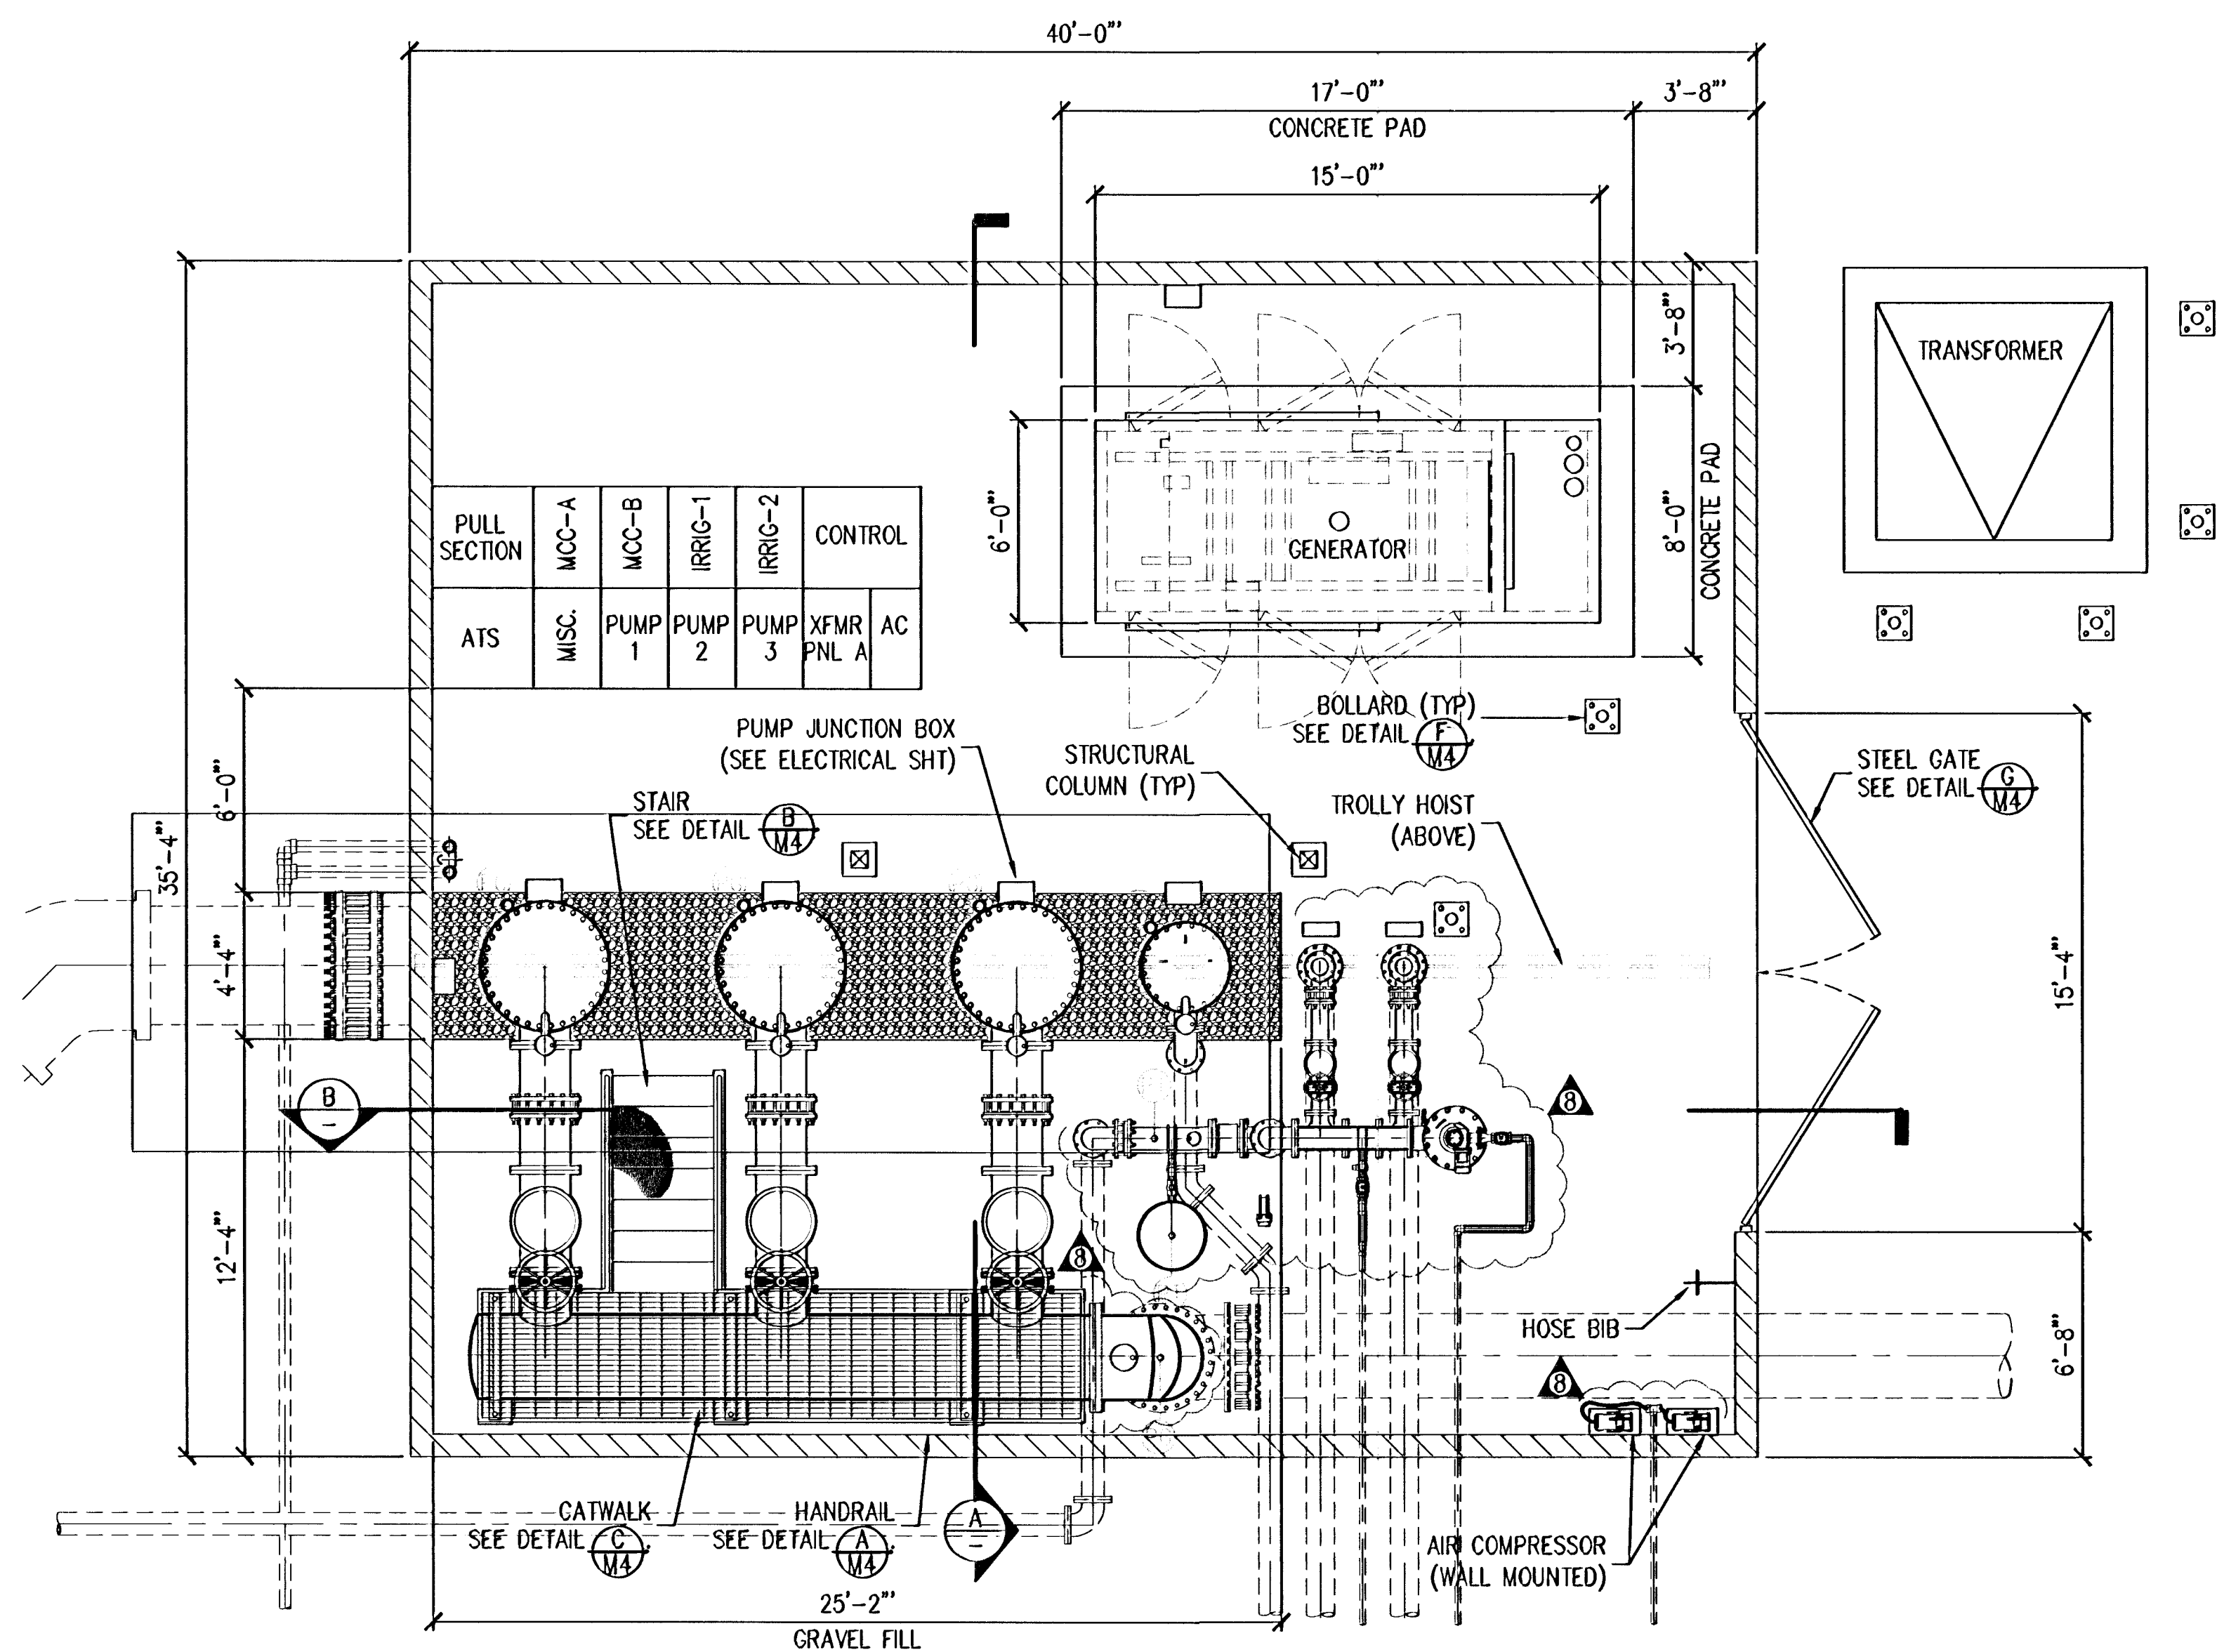


**FLOOR PLAN**

1/4" = 1'-0"

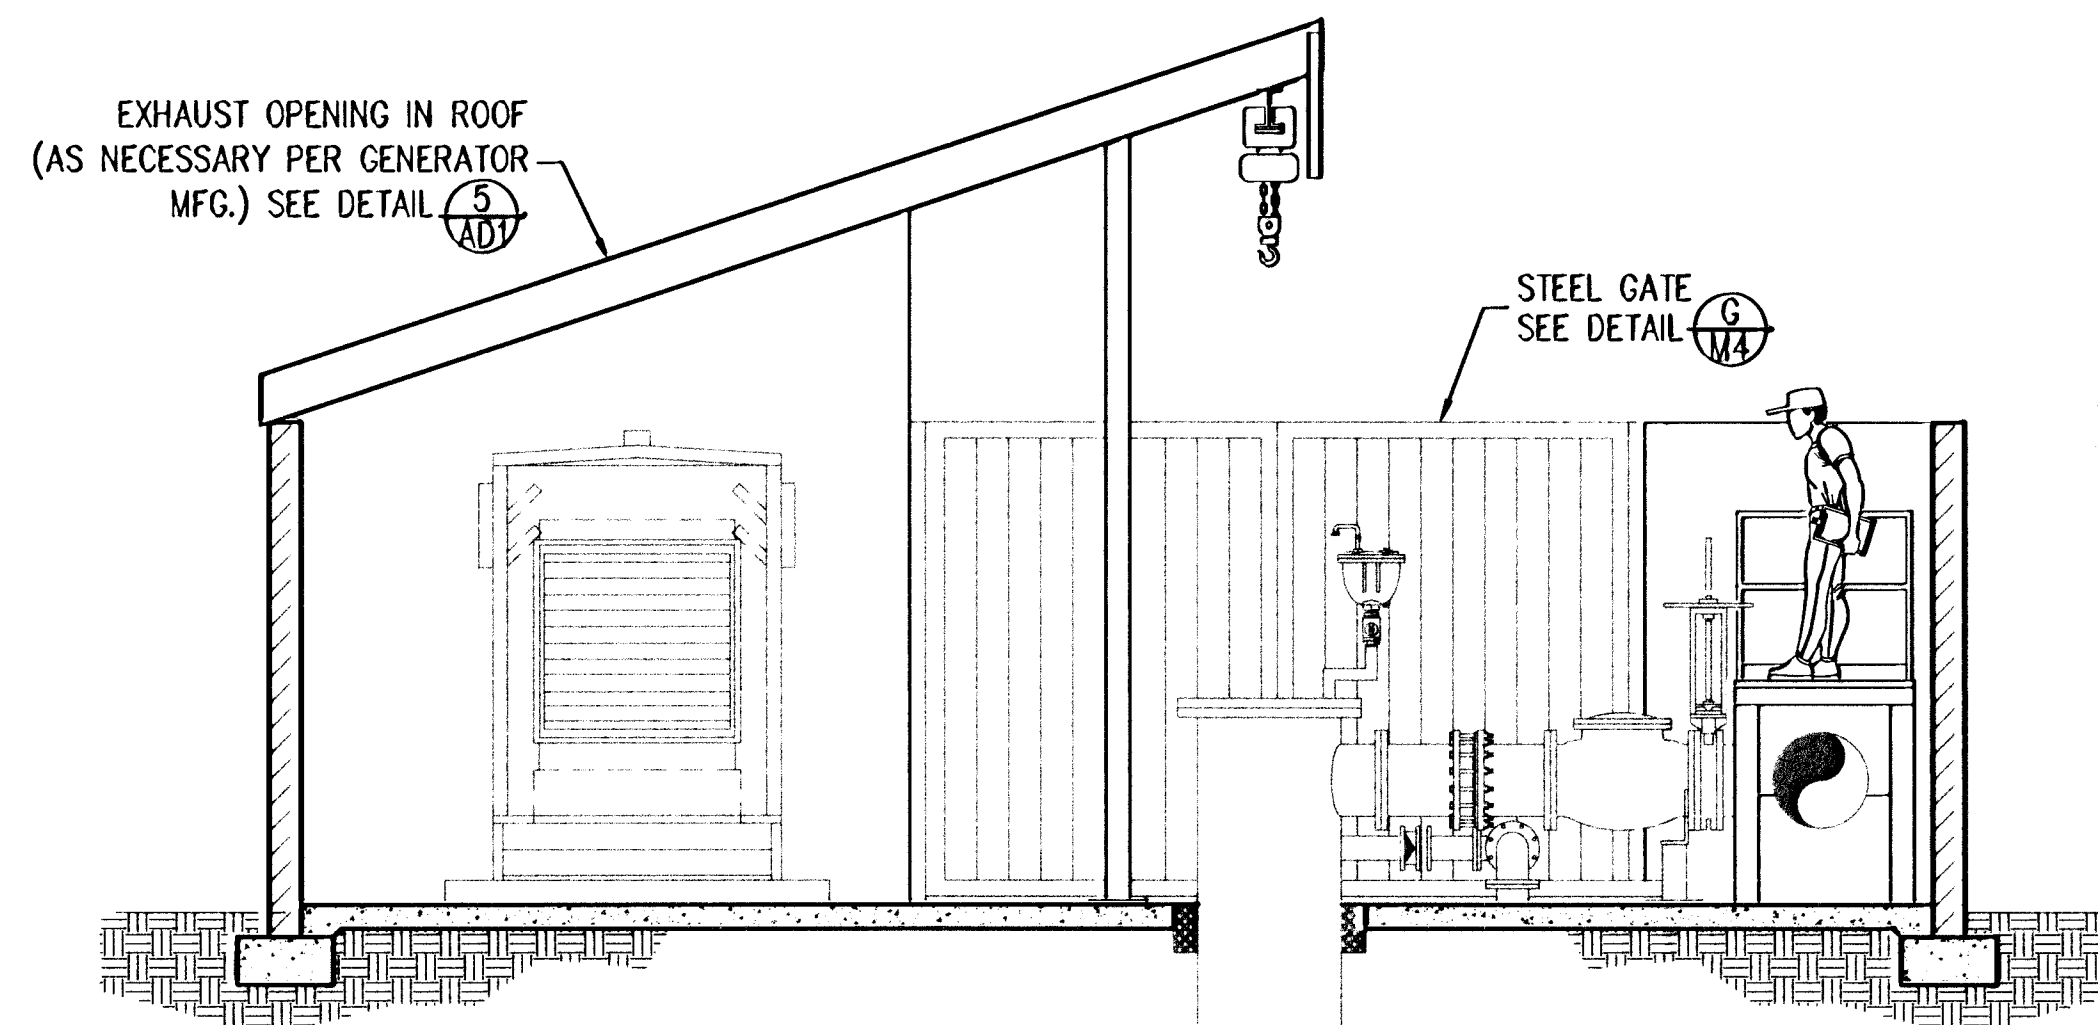

**SECTION A**

1/4" = 1'-0"

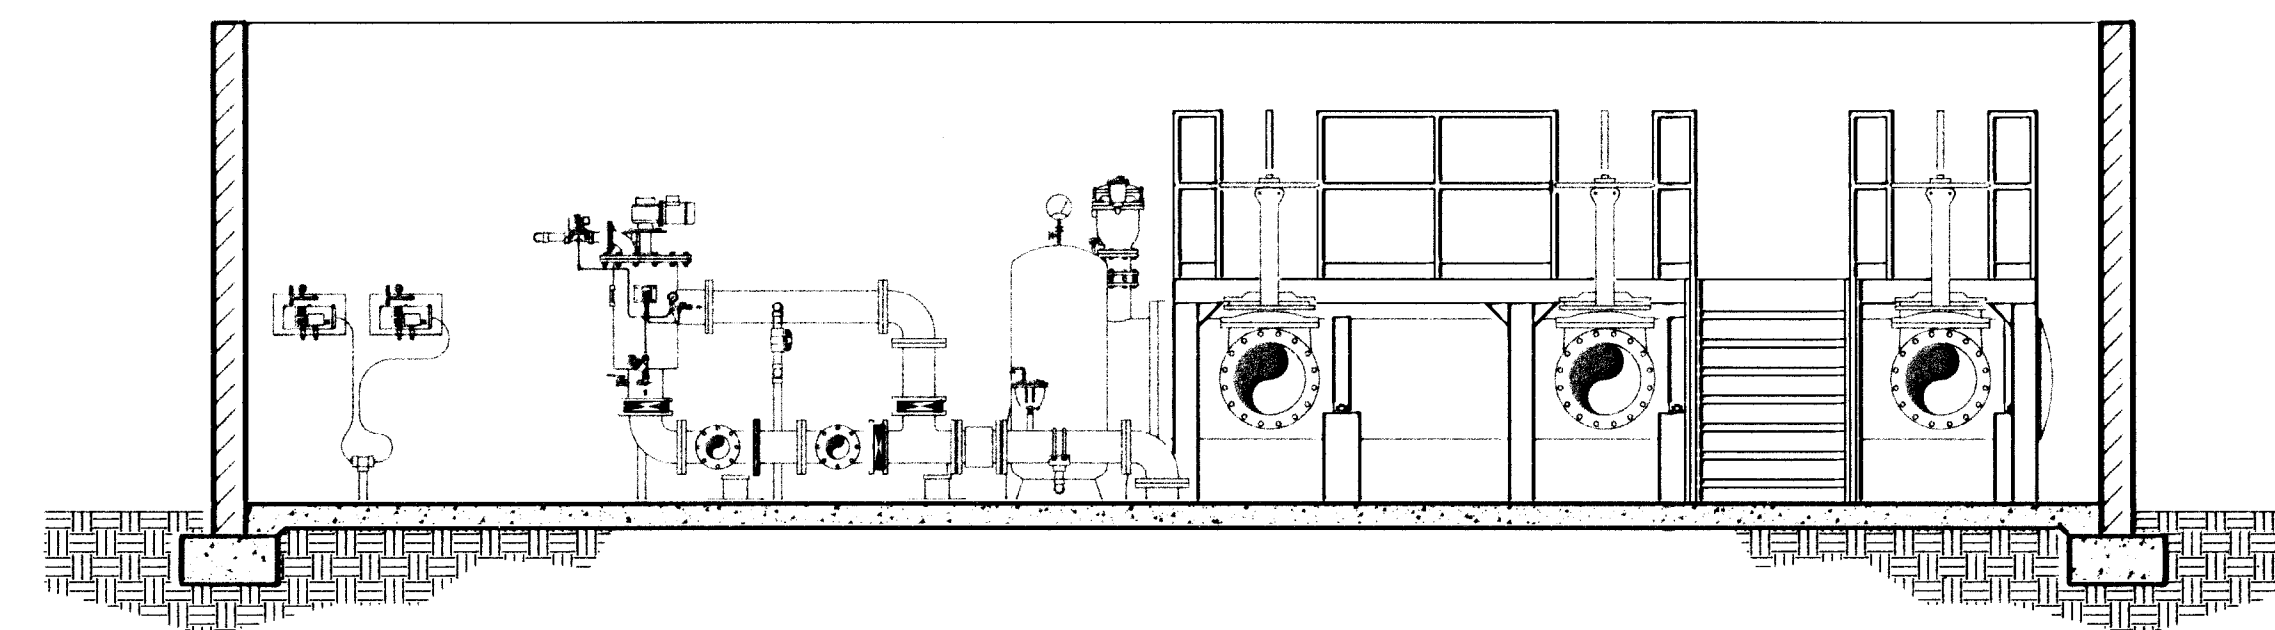

**SECTION B**

1/4" = 1'-0"

**RECORD DRAWINGS**

NO.	BY	DATE	REVISIONS	DATE	APP.
1	UP	4/8/05	PER CITY COMMENTS -		
2	UP	4/27/05	PER CITY COMMENTS -		
3	DC	5/15/05	PER CITY COMMENTS -		
4	DC	5/19/05	PER CITY COMMENTS -		
5	BR	7/6/05	IRRIGATION FILTER		
6	BR	9/21/05	WETLAND PLANTER		
7	BR	9/26/05	HYDROSTATIC RELIEF		
8	DC	12/2/05	RECORD DRAWINGS		

PREPARED BY ANDREW T. KOMOR	PROJECT ENGINEER R.C.E. NO. - # C 64528	SCALE 1/4" = 1'
DATE EXP. 6/30/07	DRAWN S.L./A.K.	CHECKED A.K.
	DATE APR 2005	

**CYPRESS GROVE  
WATER PUMP STATION  
ARCHITECTURAL  
SECTIONS**

**PACE**  
PACIFIC ADVANCED  
CIVIL ENGINEERING  
1700 S. MOUNTAIN VALLEY, CA 92278  
PH (714) 481-7300 FAX (714) 481-7299


SHEET  
**A1**  
JOB NO. 8138-E

Xrefs: 8138-10-10k.dwg, 8138-SECTIONS.dwg, 8138-MCC.dwg, 8138-ARCH.dwg, 8138-STRUCT.dwg  
D:\p138\8138-10-10k.dwg, 1/1/05, 16:04 (LMS Tech), Version = 1



THESE DRAWINGS ARE THE PROPERTY OF PACIFIC ADVANCED AND SHALL NOT BE REPRODUCED IN ANY MANNER NOR BE USED FOR CONSTRUCTION UNLESS STAMPED "ISSUED FOR CONSTRUCTION".  
P:\p138\Engineering\Submittals\Record Drawings\8138-10-SHEET-A01.dwg - Tab: LAYOUT By: gplland on Jan. 04, 2006 at 05:22 pm



Xref: X-S22449-20.dwg X-S22449-21.dwg X-S22449-22.dwg X-S22449-23.dwg  
 Date: 11/11/05 11:00 AM 11/11/05 11:00 AM 11/11/05 11:00 AM 11/11/05 11:00 AM  
 User: J. L. ...

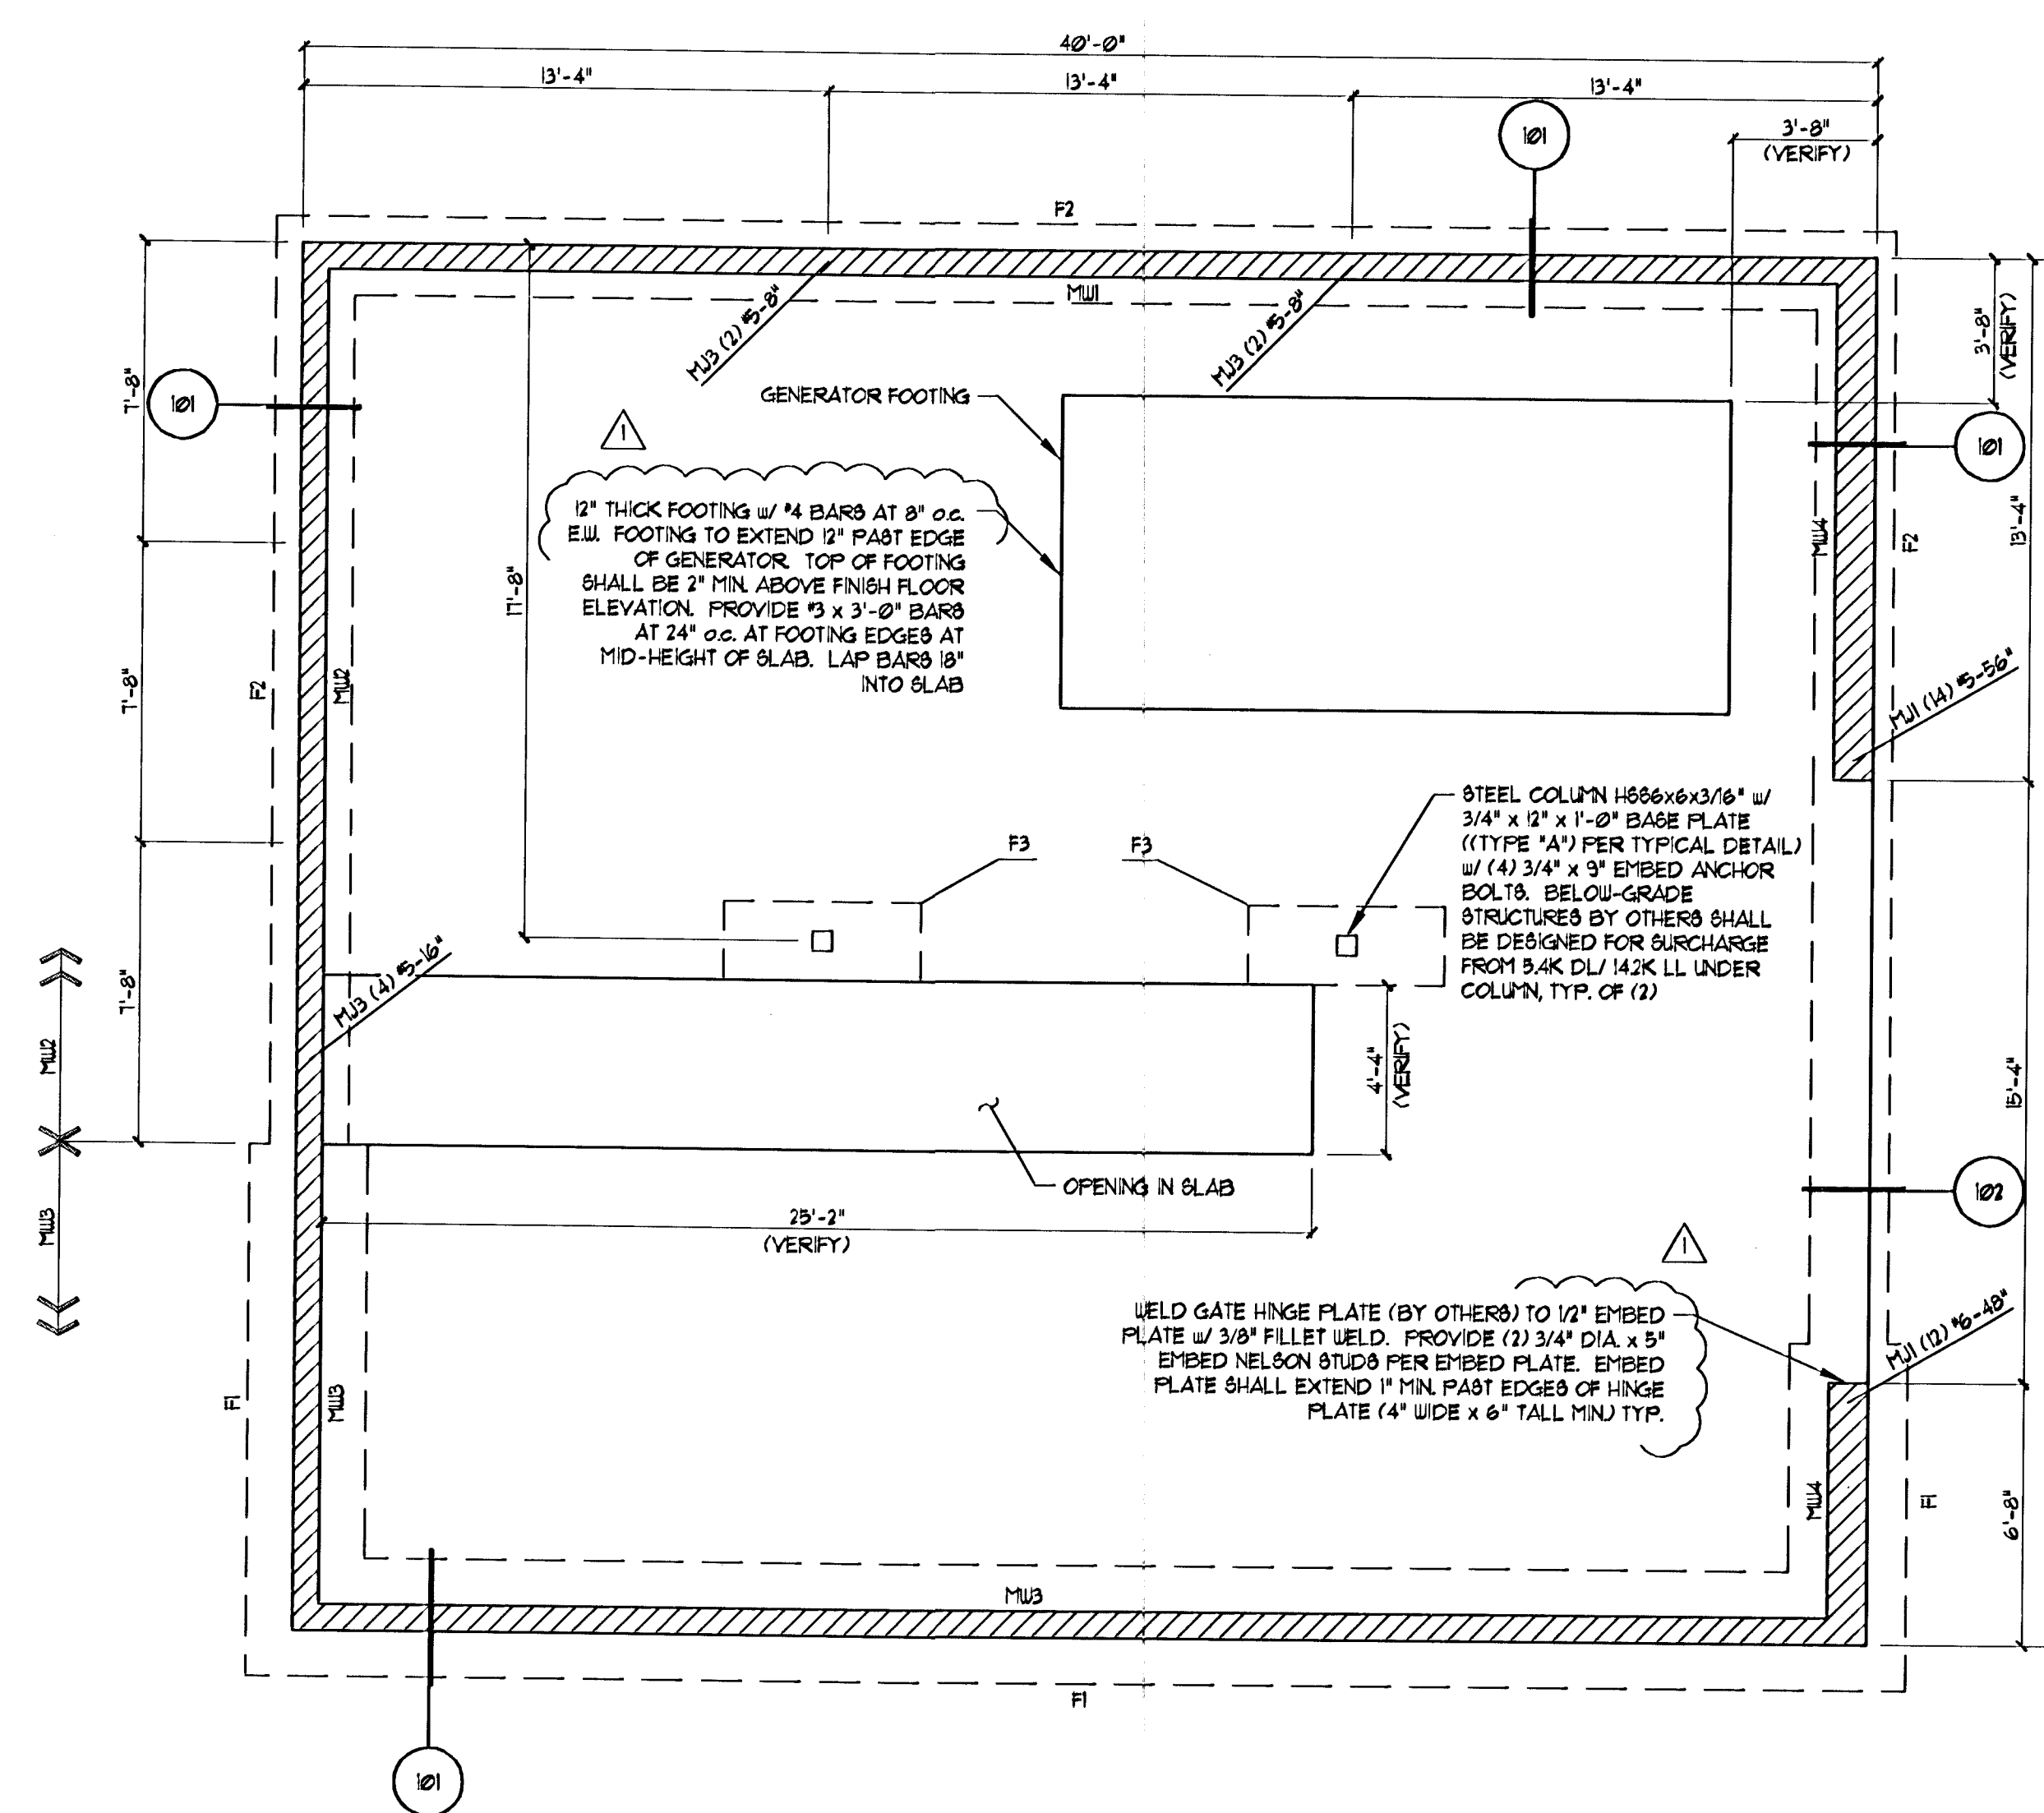


**FOOTING (F) SCHEDULE**

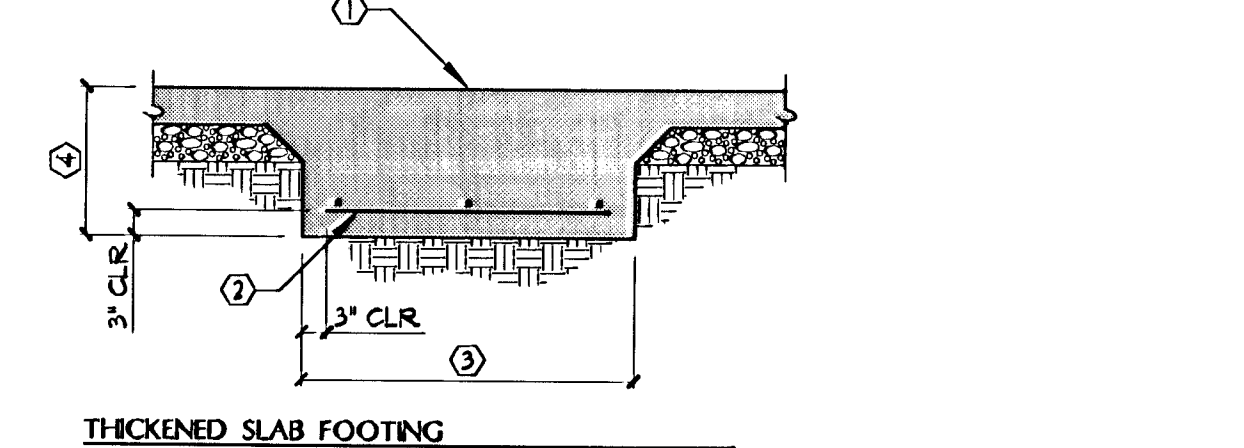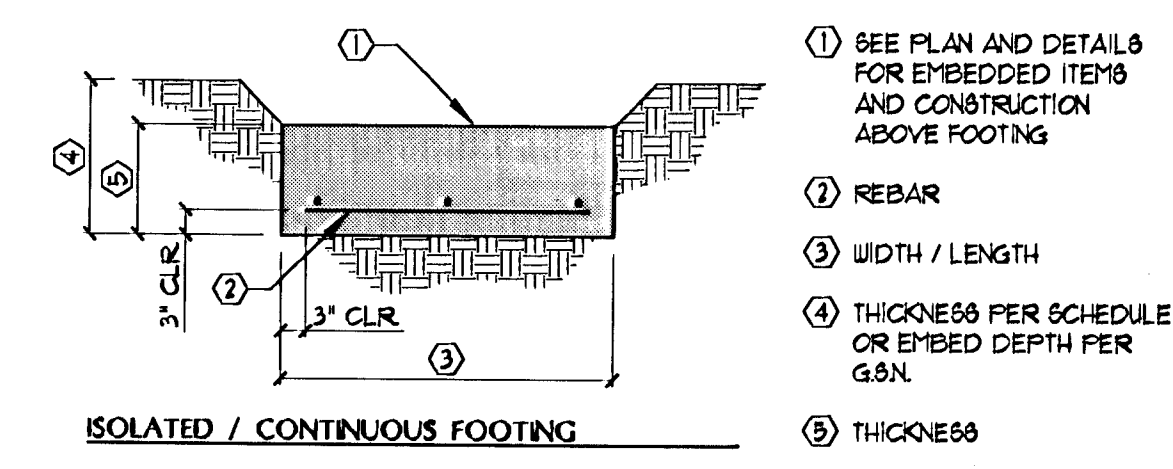

MARK	WIDTH	LENGTH	THICKNESS	FOOTING REBAR	NOTES
F1	3'-0"	CONT.	1'-6"	(3) #4 CONT. TOP & BOTTOM	
F2	2'-0"	CONT.	1'-6"	(2) #4 CONT. TOP & BOTTOM	
F3	2'-0"	3'-0"	1'-6"	#4 AT 6" o.c. E.W. BOTTOM	CAST MONOLITHICALLY w/ SLAB

**MASONRY WALL (MW) SCHEDULE**

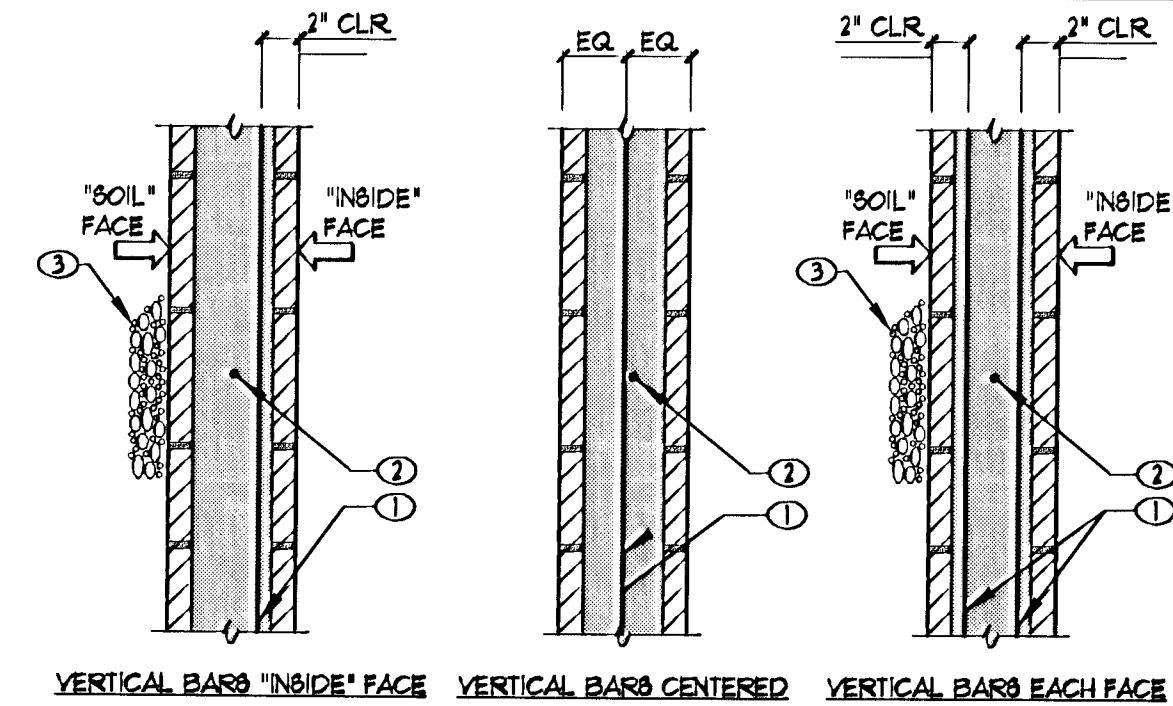

MARK	NOMINAL THICKNESS	VERT. REINFORCING FULL WALL HEIGHT	HORIZ. REINFORCING	NOTES
MU1	8"	#5 AT 48" o.c. CENTERED	#5 AT 48" o.c.	
MU2	8"	#5 AT 32" o.c. CENTERED	#5 AT 48" o.c.	
MU3	8"	#5 AT 16" o.c. CENTERED	#5 AT 48" o.c.	
MU4	12"	#5 AT 48" o.c. CENTERED	#5 AT 48" o.c.	


**FOUNDATION PLAN NOTES**

- VERIFY ALL DIMENSIONS PRIOR TO CONSTRUCTION. RESOLVE DISCREPANCIES WITH ARCHITECT.
- ALL FOOTINGS SHALL EXTEND 24 INCHES MIN. BELOW PAD GRADE. PAD GRADE IS DEFINED AS LOWEST ADJACENT COMPACTED SUBGRADE (PAD GRADE BEFORE LANDSCAPING) OR NATURAL GRADE WITHIN 5 FEET OF BUILDING FOR PERIMETER FOOTINGS, OR TOP OF EXTERIOR PAVING OR CONCRETE WHERE EXTERIOR PAVING OR CONCRETE IS PERMANENTLY LOCATED DIRECTLY ADJACENT TO BUILDING AND EXTENDS AT LEAST 5 FEET FROM BUILDING. FOOTING EXCAVATIONS SHALL BE CLEAN AND FREE FROM LOOSE DEBRIS, STANDING WATER, OR UNCOMPACTED MATERIAL AT TIME OF CONCRETE PLACEMENT.
- FINISH FLOOR ELEVATION = 100'-0" UNO.
- F1, F2, F3, ... DENOTES FOOTING PER SCHEDULE THIS SHEET.
- MU1, MU2, MU3, ... DENOTES MASONRY WALL PER SCHEDULE THIS SHEET.
- MUX (X) M-X-X" INDICATES MASONRY JAMB PER MASONRY JAMB SCHEDULE THIS SHEET. TYPICAL JAMB SHALL BE MU1 (2) 16-16" UNO. AS A MINIMUM, JAMB REINFORCING SHALL EXTEND TO LEVEL OF FIRST ELEVATED FLOOR OR ROOF ABOVE UNO.
- REFER TO TYP. DETAIL 01 FOR UTILITY PIPES AT FIG.
- TYPICAL CHORD REINFORCING SHALL BE (1) #5 IN CONTINUOUS GROUTED BOND BEAM AT ROOF LEVEL. SEE GEN. PLANS, AND DETAILS FOR SPECIAL REINFORCING REQUIRED AT CORNERS, JAMBS, WALL OPENINGS, TOP OF WALL, AND FOR REQUIRED LOCATION OF VERTICAL BARS WITHIN THE CELLS.
- INTERIOR CONCRETE SLAB ON GRADE SHALL BE 5" THICK OVER APPROVED SUBGRADE PER GEOTECHNICAL REPORT RECOMMENDATIONS. REINFORCE SLAB w/ #4 AT 18" o.c. MAX. EACH WAY CENTERED IN SLAB THICKNESS.


**MASONRY JAMB (MJ) SCHEDULE**

- EXAMPLE DESIGNATION: MJ1 (6) 16-32"
- MASONRY JAMB TYPE PER SCHEDULE BELOW
  - TOTAL NUMBER OF JAMB BARS AS NOTED ON PLAN. ACTUAL NUMBER OF BARS SPECIFIED ON PLAN MAY BE MORE OR LESS THAN SHOWN IN EXAMPLE PROFILES BELOW
  - JAMB BAR SIZE AS NOTED ON PLAN (EX: #4, #5, #6, ETC.)
  - SOLID GROUT DISTANCE AS NOTED ON PLAN. MASONRY JAMB TYPE "MU2" SHALL BE SOLID GROUTED BETWEEN OPENINGS.
  - EDGE OF WALL OPENING
  - CENTER OF BEAM OR GIRDER BEARING LOCATION
  - CENTER JAMB REINFORCING AND SOLID GROUT ON BEAM OR GIRDER BEARING LOCATION
  - PROFILES SHOWN IN SCHEDULE BELOW ARE FOR ILLUSTRATION PURPOSES ONLY. ACTUAL BAR QUANTITY, SIZE, AND GROUT DISTANCE SHALL CONFORM TO ACTUAL DESIGNATIONS.

MARK	PROFILE
MJ1	
MJ2	
MJ3	

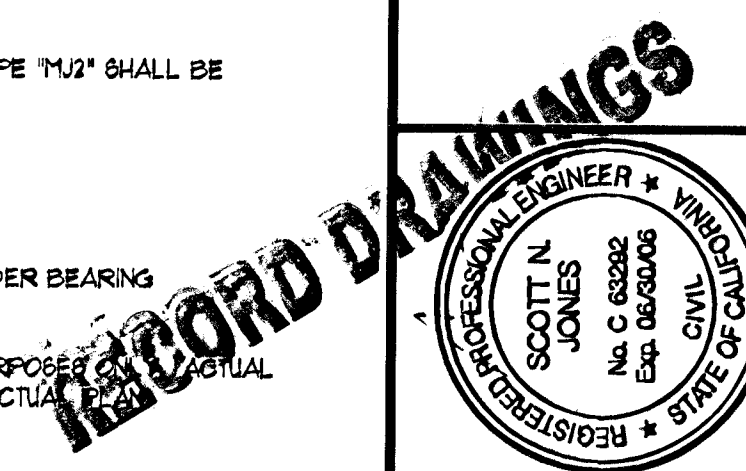

**GYPPRESS GROVE**  
**WATER PUMP STATION**  
**PUMP STATION**  
**FOUNDATION PLAN**

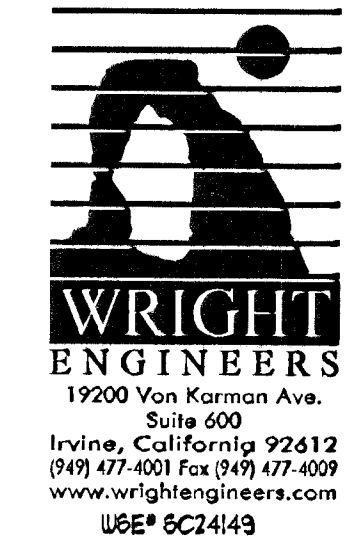


**PACIFIC ADVANCED CIVIL ENGINEERING**  
 17000 VAN KARMAN AVENUE, SUITE 400  
 IRVINE, CALIFORNIA 92612  
 PH: (714) 481-7300 FAX: (714) 481-7299

SHEET  
**A2**  
 JOB NO. 8138-E

THESE DRAWINGS ARE THE PROPERTY OF P.A.C.E. AND SHALL NOT BE REPRODUCED IN ANY MANNER NOR BE USED FOR CONSTRUCTION UNLESS STAMPED "ISSUED FOR CONSTRUCTION".

X:\2004\10-TR-049-X-SC24149-FL-049-X-SC24149-FR-049  
 Dimcode = 49; Ltitle = 24; PTitlecode = 0; Acad Ver. = 16.16 (LUS Tech); Version = 1

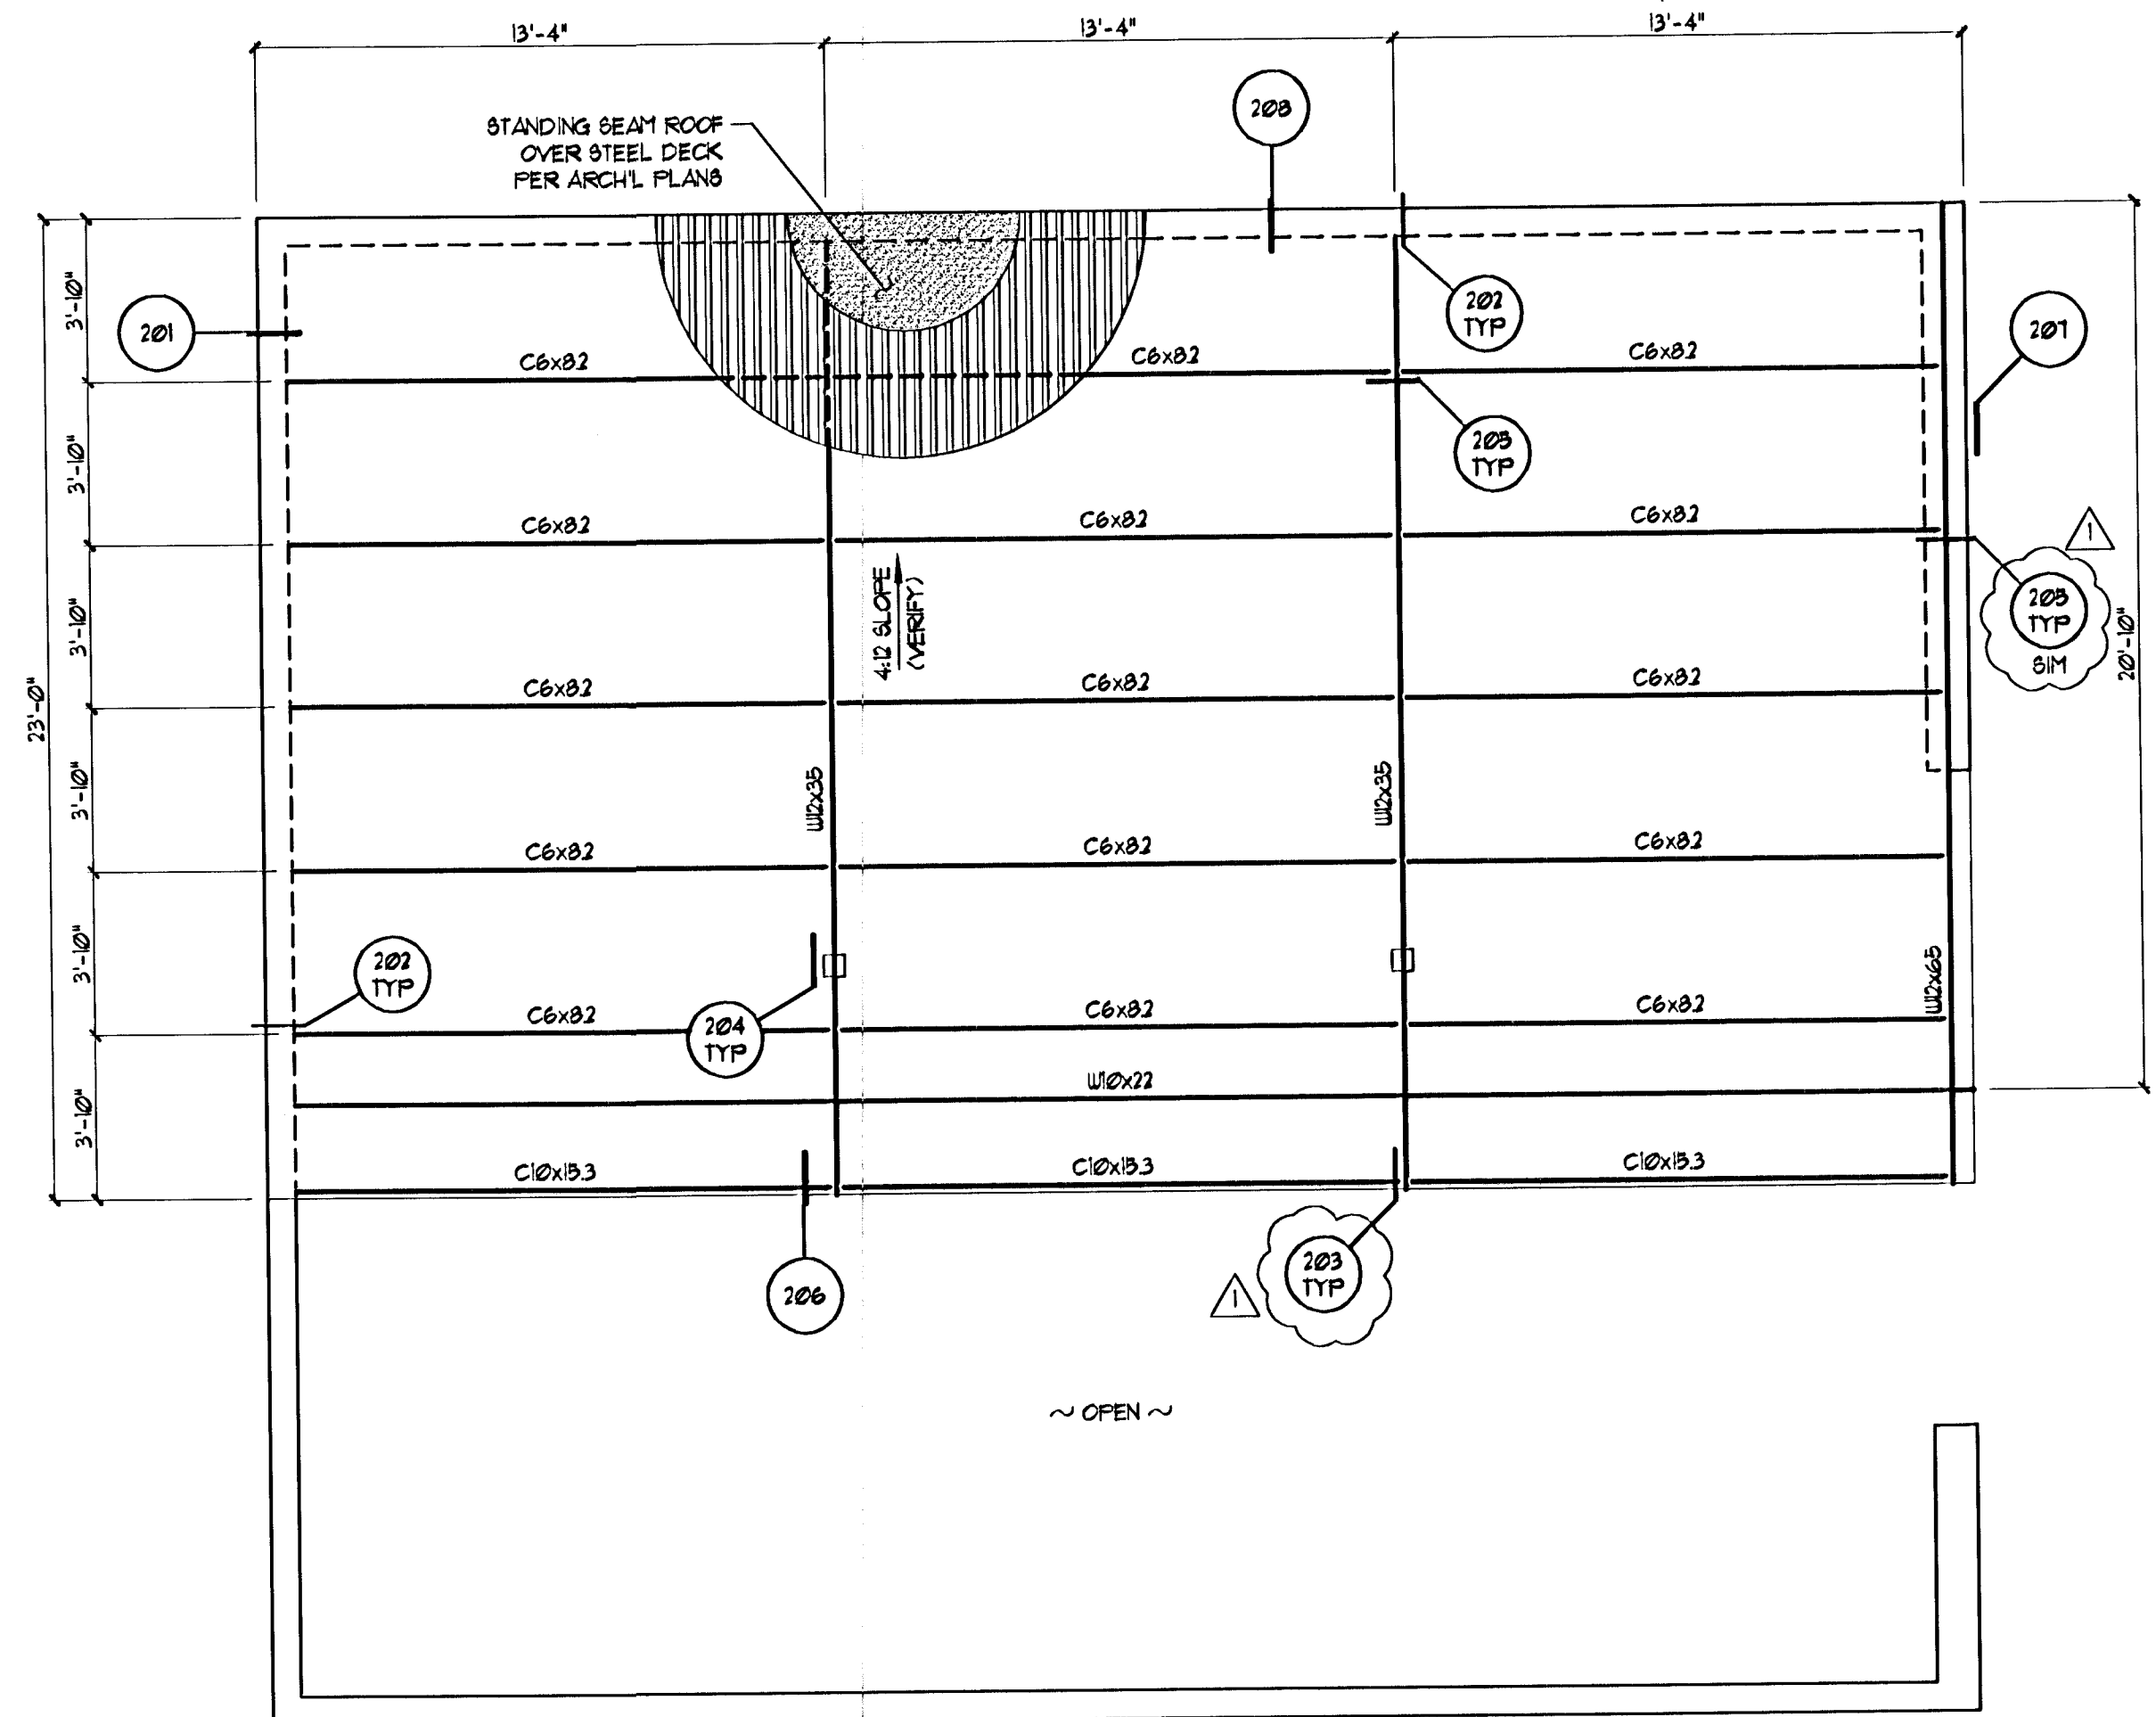


**ROOF FRAMING PLAN**  
 SCALE: 1/4" = 1'-0"

**FRAMING PLAN NOTES**


- A. VERIFY ALL ELEVATIONS, DIMENSIONS, AND SLOPES WITH LATEST ARCH'L.
- B. TYPICAL STEEL DECK: 1/2" x 20 GAGE B DECK PER G&N. ATTACH TO FRAMING PER G&N.

**RECORD DRAWINGS**

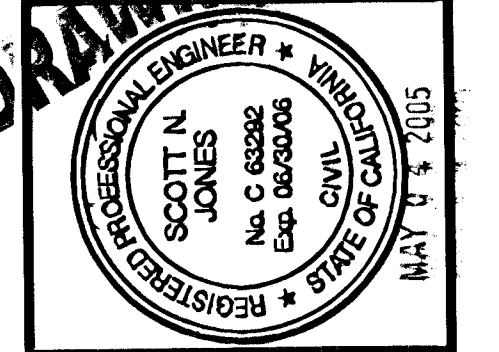

PREPARED BY	PROJECT ENGINEER
R.C.E. NO.	DATE
DRAWN	SCALE
DESIGNED	DATE
CHECKED	DATE

**CYPRESS GROVE  
 WATER PUMP STATION  
 PUMP STATION  
 ROOF FRAMING PLAN**

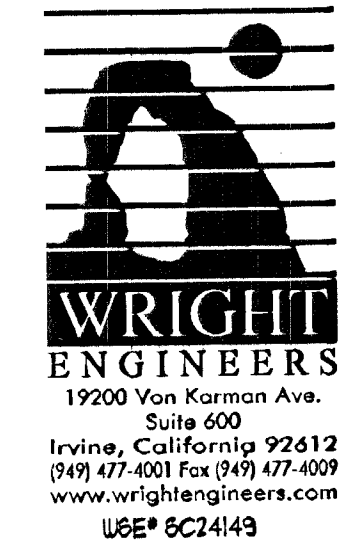

**PACIFIC ADVANCED  
 CIVIL ENGINEERING**  
 17520 NEWMORE STREET, SUITE 200  
 FOUNTAIN VALLEY, CA 92708  
 PH (714) 451-7300 FAX (714) 451-7299


SHEET  
**A3**  
 JOB NO. 8138-E

NO.	BY	DATE	REVISIONS	DATE	APP.
1	URS	3/22/05	PLAN CHECK		

THESE DRAWINGS ARE THE PROPERTY OF P.A.C.E. AND SHALL NOT BE REPRODUCED IN ANY MANNER NOR BE USED FOR CONSTRUCTION UNLESS STAMPED "ISSUED FOR CONSTRUCTION".

K:\2004\10-TR-049\10-TR-049-SC24149-FR-049-X-SC24149-FR-049.dwg - Text Layout! By: gsmith on May 04, 2005 at 06:23 am

- ① LENGTH PER TYPICAL REBAR LAP SCHEDULE
- ② BENT REBAR SIZE TO MATCH HORIZ. WALL REINF.
- ③ BENT REBAR SIZE TO MATCH HORIZ. WALL REINF. ALTERNATE DIRECTION
- ④ VERTICAL REINF. PER G&N

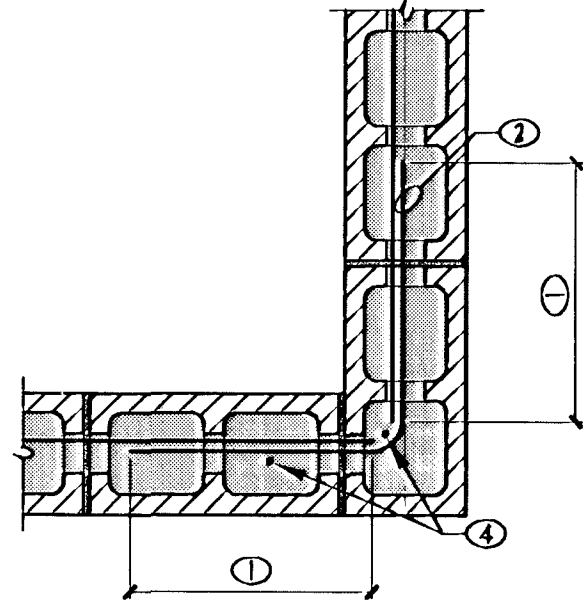

**07 TYPICAL MASONRY WALL INTERSECTION**  
M81-16 040212 TRP NO SCALE


A. WHERE WALL HORIZ. REINF. ARE AT DIFFERENT ELEVATIONS FROM EACH OTHER PROVIDE BENT BAR IN SOLID-GROUTED CELLS AT EACH HORIZ. BAR 911 TO THIS DETAIL.

- ① BAR SPACING IS MEASURED AS CENTER TO CENTER BAR SPACING. NOTIFY ENGINEER WHERE BAR SPACING IS LESS THAN MIN. SPACING NOTED IN SCHEDULE.
- ② TOP BARS ARE HORIZONTAL BARS SO PLACED THAT 12 INCHES OR MORE OF FRESH CONCRETE IS CAST IN MEMBER BELOW SPLICE.

BAR SIZE	REBAR LOCATION					
	FOOTINGS & SLAB ON GRADE (F <sub>c</sub> ≥ 2500 PSI w/ 1 1/2" CLR)			ELEVATED SLAB AND BEAMS (F <sub>c</sub> ≥ 3000 PSI w/ 3/4" CLR)		
	MIN. SPACING	TOP BARS	OTHER BARS	MIN. SPACING	TOP BARS	OTHER BARS
#3	2	18	14	2	11	13
#4	2 1/2	24	19	2	28	21
#5	3 1/4	30	23	2 1/4	41	31
#6	3 3/4	31	28	2 1/4	56	43
#7	4	60	46	2 1/2	90	69
#8	4	76	59	2 1/2	111	88
#9	4 1/4	94	72	2 3/4	134	103

- A. ALL TABULATED VALUES ARE IN UNITS OF INCHES UNO.
- B. CONCRETE LAP LENGTHS BASED ON ACI 318-99 SECTION 12.3 WITH CLASS B LAP SPLICE PER SECTION 12.5 FOR NORMAL WT CONCRETE AND UNCOATED BARS.
- C. CONCRETE STRENGTHS SHOWN ARE FOR DESIGN PURPOSES ONLY. SEE G&N FOR ACTUAL CONCRETE SPECIFICATIONS.
- D. MASONRY LAP LENGTHS BASED ON CLASS B LAP SPLICE PER ACI 318-99 AND CBC 2101 FOR UNCOATED BARS.

**04 TYPICAL REBAR LAP SCHEDULE**  
04-23915 NO SCALE

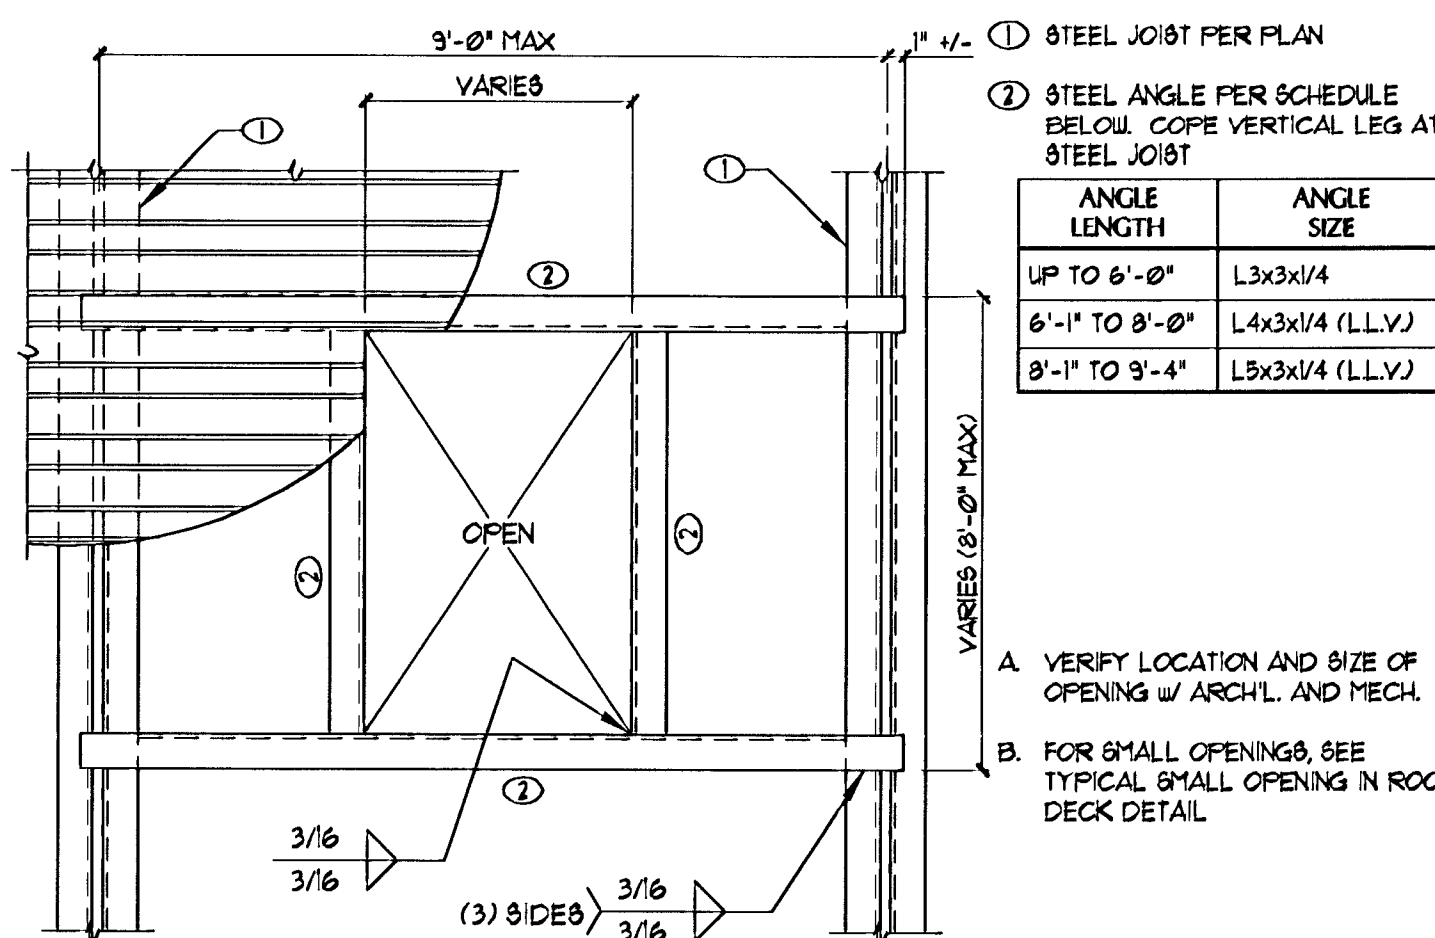


**05 TYPICAL OPENING IN ROOF**  
0501-03 040912 NO SCALE

ANGLE LENGTH	ANGLE SIZE
UP TO 6'-0"	L3x3x1/4
6'-1" TO 8'-0"	L4x3x1/4 (LLV)
8'-1" TO 9'-4"	L5x3x1/4 (LLV)

- A. VERIFY LOCATION AND SIZE OF OPENING W/ ARCHL. AND MECH.
- B. FOR SMALL OPENINGS, SEE TYPICAL SMALL OPENING IN ROOF DECK DETAIL.


**08 TYPICAL COLUMN BASE PLATE SCHEDULE**  
08-92434 NO SCALE

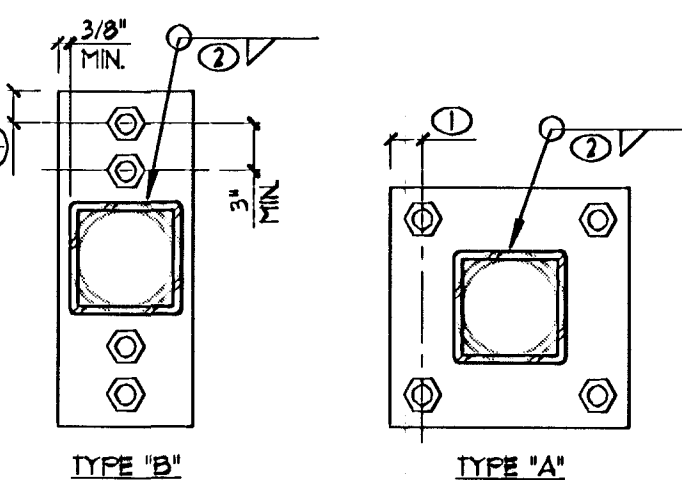

- ① AISC MIN. EDGE DISTANCE OR EDGE DISTANCE TO ACCOMMODATE PLATE WASHER AND WELDS, WHICHEVER IS GREATER.
- ② 1/4" OR MIN. WELD SIZE PER AISC MANUAL TABLE J2.4, WHICHEVER IS GREATER FOR BASE PLATES UP TO 3/4" THICK, 5/16" FOR BASE PLATES OVER 3/4" THICK.


- A. SEE PLAN OR SCHEDULE FOR BASE PLATE DIMENSIONS.
- B. BASE PLATE CONNECTIONS MAY REQUIRE MORE ANCHOR BOLTS THAN SHOWN. SEE PLAN OR SCHEDULE FOR SIZE, TYPE, AND NUMBER OF BOLTS. SEE SCHEDULE BELOW FOR MAX. ANCHOR BOLT HOLE DIA.

BOLT DIA. (Ø)	MAX. HOLE DIA.
3/4" TO 1"	Ø + 3/16"
1" TO 2"	Ø + 1/2"
OVER 2"	Ø + 1"

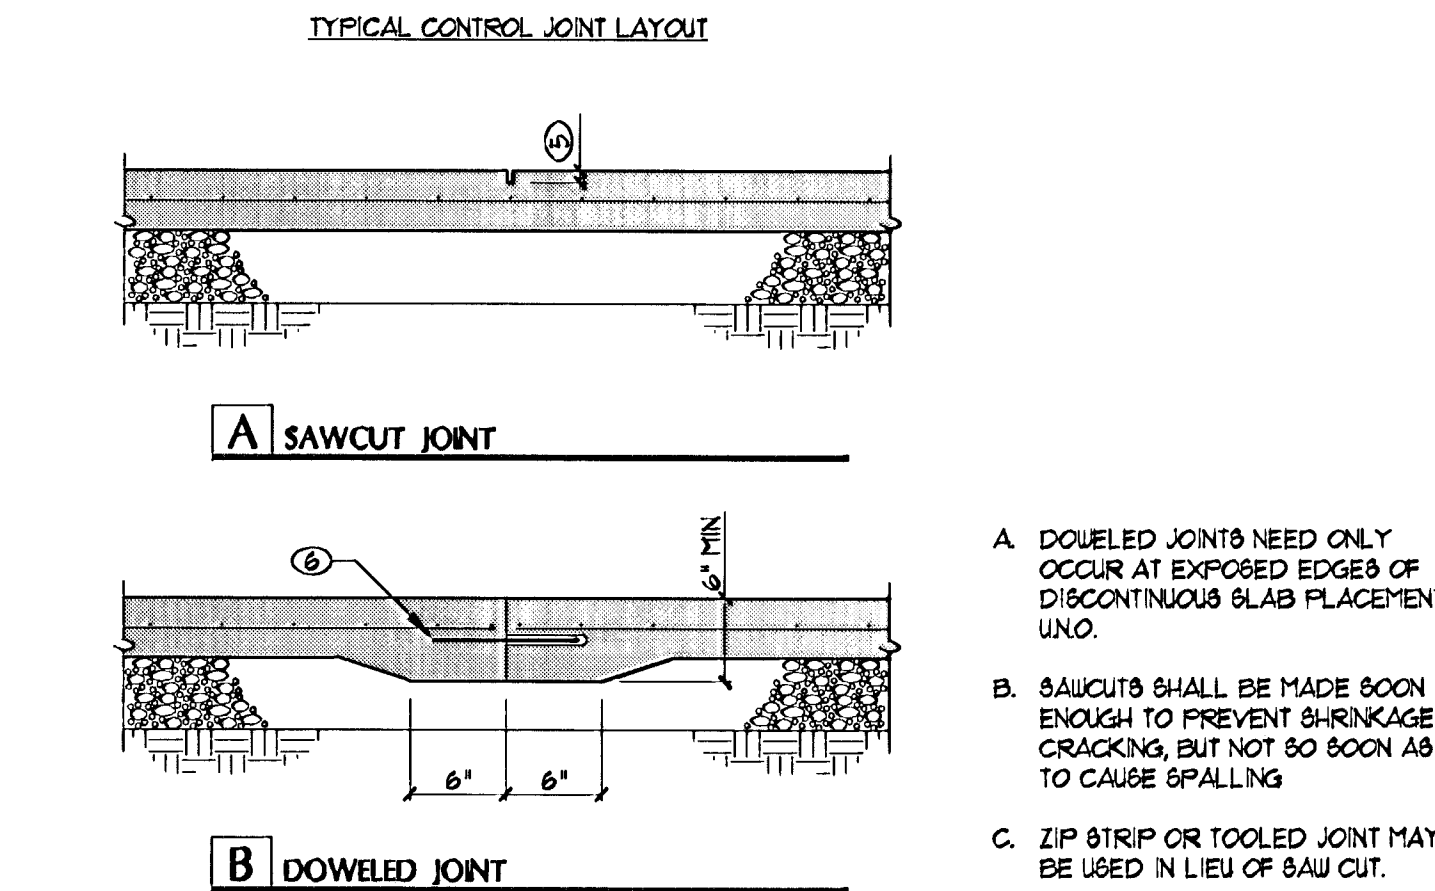

**06 TYPICAL CONTROL JOINT IN SLAB ON GRADE**  
F02-23 020711 NO SCALE


- A. DOWELED JOINTS NEED ONLY OCCUR AT EXPOSED EDGES OF DISCONTINUOUS SLAB PLACEMENT UNO.
- B. SAWCUTS SHALL BE MADE SOON ENOUGH TO PREVENT SHRINKAGE CRACKING, BUT NOT SO SOON AS TO CAUSE SPALLING.
- C. ZIP STRIP OR TOOLED JOINT MAY BE USED IN LIEU OF SAW CUT.

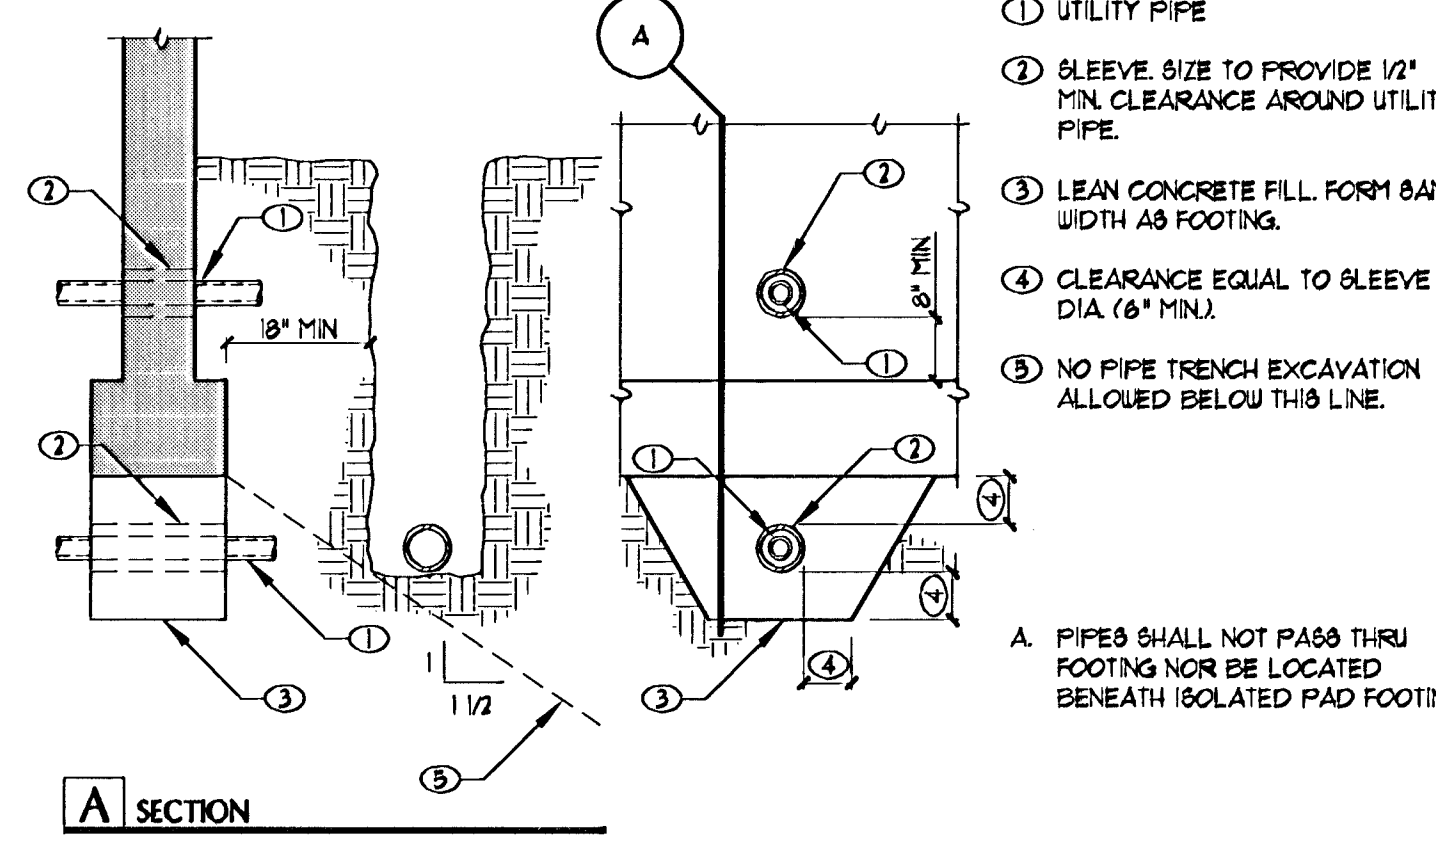

**01 UTILITY PIPES AT FOOTING**  
F01-01 030713 NO SCALE

- ① UTILITY PIPE
- ② BLEEVE SIZE TO PROVIDE 1/2" MIN. CLEARANCE AROUND UTILITY PIPE.
- ③ LEAN CONCRETE FILL. FORM SAME WIDTH AS FOOTING.
- ④ CLEARANCE EQUAL TO BLEEVE DIA. (6" MIN.).
- ⑤ NO PIPE TRENCH EXCAVATION ALLOWED BELOW THIS LINE.


A. PIPES SHALL NOT PASS THRU FOOTING NOR BE LOCATED BENEATH ISOLATED PAD FOOTING.

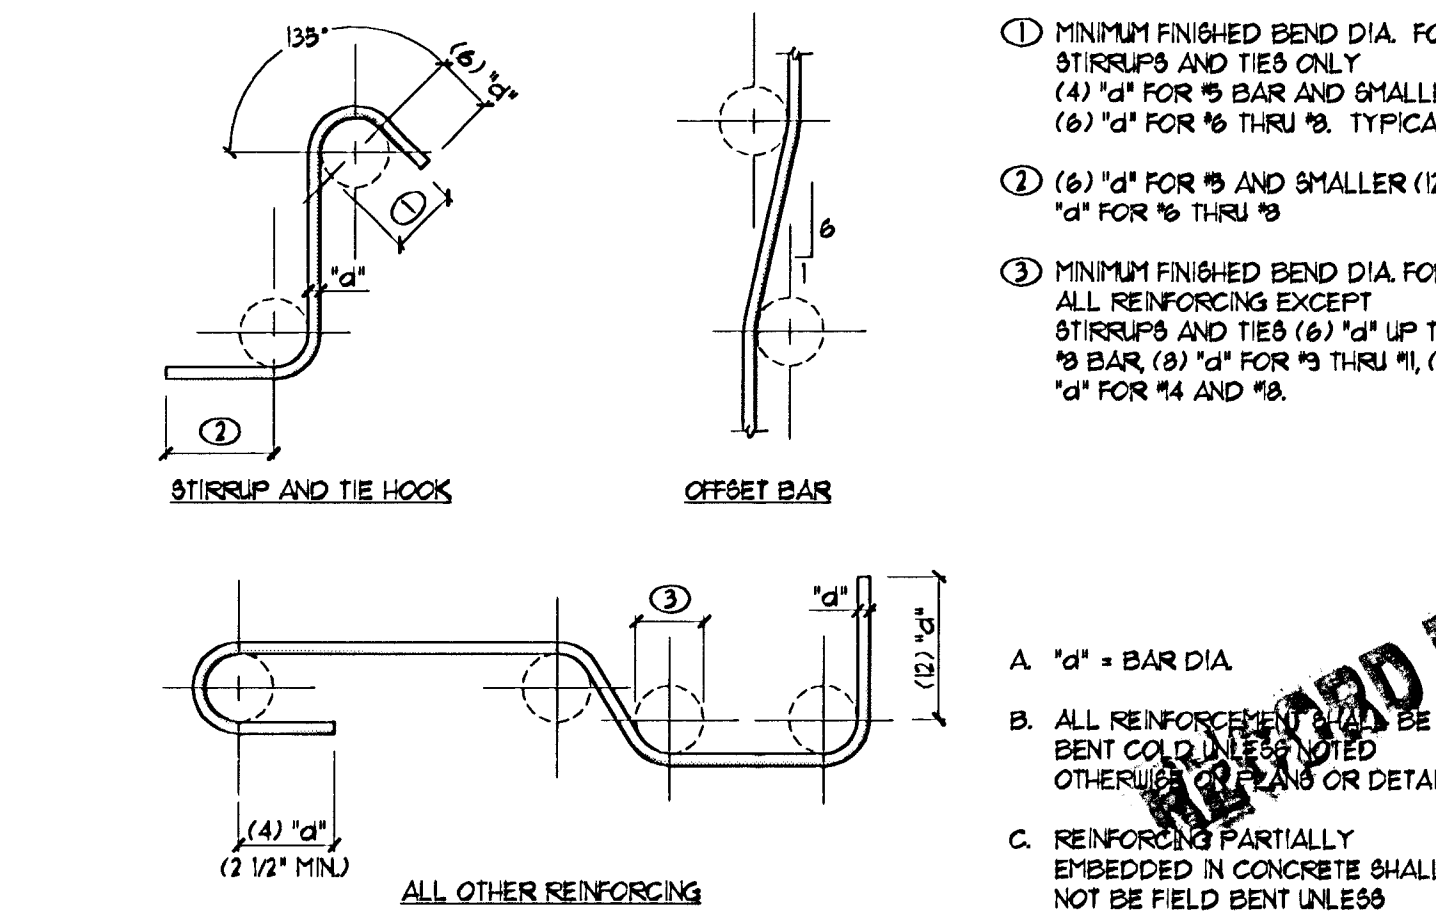

**02 STANDARD REBAR BEND DETAILS**  
02-01 030703 NO SCALE

- ① MINIMUM FINISHED BEND DIA. FOR STIRRUPS AND TIES ONLY (4) "d" FOR #5 BAR AND SMALLER (6) "d" FOR #6 THRU #8. TYPICAL.
- ② (6) "d" FOR #9 AND SMALLER (12) "d" FOR #9 THRU #8.
- ③ MINIMUM FINISHED BEND DIA. FOR ALL REINFORCING EXCEPT STIRRUPS AND TIES (6) "d" UP TO #8 BAR (8) "d" FOR #9 THRU #11, (12) "d" FOR #14 AND #18.

- A. "d" = BAR DIA.
- B. ALL REINFORCING SHALL BE BENT COLU. UNLESS OTHERWISE NOTED OR DETAILS.
- C. REINFORCING PARTIALLY EMBEDDED IN CONCRETE SHALL NOT BE FIELD BENT UNLESS SPECIFICALLY NOTED ON PLANS OR DETAILS.

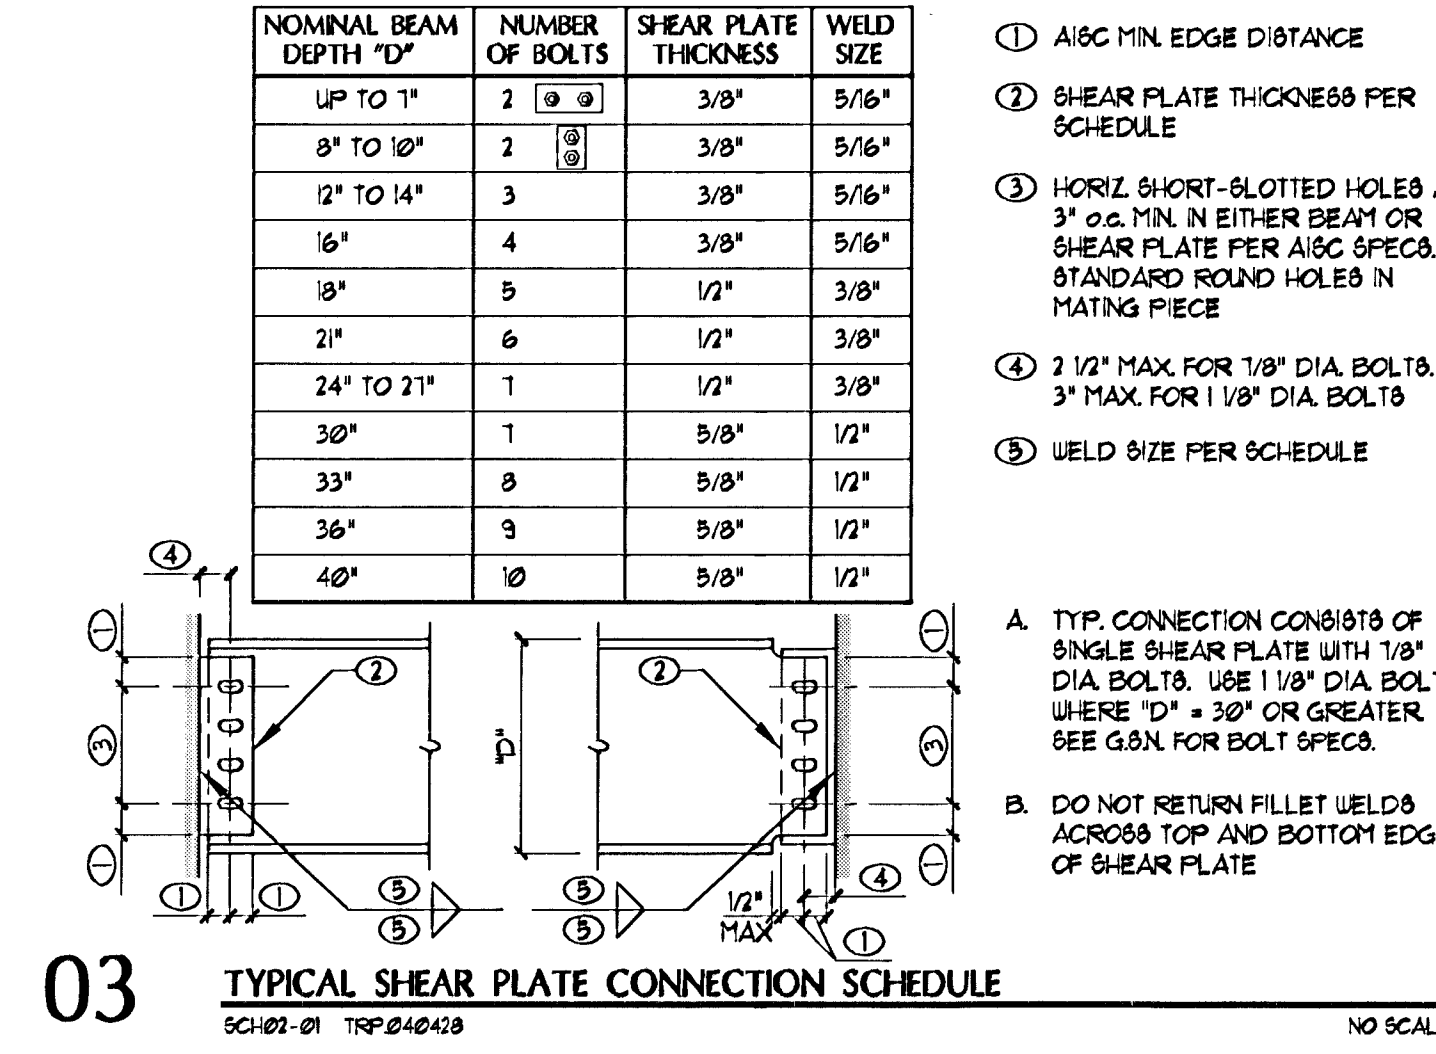

**03 TYPICAL SHEAR PLATE CONNECTION SCHEDULE**  
SC102-01 TRP 040418 NO SCALE

NOMINAL BEAM DEPTH "D"	NUMBER OF BOLTS	SHEAR PLATE THICKNESS	WELD SIZE
UP TO 1"	2 (Ø)	3/8"	5/16"
8" TO 10"	2 (Ø)	3/8"	5/16"
12" TO 14"	3	3/8"	5/16"
16"	4	3/8"	5/16"
18"	5	1/2"	3/8"
21"	6	1/2"	3/8"
24" TO 27"	7	1/2"	3/8"
30"	7	5/8"	1/2"
33"	8	5/8"	1/2"
36"	9	5/8"	1/2"
40"	10	5/8"	1/2"

- ① AISC MIN. EDGE DISTANCE
- ② SHEAR PLATE THICKNESS PER SCHEDULE
- ③ HORIZ. SHORT-SLOTTED HOLES AT 3" O.C. MIN. IN EITHER BEAM OR SHEAR PLATE PER AISC SPECS. STANDARD ROUND HOLES IN MATING PIECE
- ④ 2 1/2" MAX FOR 1/8" DIA. BOLTS, 3" MAX FOR 1 1/8" DIA. BOLTS
- ⑤ WELD SIZE PER SCHEDULE

- A. TYP. CONNECTION CONSISTS OF SINGLE SHEAR PLATE WITH 1/8" DIA. BOLTS. USE 1 1/8" DIA. BOLTS WHERE "D" = 30" OR GREATER. SEE G&N FOR BOLT SPECS.
- B. DO NOT RETURN FILLET WELDS ACROSS TOP AND BOTTOM EDGES OF SHEAR PLATE

NO.	BY	DATE	REVISIONS	DATE	APP.

**SCOTT N. JONES**  
REGISTERED PROFESSIONAL ENGINEER  
No. C 60808  
Exp. 06/30/08  
STATE OF CALIFORNIA  
MAY 13 2005

PREPARED BY	PROJECT ENGINEER	R.C.E. NO.	SCALE	DATE

**CYPRESS GROVE WATER PUMP STATION TYPICAL DETAILS**

**PACIFIC ADVANCED CIVIL ENGINEERING**  
17520 NEWHOPE STREET, SUITE 200  
FOUNTAIN VALLEY, CA 92708  
PH (714) 481-7300 FAX (714) 481-7299


**WRIGHT ENGINEERS**  
19200 Van Karman Ave. Suite 600  
Irvine, California 92612  
(949) 477-4001 Fax (949) 477-4009  
www.wrightengineers.com  
USE# 6C2449

SHEET **AD1**

JOB NO. 8138-E




**208 STEEL DECK AT MASONRY WALL**

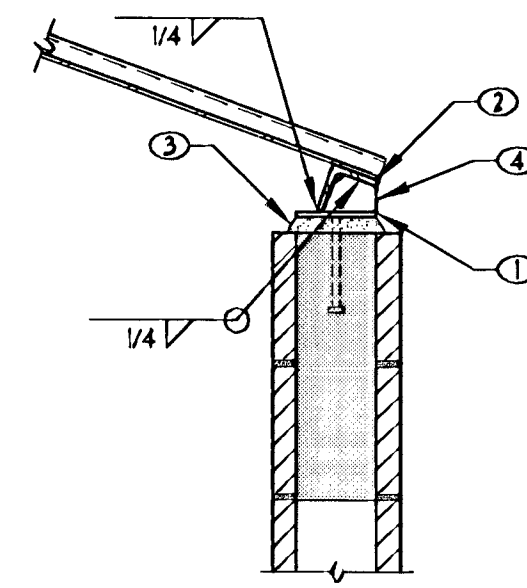

- ① EMBED PLATE 3/8" x 5" x 0'-10" w/ (3) 1/2" DIA x 6" NELSON STUDS
- ② 3/8" x CONT. EDGE ANGLE. ATTACH STEEL DECK TO ANGLE PER G.B.N.
- ③ 1" +/- GROUT OR DRYPACK
- ④ 1/4" PLATE CUT TO FIT. (1) PER EMBED PLATE


- A. MIN. (2) EMBED PLATES PER EDGE ANGLE
- B. MAX. EMBED PLATE SPACING 4'-0" o.c.
- C. WALL VERTICAL REINFORCING NOT SHOWN FOR CLARITY

**205 STEEL BEAM TO BEAM SHEAR PLATE CONNECTION**

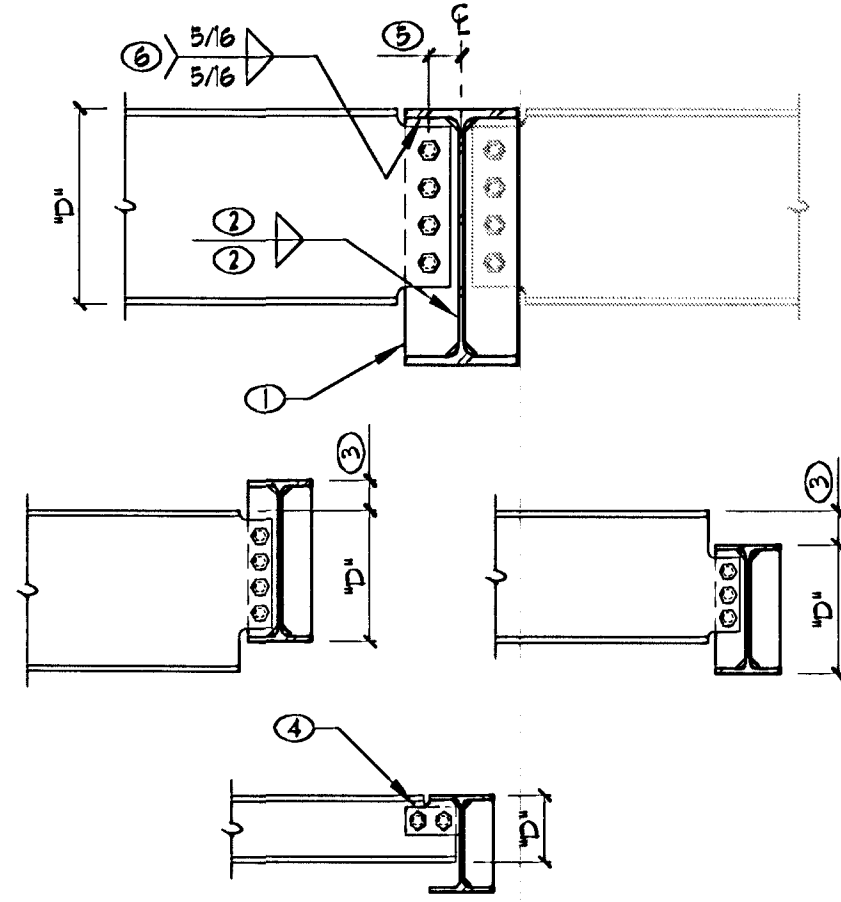


- ① SHEAR PLATE AND SIZE AND NUMBER OF BOLTS PER TYPICAL SHEAR PLATE CONNECTION SCHEDULE
  - ② WELD SIZE PER TYPICAL SHEAR PLATE CONNECTION SCHEDULE
  - ③ OFFSET TOP OF BEAM TO MATCH ADJACENT STEEL JOIST BEARING DEPTH AS OCCURS
  - ④ (2) BOLTS HORIZ AT 10" x 1" OR LESS. WELD PLATE TO BEAM AT (2) EDGES
  - ⑤ 2 1/2" MAX FOR 1/8" DIA. BOLTS. 3" MAX FOR 1 1/8" DIA. BOLTS
  - ⑥ SHEAR PLATE TO BEAM FLANGE, TYP.
- A. AT ONE-SIDED CONNECTIONS, PROVIDE 3/8" STIFFENER OPPOSITE SHEAR PLATE

**202 STEEL BEAM AT MASONRY WALL**

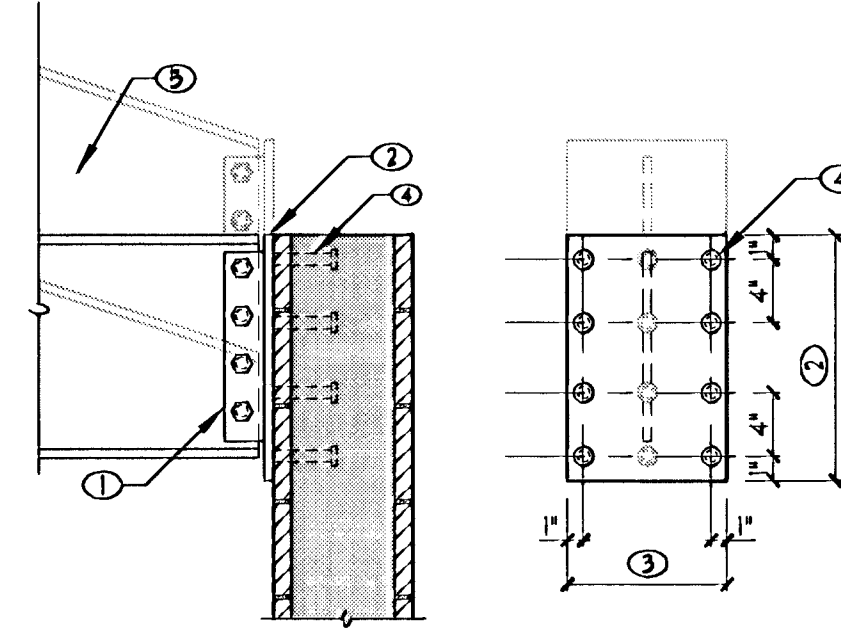

- ① SHEAR PLATE SIZE AND NUMBER OF BOLTS PER TYPICAL SHEAR PLATE CONNECTION SCHEDULE
- ② 3/4" EMBED PLATE. DEPTH EQUAL TO BEAM DEPTH (14" MIN)
- ③ 9" FOR BEAM'S UP TO 18" DEEP. 12" FOR BEAM'S UP TO 24" DEEP
- ④ 3/4" DIA x 5" NELSON STUDS. (8) FOR BEAM'S UP TO 18" DEEP. (12) FOR BEAM'S UP TO 24" DEEP
- ⑤ SLOPED BEAM AS OCCURS

**101 MASONRY WALL AT FOOTING**

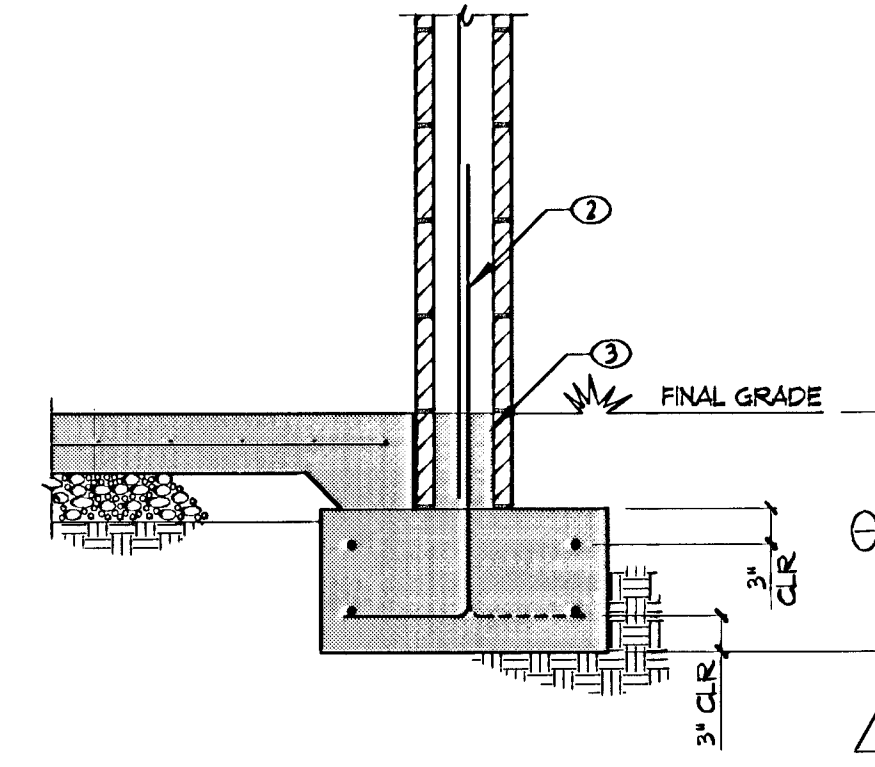

- ① EMBEDMENT PER FOOTING SCHEDULE
  - ② DOWEL TO MATCH AND LAP WITH VERTICAL WALL REINFORCING
  - ③ GROUT SOLID BELOW FINISH FLOOR
- A. GROUT AT WALL VERTICAL REINFORCING NOT SHOWN FOR CLARITY


NO SCALE

NO SCALE

NO SCALE

NO SCALE


**206 FACADE AT STEEL BEAM**

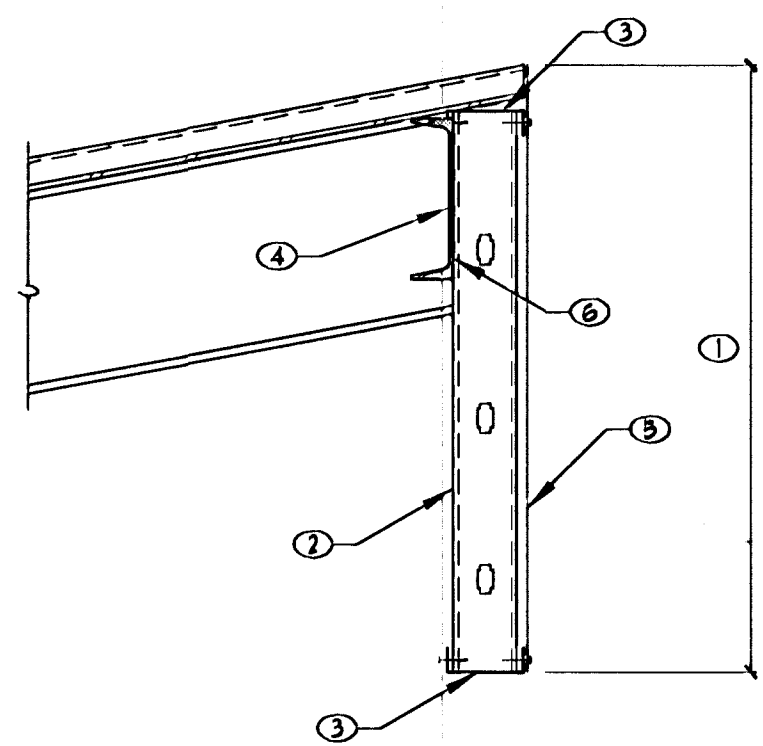

- ① DEPTH PER ARCHL (36" MAX)
  - ② 4020/62-54 STEEL STUDS AT 24" o.c.
  - ③ 402150-54 TOP & BOTTOM TRACK w/ #10 SCREW INTO EACH STUD EACH SIDE
  - ④ CHANNEL TO BEAM ATTACHMENT PER TYPICAL DETAIL
  - ⑤ FINISH PER ARCHL
  - ⑥ WELD STUD TO BEAM WEB w/ 1/8" x 2" FILLET WELD AT 12" o.c.
- A. PROVIDE 1/8 GAGE ANGLED PLATE ON C-CHANNEL TOP FLANGE WHERE REQ'D TO CONNECT STEEL DECK PER GEN. WELD ANGLED PLATE TO C-CHANNEL TOP FLANGE w/ 1/8" x 2" FILLET WELDS AT 12" o.c.

NO SCALE


**203 CRANE RAIL SUPPORT AT SLOPED STEEL BEAM**

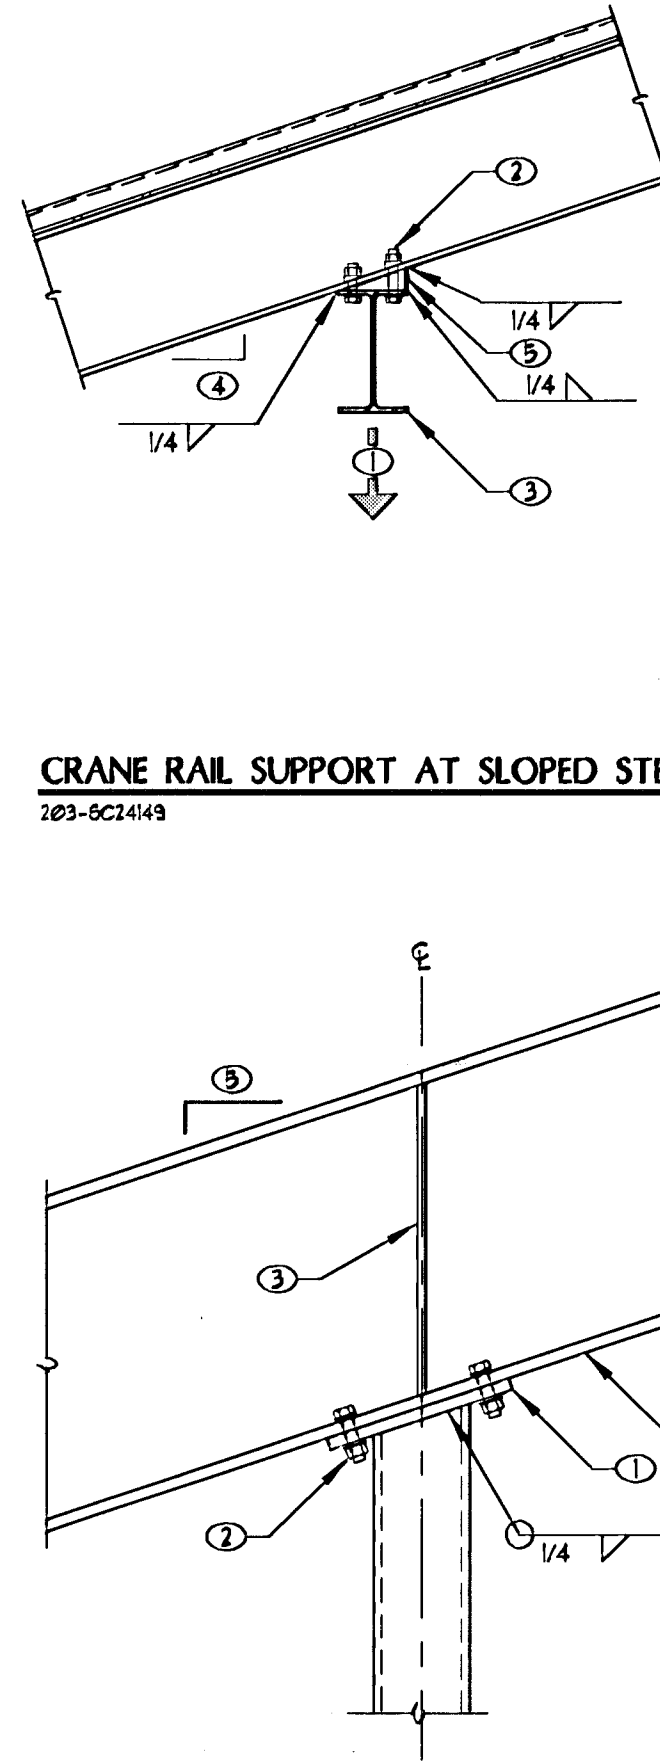

- ① MAX. CRANE LOAD TO BEAM FROM CRANE SHALL NOT EXCEED 15000 LBS UNFACTORED TOTAL LOAD
- ② (4) 3/4" DIA. BOLTS w/ BEVELED WASHERS (BEVEL TO MATCH ROOF SLOPE)
- ③ CRANE RAIL PER PLAN
- ④ SLOPE PER ARCHL
- ⑤ 1/4" STEEL PLATE. LENGTH TO MATCH WIDTH OF SLOPED BEAM

NO SCALE


**102 TYPICAL SLAB AT WALL OPENING**

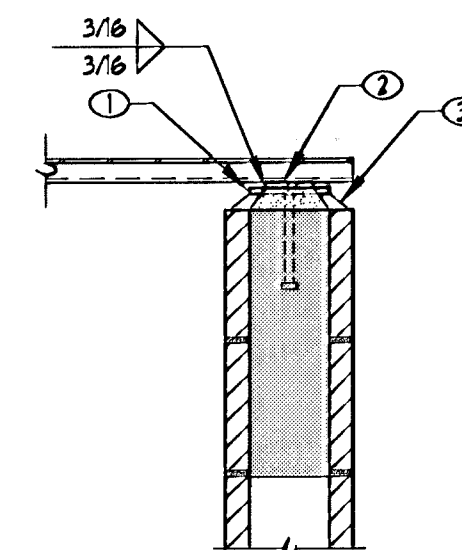

- ① EMBED PLATE 3/8" x 5" x 0'-5" w/ (2) 1/2" DIA x 6" NELSON STUDS
  - ② 3/8" x 3" x CONT. DECK BEARING PLATE
  - ③ 1" +/- GROUT OR DRYPACK
- A. MAX. EMBED PLATE SPACING 4'-0" o.c.  
 B. WALL VERTICAL REINFORCING NOT SHOWN FOR CLARITY

NO SCALE


**207 STEEL BEAM AT MASONRY WALL**

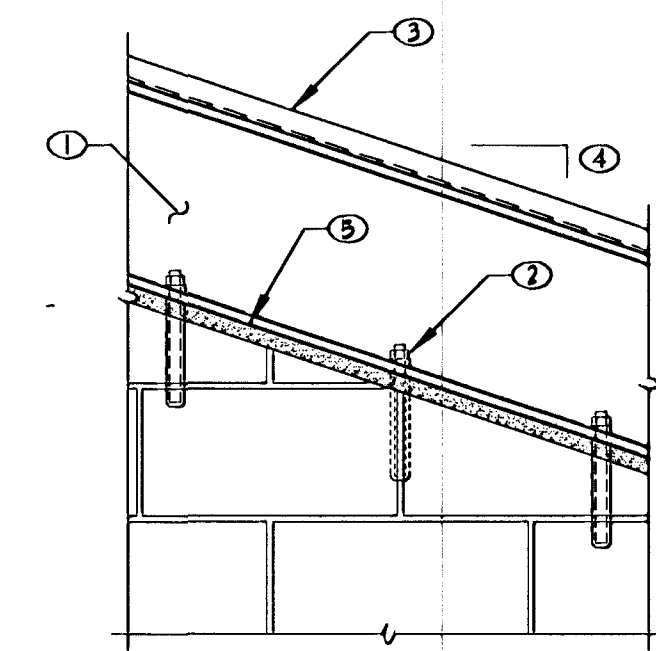

- ① STEEL BEAM PER PLAN. CENTER BEAM ON WALL
- ② 3/8" DIA x 6 3/8" EMBEDMENT EPOXY BOLT AT 18" o.c. STAGGER BOLTS ON EITHER SIDE OF BEAM WEB. PROVIDE BEVEL WASHERS TO MATCH SLOPE OF BEAM
- ③ STEEL DECK PER PLAN
- ④ SLOPE PER ARCHL
- ⑤ 1" +/- GROUT OR DRYPACK

NO SCALE


**204 SLOPED STEEL BEAM AT STEEL COLUMN**

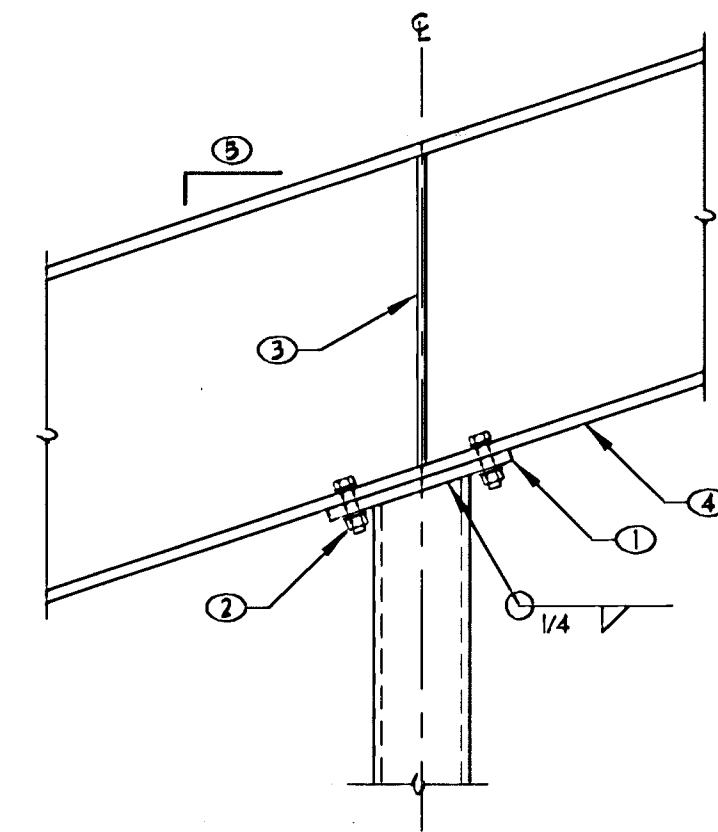

- ① 3/4" CAP PLATE
- ② (4) 3/4" DIA BOLTS
- ③ 1/2" STIFFENER
- ④ CONTINUOUS CANTILEVER BEAM AS OCCURS
- ⑤ SLOPE PER ARCHL

NO SCALE

**201 STEEL DECK AT MASONRY WALL**

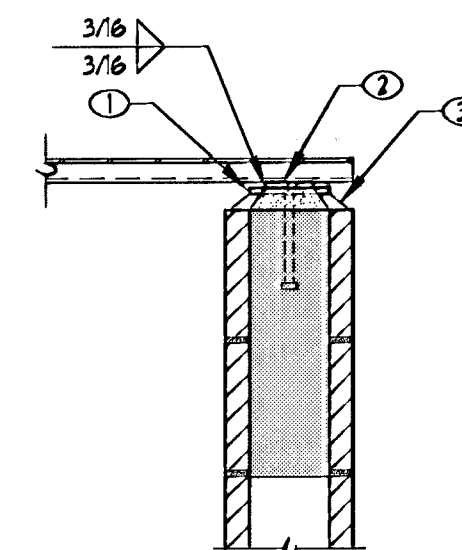

- ① EMBED PLATE 3/8" x 5" x 0'-5" w/ (2) 1/2" DIA x 6" NELSON STUDS
  - ② 3/8" x 3" x CONT. DECK BEARING PLATE
  - ③ 1" +/- GROUT OR DRYPACK
- A. MAX. EMBED PLATE SPACING 4'-0" o.c.  
 B. WALL VERTICAL REINFORCING NOT SHOWN FOR CLARITY

NO SCALE

PLAN CHECK	DATE	APP.
URS 3/24/05		
	NO	REVISIONS
	BY	DATE

**RECORD DRAWINGS**

REGISTERED PROFESSIONAL ENGINEER - MECHANICAL  
**SCOTT N. JONES**  
 No. C 62288  
 Exp. 06/30/08  
 CIVIL  
 STATE OF CALIFORNIA  
 MAY 11, 2005

PROJECT ENGINEER	SCALE	DATE
R.C.E. NO. ---		
EXP.	DRAWN	CHECKED

**CYPRESS GROVE WATER PUMP STATION FOUNDATION AND FRAMING DETAILS**

**PACE PACIFIC ADVANCED CIVIL ENGINEERING**  
 17520 NEWHOPE STREET, SUITE 200  
 FOUNTAIN VALLEY, CA 92708  
 PH (714) 461-7500 FAX (714) 461-7299


**WRIGHT ENGINEERS**  
 19200 Von Karman Ave. Suite 600  
 Irvine, California 92612  
 (949) 471-0011 Fax (949) 471-6009  
 www.wrightengineers.com  
 URS# 6C24149

SHEET **AD2**  
 JOB NO. 8138-E

EQUIPMENT LIST

ITEM	NAME	MANUFACTURER	MODEL	DESCRIPTION	QTY
1	SUBMERSIBLE STORMWATER PUMP	FLYGT	LL 3400/715	7900 GPM @ 30' TDH; SINGLE SPEED DRIVE, 110 HP, 460V, 3 PH, 60 HZ, FM RATED	3
2	SUBMERSIBLE IRRIGATION PUMP	GRUNDFOS	385S	450 GPM @ 90 PSI; VFD; 30 HP, 460V, 3 PH, 60 HZ; MANUFACTURER'S SUCTION SCREEN	2
3	SUBMERSIBLE RECIRCULATION PUMP	FLYGT	LL 3127.090	800 GPM @ 18 TDH; SINGLE SPEED DRIVE; 10 HP, 460V, 3 PH, 60 HZ; FM RATED	1
4	BLADDER TANK	WELL MATE	COMMERCIAL CLASS	200 GALLON CAPACITY WITH BLADDER; 125 P.S.I. RATED; VERTICAL TANK	1
5	AIR COMPRESSOR	GAST	1023	WALL MOUNTED AERATION UNIT; 3/4 HP; 8.5 CFM PER 10 P.S.I. AIR COMPRESSOR; 120V SINGLE PHASE	2
6	2 1/2" Y-STRAINER	-	-	Y-STRAINER SHALL BE PROVIDED BY THE IRRIGATION SUCTION SCREEN MANUFACTURER (BRONZE CONSTRUCTION)	1
7	2 1/2" BALL VALVE	SPEARS	TRU UNION 2000	150 P.S.I. RATED; INDUSTRIAL STANDARD; TRUE UNION BALL VALVE; FLANGED END CONNECTORS	1
8	PRESSURE REDUCING CONTROL VALVE	CLA VALVE	100-01	2.5" FLANGED; ADJUSTABLE; 150 P.S.I. RATED; DUCTILE IRON BODY	1
9	6" CHECK VALVE	VAL-MATIC	VM506A	"SWING-FLEX" MODEL; ANSI CLASS 125 (200 PSI RATED, NON SLAM FEATURE)	2
10	18" CHECK VALVE	VAL-MATIC	FM518A	"SWING-FLEX" MODEL; ANSI CLASS 125 (200 PSI RATED, NON SLAM FEATURE)	3
11	6" KNIFE GATE VALVE	DeZURICK	KGL	STAINLESS STEEL; 304 S.S., KNIFE GATE; NBR SEAT TYPE C PACKING; WITH HANDWHEEL OPERATOR	2
12	18" KNIFE GATE VALVE	DeZURICK	KGL	STAINLESS STEEL; 304 S.S., KNIFE GATE; NBR SEAT TYPE C PACKING; WITH HANDWHEEL OPERATOR	3
13	1" AIR COMBINATION VALVE	VAL-MATIC	201C.2	SINGLE HOUSING TYPE; ANSI 125 CLASS THREADED INLET; RATED FOR 150 P.S.I.	2
14	3" AIR COMBINATION VALVE	VAL-MATIC	203C.2	SINGLE HOUSING TYPE; ANSI 125 CLASS THREADED INLET; RATED FOR 150 P.S.I.	3
15	6" AIR COMBINATION VALVE	VAL-MATIC	106/38	CUSTOM BUILT SINGLE HOUSING TYPE; ANSI 125 CLASS THREADED INLET; RATED FOR 150 P.S.I. SEE DETAIL	1
16	LEVEL TRANSDUCER	KPSI	735	SUBMERSIBLE HYDROSTATIC LEVEL TRANSDUCER; ACCURACY UP TO ±0.5% F.S.; WELDED 316 S.S. CONSTRUCTION; ANALOG OUTPUTS OF 4-20mA (SET 2.5' FROM BASE OF STRUCTURE)	1
17	PRESSURE TRANSDUCER	KPSI	28	PRESSURE TRANSDUCER ACCURACY UP TO ±0.5% F.S.; WELDED 316 S.S. CONSTRUCTION; ANALOG OUTPUTS OF 4-20mA (SET 8" FROM BASE OF STRUCTURE)	1
18	LIQUID LEVEL PROBES	WARRICK	SERIES 3Y PROBES	SUBMERSIBLE LIQUID PROBES; PROBE MATERIAL 316 S.S., SHIELD MATERIAL: TEFLON (SET 8" FROM BASE OF STRUCTURE)	1
19	8" MAGNETIC FLOW METER	SIEMENS	MAGFLO MAG 5100 W	COMBINED TYPE, AWWA/ANSI 150 LB FLANGES, 4-20 mA OUTPUTS; ± 0.1% UNCERTAINTY	1
20	PRESSURE GAUGE	WIKA	233.34-9834800-833	15 P.S.I. 1/2"NPT; 4.5" CASE; 233.34 MODEL - LIQUID (GLYCERINE) FILLED; 316 S.S. WETTED PARTS; POCAN CASE	1
21	PRESSURE GAUGE	WIKA	233.34-9834800-833	30 P.S.I. 1/2"NPT; 4.5" CASE; 233.34 MODEL - LIQUID (GLYCERINE) FILLED; 316 S.S. WETTED PARTS; POCAN CASE	4
22	PRESSURE GAUGE	WIKA	233.34-9834800-833	200 P.S.I. 1/2"NPT; 4.5" CASE; 233.34 MODEL - LIQUID (GLYCERINE) FILLED; 316 S.S. WETTED PARTS; POCAN CASE	2
23	BRIDGE CRANE	DEMAG	HOIST: DKUN16-1600V1-2/1F4 TROLLEY:EU36DK	3.0 TON OVERHEAD BRIDGE CRANE; LIFT: 20'-0" (OR AS REQUIRED) ACTIVE LIFT @ 16/4 FPM; 4.02/0.99 AMPS (AT FULL LOAD); 6.4/32; VOLTAGE: 460/3/60	1
24	BACKUP GENERATOR	GENERAC	SD0250-K3612	250 KW STANDBY POWER GENERATOR, 12 HOUR FUEL TANK (277/480 VAC, 3 PH, 60 HZ)	1
25	MOTOR CONTROL CENTER	CUTLER-HAMMER	-	MCC ENCLOSURE RATED NEMA 3R; 480 VAC	1
26	BOLLARD	-	-	4" DIA. x 36" HIGH, CEMENT FILLED, PAINTED YELLOW, SEE DETAIL	3
27	SAFETY GRATE WALKWAY	SYRACUSE CASTINGS	-	PEDESTRIAN RATED, SEE DETAIL	-
28	HANDRAILING	-	-	PER DETAIL	-
29	STAIRWAY	-	-	PER DETAIL	1
30	BRUSH FILTER	AMIAD	3-1087-1110-3500	900 GPM, 300 MICRON WEDGE WIRE SCREEN, 150 PSI RATED, CARBON STEEL HOUSING, STAINLESS STEEL INTERNALS, FILTER CONTROL PANEL, 8" GEAR OPERATED B/FV, (230V, 1Ø)	1

\*NOTE - ALL EQUIPMENT SHOWN ABOVE HAS BEEN PRE-APPROVED PER THE SPECIFICATIONS. ALL PROPOSED EQUIPMENT MODIFICATIONS MUST BE APPROVED BY THE ENGINEER "AS EQUAL" (I.E. MUST SATISFY THE REQUIREMENTS OF THE SPECIFICATION).

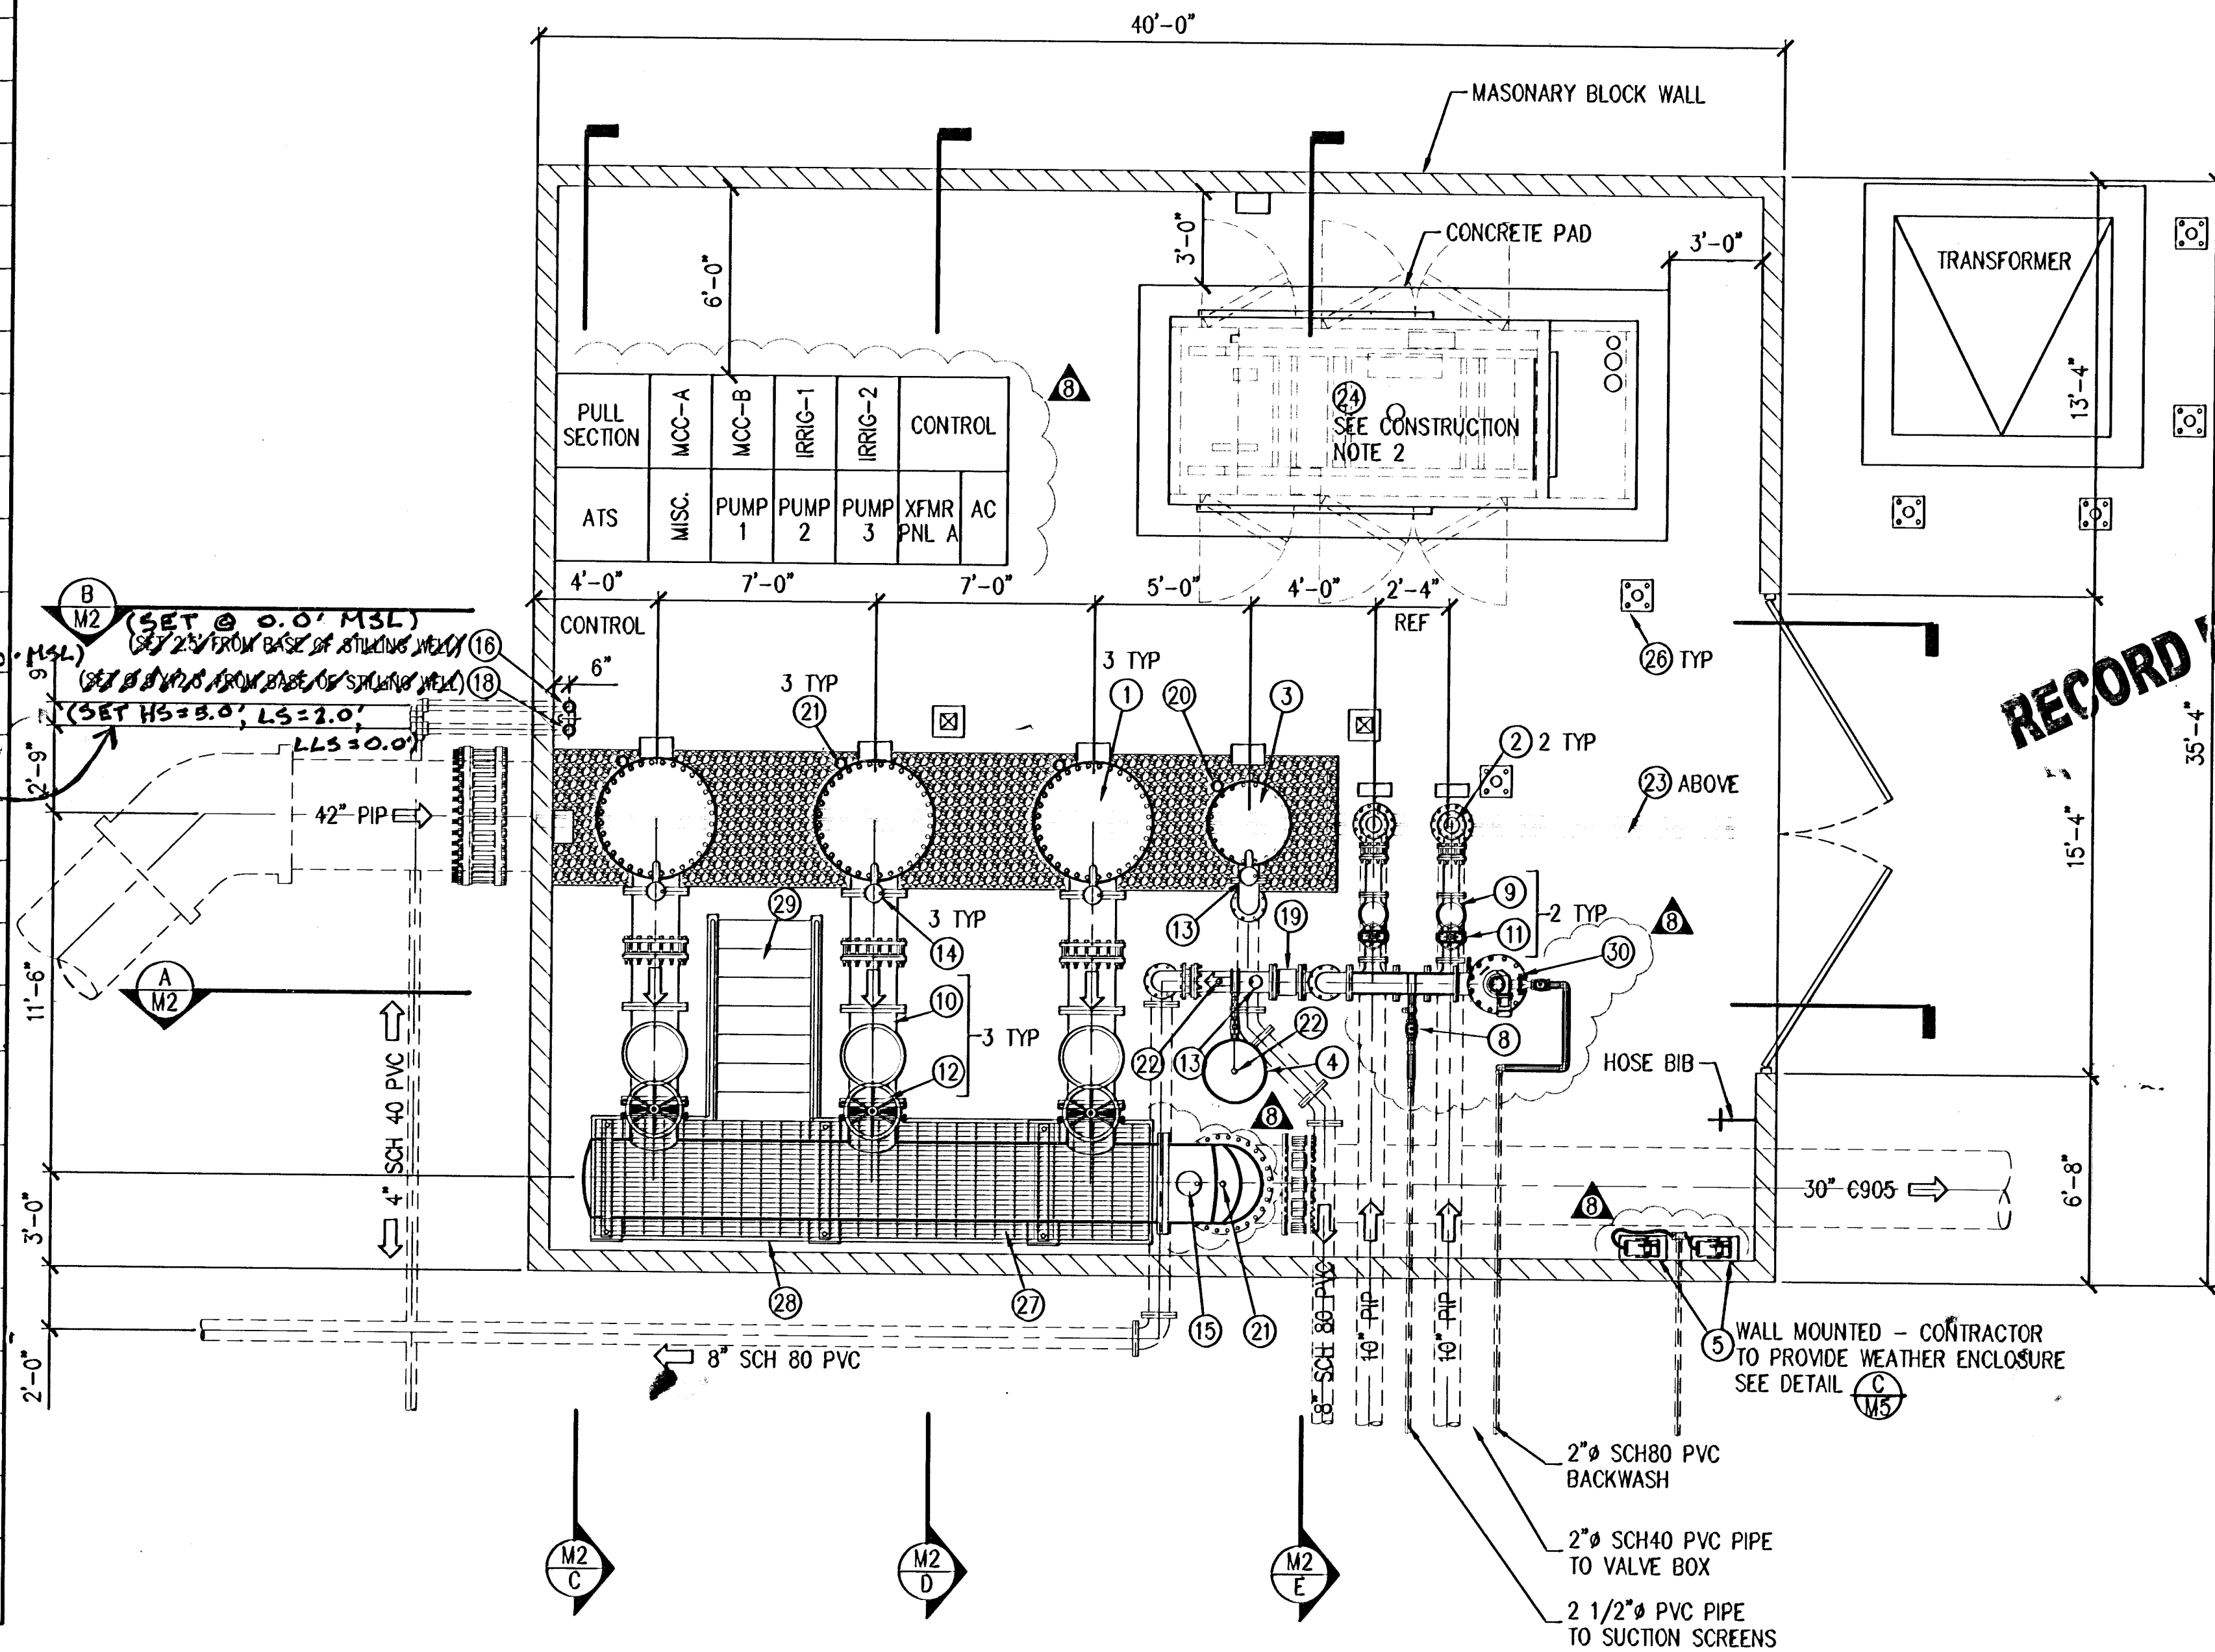

MECHANICAL PLAN - TANK & BASIN  
1/4" = 1'-0"

CONSTRUCTION NOTES

- CONTRACTOR TO PROVIDE NECESSARY PIPE SUPPORTS, HARNESS, STRAPS, THRUST BLOCKS, ETC. AS REQUIRED TO SECURE PIPING AND EQUIPMENT PER SPECIFICATIONS.
- GENERATOR LOCATION AND DIMENSIONS ARE BASED UPON KOHLER GENERATOR SPECIFICATIONS. IF A DIFFERENT GENERATOR MANUFACTURER IS SELECTED, THE CONTRACTOR SHALL REVISE THE BUILDING ACCORDINGLY.
- CONTRACTOR SHALL CONSULT GEOTECHNICAL REPORT PRIOR TO ALL CONSTRUCTION.
- CONTRACTOR TO COORDINATE WITH PUMP MANUFACTURER FOR BASE MOUNTING DETAILS AND ELECTRICAL CABLE RETAINING MECHANISM.

4/8/05	PER CITY COMMENTS -		
4/27/05	PER CITY COMMENTS -		
5/05/05	PER CITY COMMENTS -		
5/19/05	PER CITY COMMENTS -		
7/8/05	IRRIGATION FILTER		
9/21/05	WETLAND PLANTER		
9/26/05	HYDROSTATIC RELIEF		
12/22/05	RECORD DRAWINGS		
NO	BY	DATE	REVISIONS

RECORD DRAWINGS

PREPARED BY: ANDREW J. KOMOR  
PROJECT ENGINEER  
R.C.E. NO. - # C 64928  
EXP. 6/30/07

SCALE: 1/4" = 1'

DESIGNED: J.A.M.  
RECORDED: A.V.C.  
DATE: APR 2005

CYPRESS GROVE  
WATER PUMP STATION  
MECHANICAL BELOW  
TANK PLAN

**PACIFIC**  
PACIFIC ADVANCED  
CIVIL ENGINEERING  
17520 NEWMOORE STREET, SUITE 200  
FOUNTAIN VALLEY, CA 92705  
PH (714) 481-7300 FAX (714) 481-7299


SHEET  
**M1**  
JOB NO. 8138-E

Xref: 0138-10-Tank.dwg; 0138-MECH.dwg; 0138-ARCH.dwg; 0138-STRUCT.dwg  
Dwgcode = 48; LTitle = 1; PTitle = 1; Acad Ver. = 16.0; (LMS Tech); Version = 1


P: 0138 (Engineering) Submittal (Record Drawings) (Sheets) 0138-10-SHEET-M01.dwg - Title: LAYOUT By: gajilano on Jan. 04, 2006 at 05:14 PM




Xrefs: 8138-10-Tbl.dwg, 8138-SECTIONS.dwg  
 Date: 4/27/05  
 L1Scale = 0.5; P1Scale = 1; Acad Ver. = 16.0; (LMS Tech); Maxtext = 1

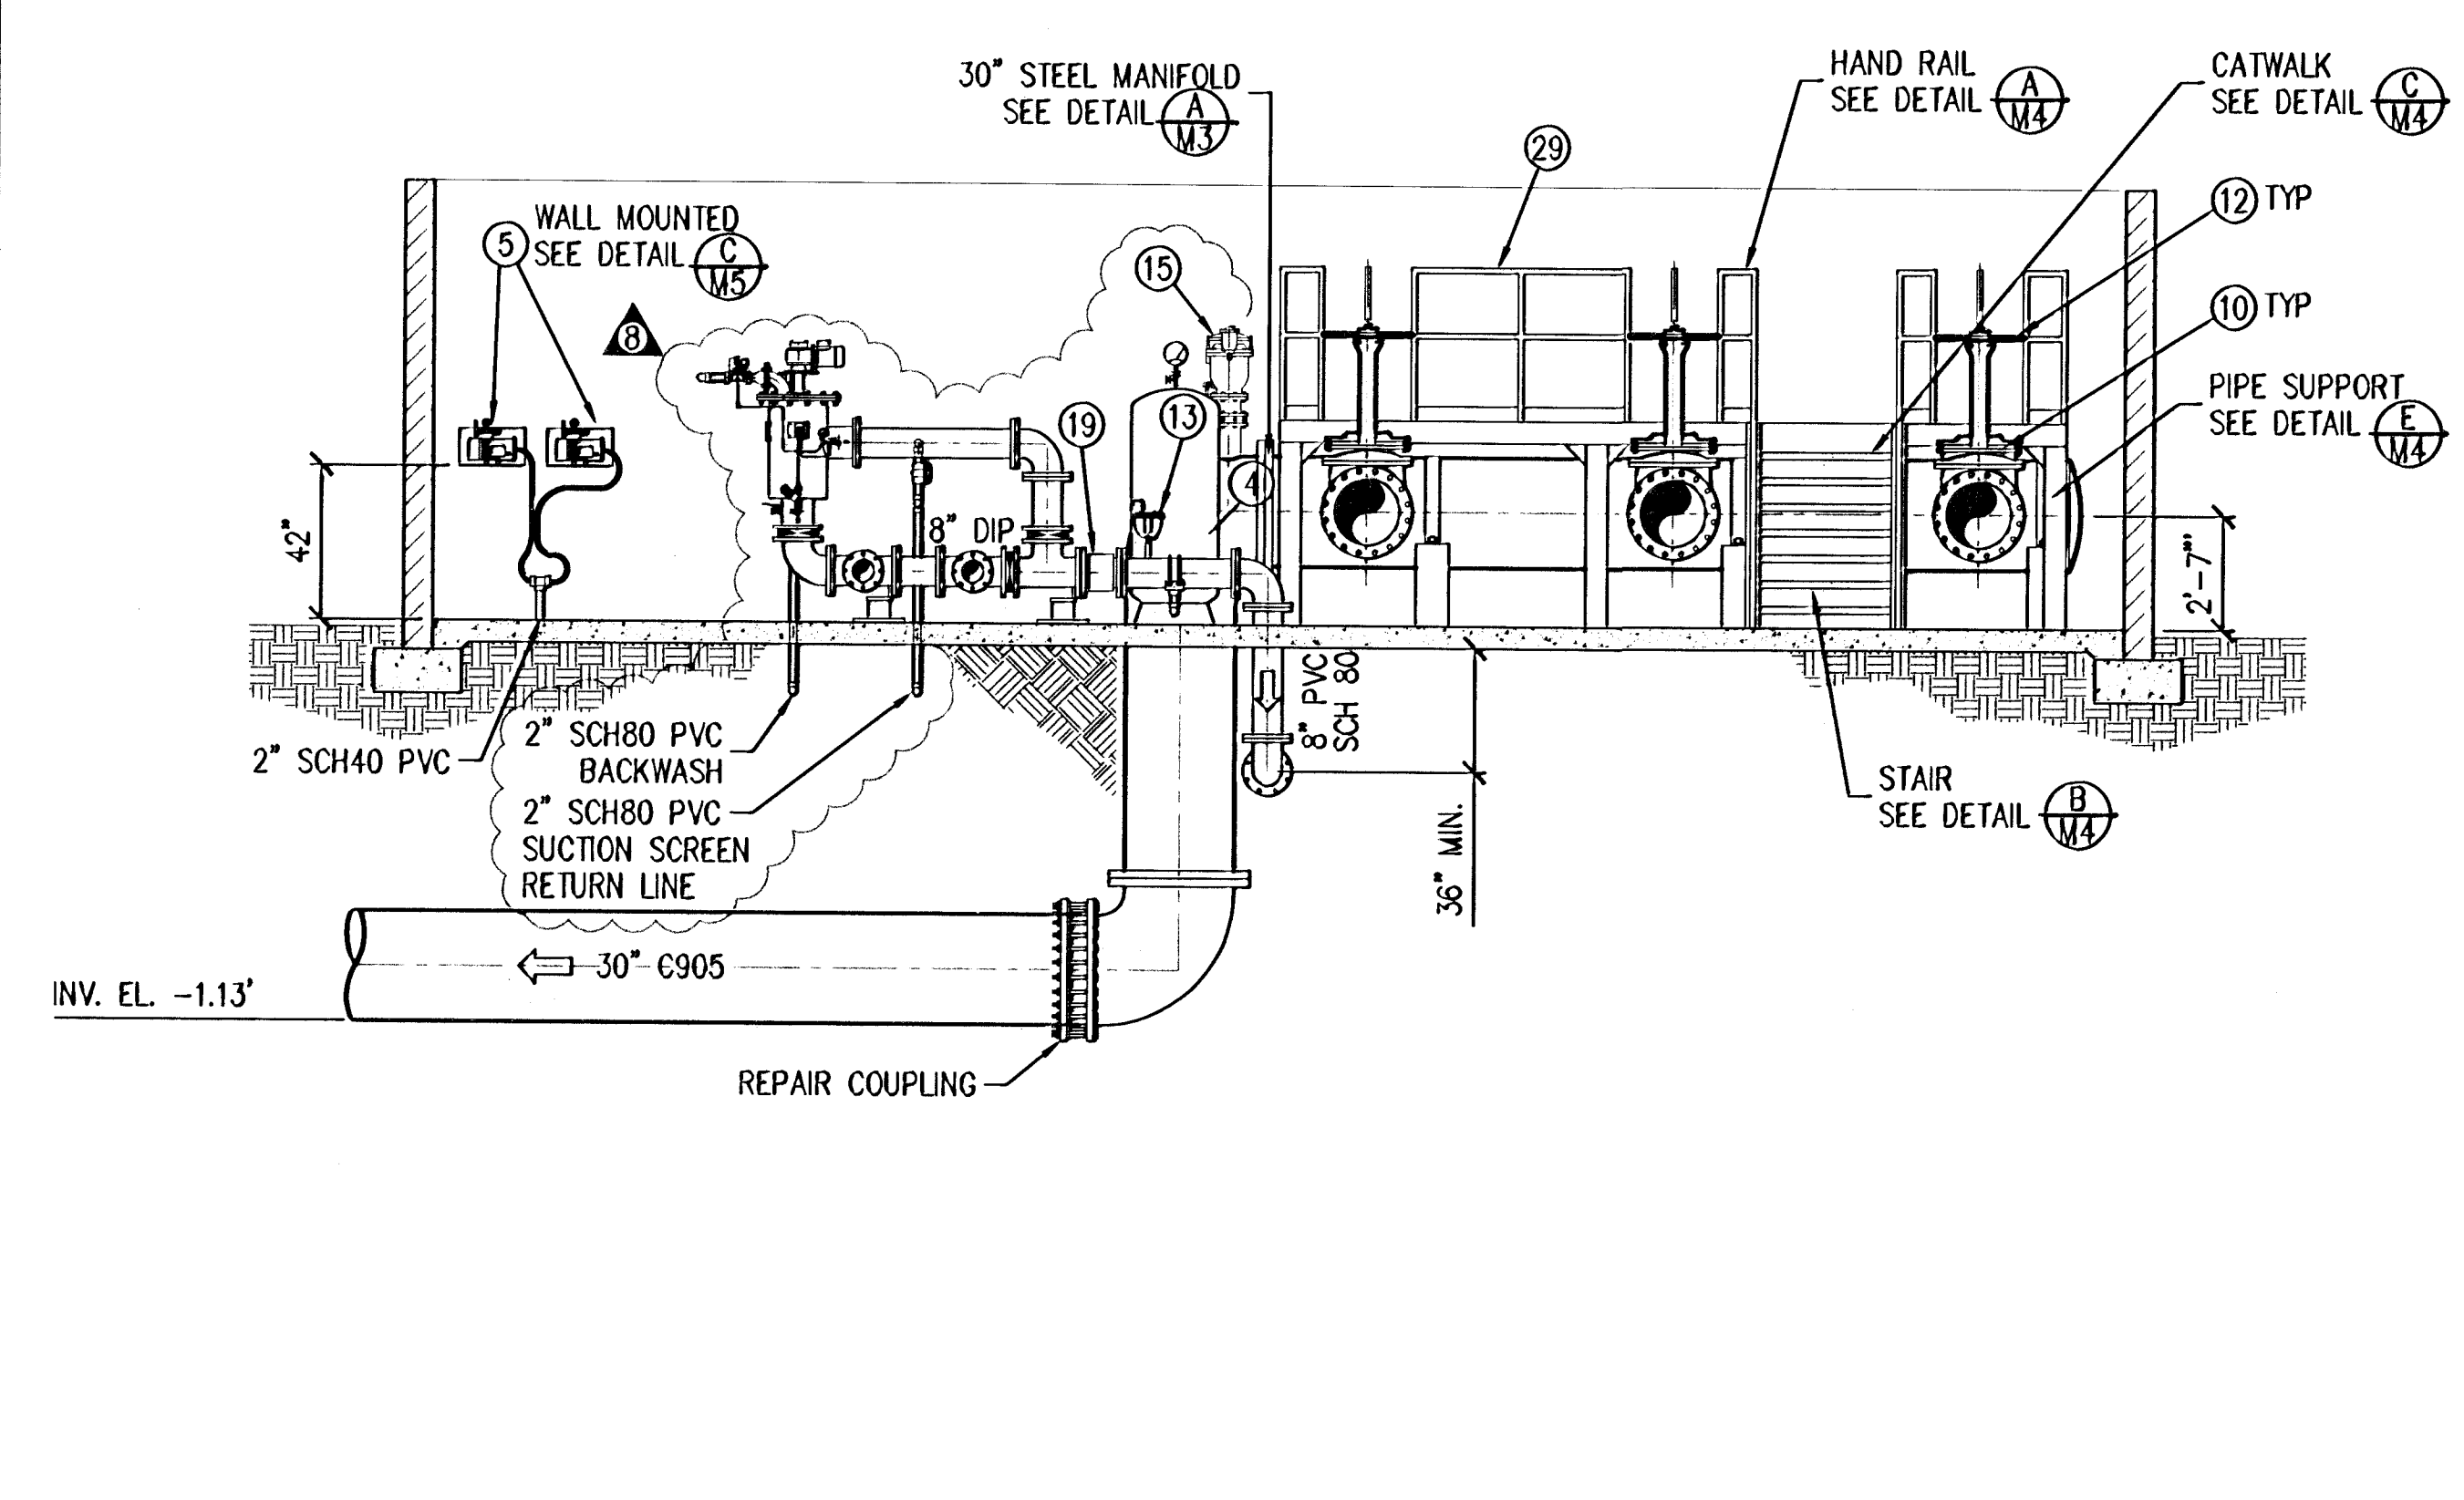


**SECTION A**  
1/4" = 1'-0"

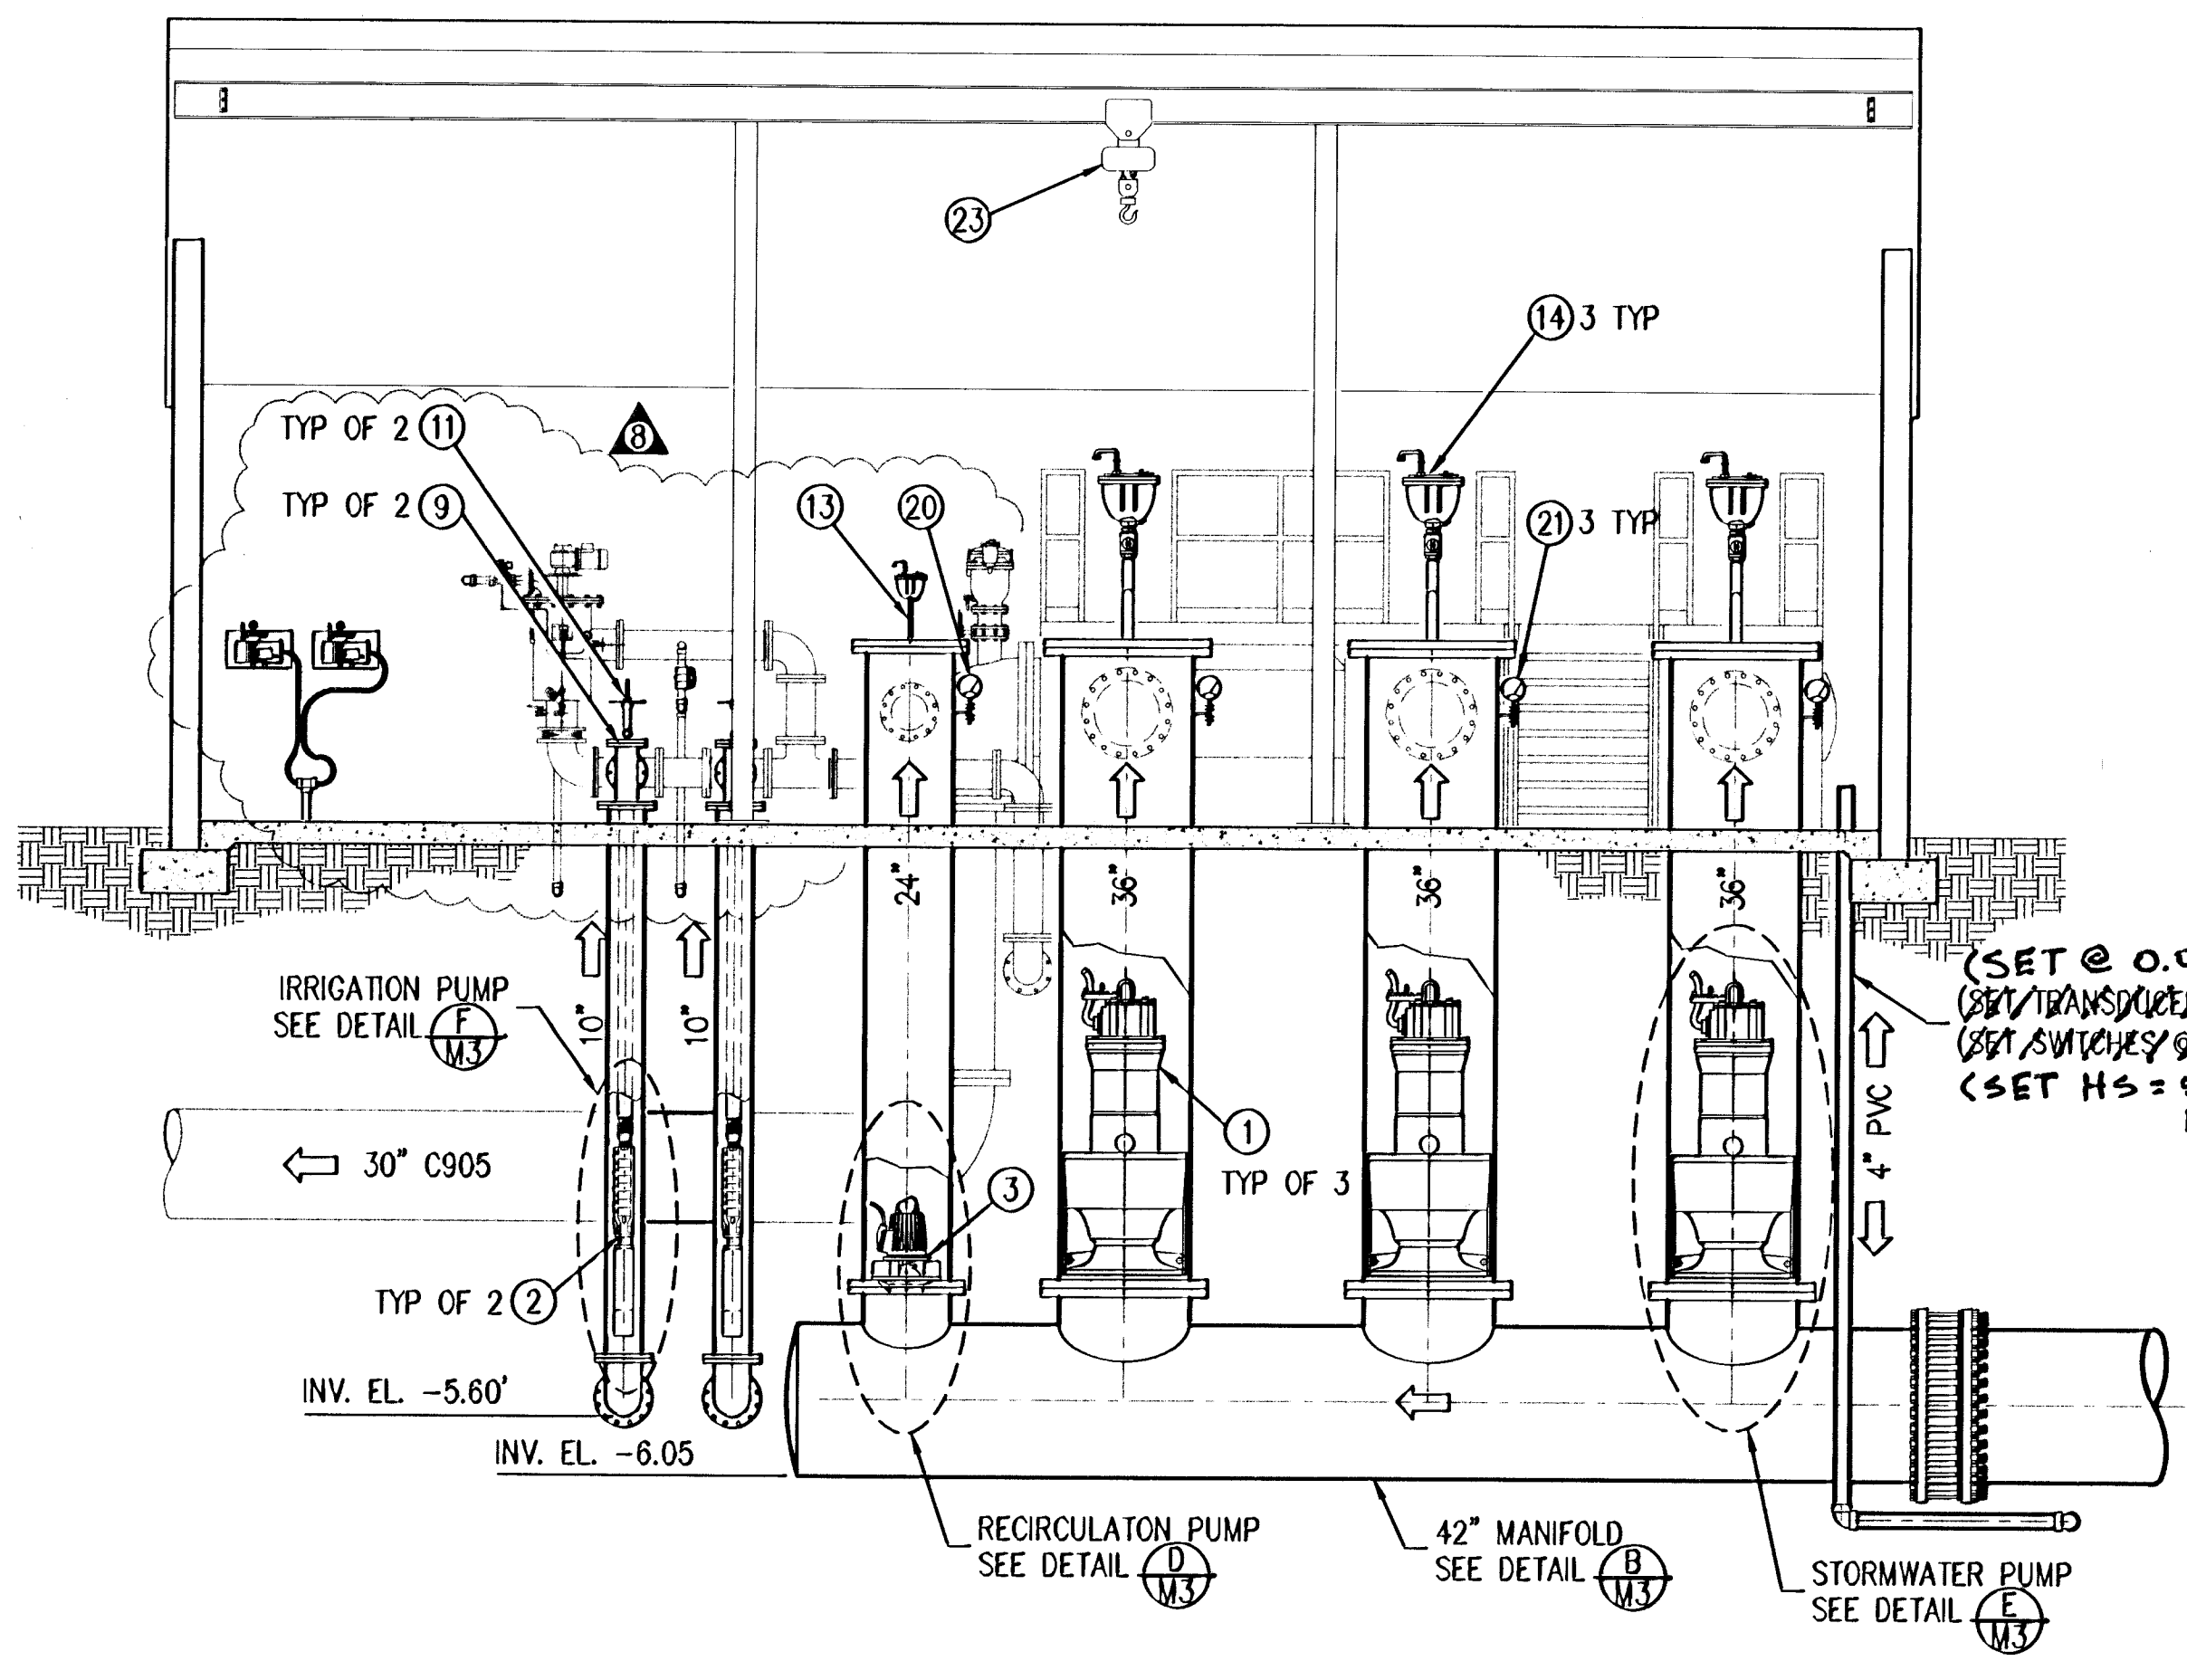


**SECTION B**  
1/4" = 1'-0"

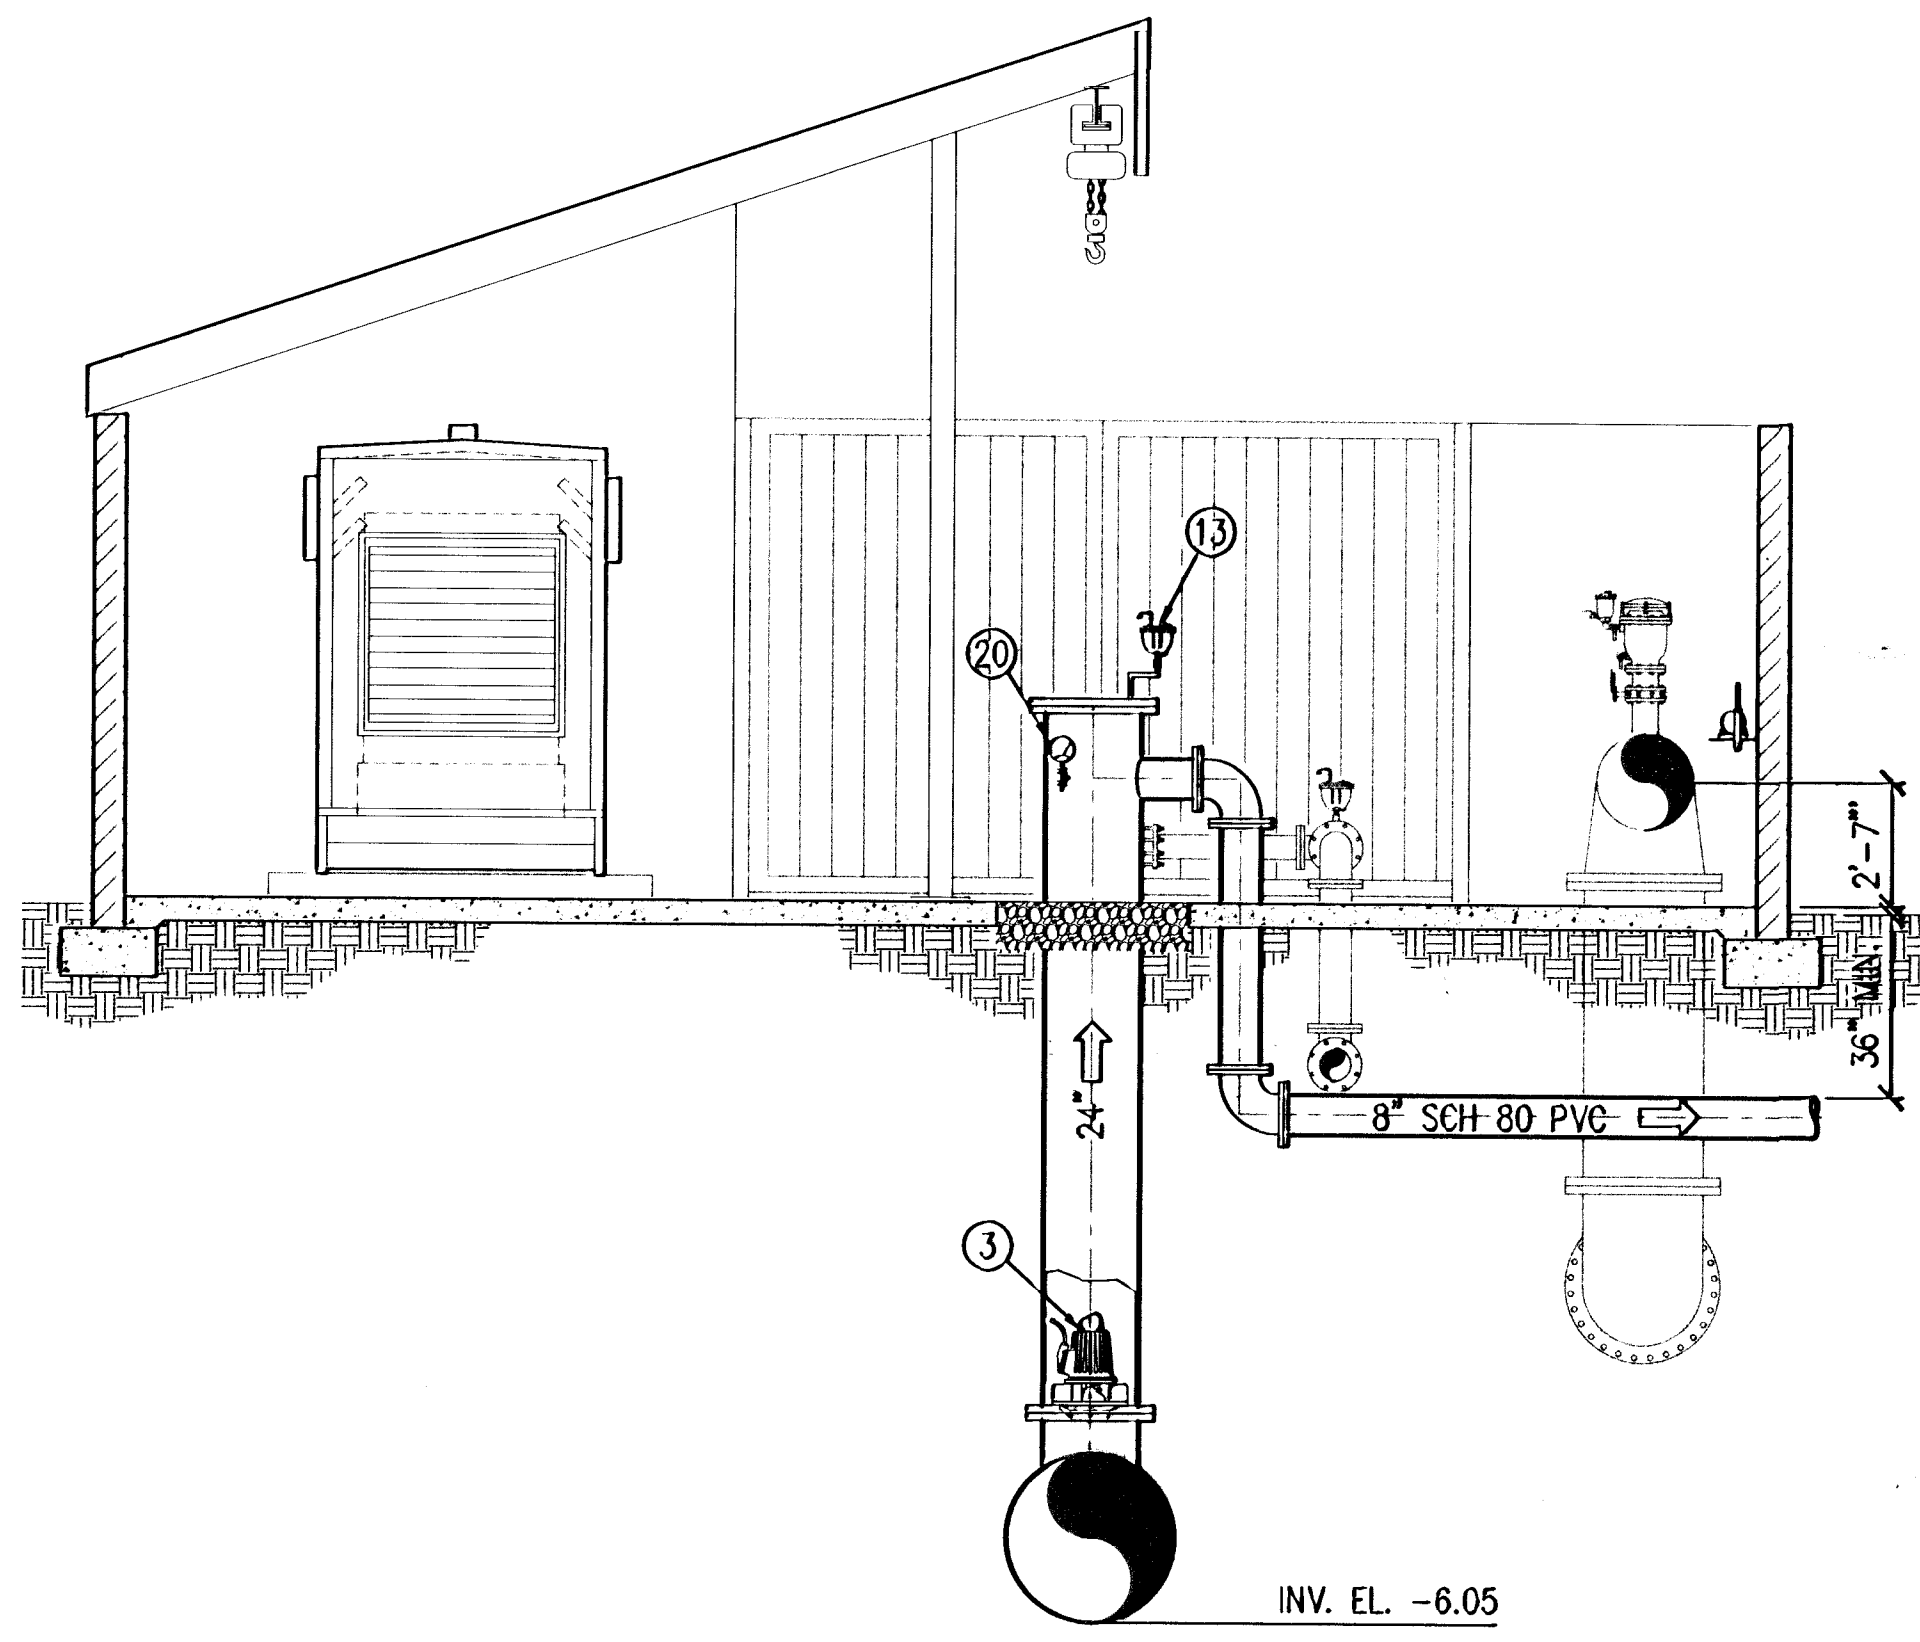

**SECTION C**  
1/4" = 1'-0"

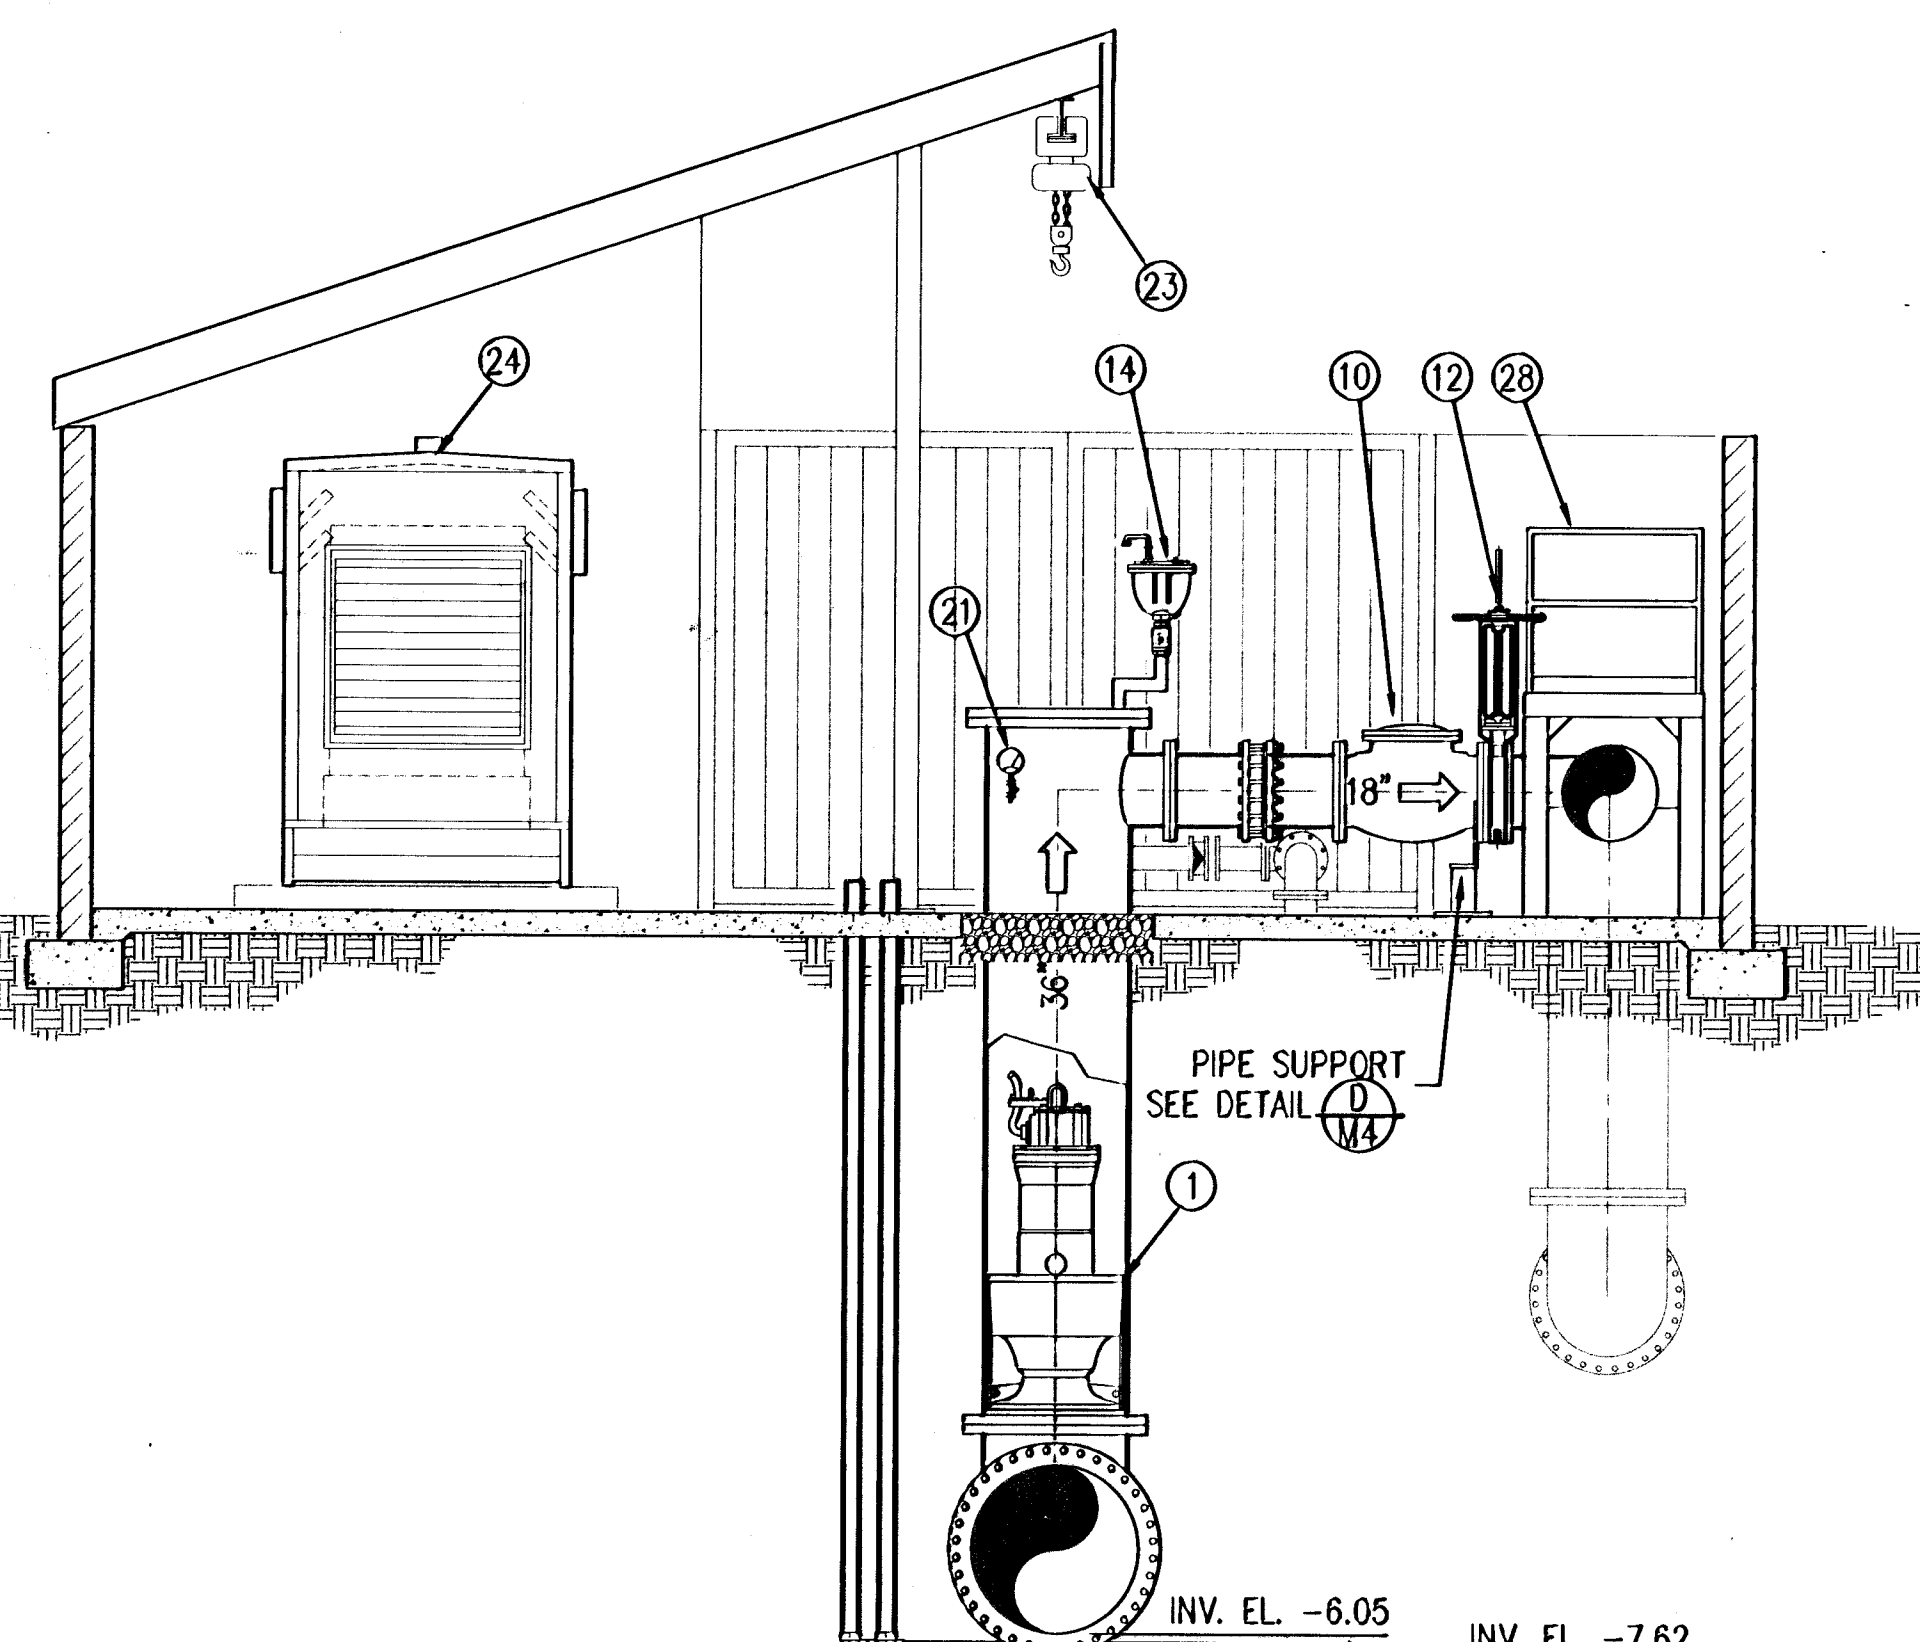

**SECTION D**  
1/4" = 1'-0"

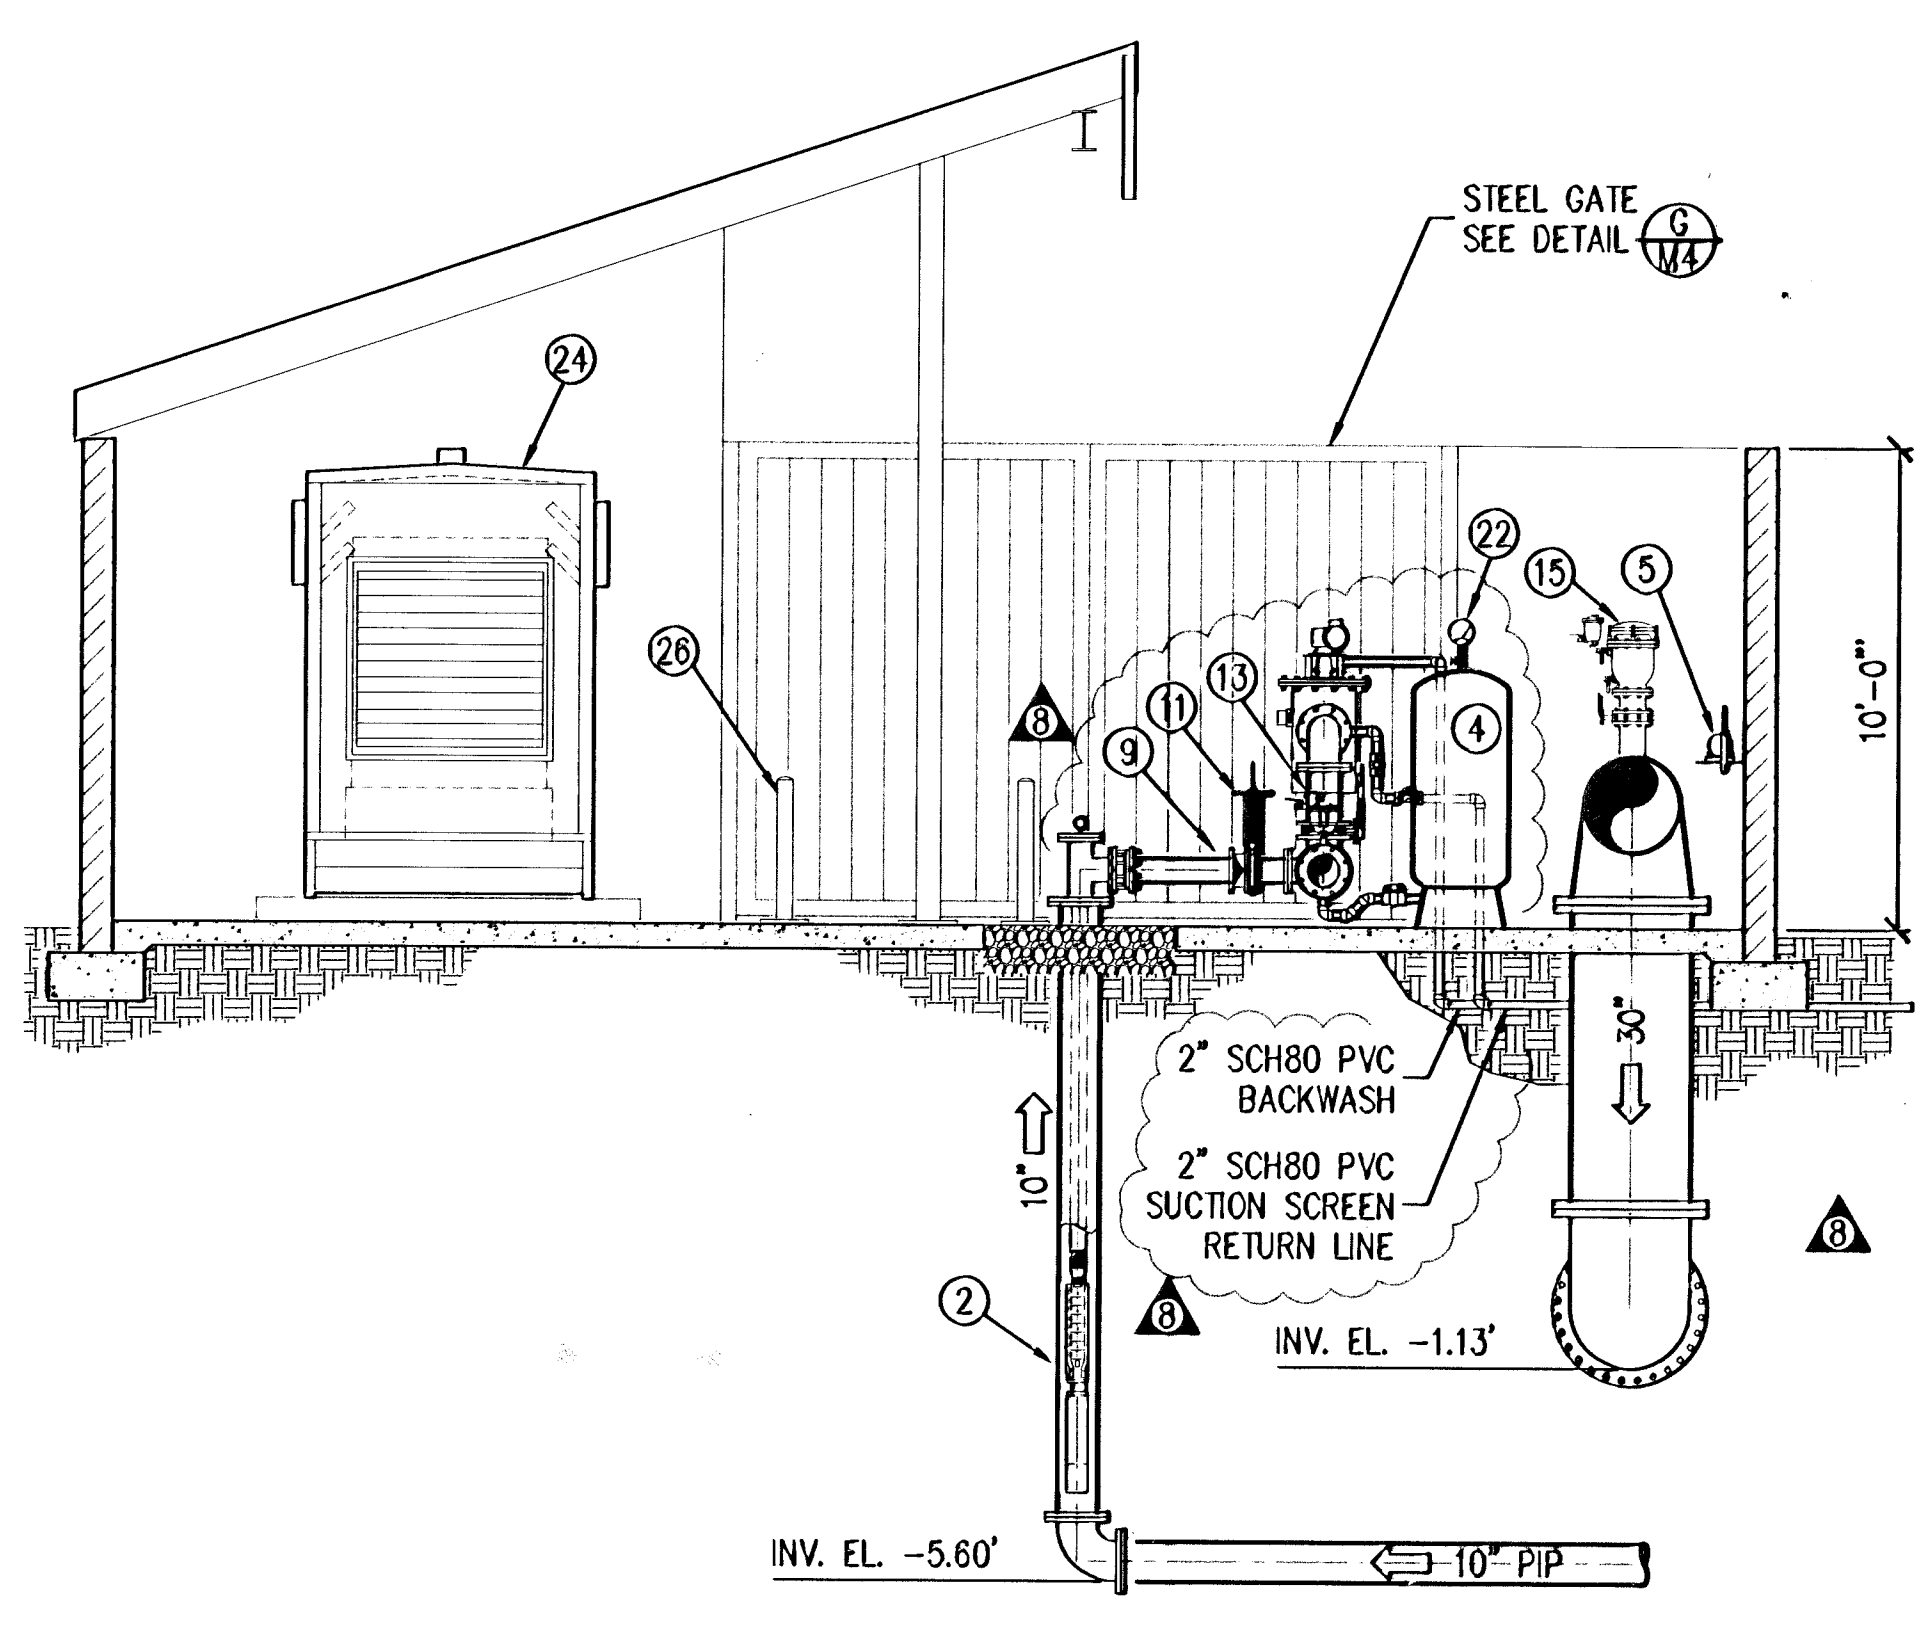

**SECTION E**  
1/4" = 1'-0"

**RECORD DRAWINGS**

NO.	BY	DATE	REVISIONS
1	JP	4/8/05	PER CITY COMMENTS - PRIOR TO APPROVAL
2	JP	4/27/05	PER CITY COMMENTS - PER CITY APPROVAL
3	DC	5/05/05	PER CITY COMMENTS - PRIOR TO APPROVAL
4	DC	5/19/05	PER CITY COMMENTS - PRIOR TO APPROVAL
5	BR	7/8/05	IRRIGATION FILTER
6	BR	9/27/05	METLAND PLANTER
7	BR	9/28/05	HYDROSTATIC RELIEF
8	DC	12/22/05	RECORD DRAWINGS

PREPARED BY: ANDREW T. KOMOR  
 PROJECT ENGINEER  
 R.C.E. NO. --- # C 64928  
 EXP. 6/30/07  
 DRAWN BY: J.J.M.  
 ASSIGNED: J.J.M.  
 CHECKED: A.K.  
 DATE: APR 2005


**GYPSUM GROVE**  
**WATER PUMP STATION**  
**MECHANICAL SECTIONS**

**PACIFIC ADVANCED CIVIL ENGINEERING**  
 17520 NEWHOPE STREET, SUITE 200  
 FOUNTAIN VALLEY, CA 92708  
 PH: (714) 461-7300 FAX: (714) 461-7299

SHEET  
**M2**  
 JOB NO. 8138-E


P:\0138\Engineering\Submittals\Record Drawings\8138-10-SHEET-M2.dwg - Tab: LAYOUT1 By: gilliland on Jan. 04, 2006 at 05:27 pm



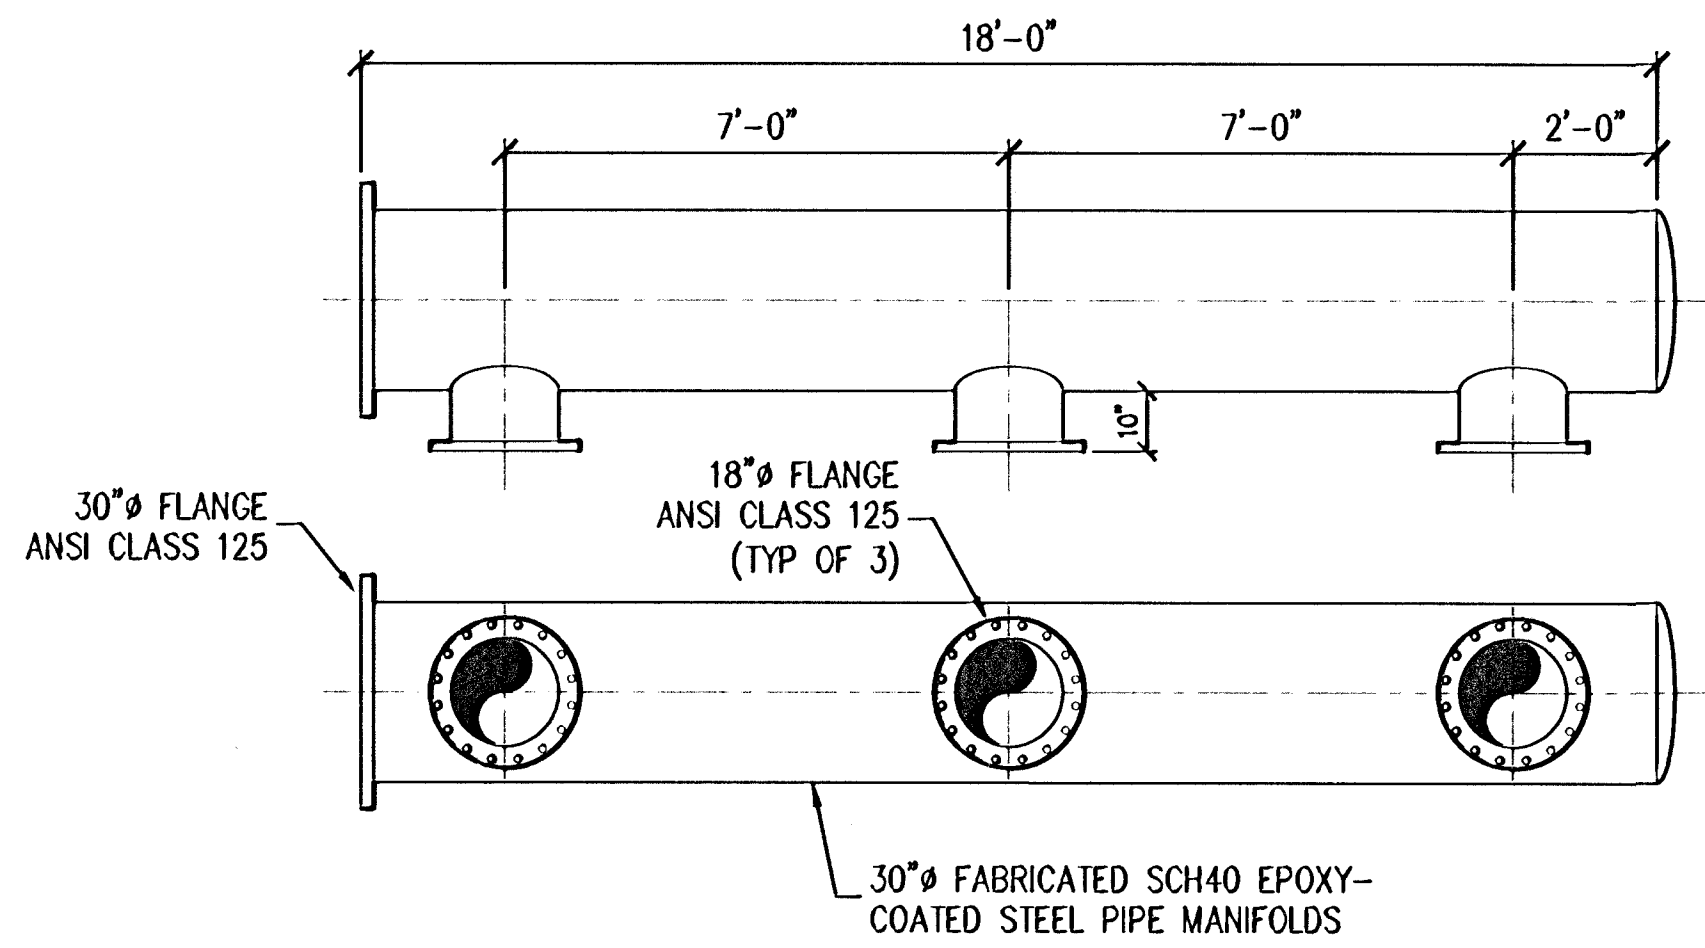


**30" STEEL MANIFOLD**

SCALE: 3/8"=1'-0" **A**

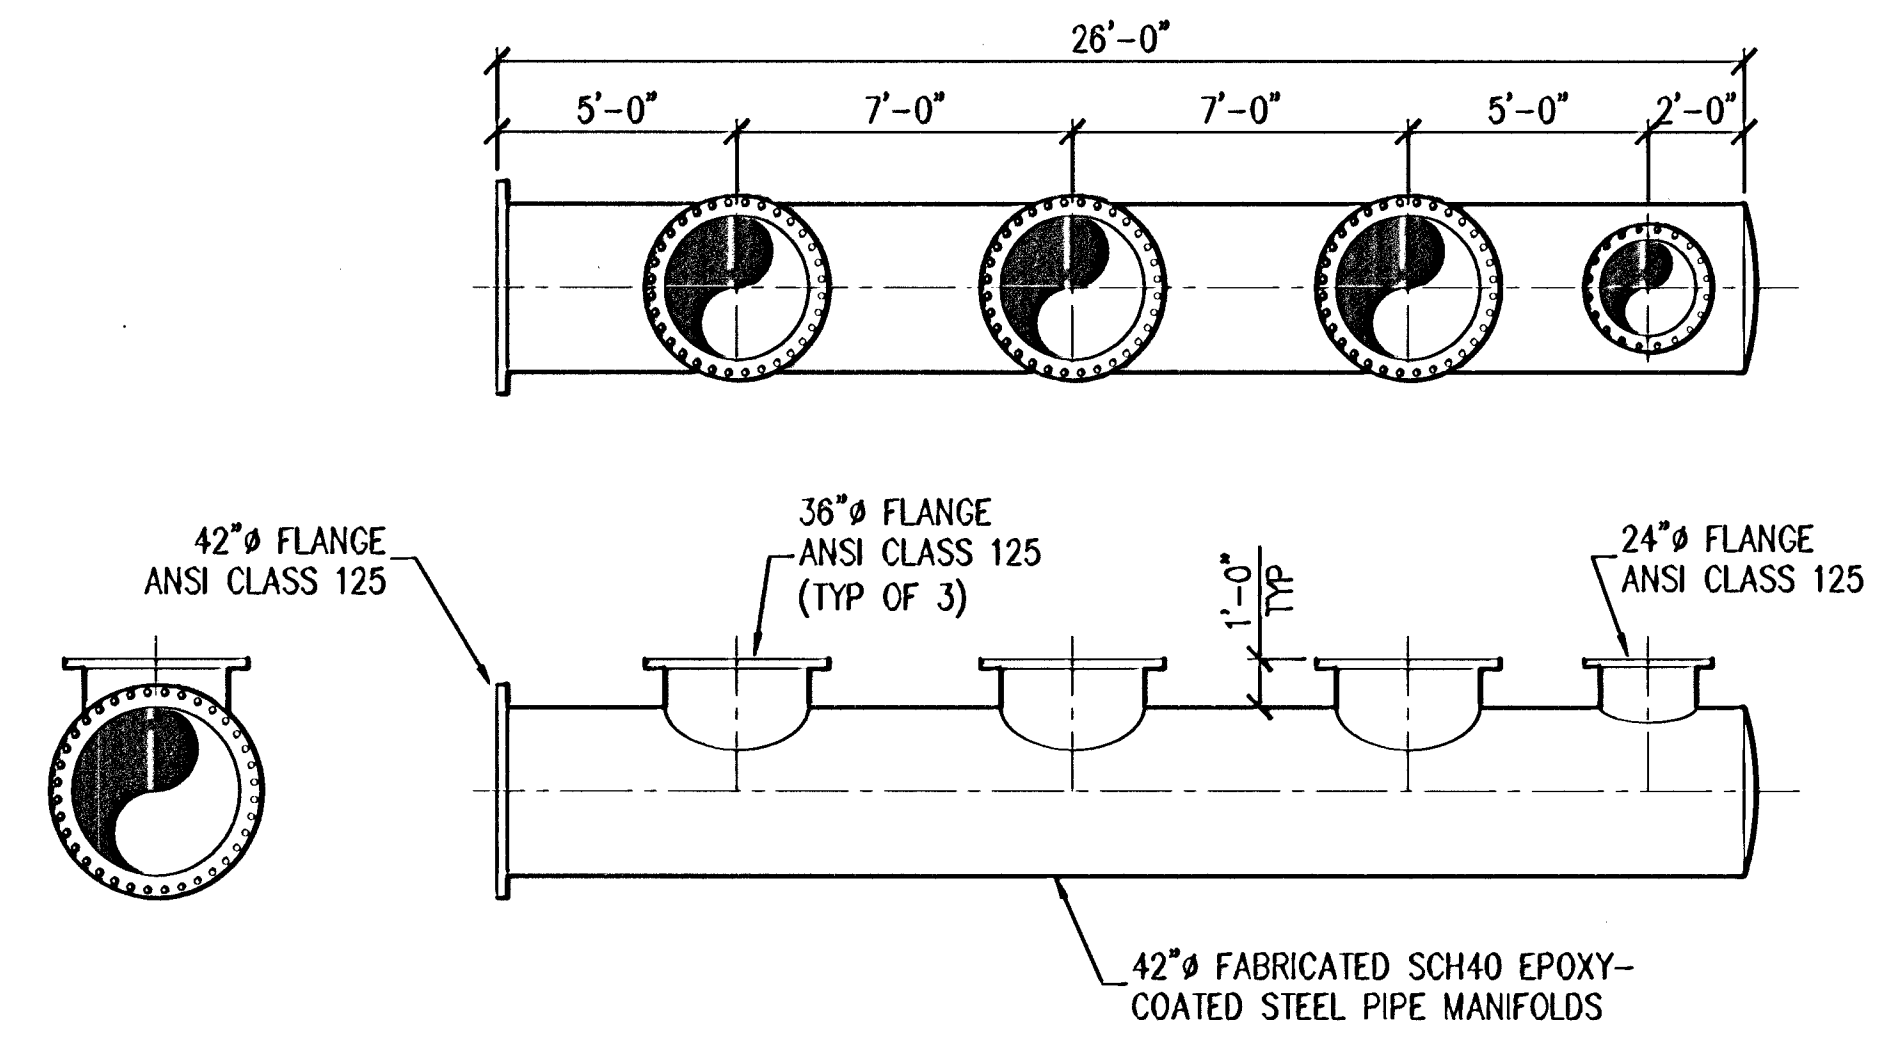

**42" STEEL MANIFOLD**

SCALE: 1/4"=1'-0" **B**

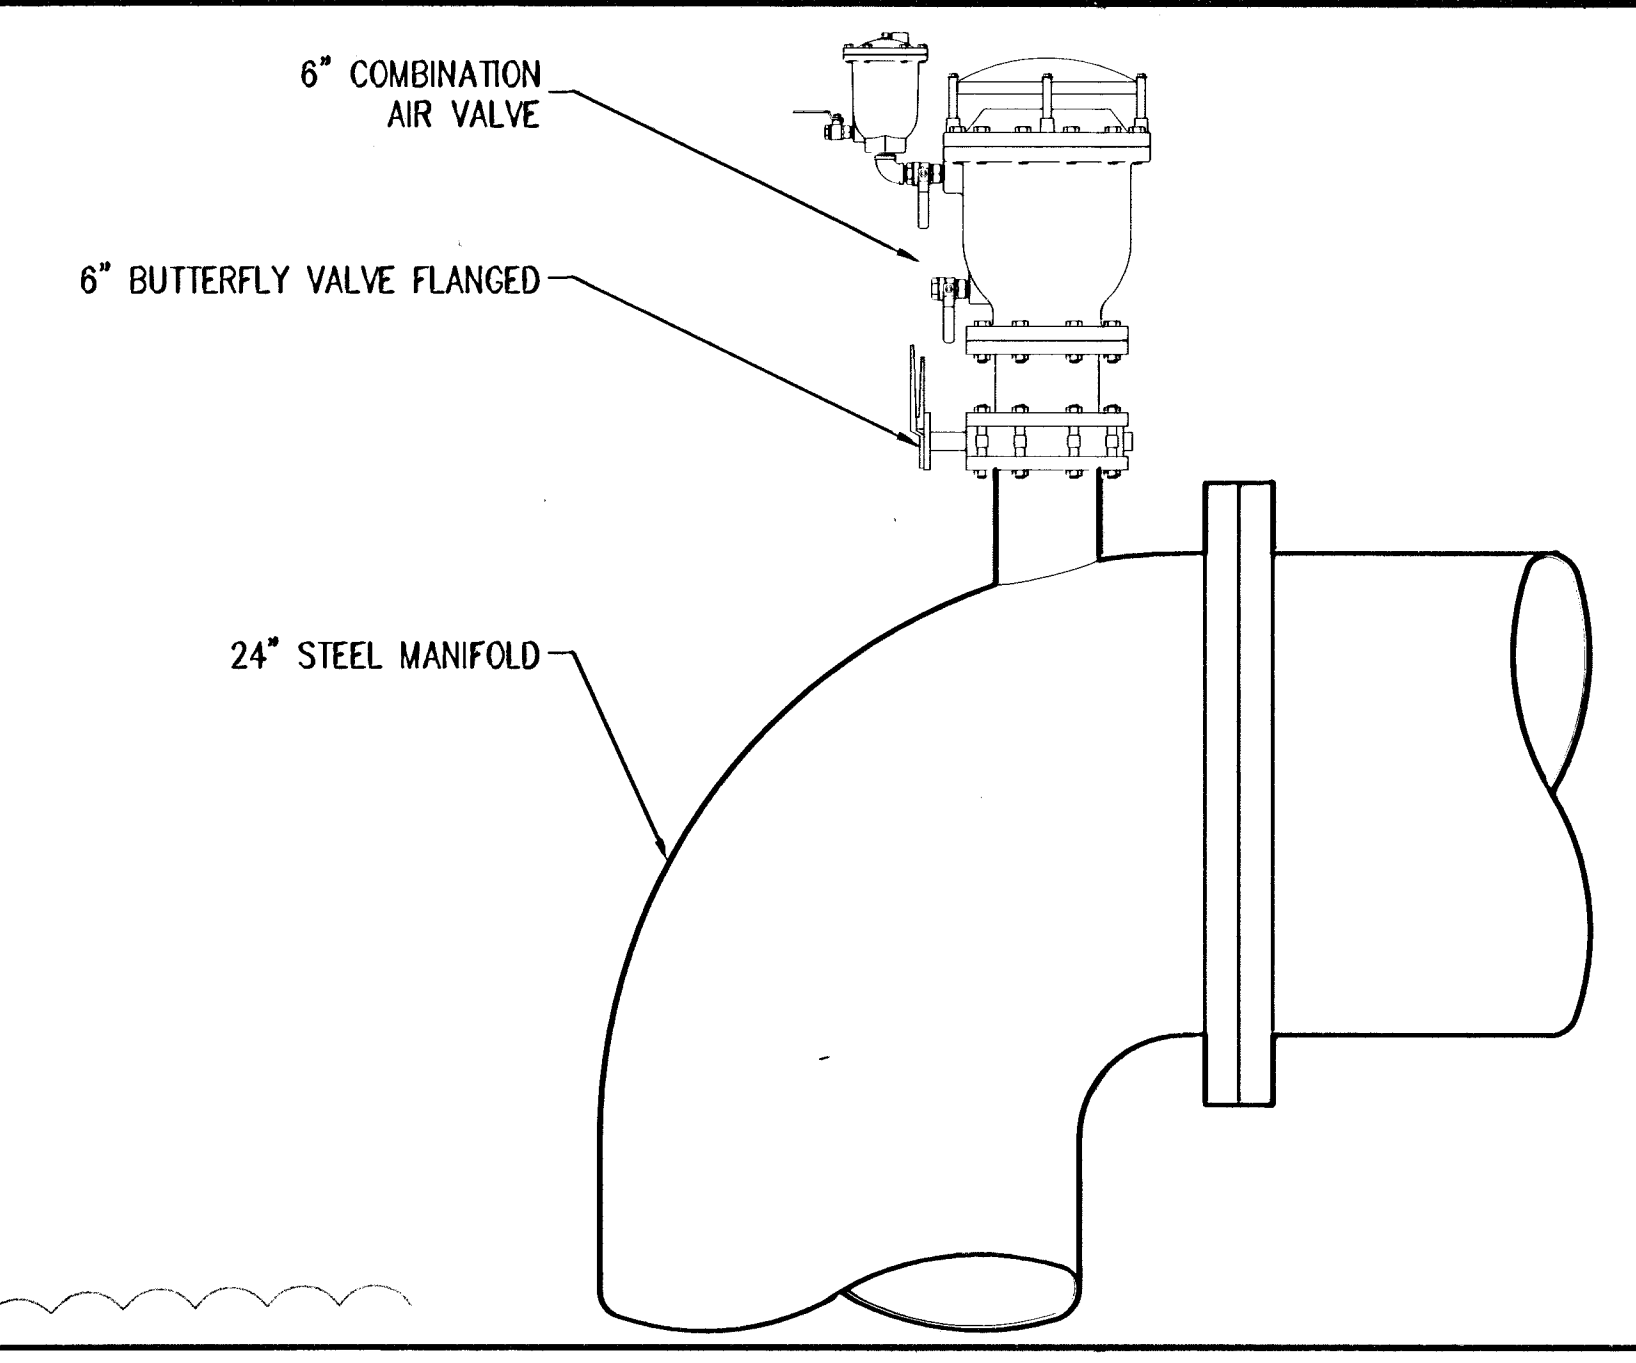

**COMBINATION AIR VALVE DETAIL**

SCALE: 1"=1'-0" **C**

NO.	BY	DATE	REVISIONS	DATE	APP.
1	UP	4/8/05	PER CITY COMMENTS - PRIOR TO APPROVAL		
2	UP	4/27/05	PER CITY COMMENTS - PRIOR TO APPROVAL		
3	DC	5/8/05	PER CITY COMMENTS - PRIOR TO APPROVAL		
4	DC	5/19/05	PER CITY COMMENTS - PRIOR TO APPROVAL		
5	BR	7/6/05	IRRIGATION FILTER		
6	BR	9/21/05	METLAND PLANTER		
7	BR	9/26/05	HYDROSTATIC RELIEF		
8	DC	12/22/05	RECORD DRAWINGS		


**RECORD DRAWINGS**

PREPARED BY ANDREW T. KOMOR	PROJECT ENGINEER	R.C.E. NO. - # C 04528	SCALE 1/4" = 1'
CHECKED J.A.M.	DATE APR 2005		

**GYRESS GROVE WATER PUMP STATION MECHANICAL DETAILS**


**PACIFIC ADVANCED CIVIL ENGINEERING**  
17520 NEW ORE STREET, SUITE 200  
FOUNTAIN VALLEY, CA 92708  
PH (714) 481-7500 FAX (714) 481-7299

SHEET **M3**  
JOB NO. 8138-E

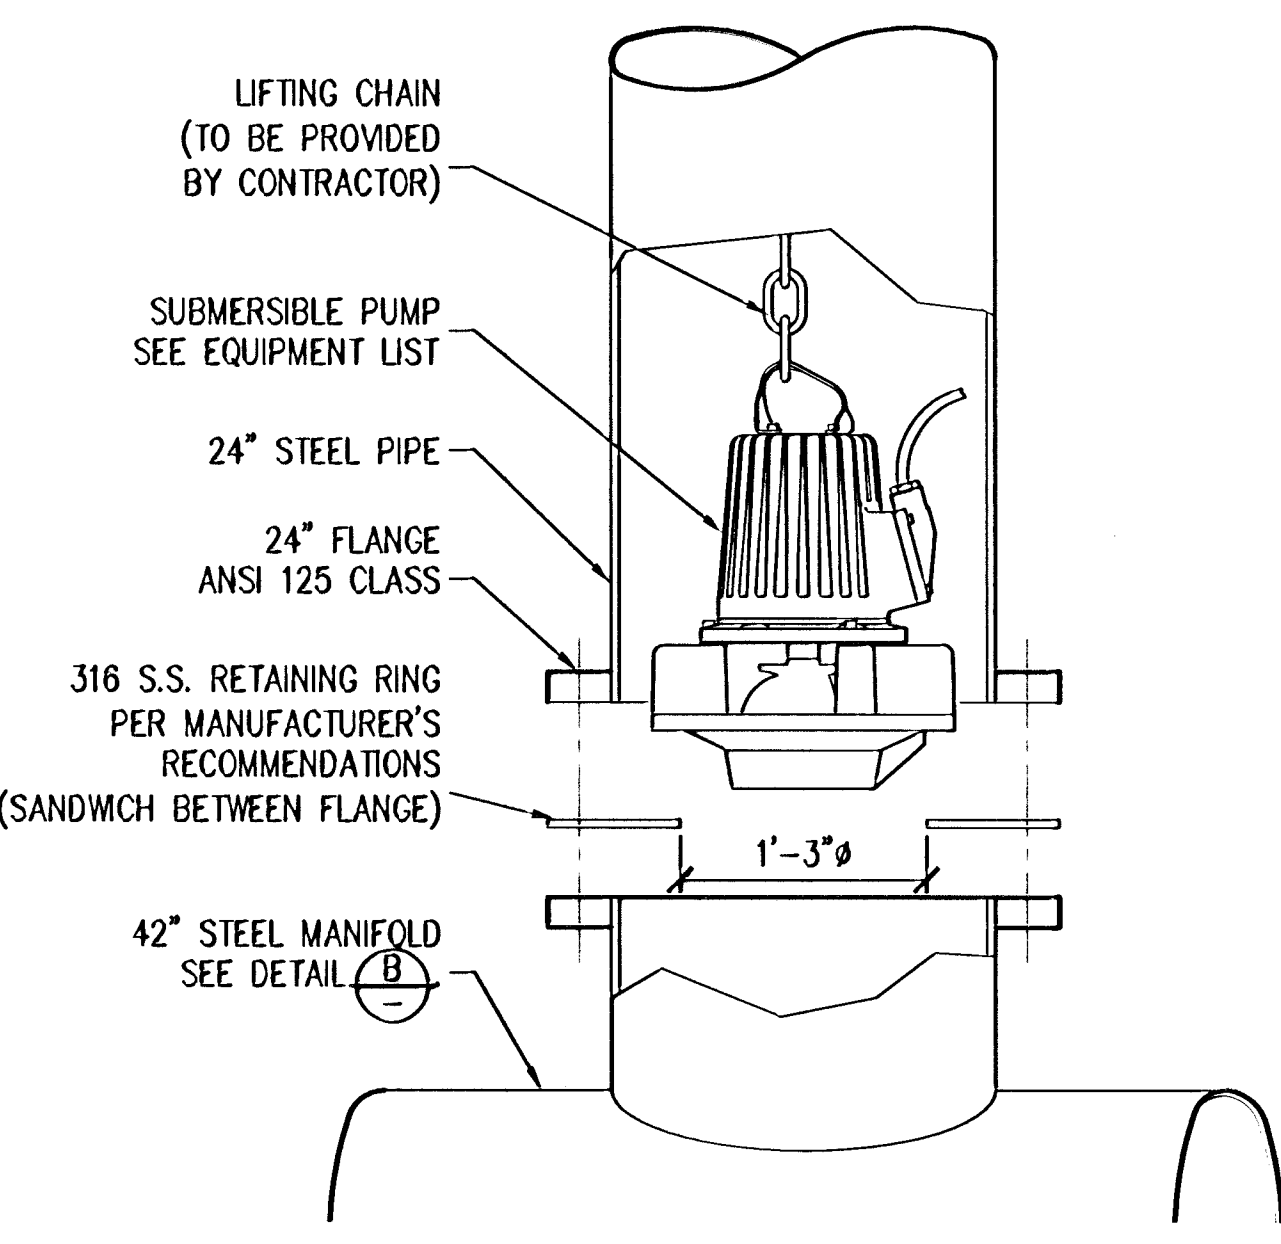


**RECIRCULATION PUMP DETAIL**

SCALE: 1"=1'-0" **D**

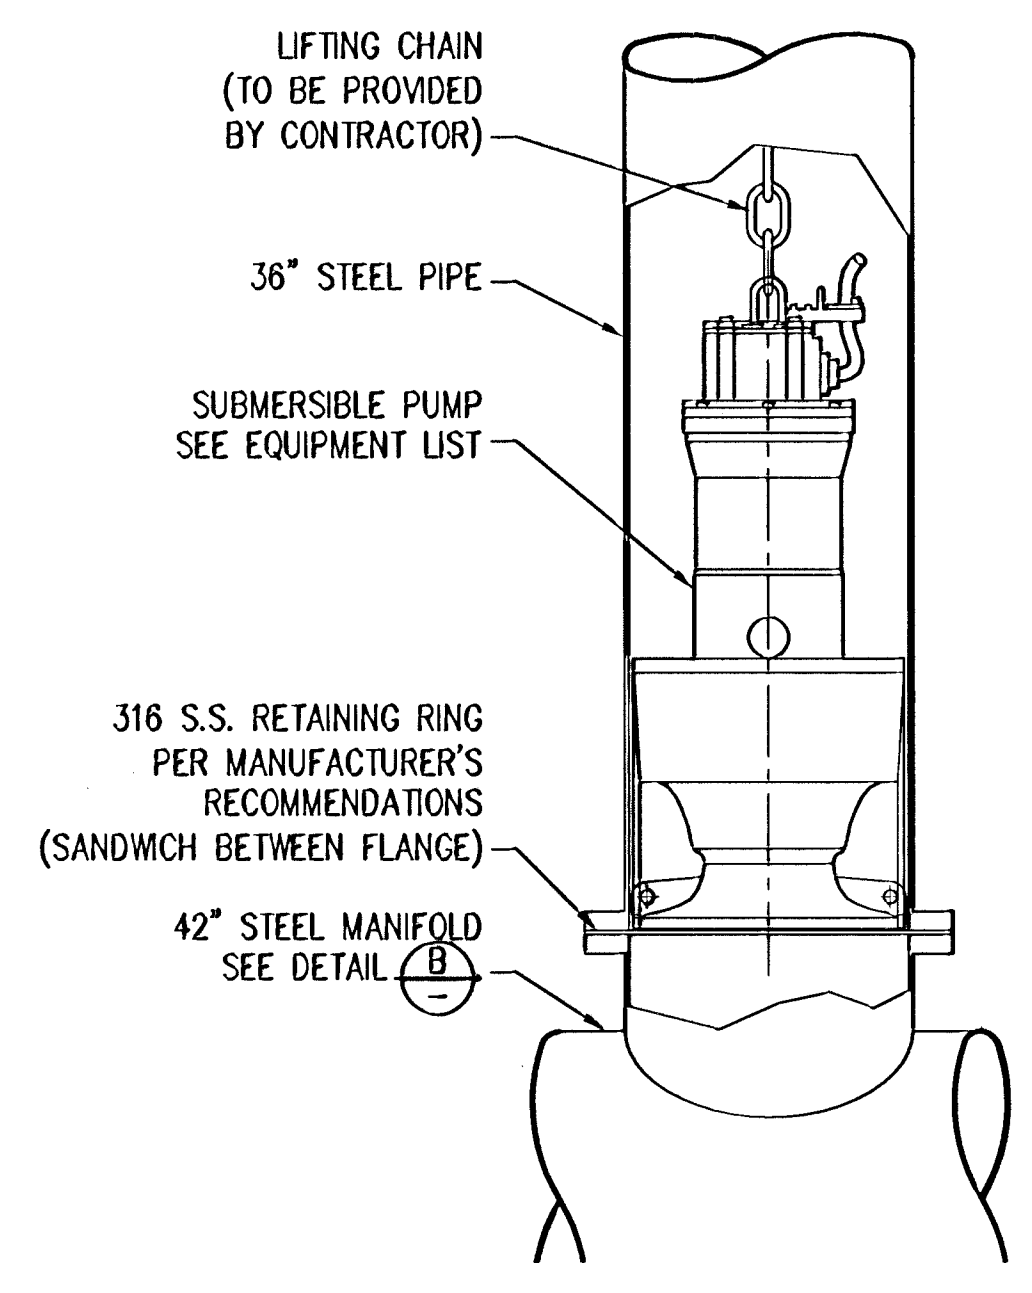


**STORMWATER PUMP DETAIL**

SCALE: 1/2"=1'-0" **E**

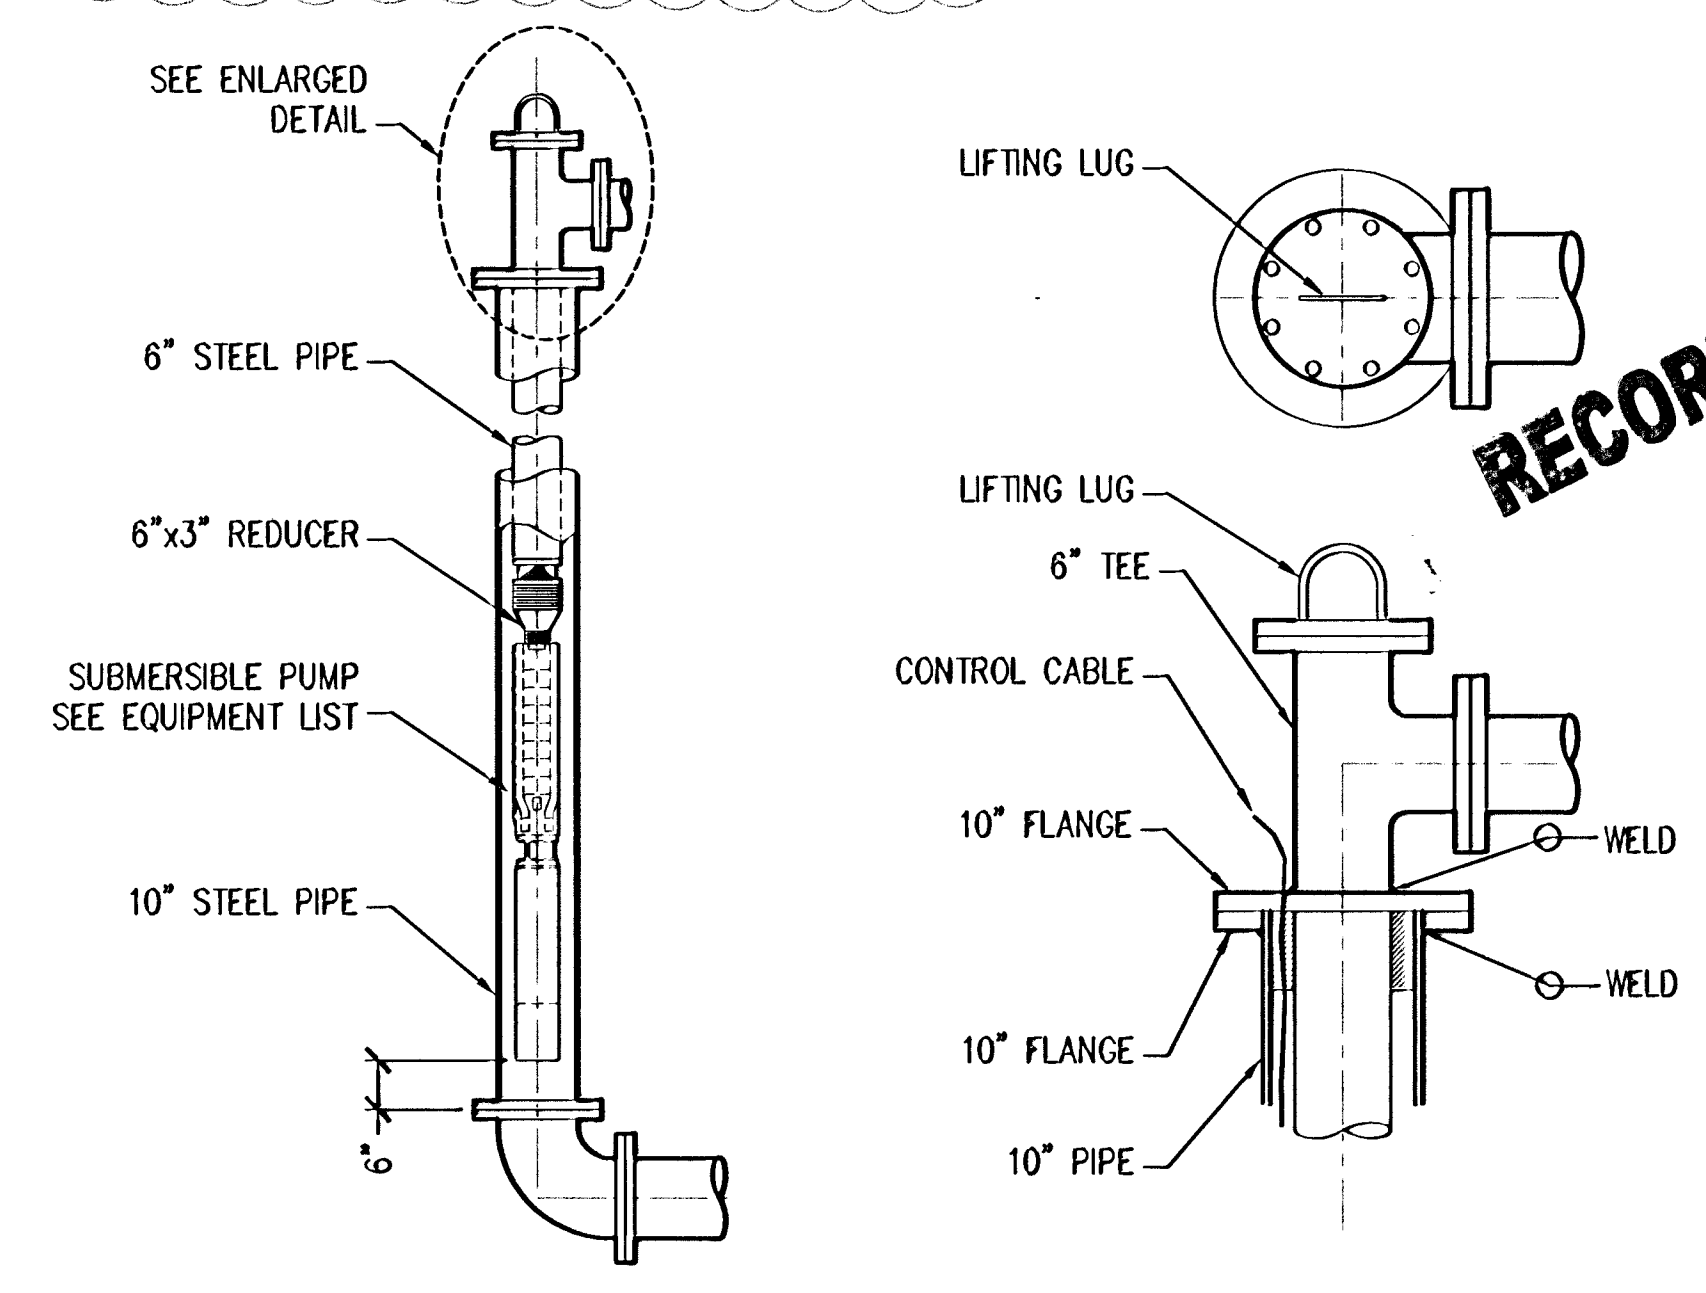


**IRRIGATION PUMP DETAIL**

SCALE: 1/2"=1'-0" **F**

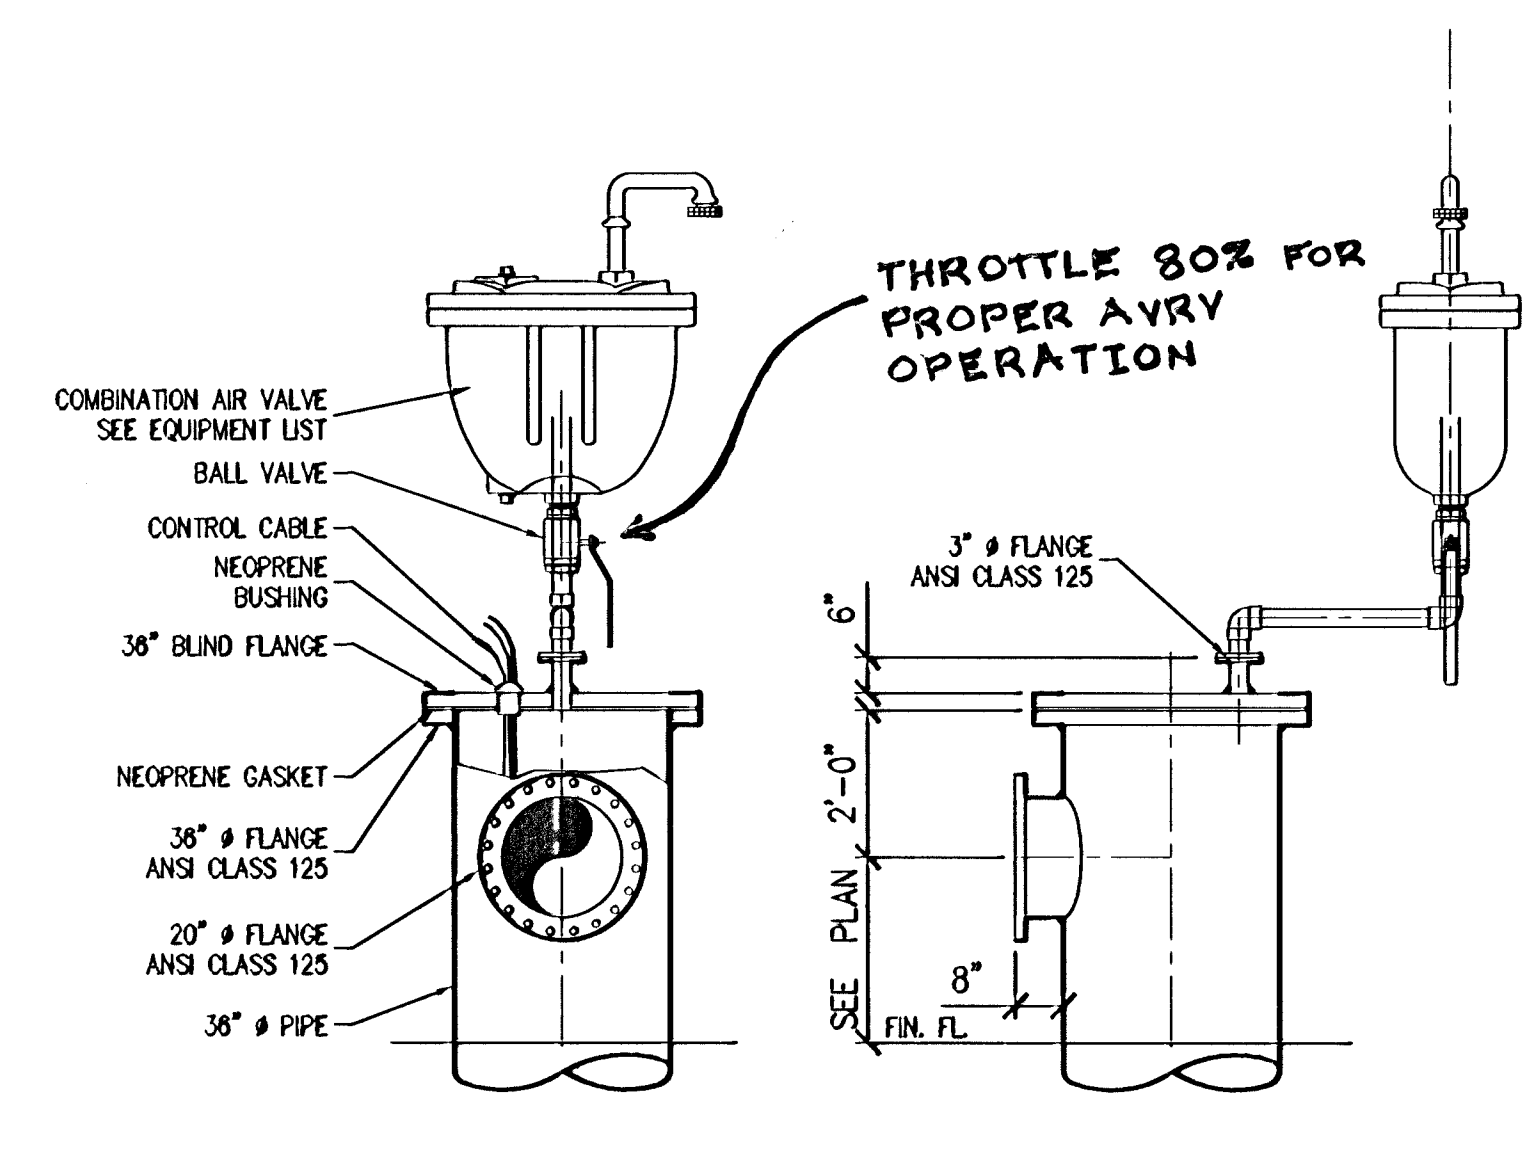


**TOP OF 36" CAN DETAIL**

SCALE: 3/8"=1'-0" **G**

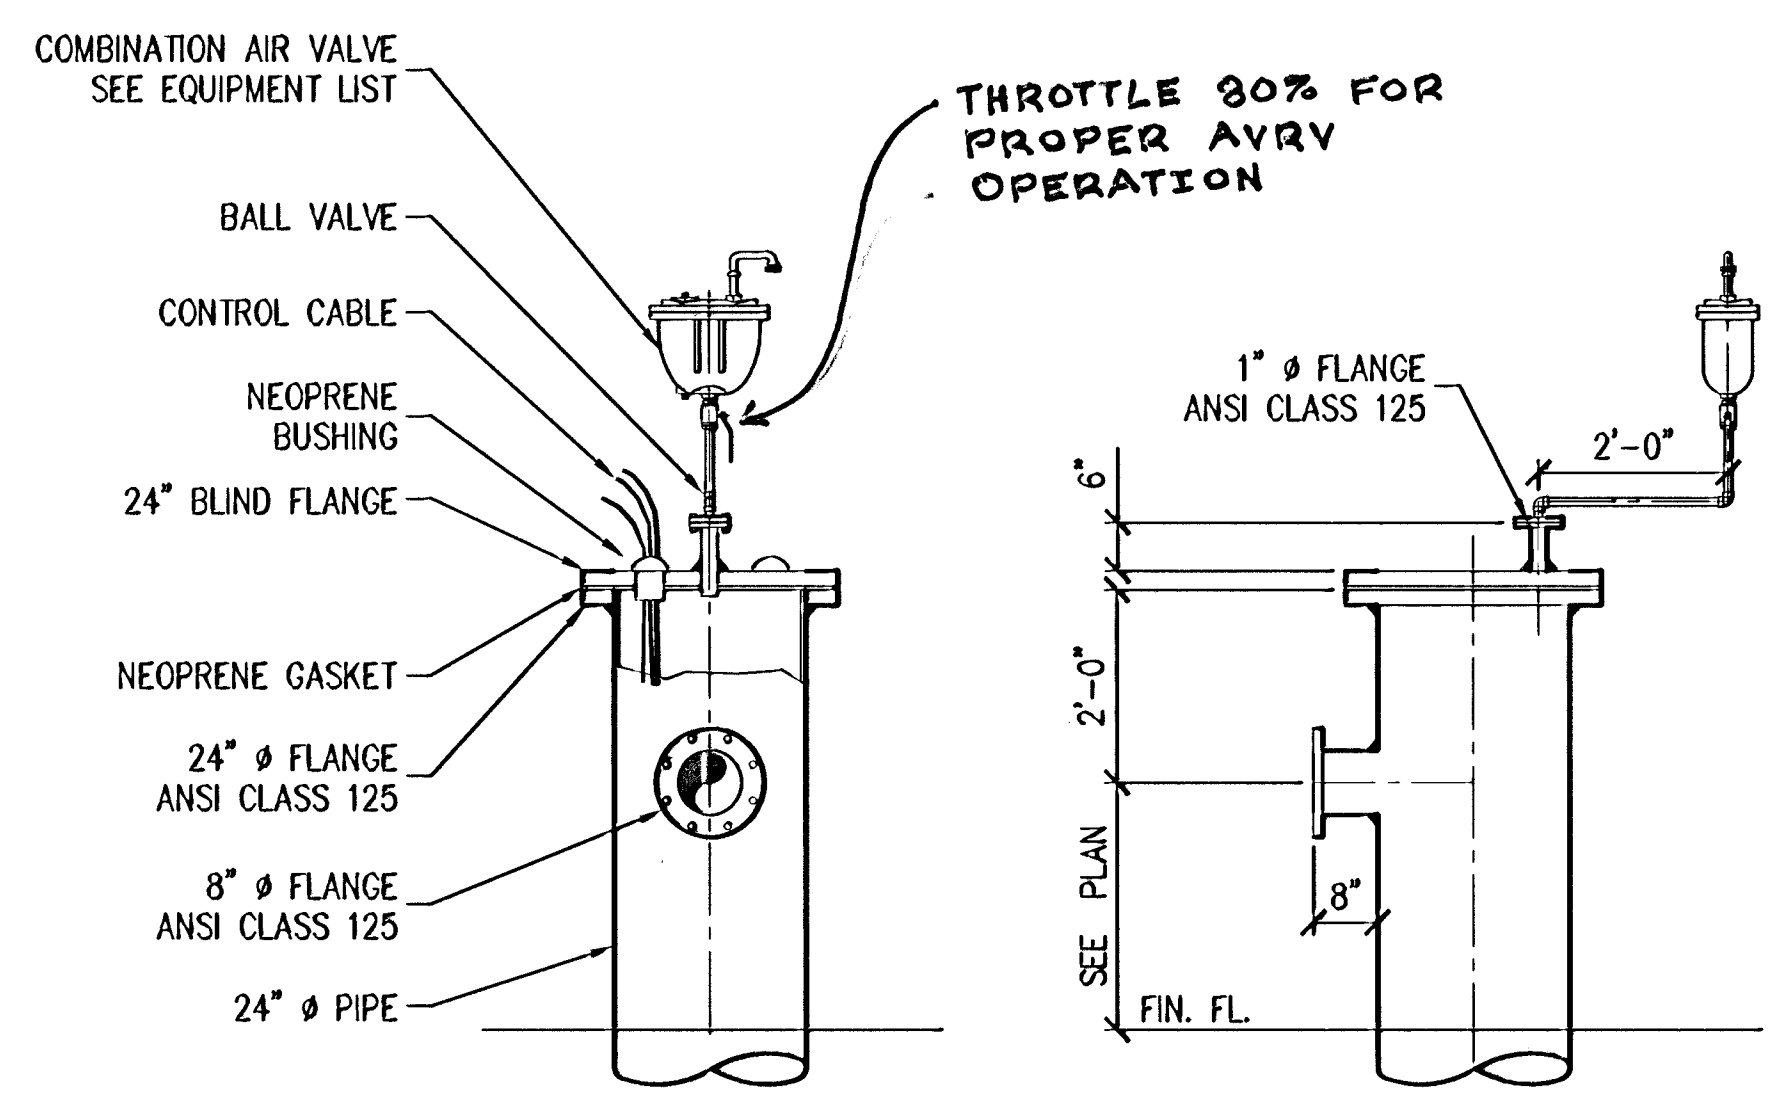

**TOP OF 24" CAN DETAIL**

SCALE: 1/2"=1'-0" **H**

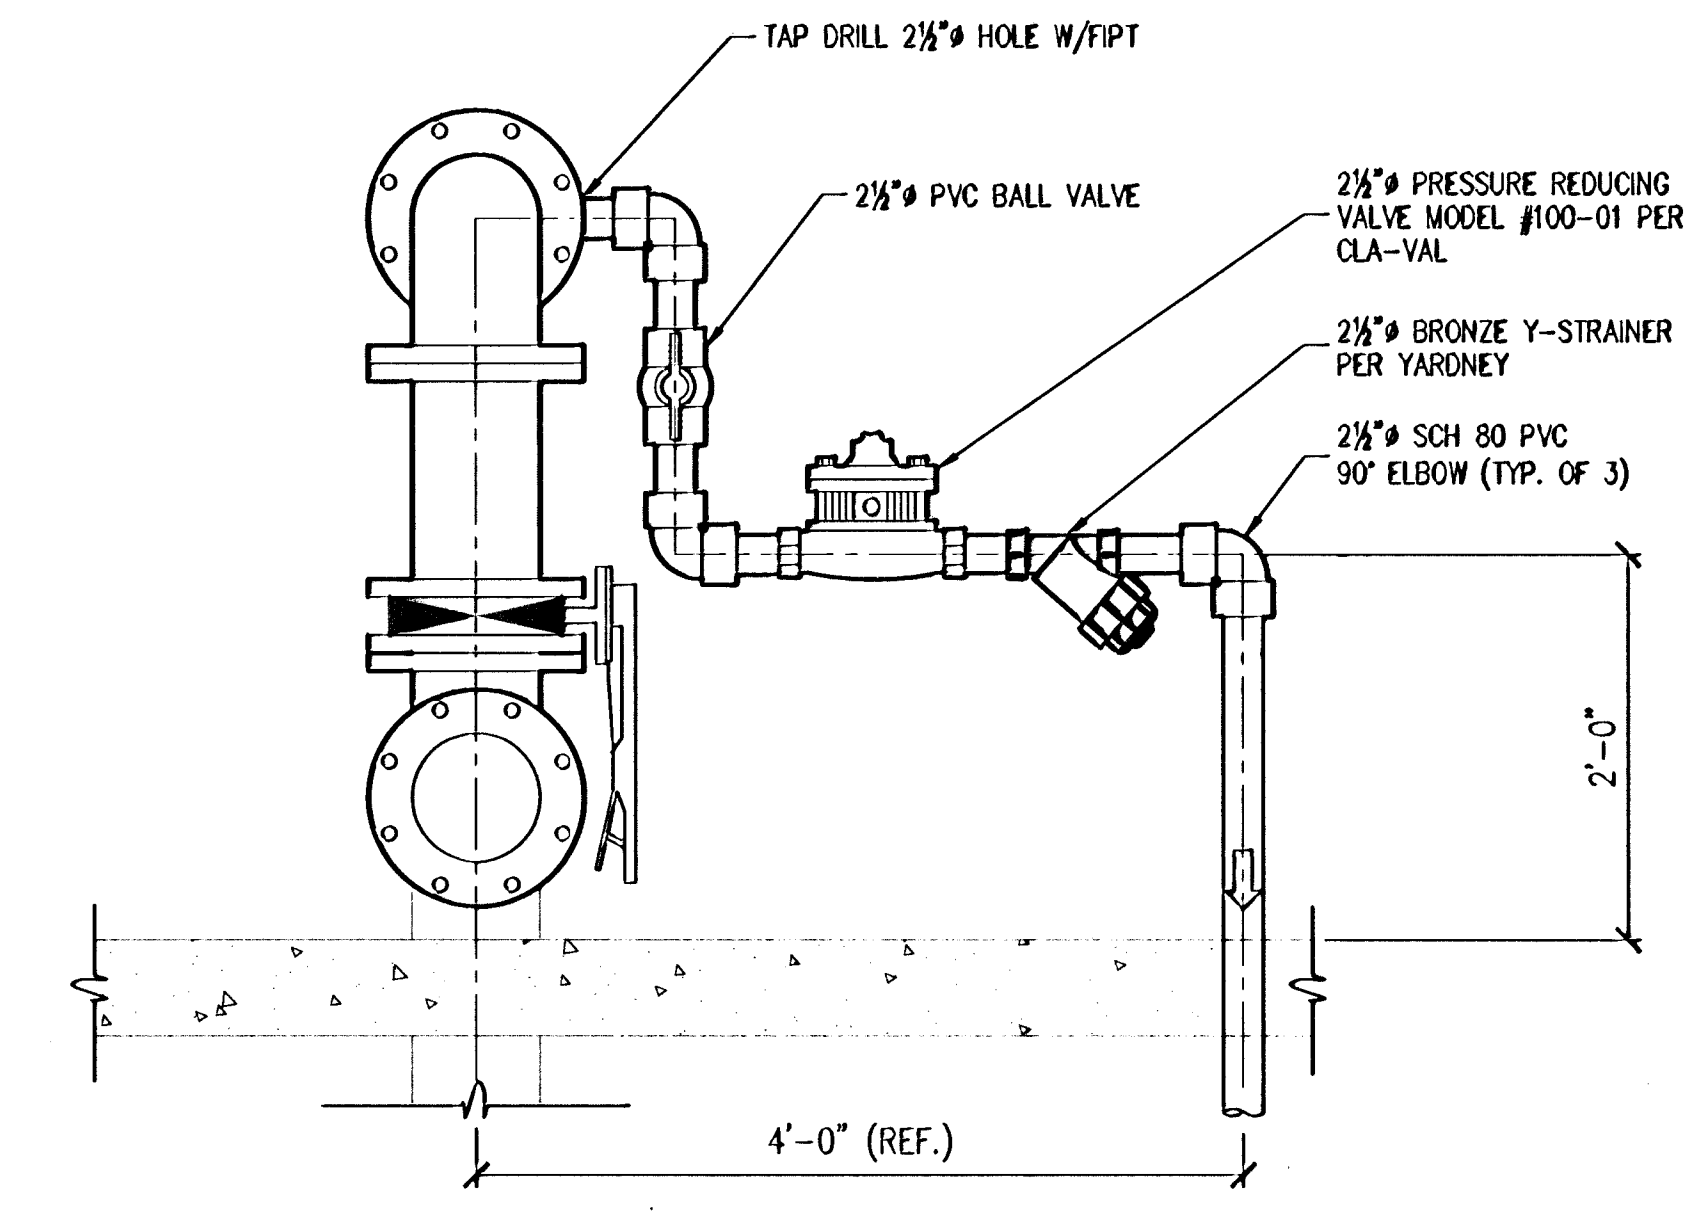


**SUCTION SCREEN RETURN LINE**

SCALE: 1"=1'-0" **I**

Xrefs: 8138-10-Tblk.dwg Dimstyle = 32; LTable = 0.5; PStyle = 1; Acad Ver. = 16.0a (LMS Tech); Version = 1

P:\3138\Engineering\Submittals\Record Drawings\Sheets\8138-10-SHEET-M3.dwg - Tab: LAYOUT By: dpliliana on Jun 04, 2006 at 05:28 pm

- NOTES:  
1.  
2. TOP RAIL AT END POST SHALL BEND DOWN ON 1" MAX. CENTER LINE RADIUS. TOP RAIL AT CORNERS SHALL BE A SIDE OUTLET ELBOW (OR OFFSET CORNER POST 6" AND USE 3" CENTER LINE RADIUS HORIZ. BEND IN ALL RAILS AND TOEBOARD).  
3. PROVIDE EXPANSION JOINTS IN HANDRAILING PER MANUFACTURER RECOMMENDATIONS.

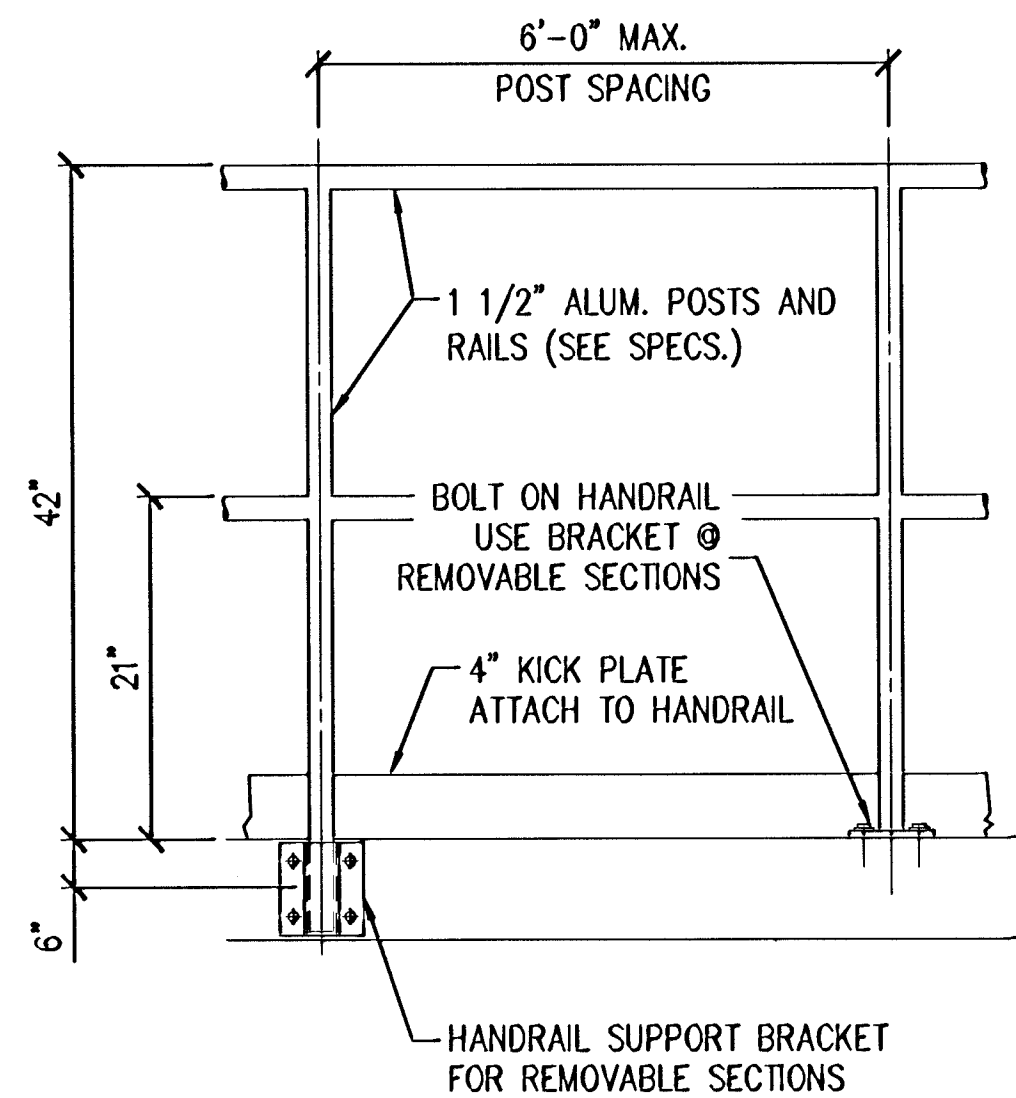


HANDRAIL DETAIL

SCALE: 1"=1'-0"

A


- NOTE:  
1. STAIR TREAD WIDTH TO BE A MINIMUM OF 11" BY 36".  
2. VERTICAL DISTANCE BETWEEN STEPS SHALL NOT EXCEED 8".  
3. CONTRACTOR TO FIELD VERIFY DIMENSIONS FOR RISE AND RUN OF STAIR.

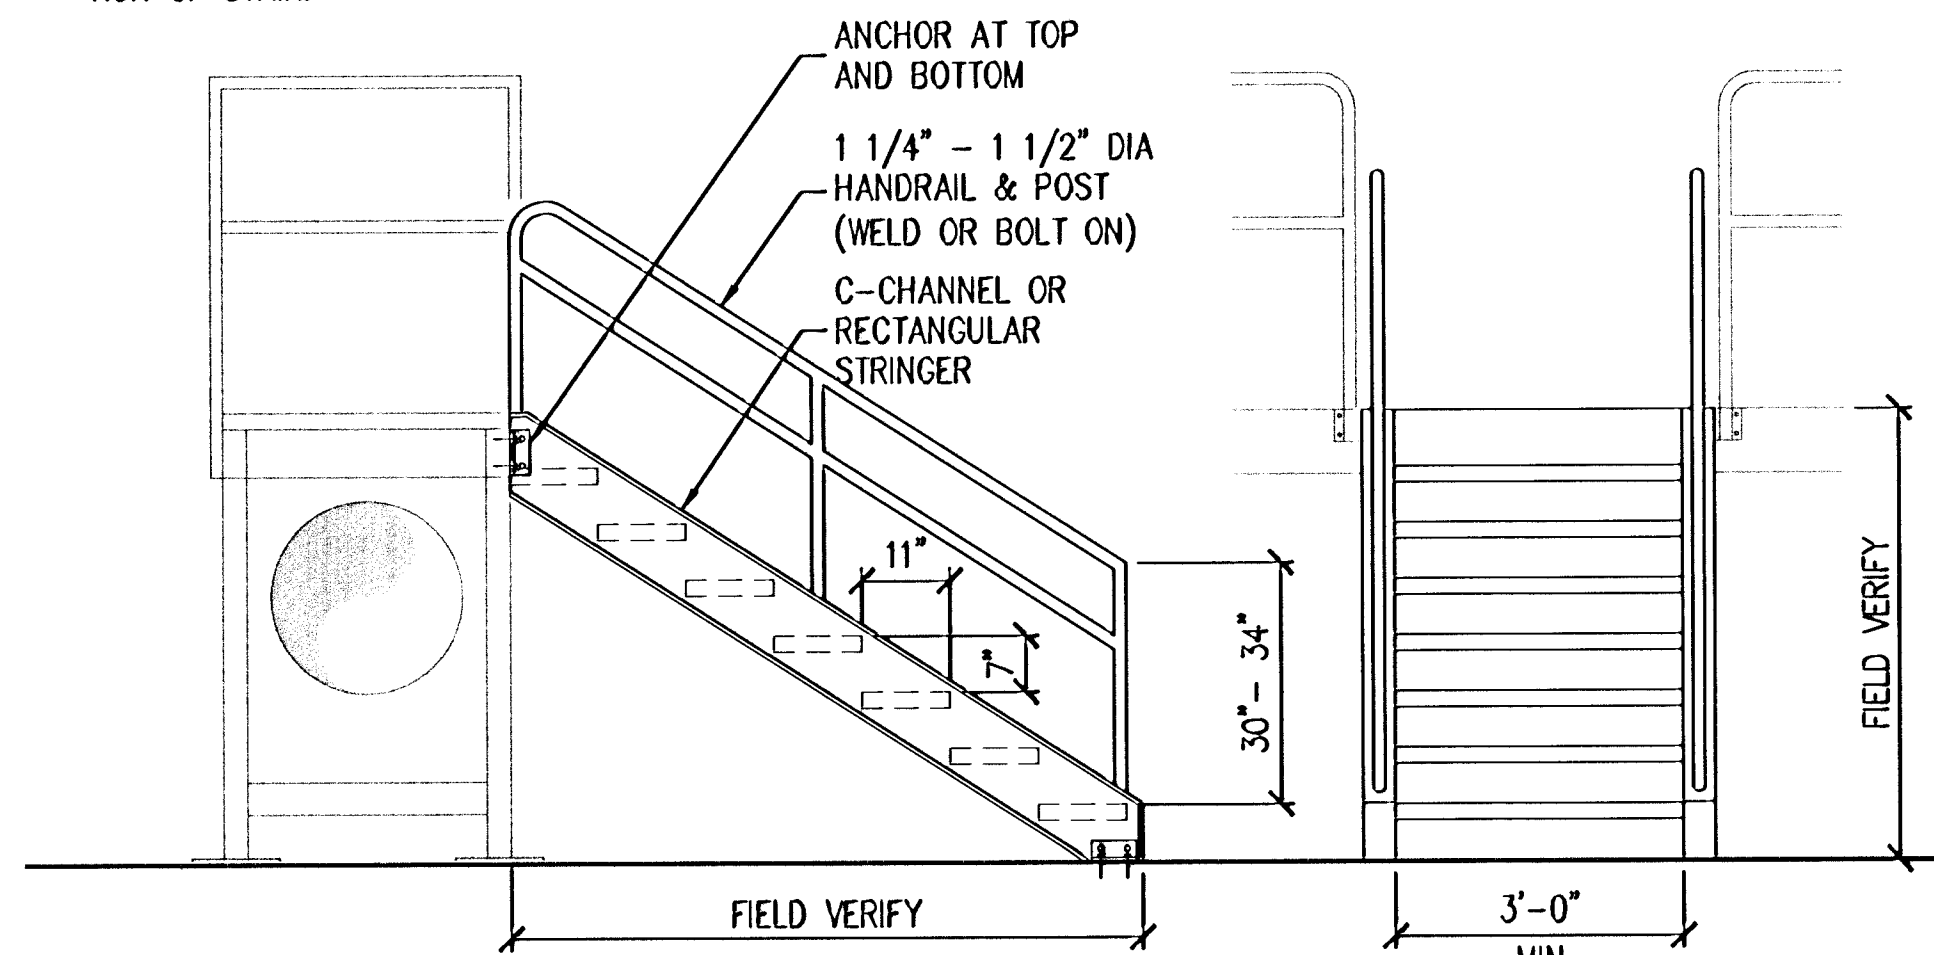

STAIR DETAIL

SCALE: 1/2"=1'-0"


B

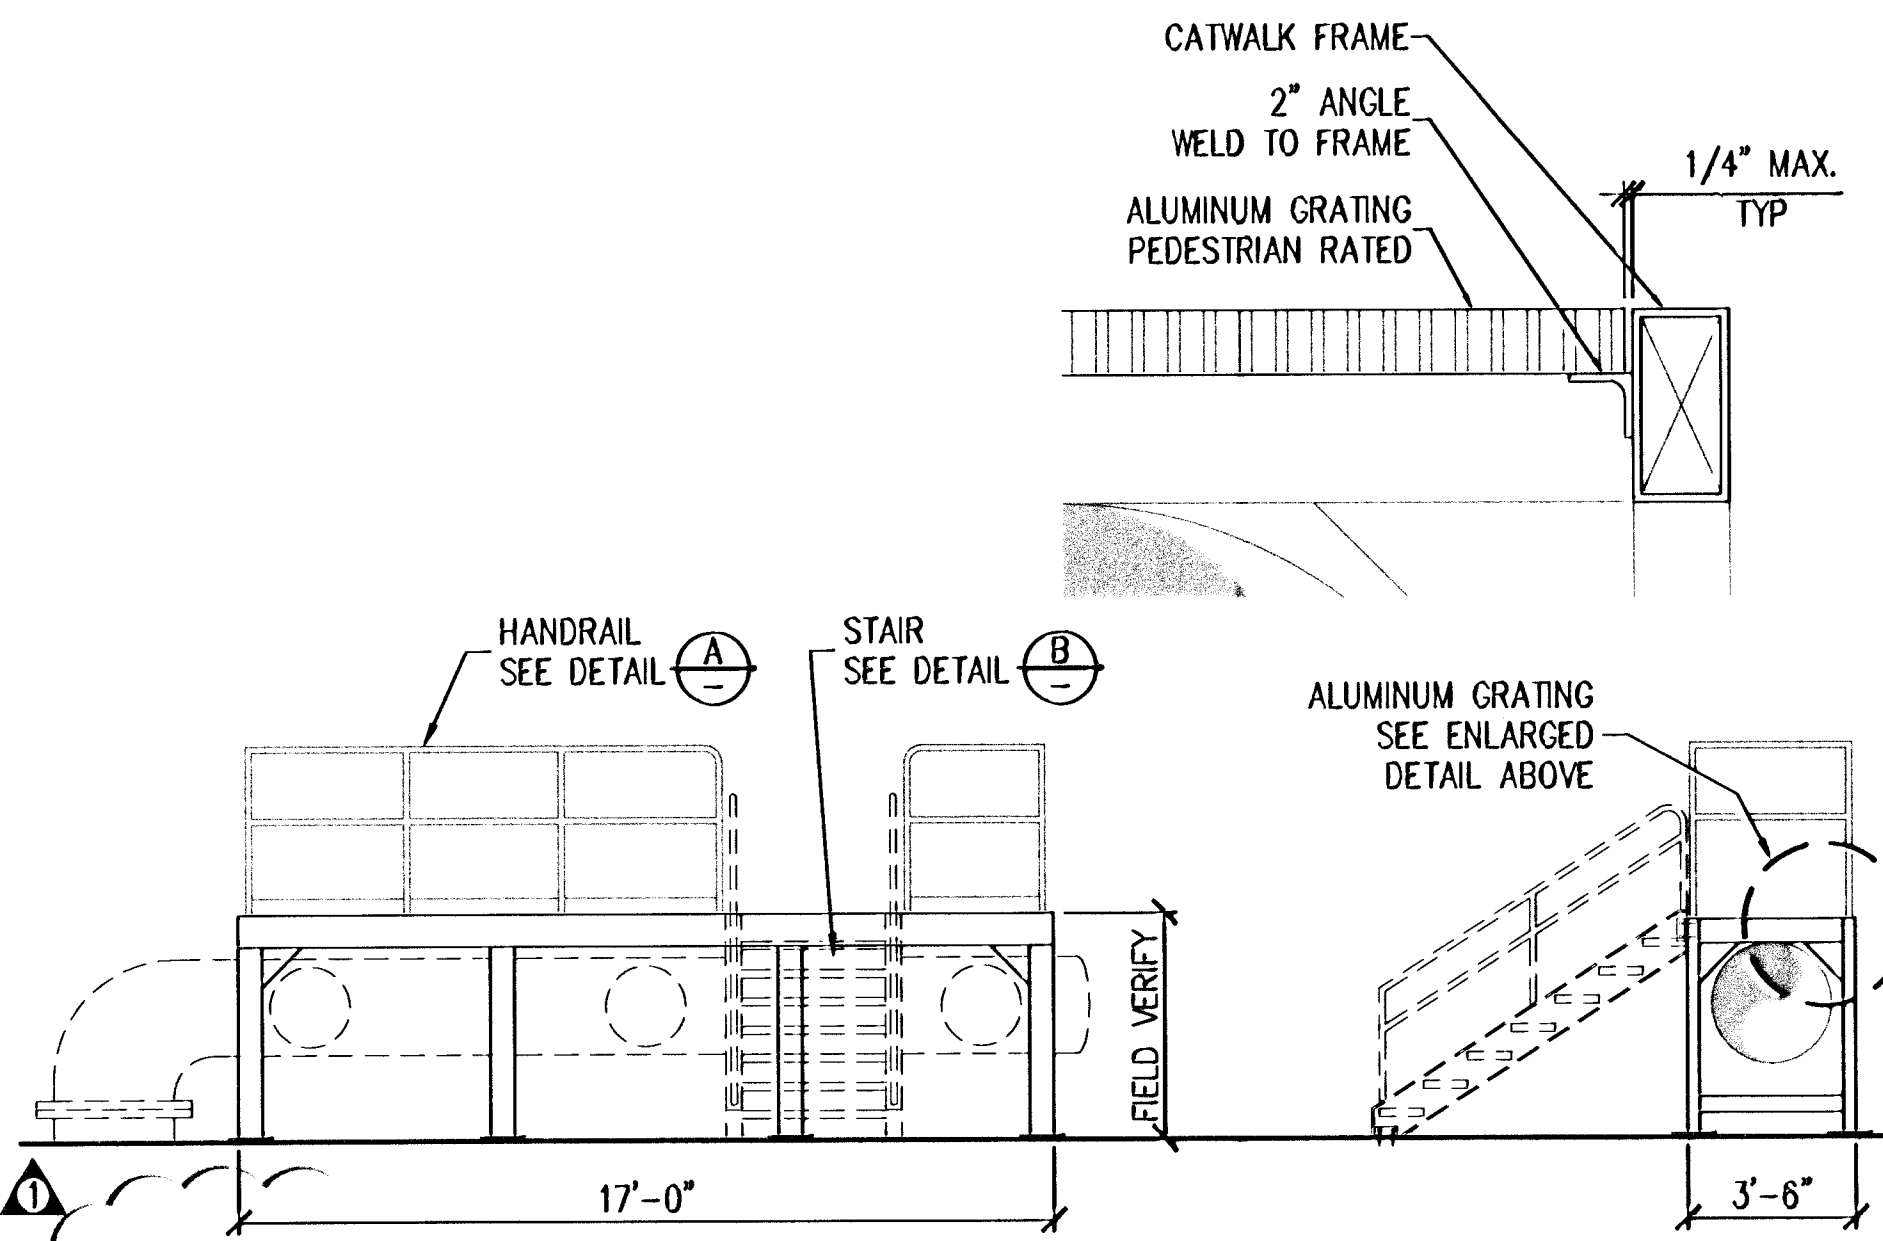

SERVICE CATWALK

SCALE: 1/4"=1'-0"


C

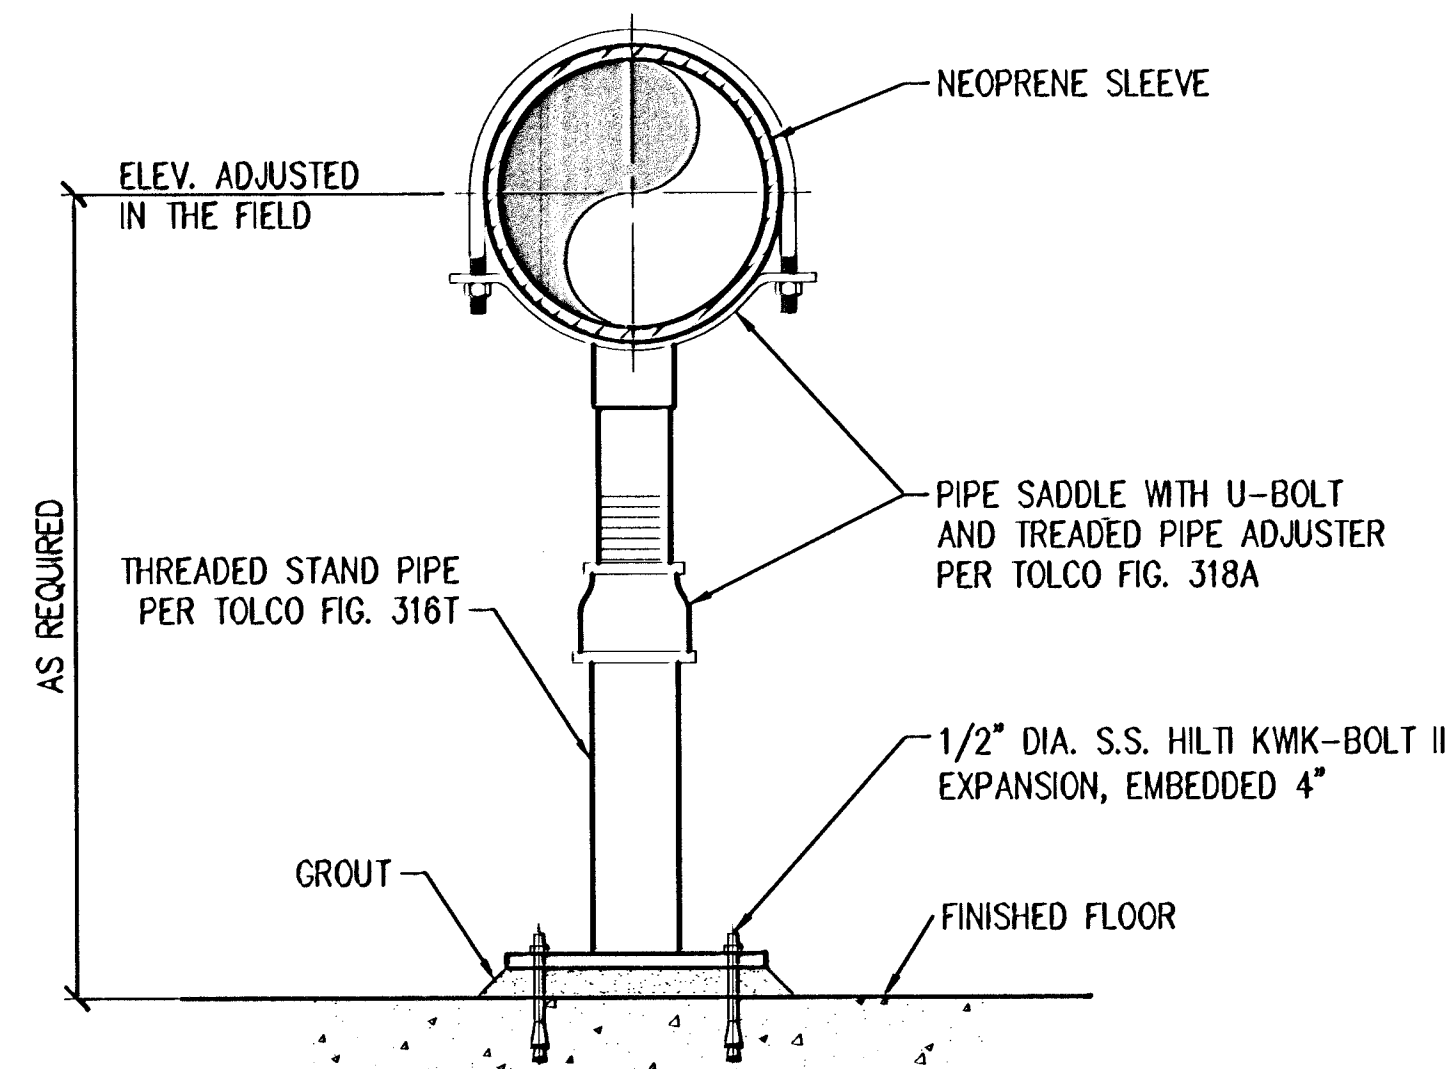

PIPE SUPPORT

SCALE: 1"=1'-0"


D

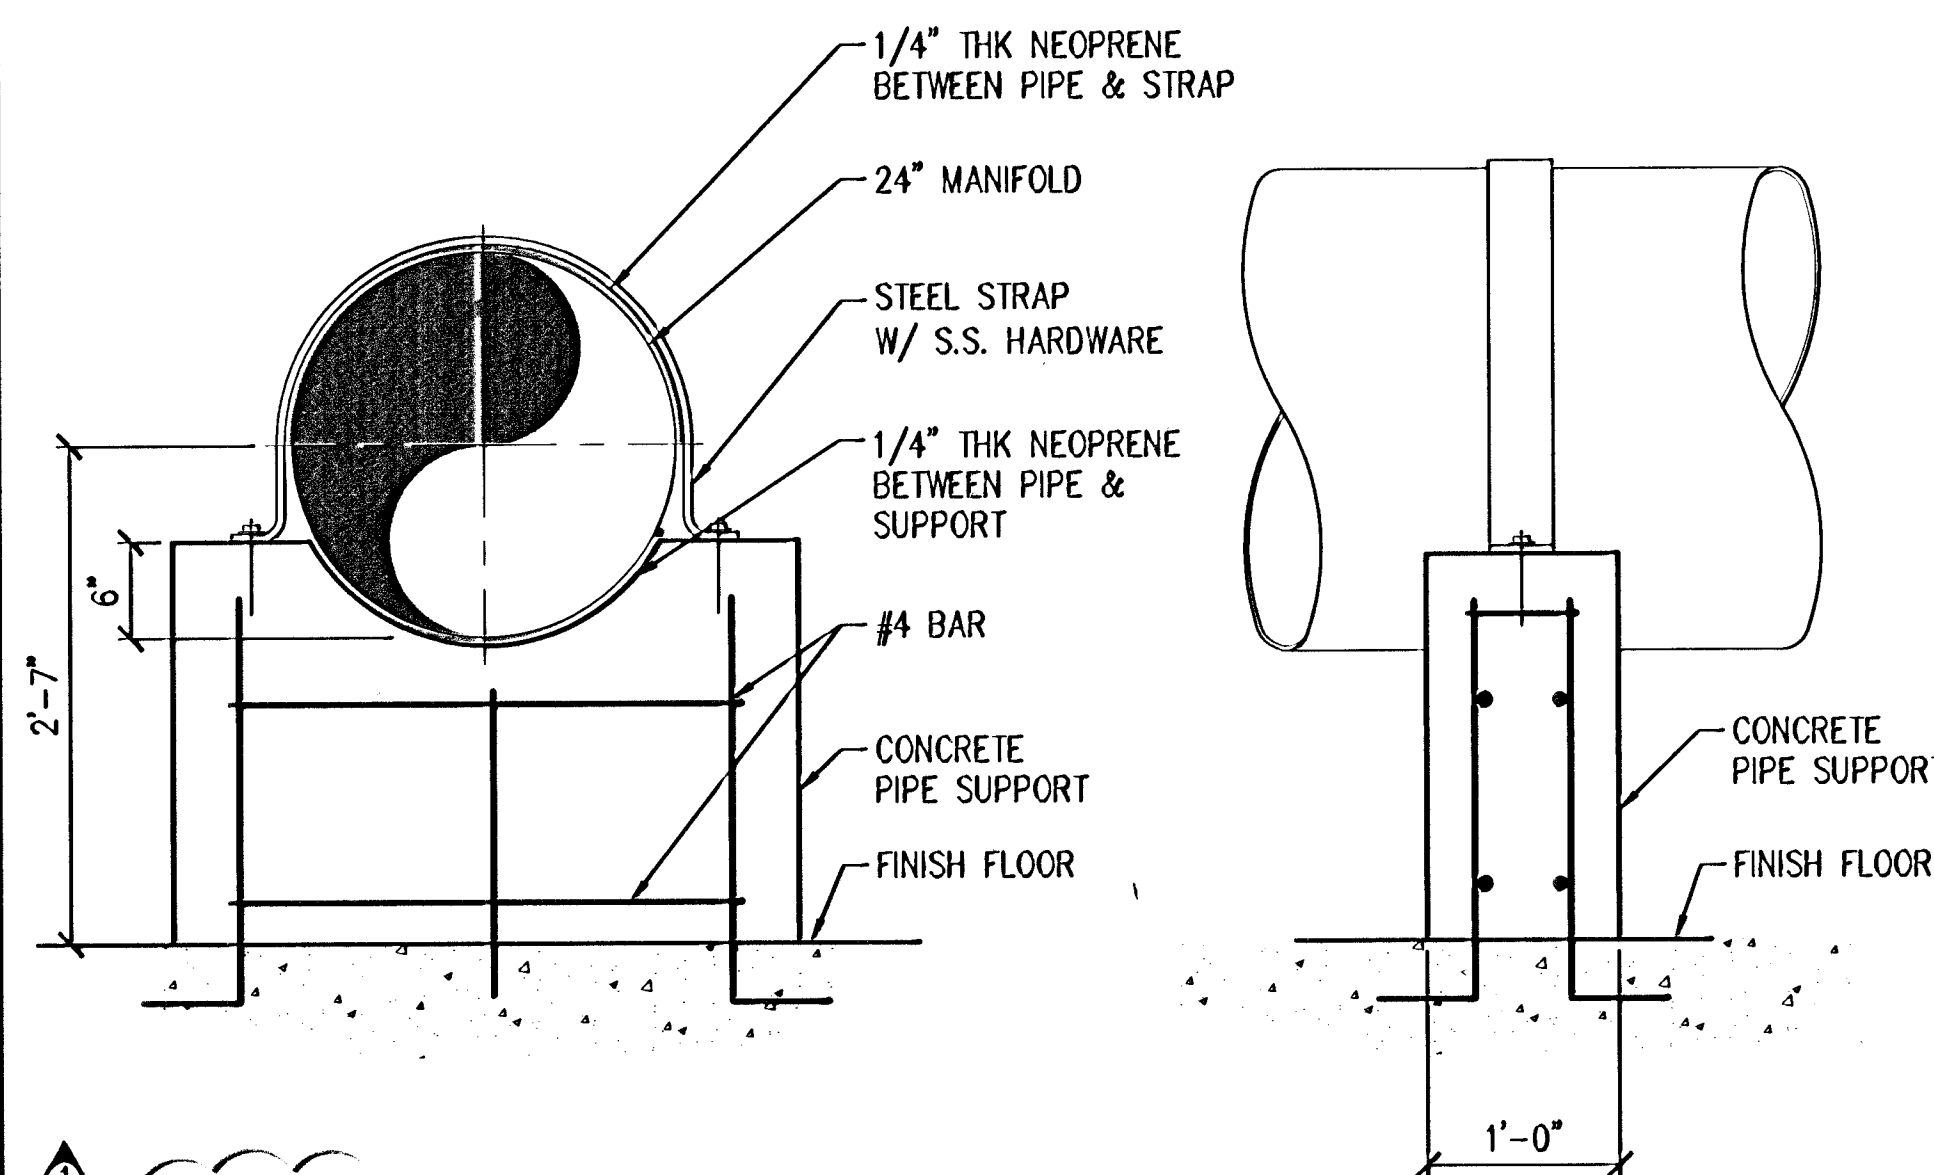

PIPE SUPPORT

SCALE: 1"=1'-0"


E

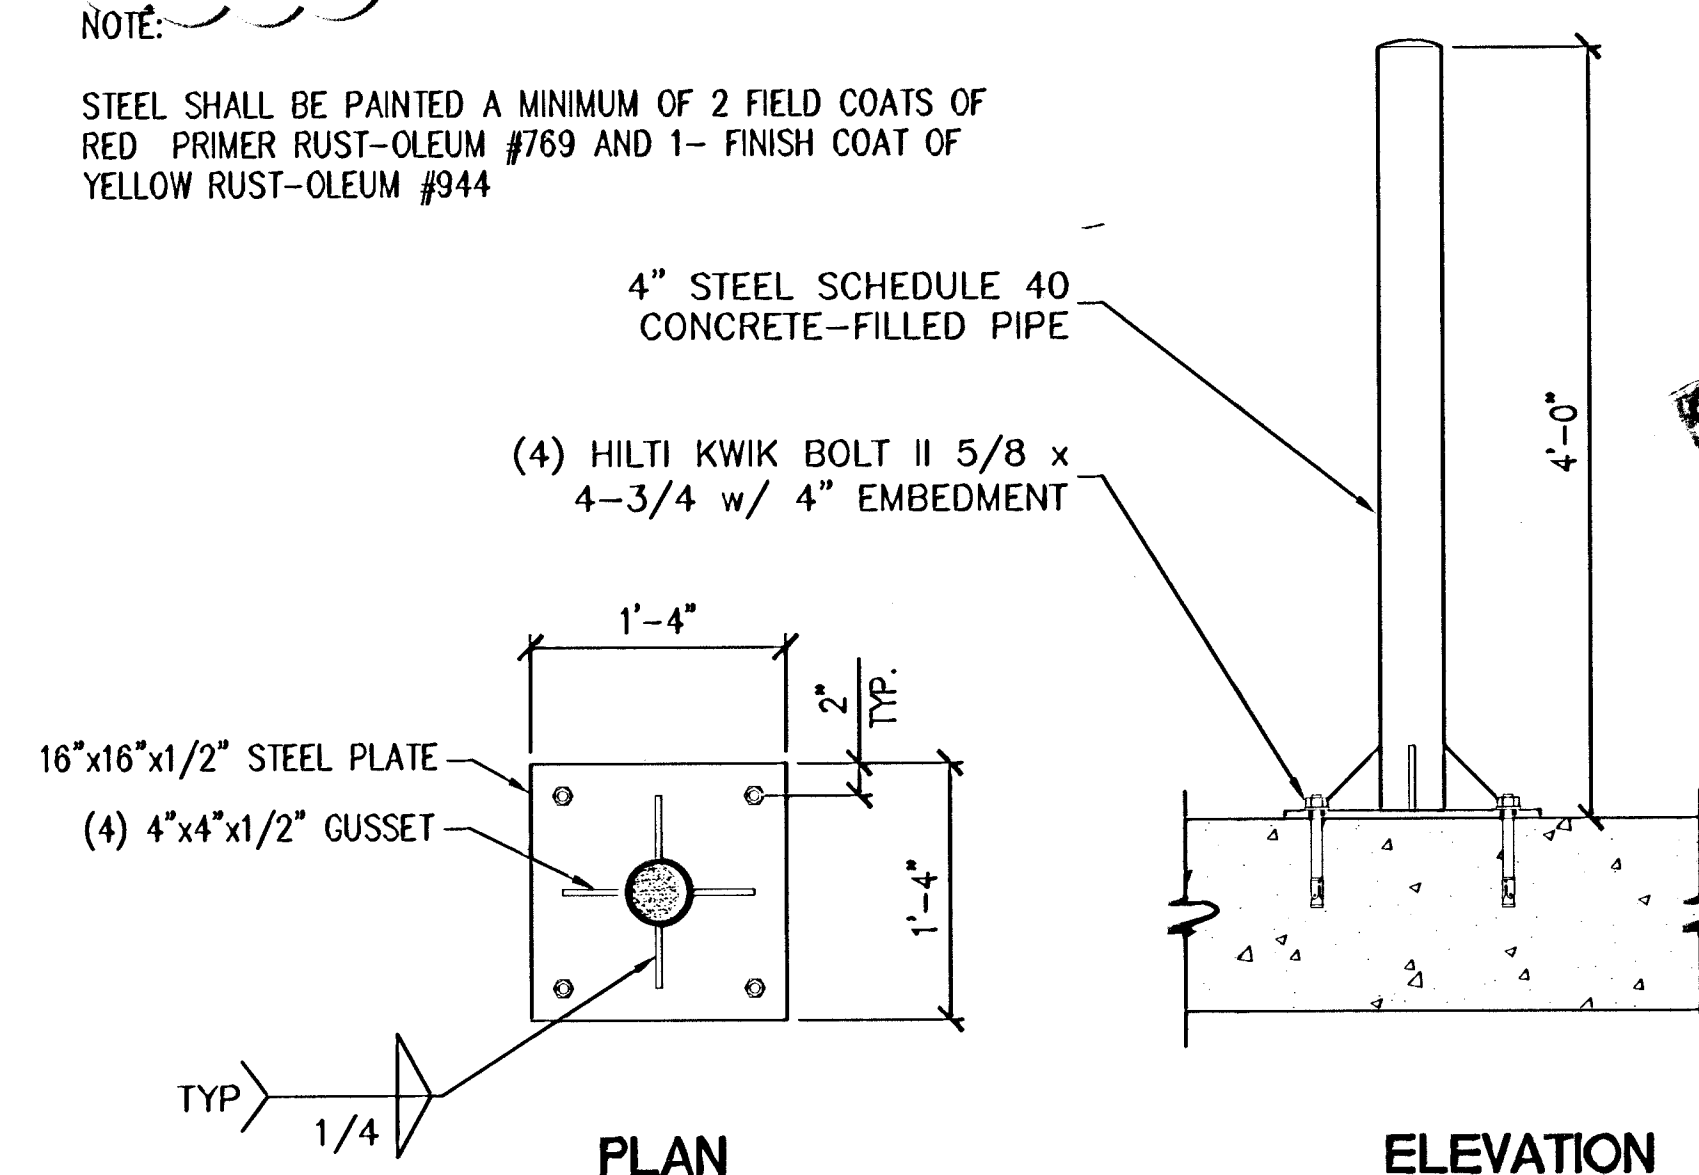

BOLTED BOLLARD DETAIL

SCALE: 1"=1'-0"


F

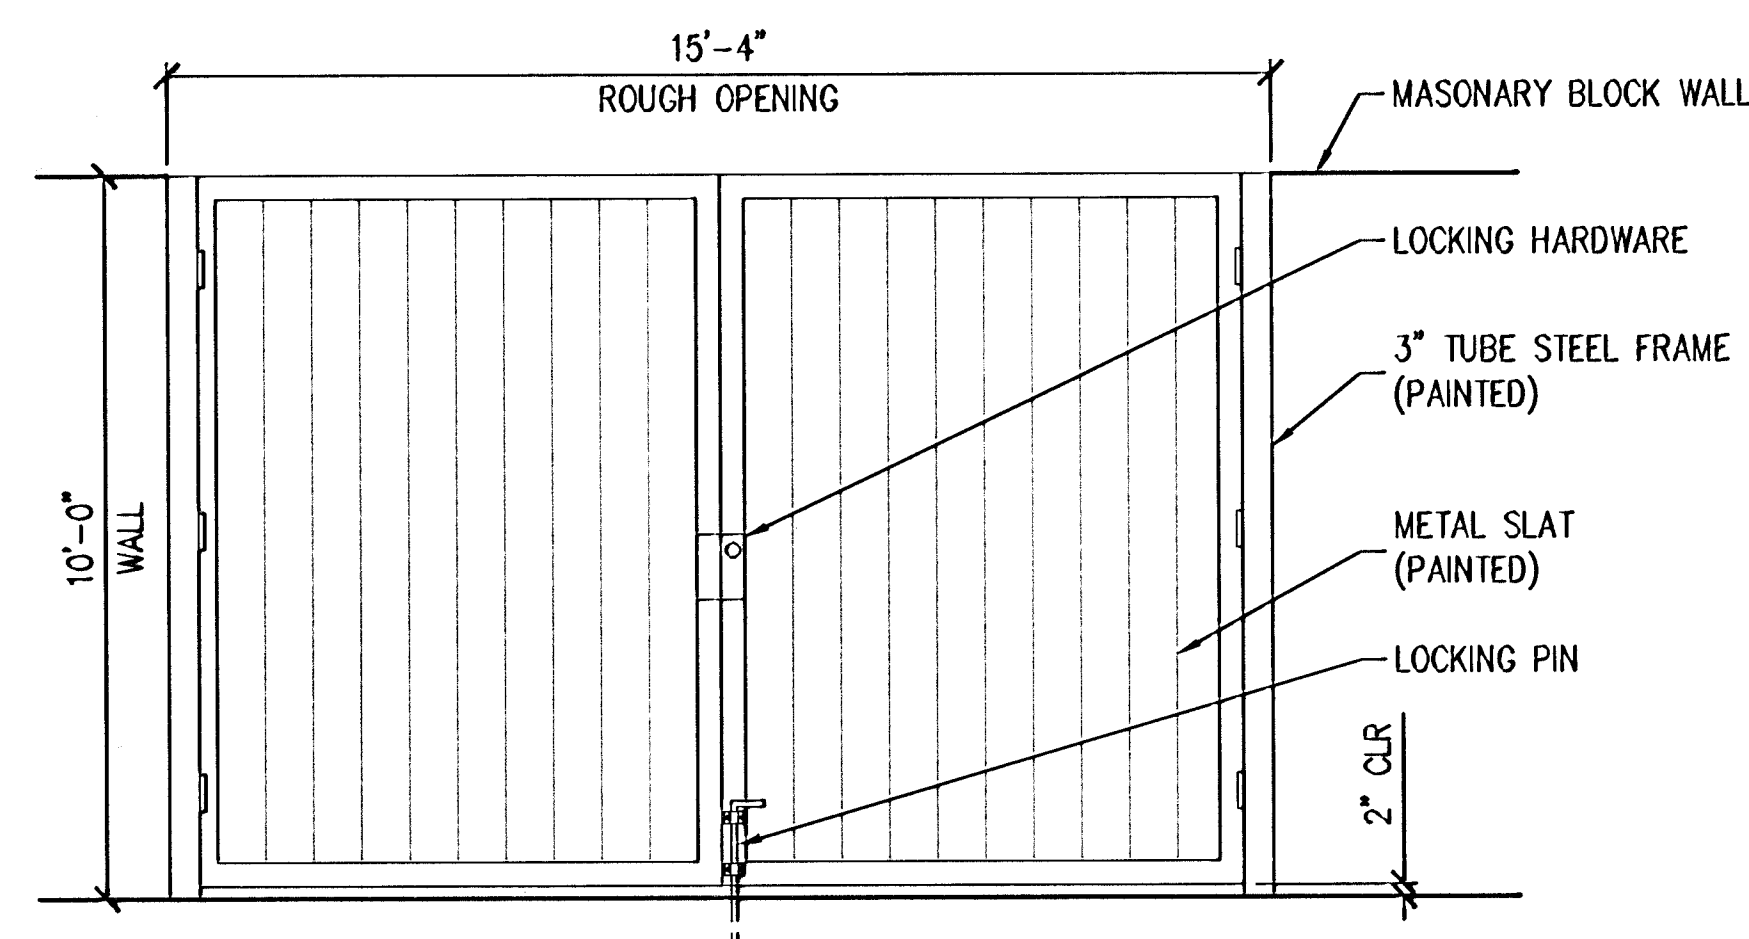

STEEL GATE

SCALE: 3/8"=1'-0"

G

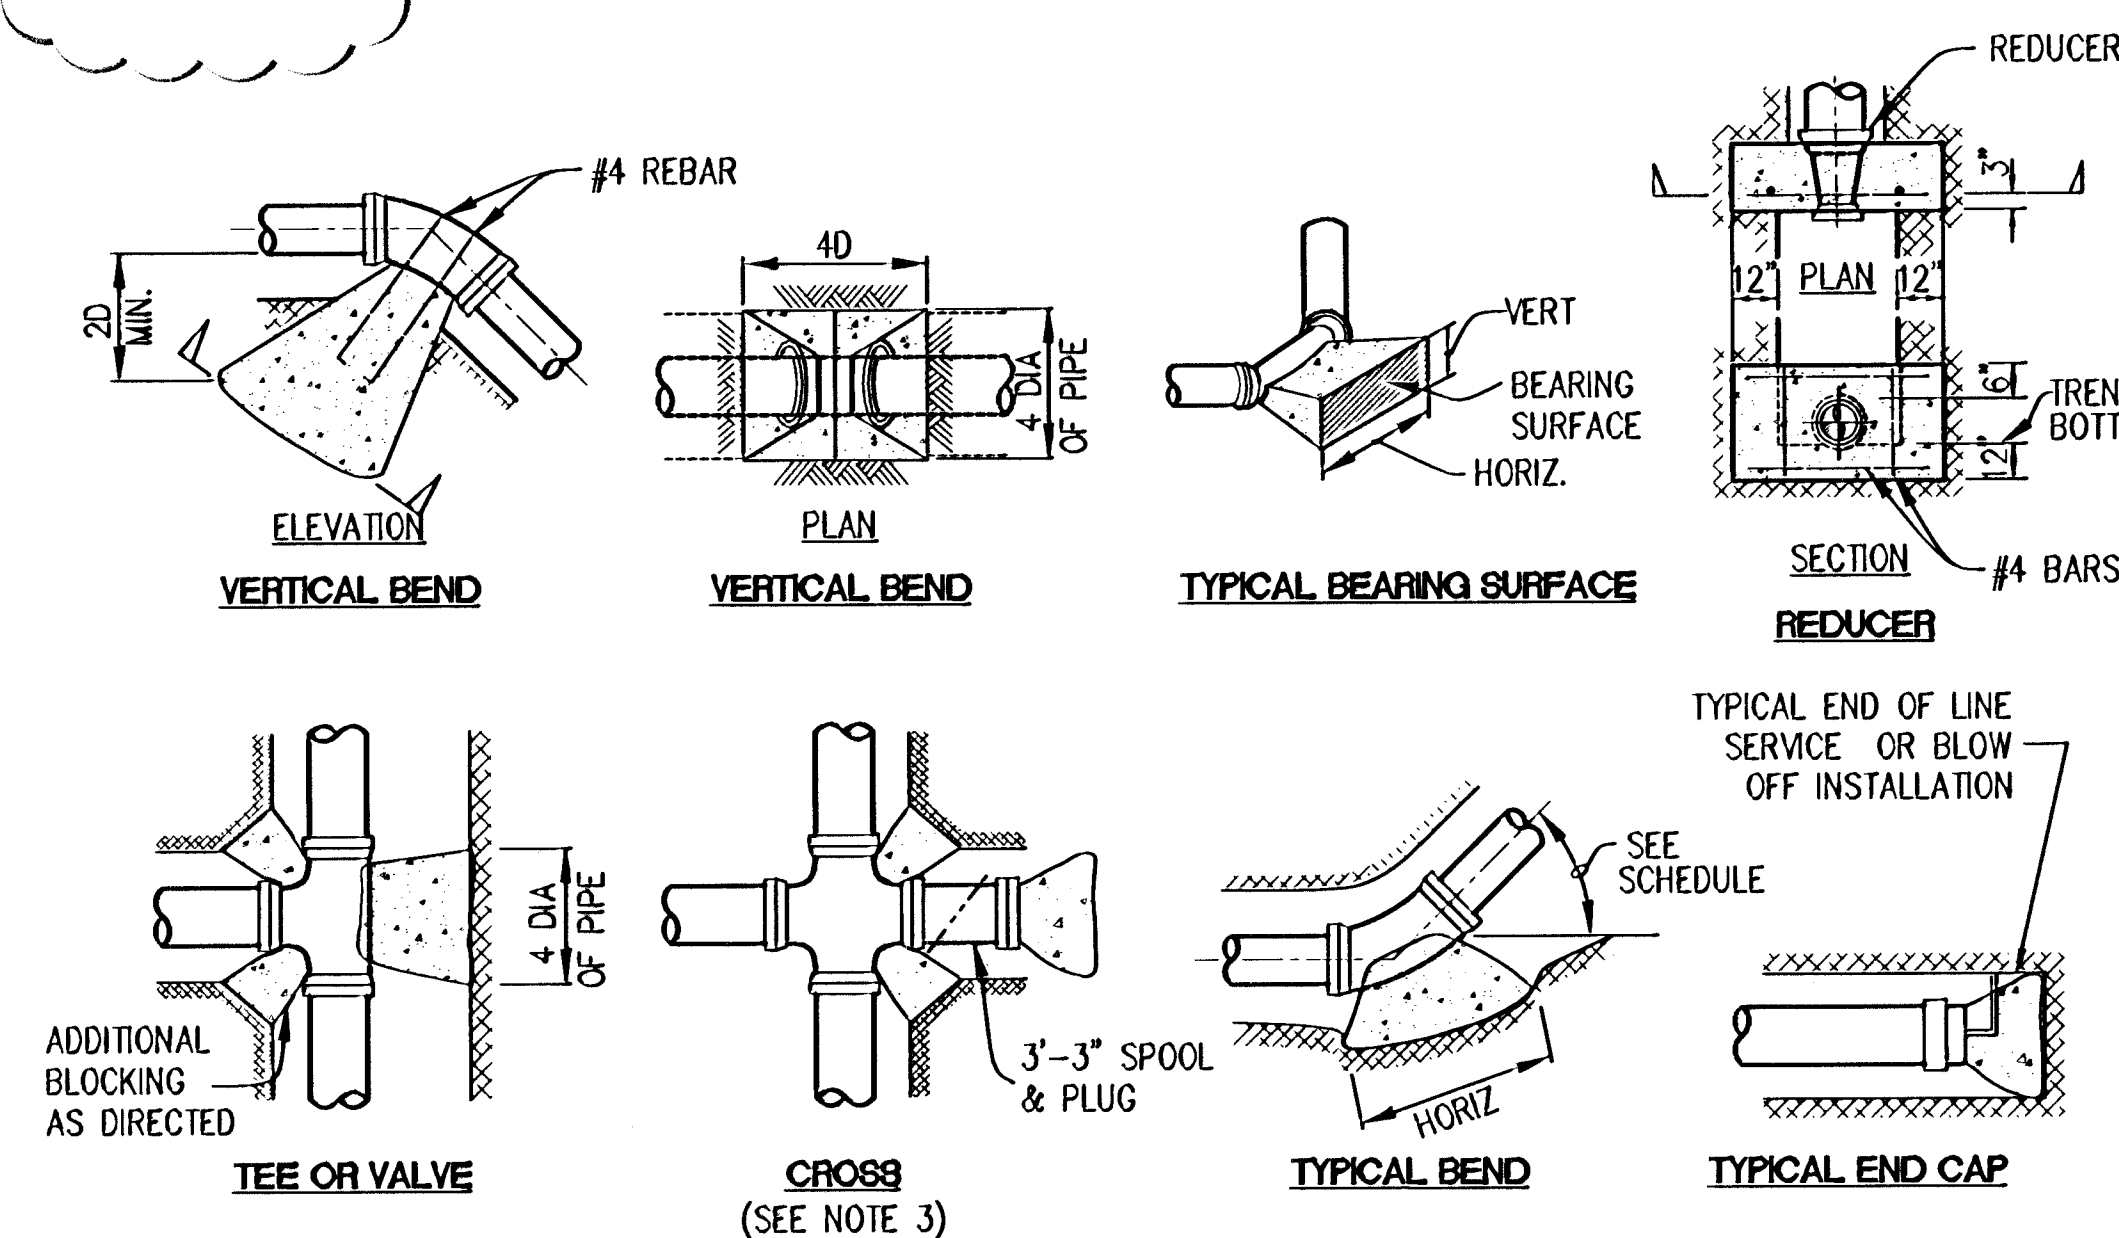

THRUST BLOCK

- NOTES:  
1. THRUST BLOCK BEARING AREA BASED ON ALLOWABLE SOIL BEARING VALUE OF 2000 psf PRESSURE AND 150 psi LINE PRESSURE WITH 3'-0" COVER MINIMUM.  
2. PORTLAND CEMENT CONCRETE SHALL BE 420-C-2000 CONCRETE. CONCRETE SHALL BE PLACED AGAINST UNDISTURBED SOIL.  
3. THRUST BLOCKS ON CROSSES SHALL BE USED ONLY WHEN THERE IS A STUB-OUT ON ONE OR MORE SIDES.  
4. REINFORCING STEEL SHALL CONFORM TO ASTM A15 AND A305 INTERMEDIATE GRADE.  
5. CONCRETE SHALL NOT EXTEND INTO FLANGE OR ADJOINING PIPE.  
6. THRUST BLOCK BEARING AREAS HAVE BEEN CALCULATED WITH A SAFETY FACTOR OF 1.5.

PIPE SIZE	BEARING AREA TABLE					
	11 1/4" BEND	22 1/2" BEND	45" BEND	90" BEND	TEE	END CAP
	HORIZ. VERT.	HORIZ. VERT.	HORIZ. VERT.	HORIZ. VERT.	HORIZ. VERT.	HORIZ. VERT.
4"	1'-0" 0'-6"	1'-0" 0'-9"	1'-3" 1'-0"	1'-0" 1'-0"	1'-6" 1'-0"	1'-6" 1'-0"
6"	1'-0" 0'-9"	1'-3" 1'-0"	2'-0" 1'-6"	2'-3" 2'-0"	2'-0" 1'-9"	2'-0" 1'-9"
8"	1'-3" 1'-0"	1'-6" 1'-6"	2'-6" 2'-0"	3'-0" 2'-9"	3'-0" 2'-0"	3'-0" 2'-0"
10"	1'-9" 1'-0"	2'-0" 1'-9"	3'-0" 2'-6"	4'-0" 3'-3"	4'-0" 2'-3"	4'-0" 2'-3"
12"	2'-0" 1'-3"	2'-6" 2'-0"	3'-6" 3'-0"	4'-6" 4'-0"	4'-0" 3'-3"	4'-0" 3'-3"
15"	2'-0" 2'-0"	3'-0" 2'-9"	4'-0" 4'-0"	6'-0" 4'-9"	5'-0" 4'-0"	5'-0" 4'-0"

SCALE: NTS

H

SL	4-75/25 PER CITY COMMENTS	NO	BY DATE	REVISIONS	DATE APP.
1					
2					
3					
4					
5					

**RECORD UPON**

APPROVED FOR CONSTRUCTION

PROJECT ENGINEER: ANDREW T. KONOR

PROJECT NO.: # C 04528

DATE: 07/20/07

SCALE: 1/4" = 1'

DESIGNED: J.A.M.

CHECKED: A.K.

DATE: APR 2005

5-4-05

**GYPPRESS GROVE WATER PUMP STATION MECHANICAL DETAILS**


**PACIFIC ADVANCED CIVIL ENGINEERING**

17520 NEWHOPE STREET, SUITE 200  
FOUNTAIN VALLEY, CA 92708  
PH (714) 461-7300 FAX (714) 461-7299

SHEET **M4**

JOB NO. 8138-E




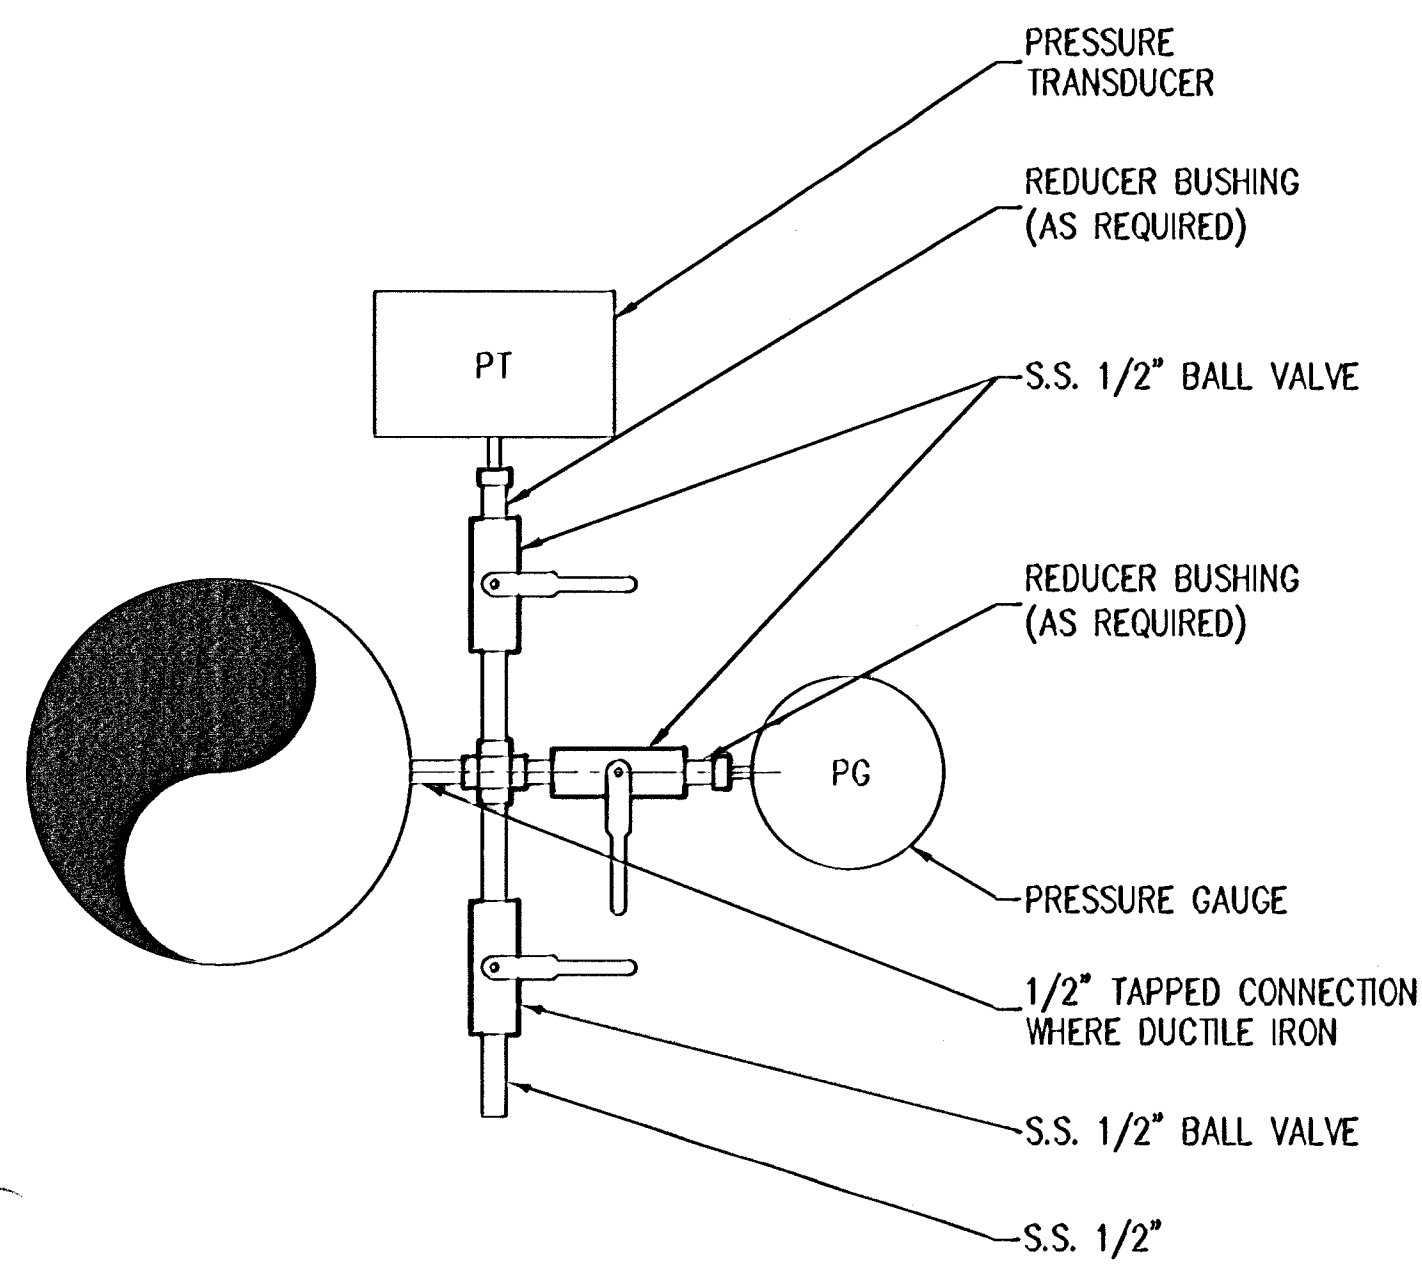

**PRESSURE TRANSDUCER**

SCALE: NONE


**A**

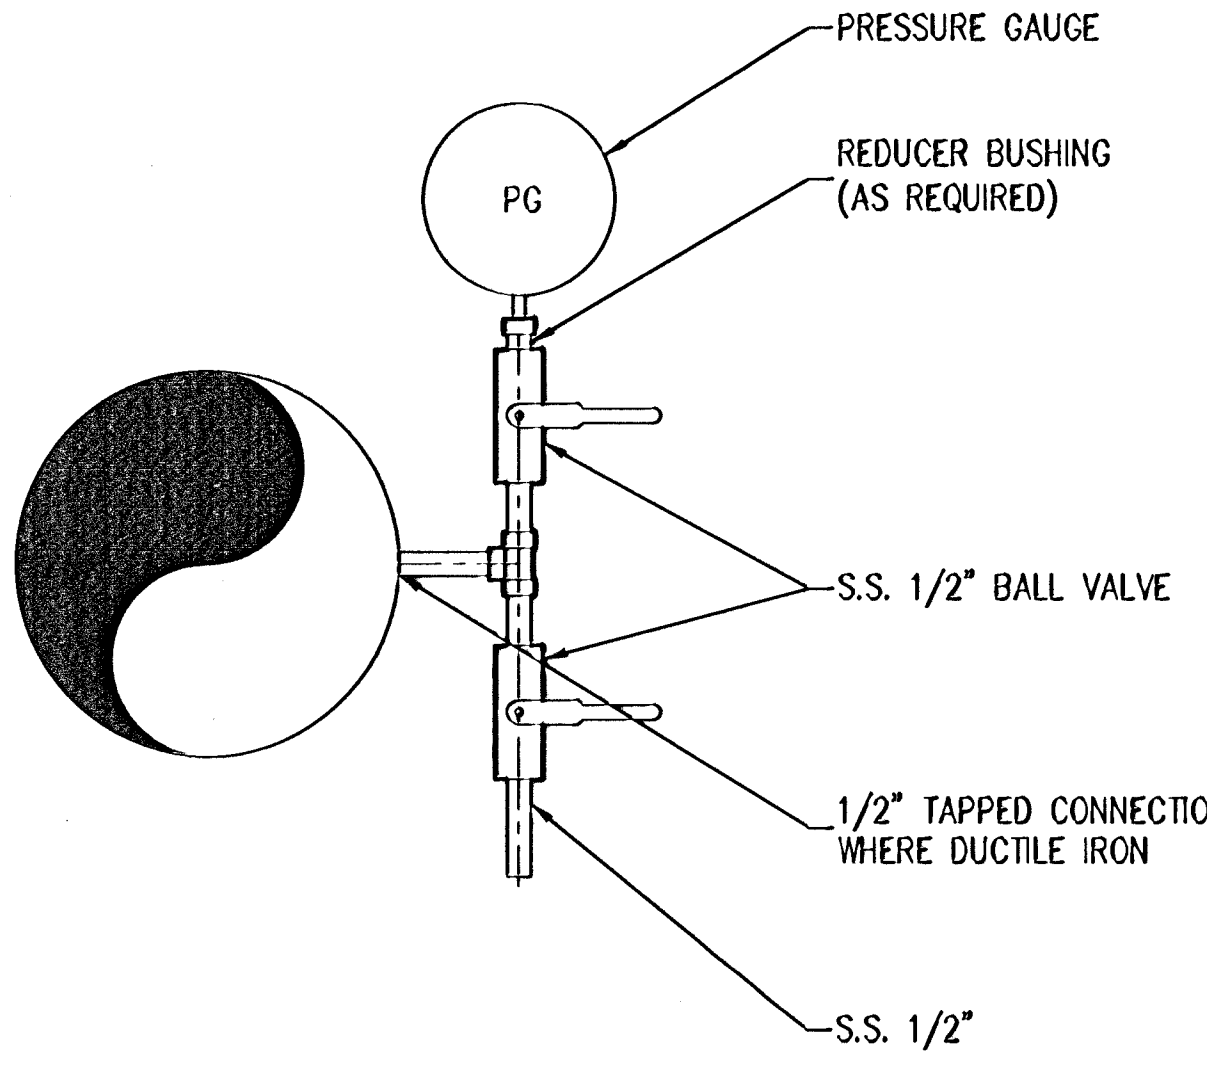

**PRESSURE GAUGE**

SCALE: NONE

**B**

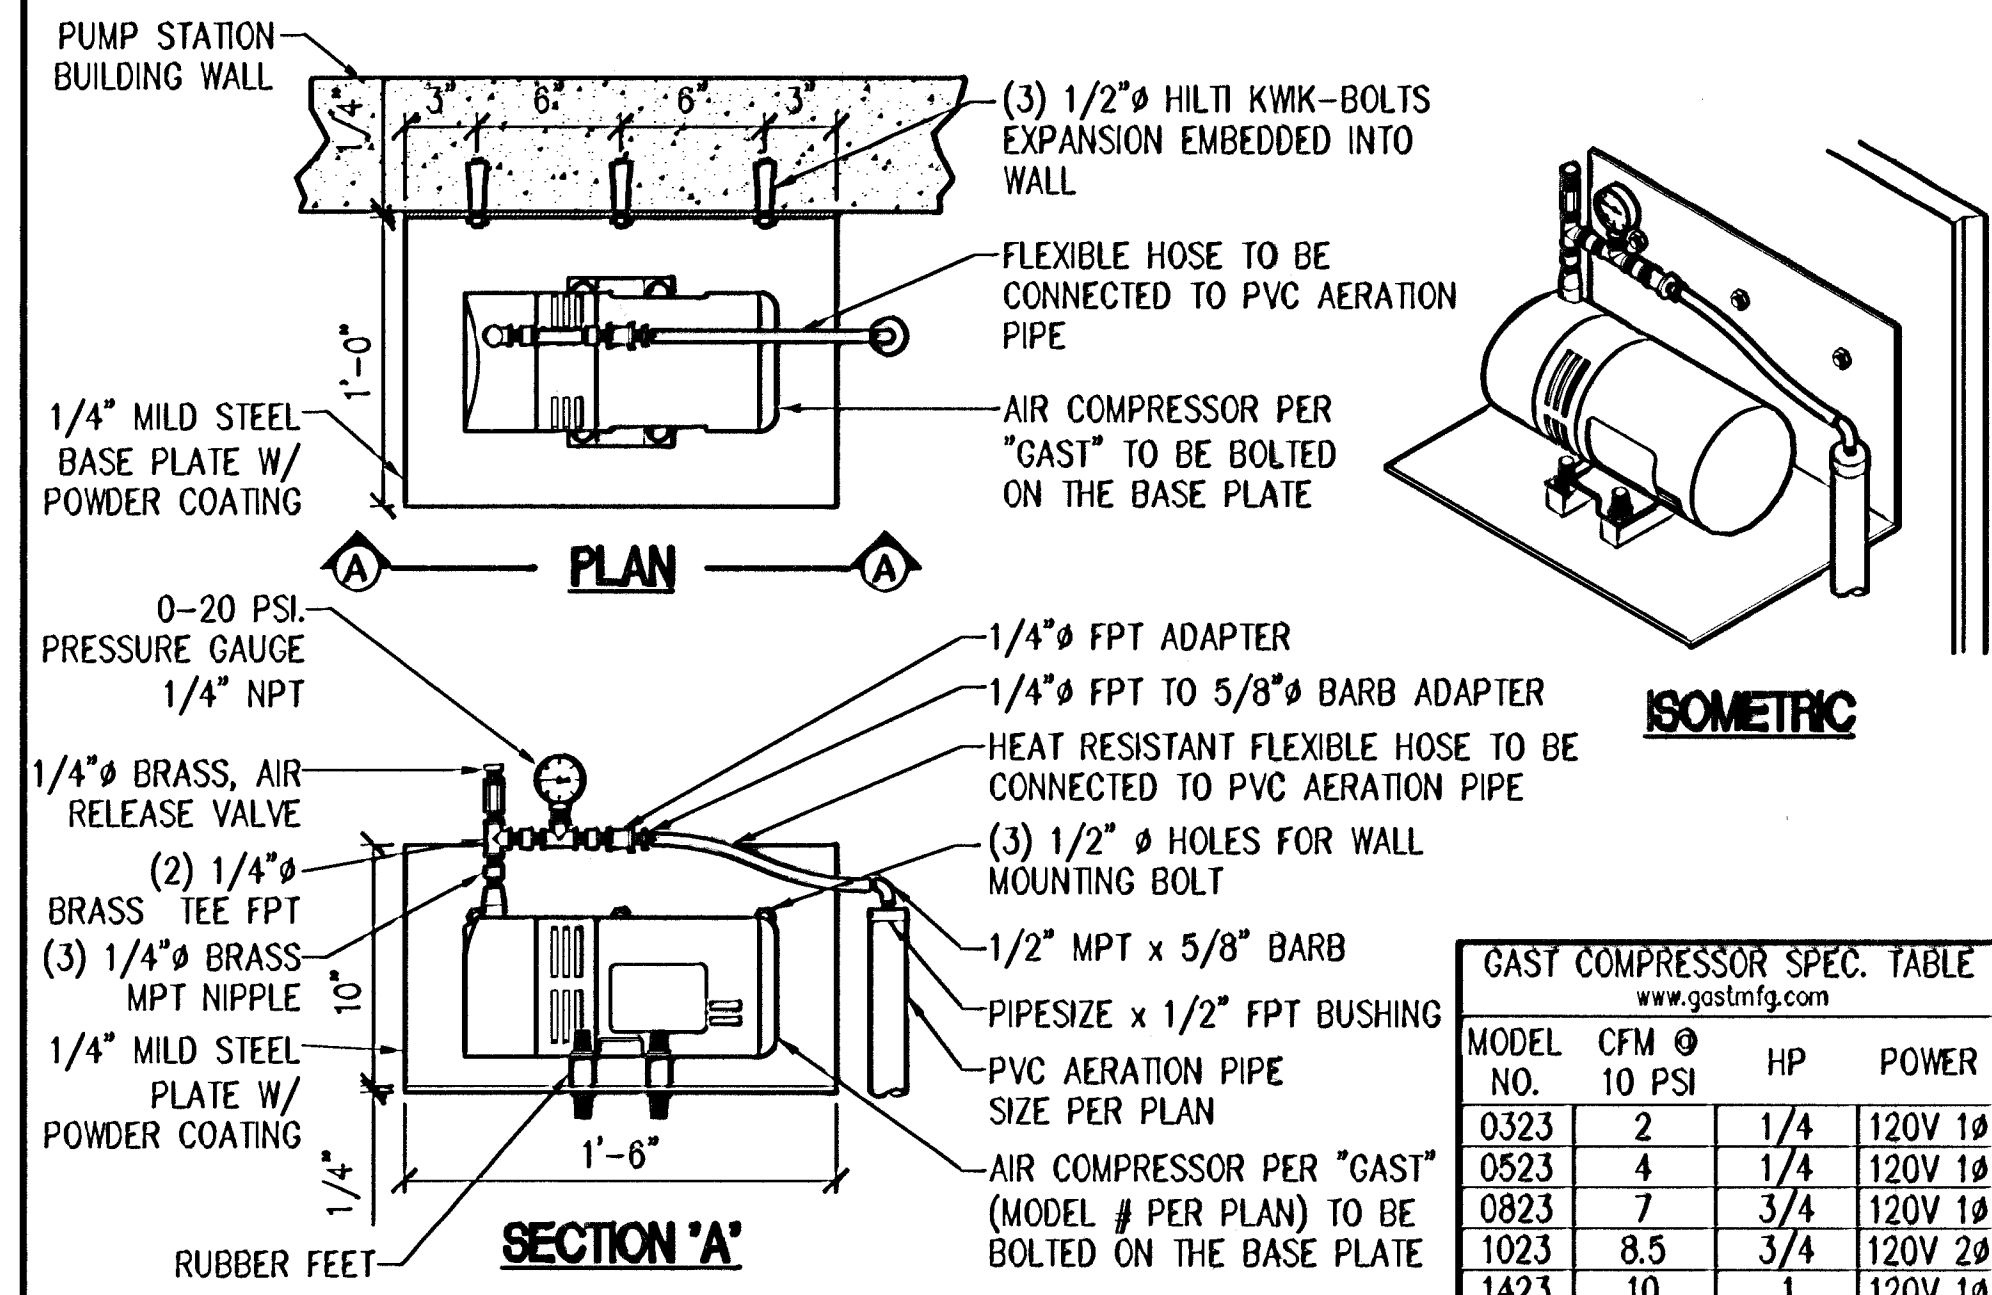

**COMPRESSOR - WALL MOUNTED**

SCALE: 1/8"=1'-0"

**C**

**RECORD DRAWINGS**

PREPARED BY: ANDREW T. KOMOR  
 PROJECT ENGINEER  
 SCALE NO.: # C 04928  
 DATE: 07/30/07  
 DRAWN: S.L./A.K.  
 CHECKED: J.A.H.  
 DATE: APR 2005  
 A.K.




**CYPRESS GROVE WATER PUMP STATION**  
**MECHANICAL DETAILS**

**PACIFIC ADVANCED CIVIL ENGINEERING**  
 17520 NEWHOPE STREET, SUITE 200  
 FOUNTAIN VALLEY, CA 91781  
 PH (714) 461-7500 FAX (714) 461-7299

SHEET  
**M5**  
 JOB NO. 8138-E

SYMBOL	DESCRIPTION	SYMBOL	DESCRIPTION
<b>P &amp; I DIAGRAM SYMBOLS</b>			
	FIELD MOUNTED INSTRUMENT		VALVE (GENERAL)
	FACE MOUNTED INSTRUMENT ON LOCAL PANEL, OPERATOR ACCESSIBLE		GATE (GENERAL)
	FACE MOUNTED INSTRUMENT ON FIELD PANEL, OPERATOR ACCESSIBLE		SWING CHECK VALVE
	INSTRUMENT MOUNTED IN LOCAL PANEL, OPERATOR INACCESSIBLE		BALL CHECK VALVE
	INSTRUMENT MOUNTED IN FIELD PANEL, OPERATOR INACCESSIBLE		PUMP (GENERAL)
	OPERATION PERFORMED WITH LOGIC OR HARDWIRED DEVICES		BLOWER (GENERAL)
	- REFERENCE ELEMENTARY DWG. #		EQUIPMENT NUMBER
	PLC OR COMPUTER FUNCTION PERFORMING OPERATION WITH VISUAL INDICATION		ELECTRIC SIGNAL
	PLC OR COMPUTER FUNCTION PERFORMING OPERATION WITH VISUAL ALARM INDICATION		LOGIC OR DATA SIGNAL
	PLC OR COMPUTER PERFORMING INTERNAL OPERATION		PNEUMATIC SIGNAL
	PLC OR COMPUTER PERFORMING INTERNAL ALARM OPERATION		CAPILLARY TUBING (FILLED SYSTEM)
	PROPORTIONAL, INTEGRAL, AND DIFFERENTIAL PARAMETERS		HYDRAULIC SIGNAL
	RATIO AND BIAS PARAMETERS		SONIC OR ELECTROMAGNETIC SIGNAL
	AUDIBLE ALARM (BUZZER OR HORN)		ELECTRIC SUPPLY FROM PANELBOARD CKT
	ANNUNCIATOR WINDOW R - ROW # C - COLUMN #		SERVICE AIR
	LAMP INDICATION (STATUS OR ALARM)		INSTRUMENT AIR
	DISCRETE INPUT		BLADDER TANK
	DISCRETE OUTPUT		
	ANALOG INPUT		
	ANALOG OUTPUT		
	JUMP TAG FROM ONE AREA TO ANOTHER AREA OF DRAWING "a" TAG CONNECT POINT ON EACH DRAWING		
	CONTINUED ON DWG I-X		
	AUTODIALER PRIORITY # PC BASED SOFTWARE		

INSTRUMENT IDENTIFICATION LETTERS				
FIRST - LETTER (F)		SUCCEEDING - LETTERS (SS)		
MEASURED OF INITIATING VARIABLE	MODIFIER	READOUT PASSIVE FUNCTION	OUTPUT FUNCTION	MODIFIER
A ANALYSIS		ALARM		
B BURNER COMBUSTION		USER'S CHOICE	USER'S CHOICE	USER'S CHOICE
C CONDUCTIVITY			CONTROLLER	
D DENSITY	DIFFERENTIAL			
E VOLTAGE		SENSOR, PRIMARY ELEMENT		
F FLOW RATE	RATIO (FRACTION)			
G GENERAL		GLASS VIEWING DEVICE		
H HAND				HIGH, OPENED
I CURRENT (ELEC.)		INDICATING, INDICATOR		
J POWER	SCAN			
K TIME, TIME SCHEDULE	TIME RATE OF CHANGE		CONTROL STATION	
L LEVEL		LIGHT		LOW, CLOSED
M MOISTURE	MOMENTARY			MIDDLE
N STATUS		STATUS ORIFICE, RESTRICTION	USER'S CHOICE	USER'S CHOICE
O OPERATOR		POINT (TEST) CONNECTION		
P PRESSURE, VACUUM				
Q QUANTITY	INTERGRATE, TOTALIZE			
R RESET		RECORD		
S SPEED, FREQUENCY	SAFETY		SWITCH	
T TEMPERATURE			TRANSMITTER	TEST
U MULTIVARIABLE		MULTIFUNCTION	MULTIFUNCTION	MULTIFUNCTION
V VIBRATION, MECH. ANALYSIS			VALVE, DAMPER LOUVER	
W WEIGHT, FORCE		WELL		
X SWITCH	X AXIS	UNCLASSIFIED	UNCLASSIFIED	UNCLASSIFIED
Y EVENT, STATE OR PRESENCE	Y AXIS		RELAY, COMPUTER, CONVERTOR	
Z POSITION DIMENSION	Z AXIS		DRIVER, ACTUATOR, UNCLASSIFIED FINAL CONTROL ELEMENT	

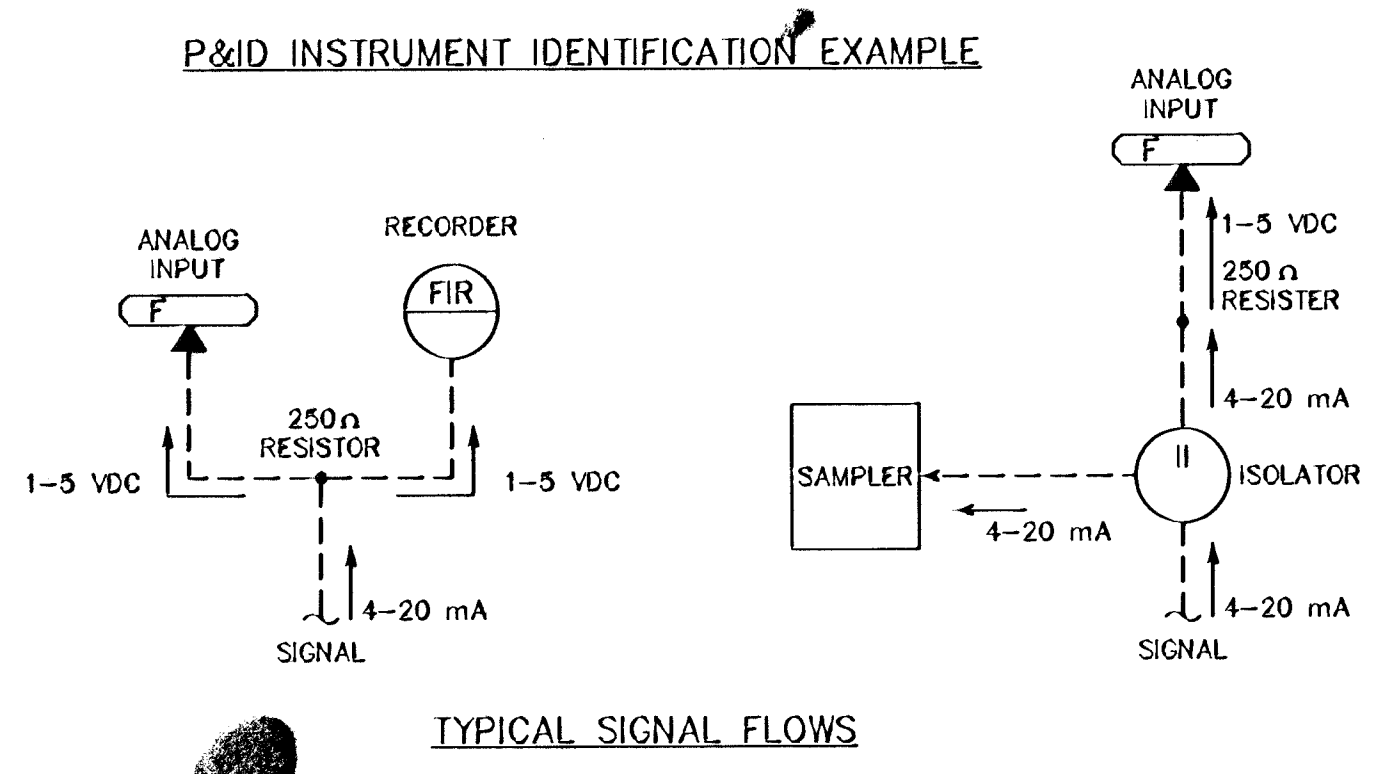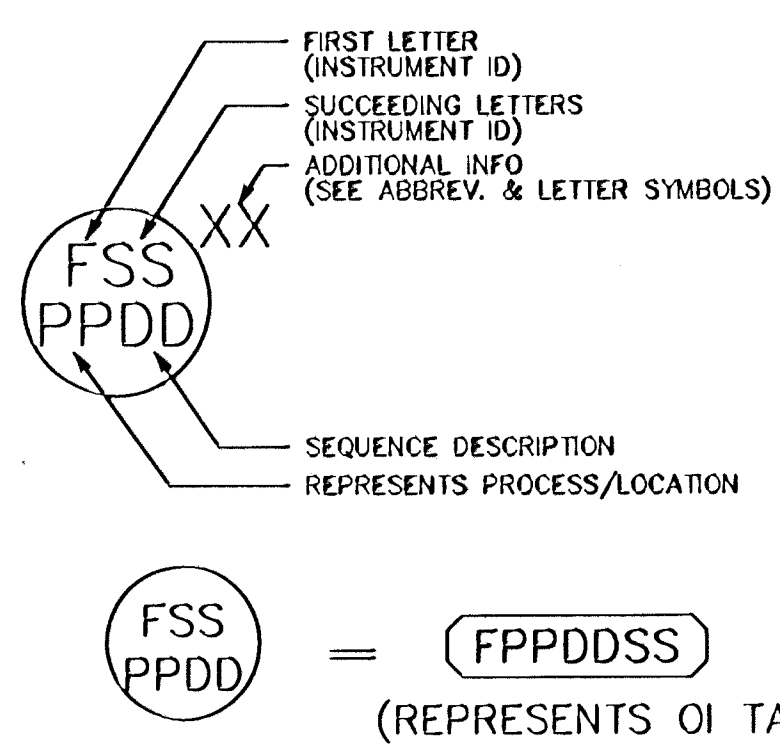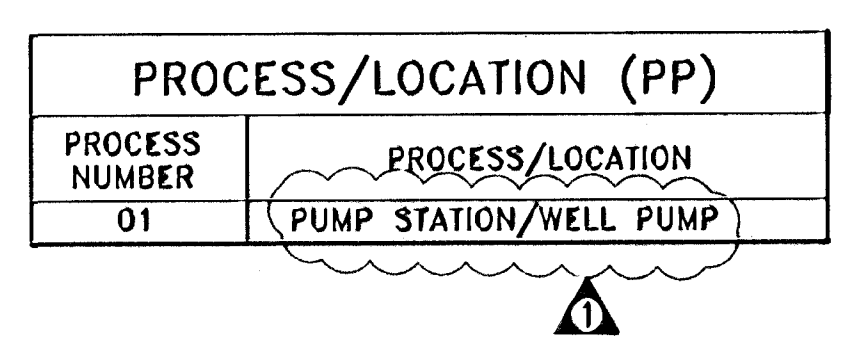

**INSTRUMENTATION ABBREVIATIONS:**

A AMPERE	MCL MILLIGRAMS PER LITER
AI ANALOG INPUT	MH MANHOLE
AIC AMPS INTERRUPTING CAPACITY	MTU MASTER TELEMETRY UNIT
AO ANALOG OUTPUT	NPW NON-POTABLE WATER
AS AIR SUPPLY	NS NITROGEN SUPPLY
ATS AUTOMATIC TRANSFER SWITCH	NTU TURBIDITY
AUTO AUTOMATIC	OCA OPEN-CLOSE-AUTO
CB CIRCUIT BREAKER	OCR OPEN-CLOSE-REMOTE
CL2 CHLORINE	OIT OPERATOR INTERFACE TERMINAL
CON CONTRACTOR	OL OVERLOAD
CU COPPER, BARE	OO ON/OFF (MAINTAINED)
CV CONTROL VALVE	OOA ON-OFF-AUTO
DCS DISTRIBUTED CONTROL SYSTEM	OOR ON-OFF-REMOTE
DI DISCRETE INPUT	OSC OPEN-STOP-CLOSE
DO DISSOLVED OXYGEN	PER PERMISSIVE
DWG DRAWING	PLC PROGRAMMABLE LOGIC CONTROLLER
ETM ELAPSED TIME METER	PNL PANEL
EOL ELECTRONIC OVERLOAD	PO PULSE OUTPUT
EXIST EXISTING	PPG POUNDS PER GALLON
FA FOUL AIR	PPH POUNDS PER HOUR
FC FAIL CLOSED	PPM PARTS PER MILLION
FE FINAL EFFLUENT	PR PAIR
FR FORWARD-REVERSE	PRES PRESSURE
FS FLOAT SWITCH/FULL SPEED	PS PRESSURE SWITCH
FW FINISHED WATER	PSI POUNDS PER SQUARE INCH
GND GROUND	PV PROCESS VARIABLE
GPD GALLONS PER DAY	R RELAY (INTRINSIC)
GPH GALLONS PER HOUR	RAS RETURN ACTIVATED SLUDGE
GPM GALLONS PER MINUTE	RAW RAW WATER
H, HI HIGH	REM REMOTE
H2S HYDROGEN SULFIDE	RF RADIO FREQUENCY
HMI HUMAN MACHINE INTERFACE	RIO REMOTE INPUT OUTPUT
HOA HAND-OFF-AUTO	RS RAW SEWAGE
HOR HAND-OFF-REMOTE	RSP RAW SEWAGE PUMP
I CURRENT	RST RESET
IO INPUT/OUTPUT	RTU REMOTE TELEMETRY UNIT
IOE INTERNAL-OFF-EXTERNAL	SEQ SERVICE ENTRANCE EQUIPMENT
JB JUNCTION BOX	SES SERVICE ENTRANCE SECTION
L, LO LOW	SIC SINGLE LOOP CONTROLLER
LAN LOCAL AREA NETWORK	SLOS START-LOCK-OFF-STOP
LC LOOP CONTROLLER	SO2 SULFUR D
LCP LOCAL CONTROL PANEL	SP SET POINT
LOS LOCK-OFF-STOP	SPD SPEED
LR LOCAL/REMOTE	SPR SPARE
LS LEVEL (i.e., FLOAT) SWITCH	SS START/STOP (MAINTAINED)
M MOTOR	SSS SOLID STATE STARTER (SOFT START)
MA MANUAL/AUTO, MILLIAMP	TS TEMPERATURE SWITCH
MC MANUFACTURE CABLE	UG UNDERGROUND
MCC MOTOR CONTROL CENTER	V VOLT
MCP MOTOR CIRCUIT PROTECTOR	VFD VARIABLE FREQUENCY DRIVE
MFR(S) MANUFACTURER(S)	W WATT, WIRE
MGD MILLION GALLONS PER DAY	WAS WASTE ACTIVATED SLUDGE
	ZS POSITION (i.e., LIMIT) SWITCH

**RECORD DRAWINGS**

**CYPRESS GROVE WATER PUMP STATION INDEX**

**PACIFIC ADVANCED CIVIL ENGINEERING**

17488 HUNTER VALLEY, CA 94705  
 17488 HUNTER VALLEY, CA 94705  
 PH (714) 481-7300 FAX (714) 481-7299

DC	4/26/05	PER CITY COMMENTS	
NO	BY DATE	REVISIONS	DATE APP.

PREPARED BY: ANDREW T. KOMOR  
 PROJECT ENGINEER  
 R.C.E. NO. - # C 84526  
 EXP. 6/30/07  
 SCALE: 1/4" = 1'  
 ISSUED: J.L.M.  
 CHECKED: A.K.  
 DATE: APR 2005

SHEET **10**

JOB NO. 8138-E



P:\8138E\Engineering\8138-10\Sheets\8138-10-SHEET-0.dwg - Tab: LAYOUT1 By: gspilston on May 04, 2005 at 03:22 PM










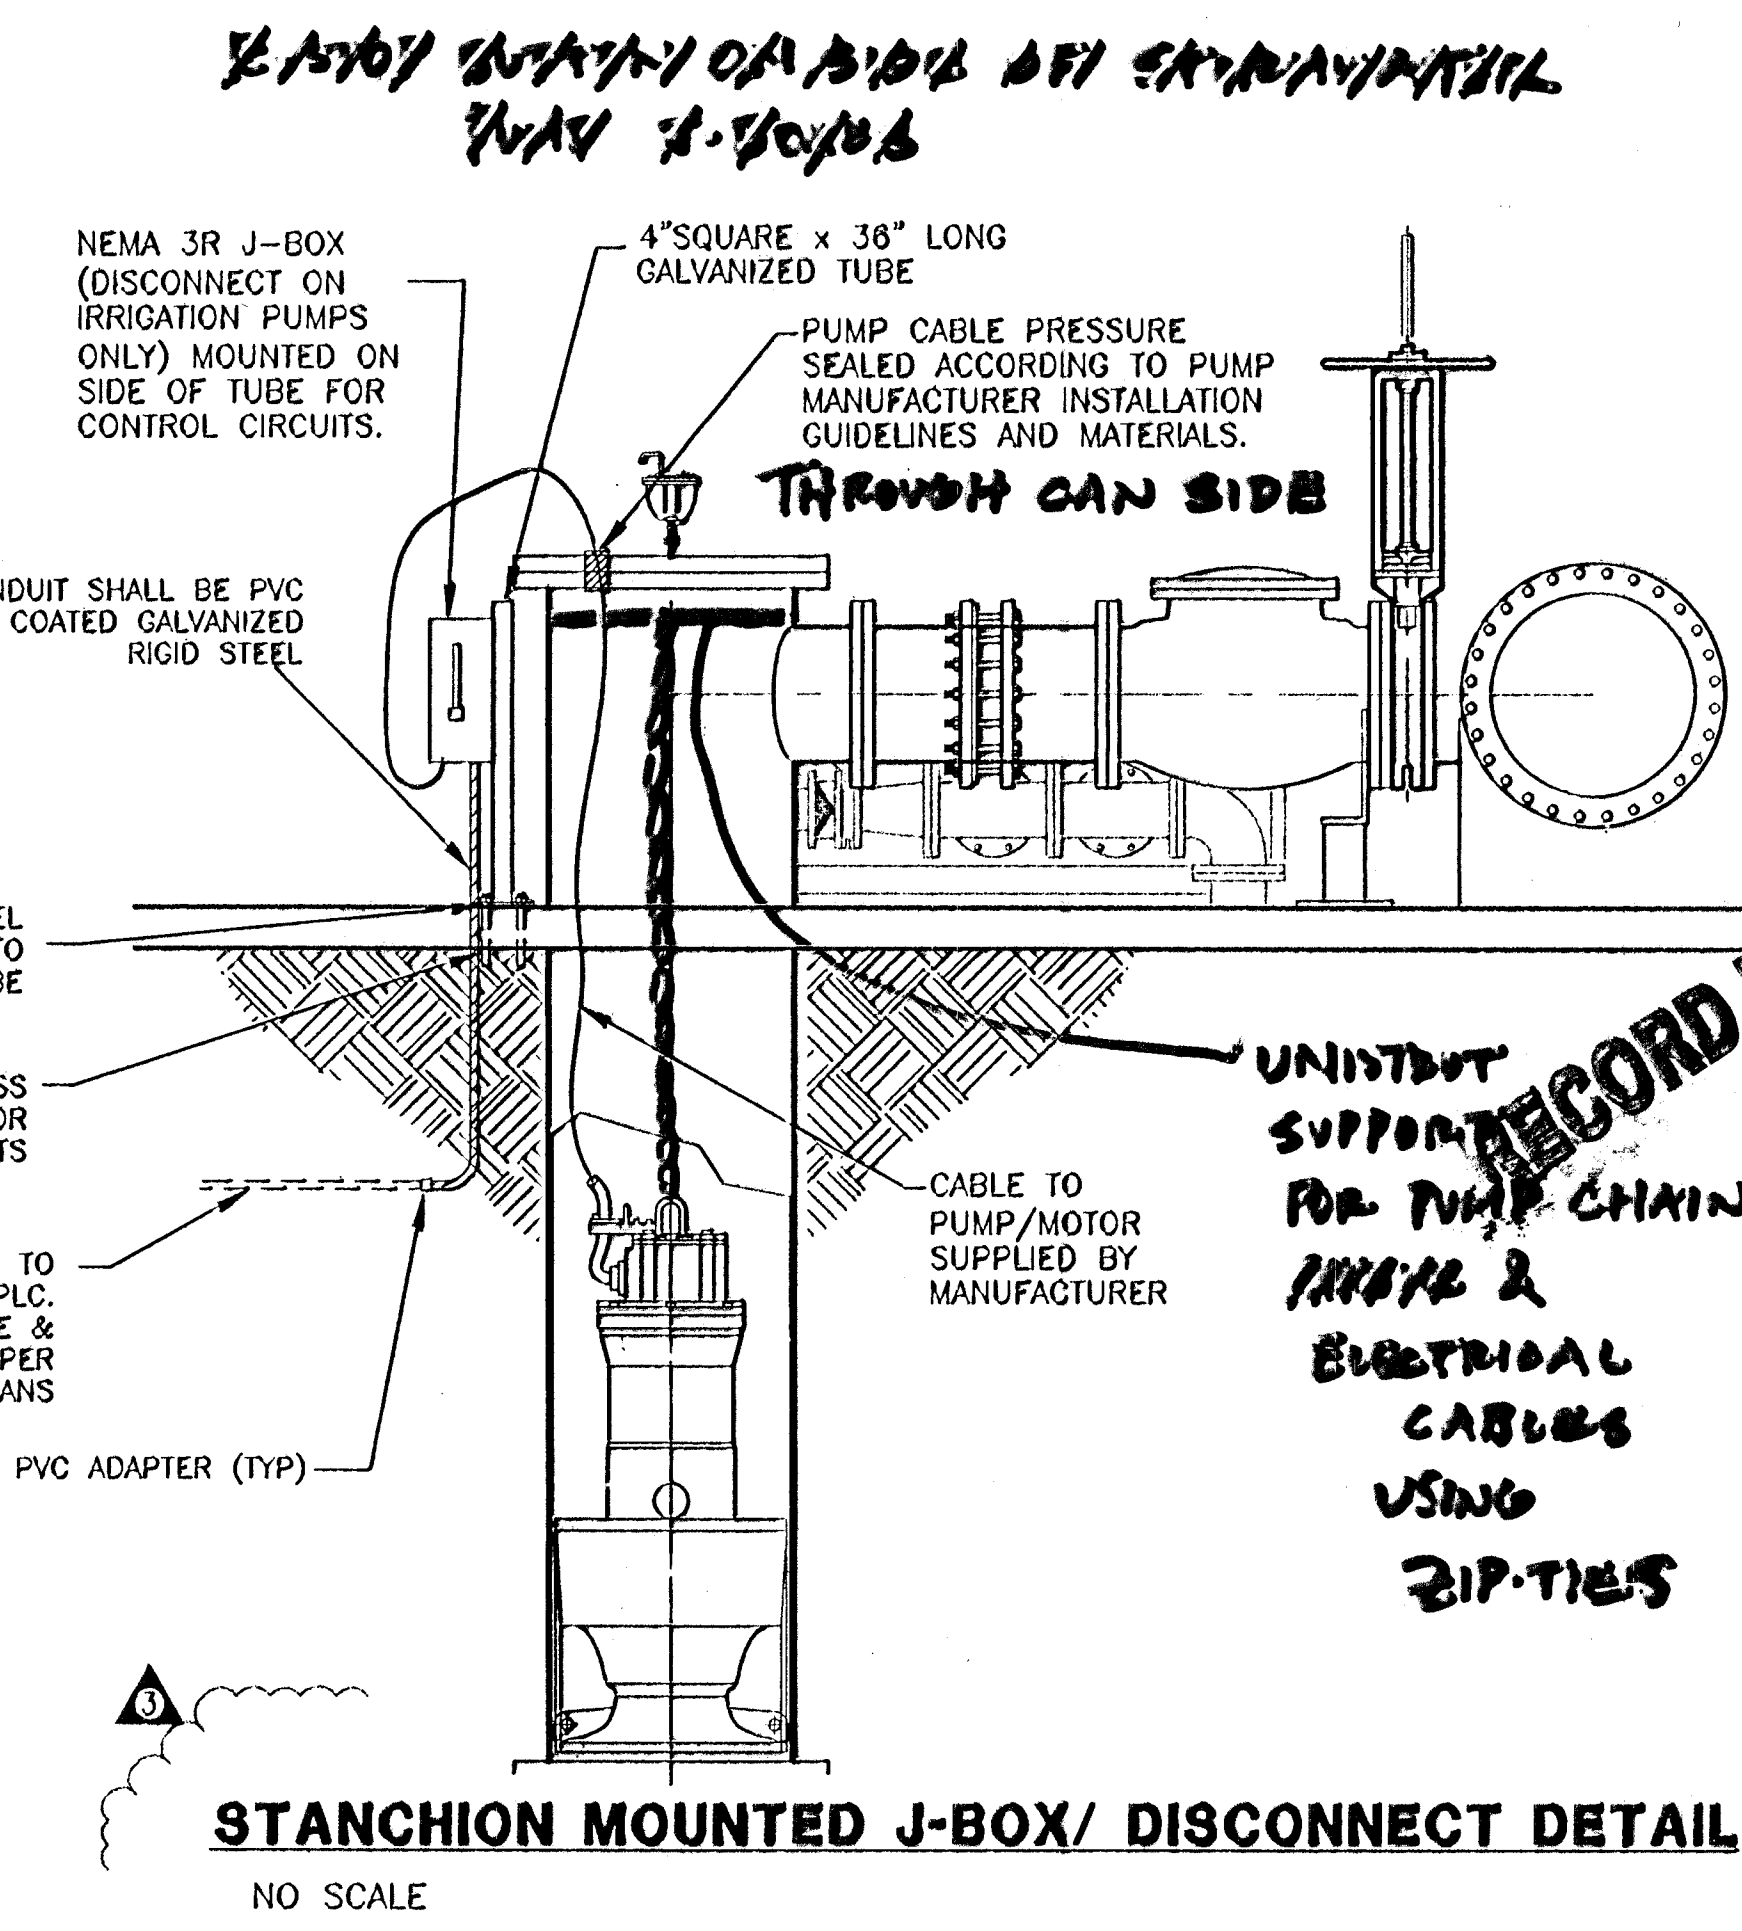
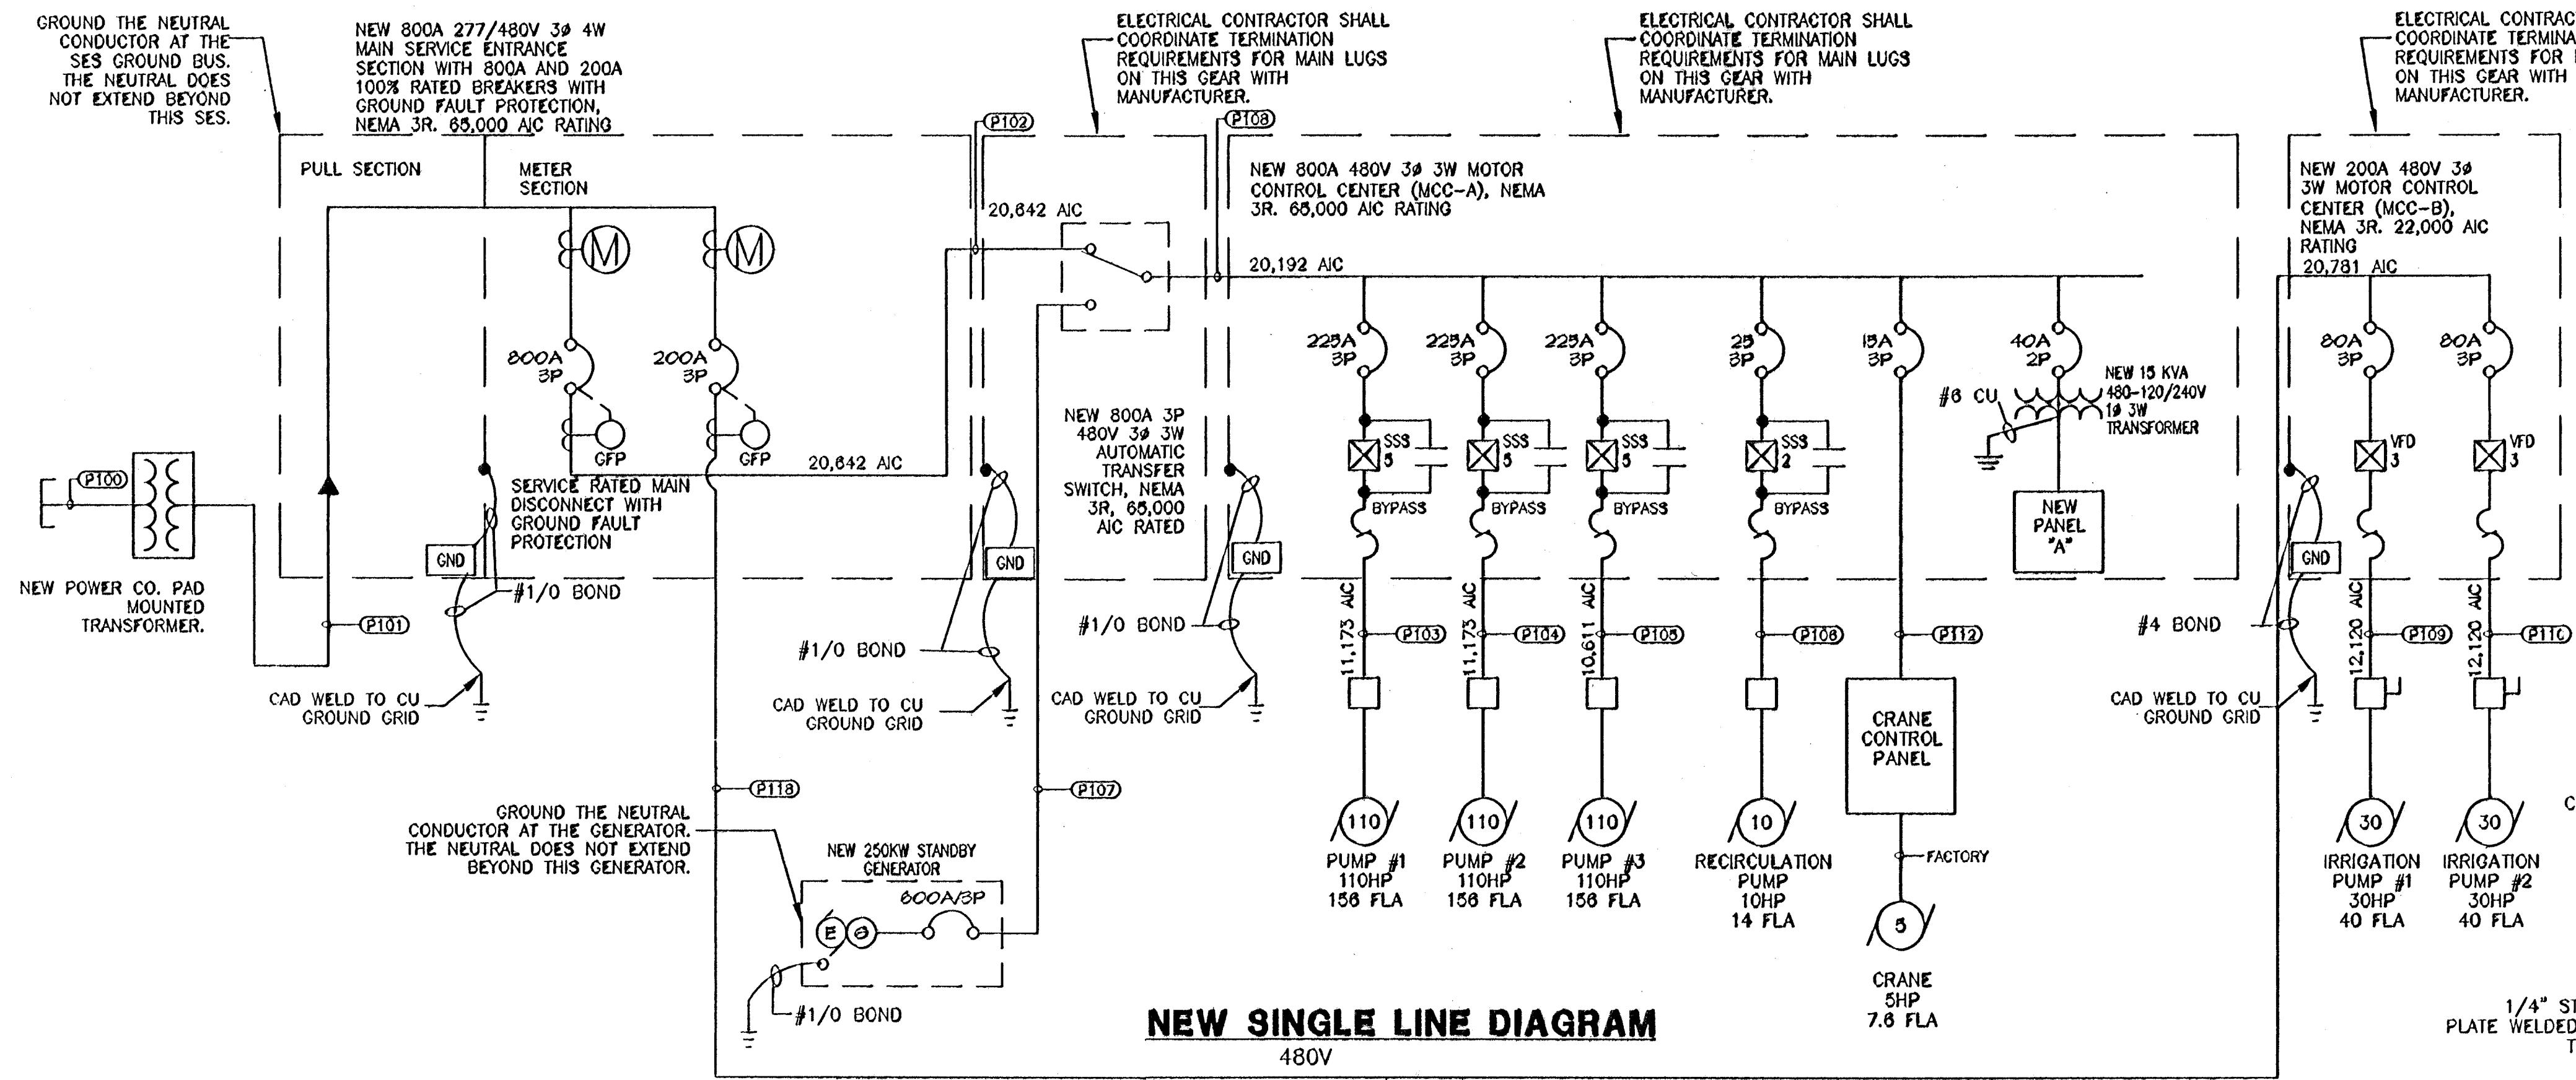


**NEW MCC-A LOAD CALC**

	CONNECTED	REDUNDANT
STORMWATER PUMP #1 (110HP)	156.0 AMPS	156.0 AMPS
STORMWATER PUMP #2 (110HP)	156.0 AMPS	156.0 AMPS
STORMWATER PUMP #3 (110HP)	156.0 AMPS	AMPS
RECIRCULATION PUMP (10HP)	10.0 AMPS	AMPS
CRANE (5HP)	7.6 AMPS	7.6 AMPS
PANEL "A" (MAX LOAD)	31.0 AMPS	31.0 AMPS
<b>TOTAL</b>	<b>516.6 AMPS</b>	<b>350.6 AMPS</b>
25% LARGEST MOTOR LOAD	39.0 AMPS	39.0 AMPS
<b>GRAND TOTAL</b>	<b>555.6 AMPS</b>	<b>389.6 AMPS</b>

**NEW MCC-B LOAD CALC**

	CONNECTED	REDUNDANT
IRRIGATION PUMP #1 (30HP)	40.0 AMPS	40.0 AMPS
IRRIGATION PUMP #2 (30HP)	40.0 AMPS	40.0 AMPS
<b>TOTAL</b>	<b>80.0 AMPS</b>	<b>80.0 AMPS</b>
25% LARGEST MOTOR LOAD	10.0 AMPS	10.0 AMPS
<b>GRAND TOTAL</b>	<b>90.0 AMPS</b>	<b>90.0 AMPS</b>

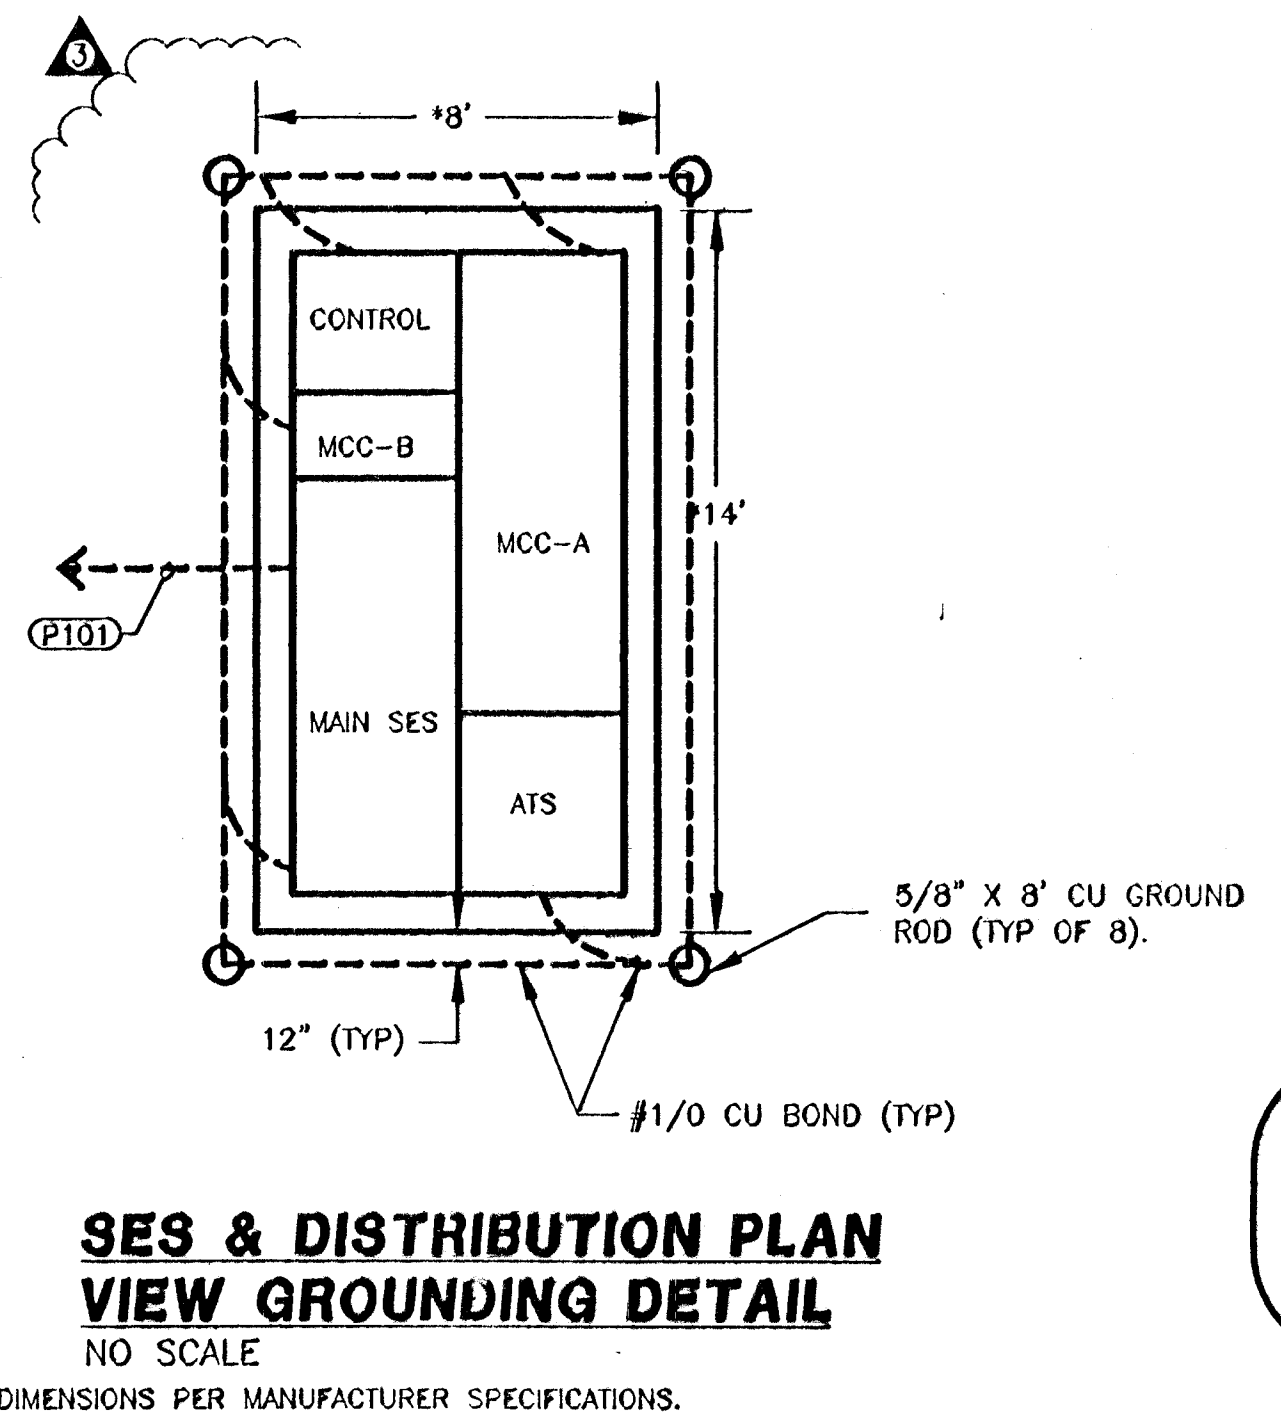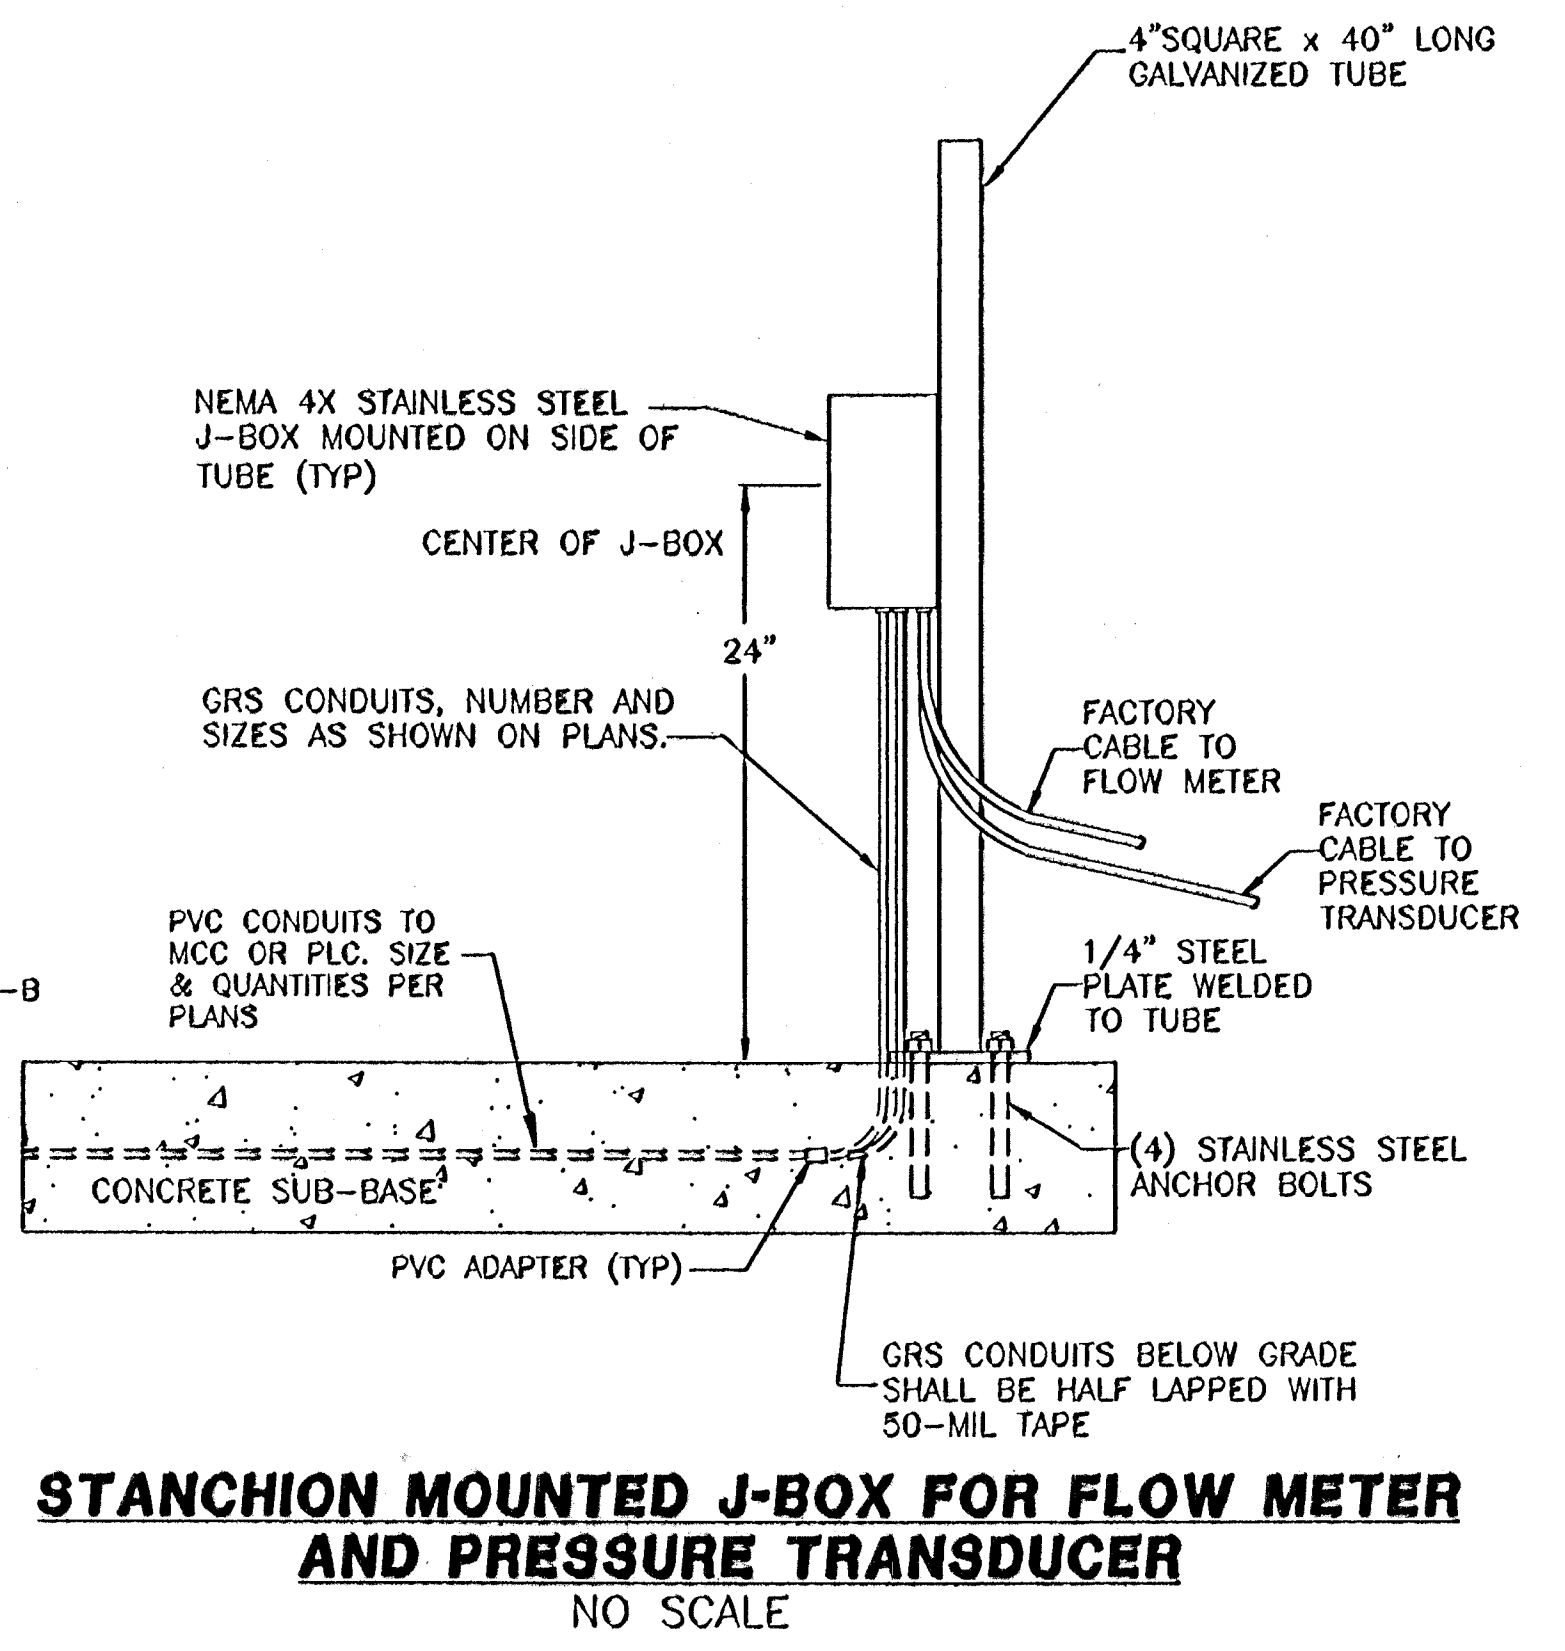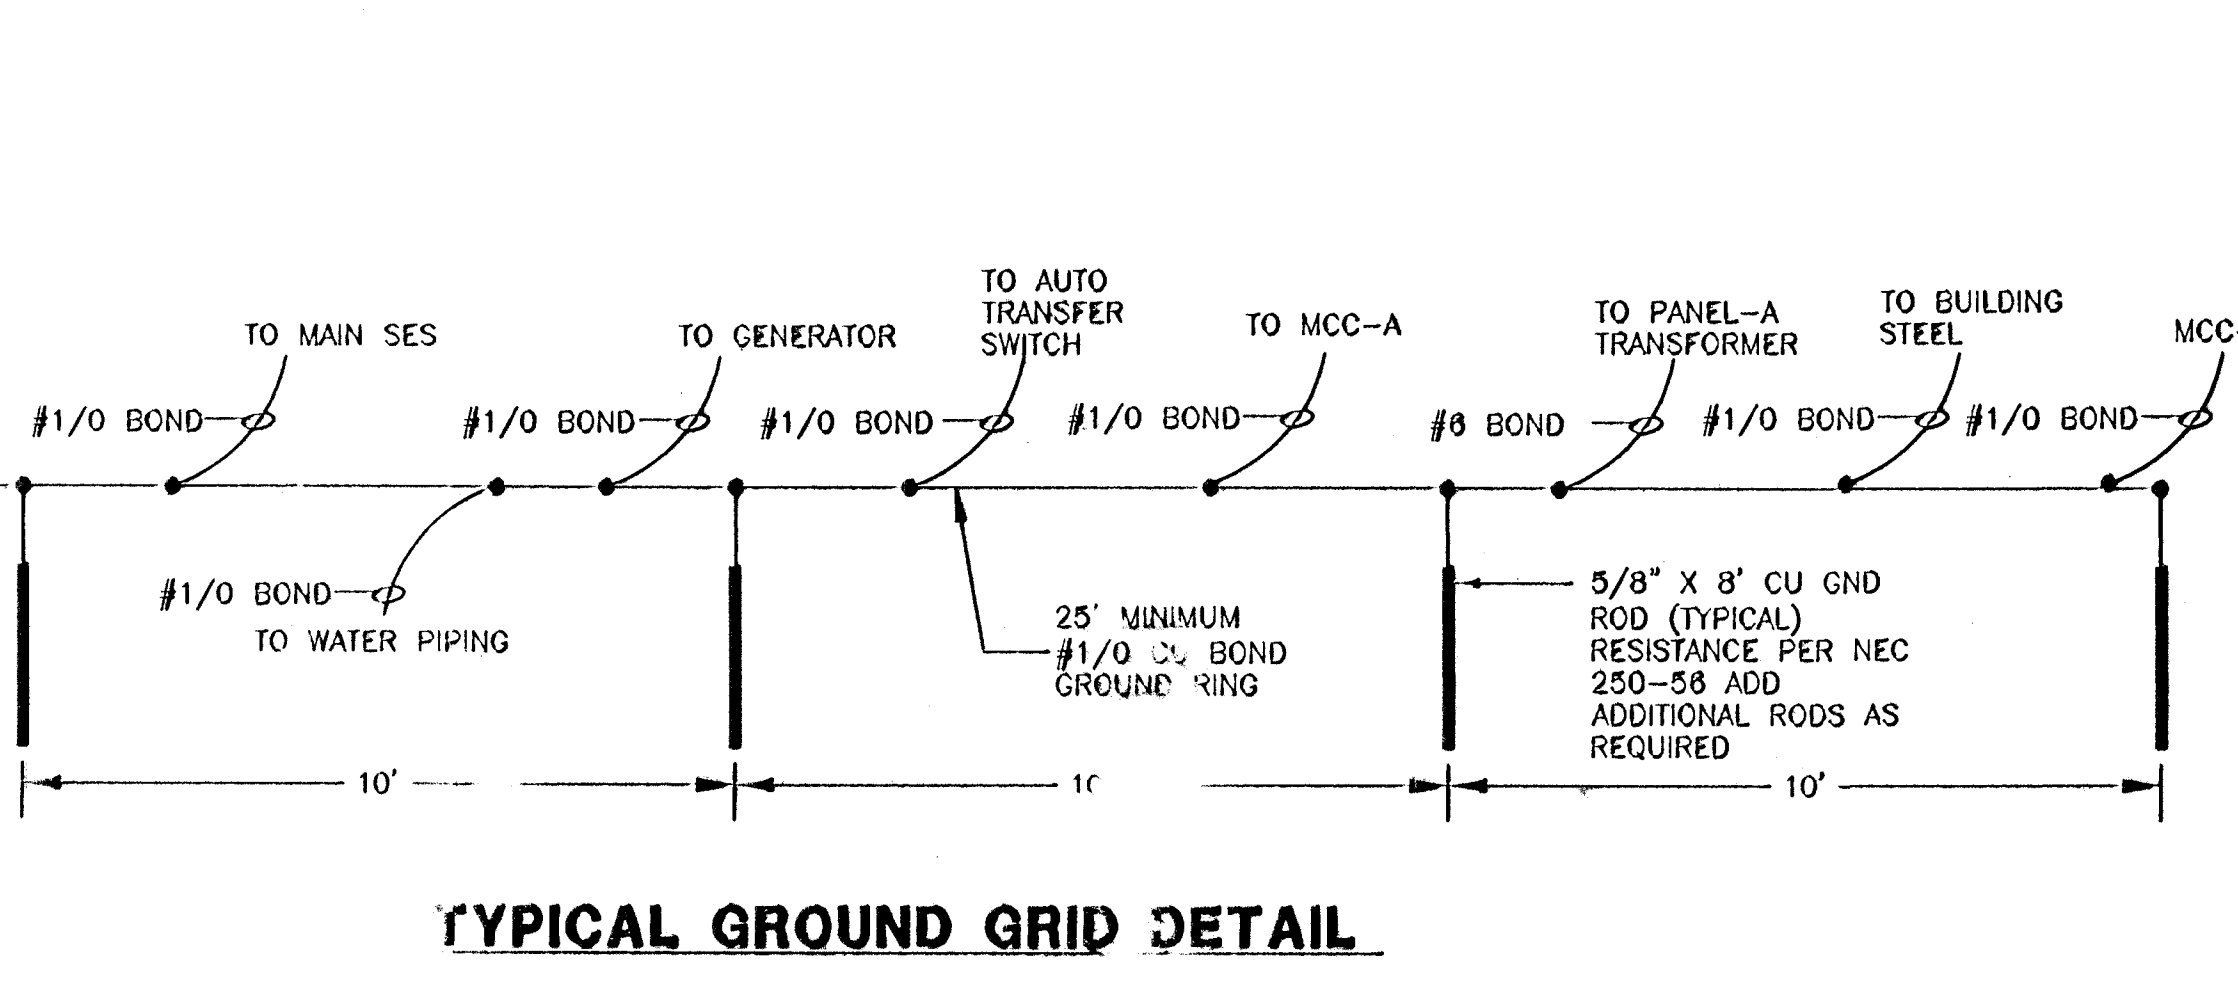


NO.	BY DATE	REVISIONS	DATE	APP.
1				
2				
3				
4				



DESIGNED BY R.S.W.	CHECKED BY R.S.W.	DATE 10/01/05
DRAWN BY E.D.H.	SCALE	
PROJECT ENGINEER R.S.W.	EXP. 8/22/2005	

CYPRESS GROVE  
 STORM WATER PUMP  
 STATION  
 ELECTRICAL PLANS  
 SINGLE LINE

**PACIFIC ADVANCED CIVIL ENGINEERING**  
 1700 N. WILSON STREET, SUITE 200  
 CHANDLER, ARIZONA 85225  
 PH (714) 481-7290 FAX (714) 481-7299

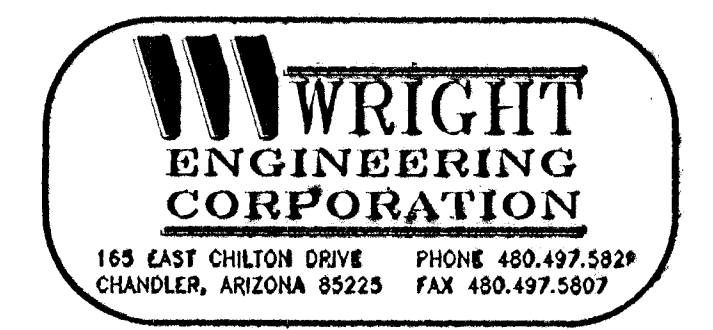

SHEET  
**E1.1**  
 JOB NO. 8072-E

Arx: 8072-10-Tbl-001g MEC-TBL-INFO.dwg  
 Date: 10/01/05 11:10:00 AM  
 User: RSW  
 Plot: 10/01/05 11:10:00 AM  
 Plot Device: HPGL2  
 Plot Scale: 1.0000  
 Plot Orientation: Landscape  
 Plot Color: Black  
 Plot Lineweight: 0.0020  
 Plot Linetype: Solid  
 Plot Font: Arial, 10  
 Plot Title: 8072-10-Tbl-001g MEC-TBL-INFO.dwg  
 Plot Sheet: 1 of 1  
 Plot Date: 10/01/05 11:10:00 AM  
 Plot User: RSW


WRIGHT ENGINEERING CORPORATION - 165 EAST CHILTON DRIVE, CHANDLER, ARIZONA 85225 - TEL: 480.497.5939







RTU AIR CONDITIONING UNIT CAPABLE OF MAINTAINING 90° F IN 113° F AMBIENT.

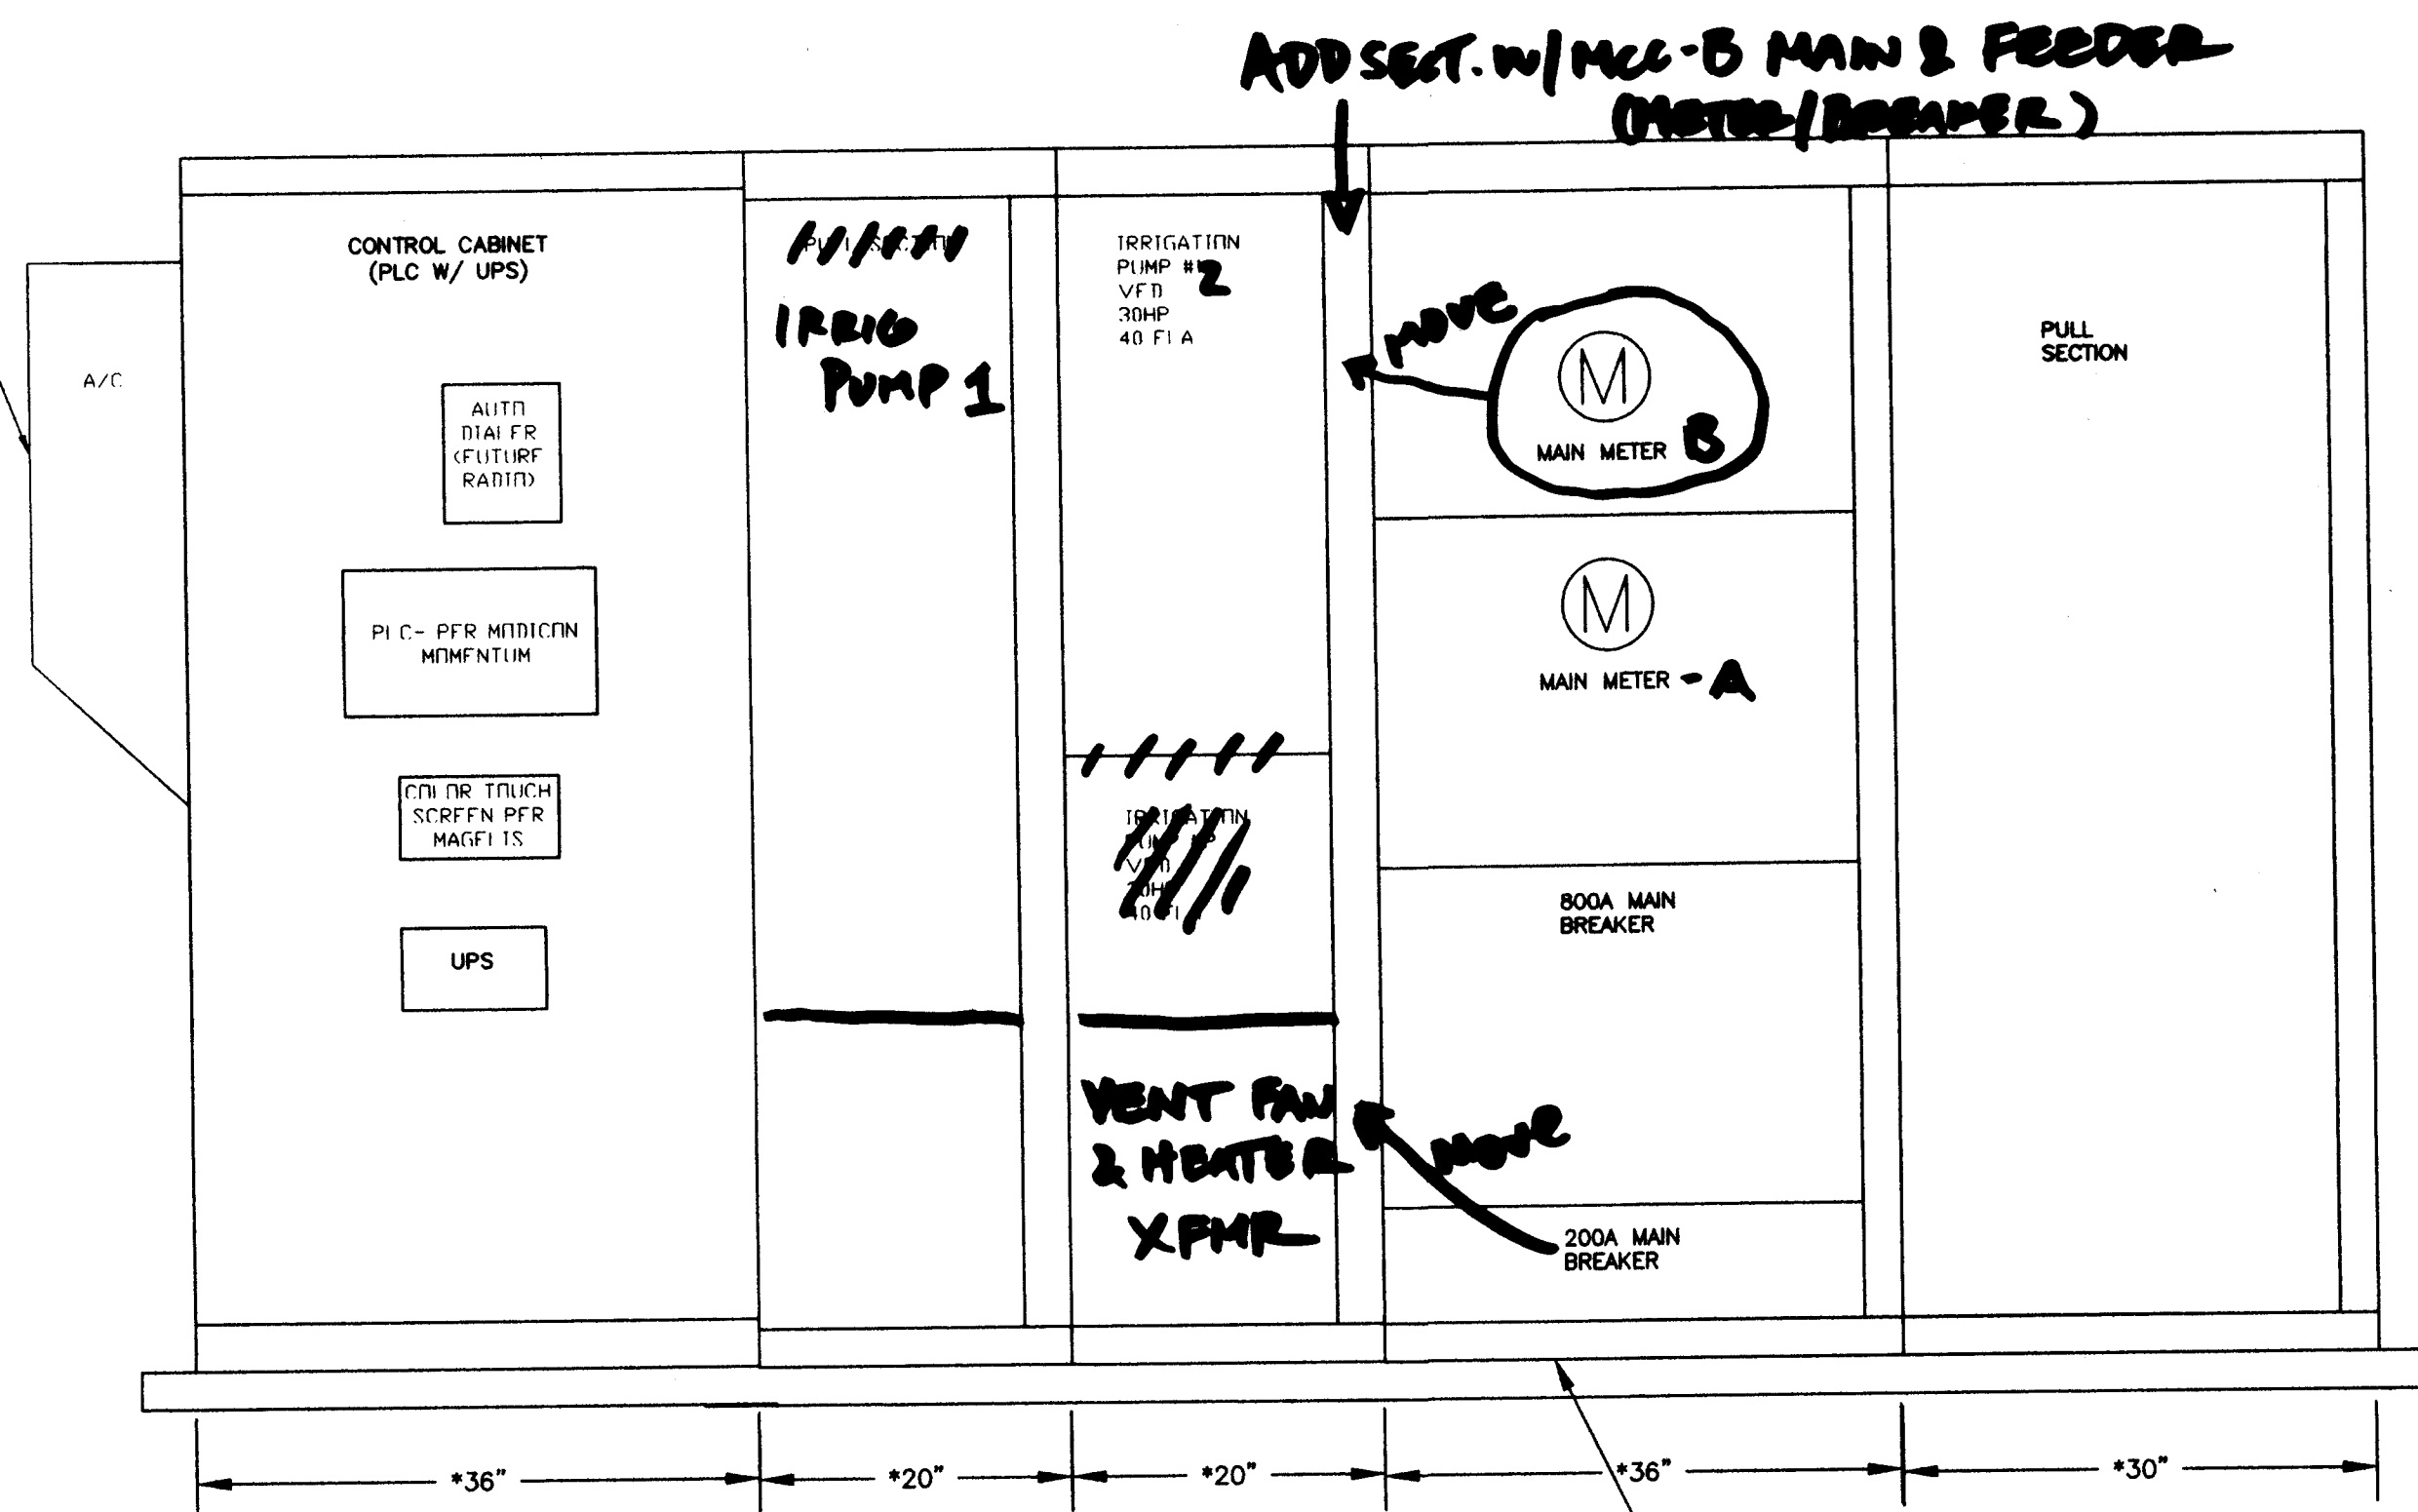


**NORTH MCC-B ELEVATION DETAIL**

\* CONFIRM ACTUAL SIZE WITH MANUFACTURER PRIOR TO CONSTRUCTION.

**NEW MAIN SES**

\* CONFIRM ACTUAL SIZE WITH MANUFACTURER PRIOR TO CONSTRUCTION.

MAIN SES SHALL CONFORM TO CURRENT PG&E STANDARDS

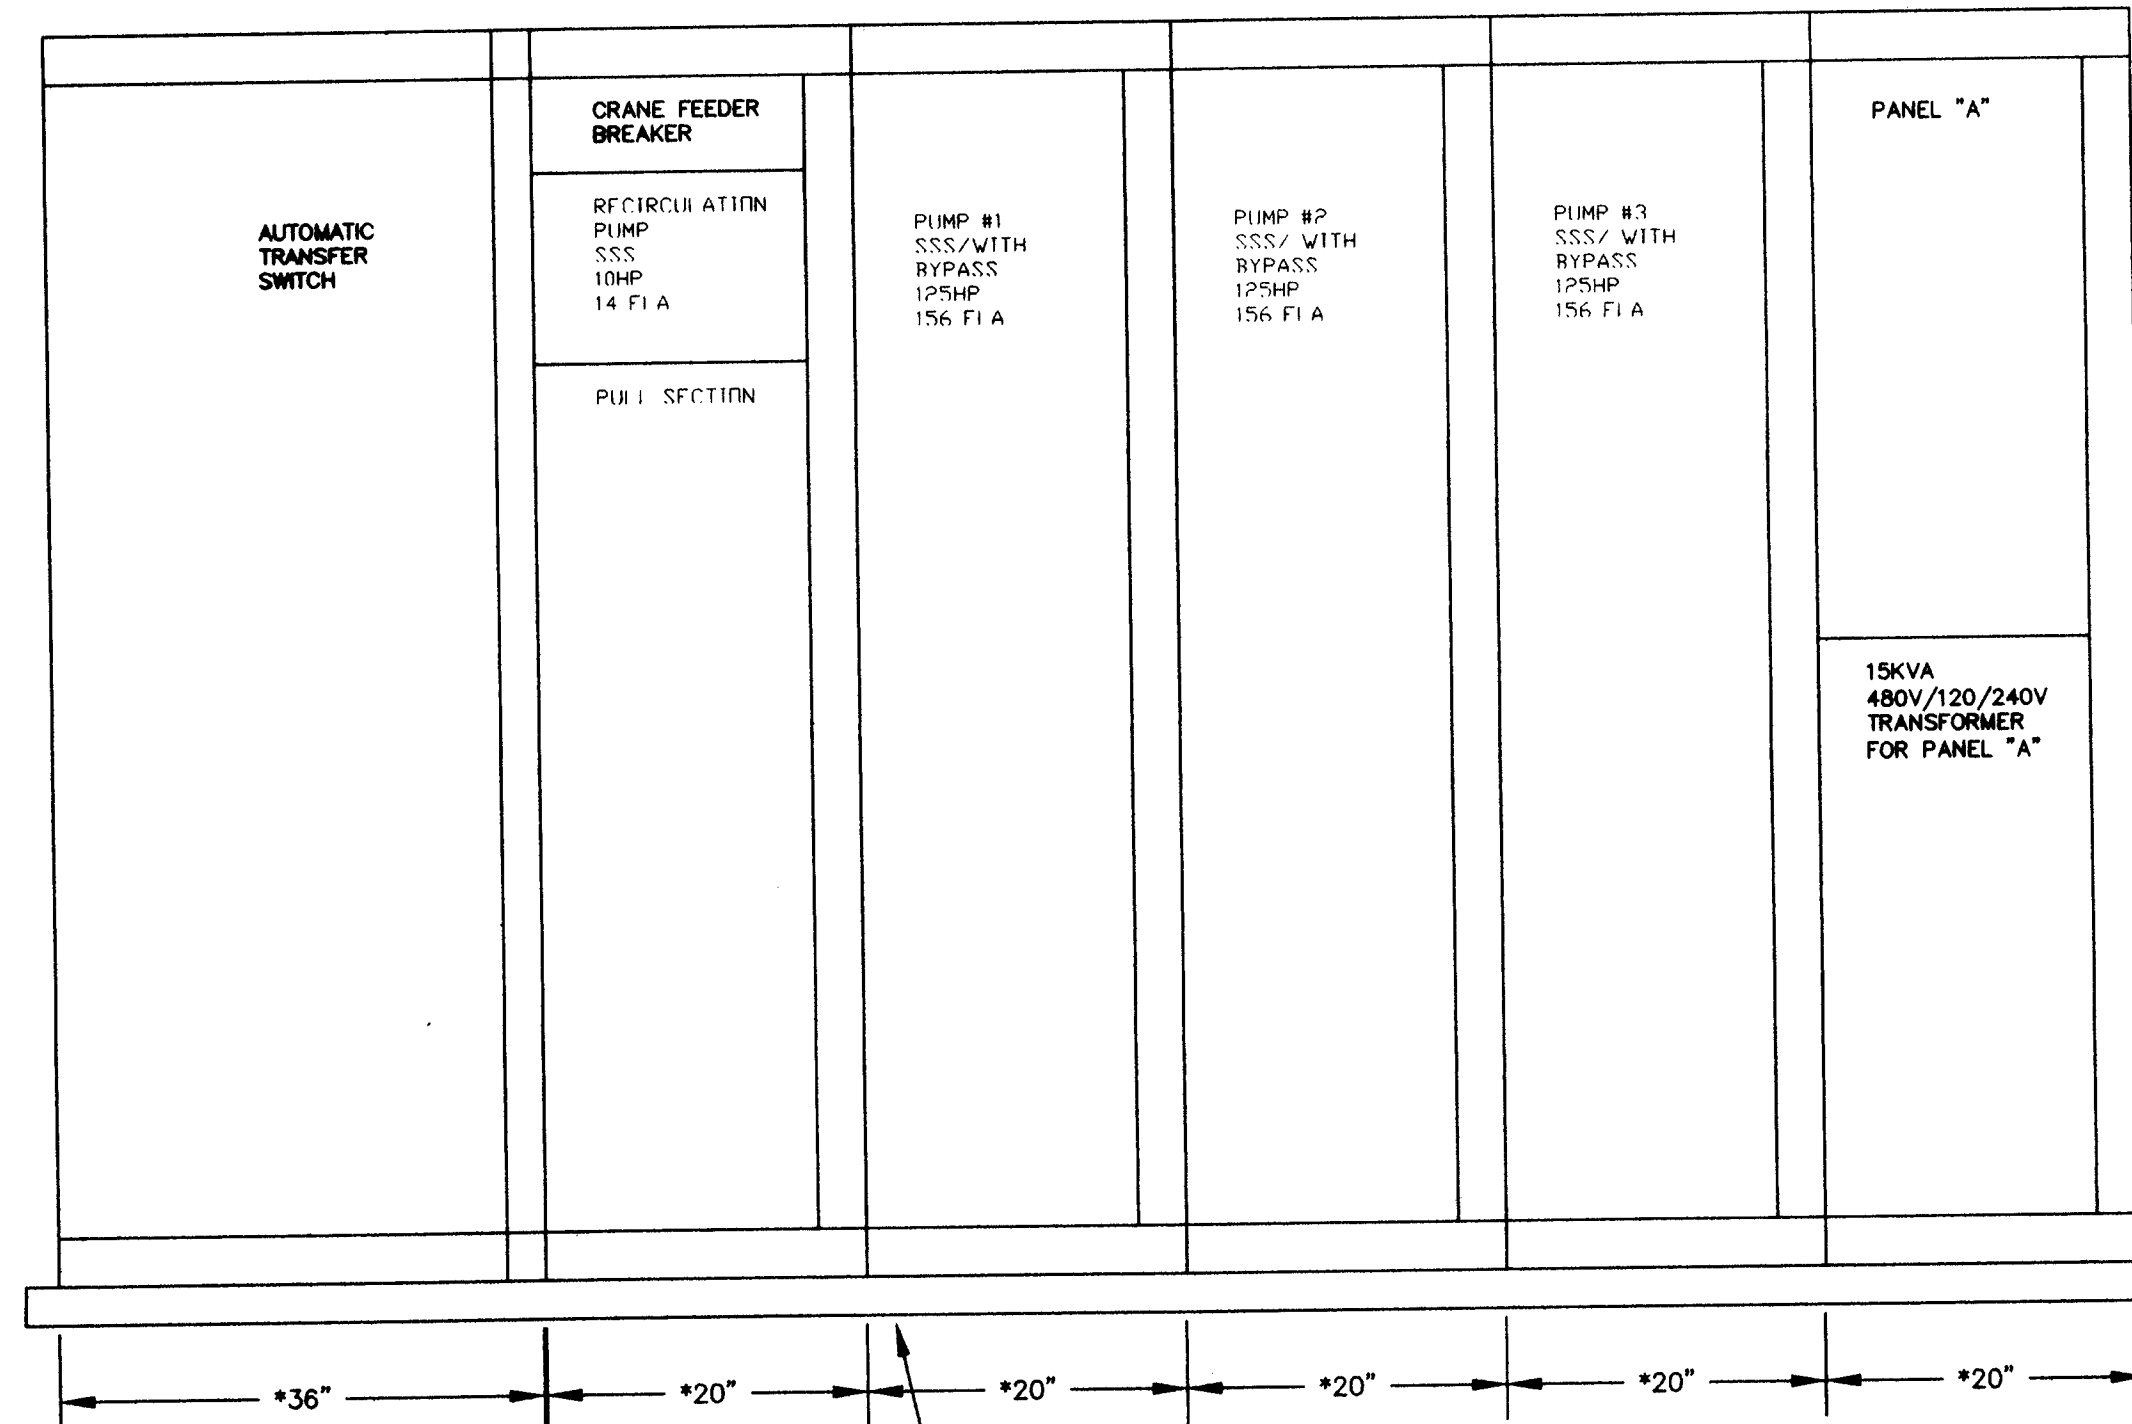

**SOUTH MCC-A ELEVATION DETAIL**

\* CONFIRM ACTUAL SIZE WITH MANUFACTURER PRIOR TO CONSTRUCTION.

EXTEND 6" THICK 2500PSI CONCRETE PAD 36" IN FRONT OF ELECTRICAL EQUIPMENT AND 6" ON SIDES AND BACK. CONFIRM ACTUAL DIMENSIONS AND REINFORCEMENT WITH GEAR MANUFACTURER PRIOR TO INSTALLATION.

PANEL A	TYPE: BOLT ON				100 AMP MAIN BKR			
120/240V 1φ 3W	PANEL MOUNTED				NEMA 1			
CIRCUIT DESCRIPTION	BKR SIZE	CIR NO.	LOAD	CIR NO.	BKR SIZE	CIR DESCRIPTION	BKR SIZE	CIR DESCRIPTION
AREA LIGHTING*	20/1	1	262	2	2	SPACE		
GFI RECEPTACLES	20/1	3		600	20/1	PLC/UPS		
OVERHEAD LIGHTS*	20/1	5	480	600	20/1	A/C UNIT FOR CONTROL		
GENERATOR CONTROL/BATTERY	20/1	7		400	8	"		
GENERATOR BLOCK HEATER	20/1	9	828	480	10	AIR COMPRESSOR 2		
"	/2	11		480	12	"		
AIR COMPRESSOR 1		13	828		14	SPACE		
"		15		828	16	SPACE		
SPACE		17			18	SPACE		
SPACE		19			20	SPACE		
SPACE		21			22	SPACE		
SPACE		23			24	SPACE		
CODE TOTAL VA			3478	3936		*INDICATES LOAD @ 125%		
CODE TOTAL AMPS			29.0	32.8		22,000 AIC BREAKERS		

**CONDUIT AND WIRE SCHEDULE**

CONDUIT NO.	SIZE	WIRE		FROM	TO	REMARKS
		POWER	CONTROL			
P100	2-5"	WIRE BY POWER CO.		POWER CO. TRANSFORMER	MAIN SES PULL SECTION	
P101	4-2"	4-#3/0 ea.	1-#1/0 ea.	MAIN SES	AUTO TRANSFER SWITCH	
P102	1.5"	3-#2/0	#6	MCC	STORMWATER PUMP #1	
P103	1.5"	3-#2/0	#6	MCC	STORMWATER PUMP #2	
P104	1.5"	3-#2/0	#6	MCC	STORMWATER PUMP #3	
P105	1.5"	3-#2/0	#6	MCC	RECIRCULATION PUMP	
P106	1/2"	3-#10	#10	MCC	STANDBY GENERATOR	
P107	4-2"	4-#3/0 ea.	1-#1/0 ea.	AUTO TRANSFER SWITCH	AUTO TRANSFER SWITCH	
P108	4-2"	4-#3/0 ea.	1-#1/0 ea.	AUTO TRANSFER SWITCH	MCC	
P109	1"	3-#8	#10	MCC-B	IRRIGATION PUMP #1	
P110	1"	3-#8	#10	MCC-B	IRRIGATION PUMP #2	
P111	1"	3-#12	#12	PANEL A (10,12)(13,15)	AIR COMPRESSOR (TYPICAL)	
P112	1"	3-#10	#12	MCC	CRANE (VIA CRANE CONTROL PANEL)	
P113						
P114	1"	2-#12	#12	PANEL A-5	CANOPY LIGHTS	
P115	1"	2-#12	#12	PANEL A-1	AREA LIGHTS	
P116	1"	2-#12	#12	PANEL A-3	GENERAL USE RECEPTACLES	
P117	1"	2-#14	#14	MCC	FLOW METER J-BOX	FOR FLOW METER TOTAL FOR FLOW METER POWER
P118	2"	3-#3/0	#4	MAIN SES	MCC-B	
C101	3/4"		#12	FACTORY CABLE	PLC	
C102			#12	40-#14	PLC	LOCATED IN MCC WIREWAY
C103	3/4"		#12	4-#14	MCC	STORMWATER PUMP #1
C104	3/4"		#12	4-#14	MCC	STORMWATER PUMP #2
C105	3/4"		#12	4-#14	MCC	STORMWATER PUMP #3
C106	3/4"		#12	4-#14	MCC	RECIRCULATION PUMP
C107	3/4"		#18	TWISTED SHIELDED PAIR	MCC	LEVEL TRANSDUCER
	3/4"		6-#14		MCC	LEVEL SWITCHES J-BOX
C108	3/4"		#14	2-#14	MCC	INTRUSION ALARM
C109	3/4"		#18	TWISTED SHIELDED PAIR	MCC	PRESSURE TRANSDUCER/ FLOW METER J-BOX
	3/4"		#18	TWISTED SHIELDED PAIR	MCC	FOR PRESSURE TRANSDUCER
C112	1"		4-#14	1-#14 GND	MCC	GENERATOR

**RECORD DRAWINGS**

DATE: 9-09

PREPARED BY: RONALD S. WRIGHT  
PROJECT ENGINEER  
R.S.E. NO. -- # 013216  
EXP. 9/30/2005

SCALE: AS SHOWN

DATE: May, 2005

**CYPRESS GROVE STORM WATER PUMP STATION ELECTRICAL PLANS DETAILS**

**PACIFIC ADVANCED CIVIL ENGINEERING**  
17520 NEWHOPE STREET, SUITE 200  
PH (714) 481-7300 FAX (714) 481-7299


**WRIGHT ENGINEERING CORPORATION**  
165 EAST CHILTON DRIVE CHANDLER, ARIZONA 85225 PHONE 480.487.5829 FAX 480.487.5807

WEC JOB# 04410


SHEET **E1.3**  
JOB NO. 8072-E

Notes: MCC-B-TBL-INFO.dwg, 8/27/10-Talk.dwg  
Dwgcode = 1; Liscode = 1; Pstcode = 1; Acad Ver. = 16.0s (LMS Tech); Version = 1


Wright\11 - CYPRESS GROVE\E1.3 ELECTRICAL DETAILS.dwg - Tab: Layout1 By: Joshua Carroll on May 03, 2005 at 01:09 PM

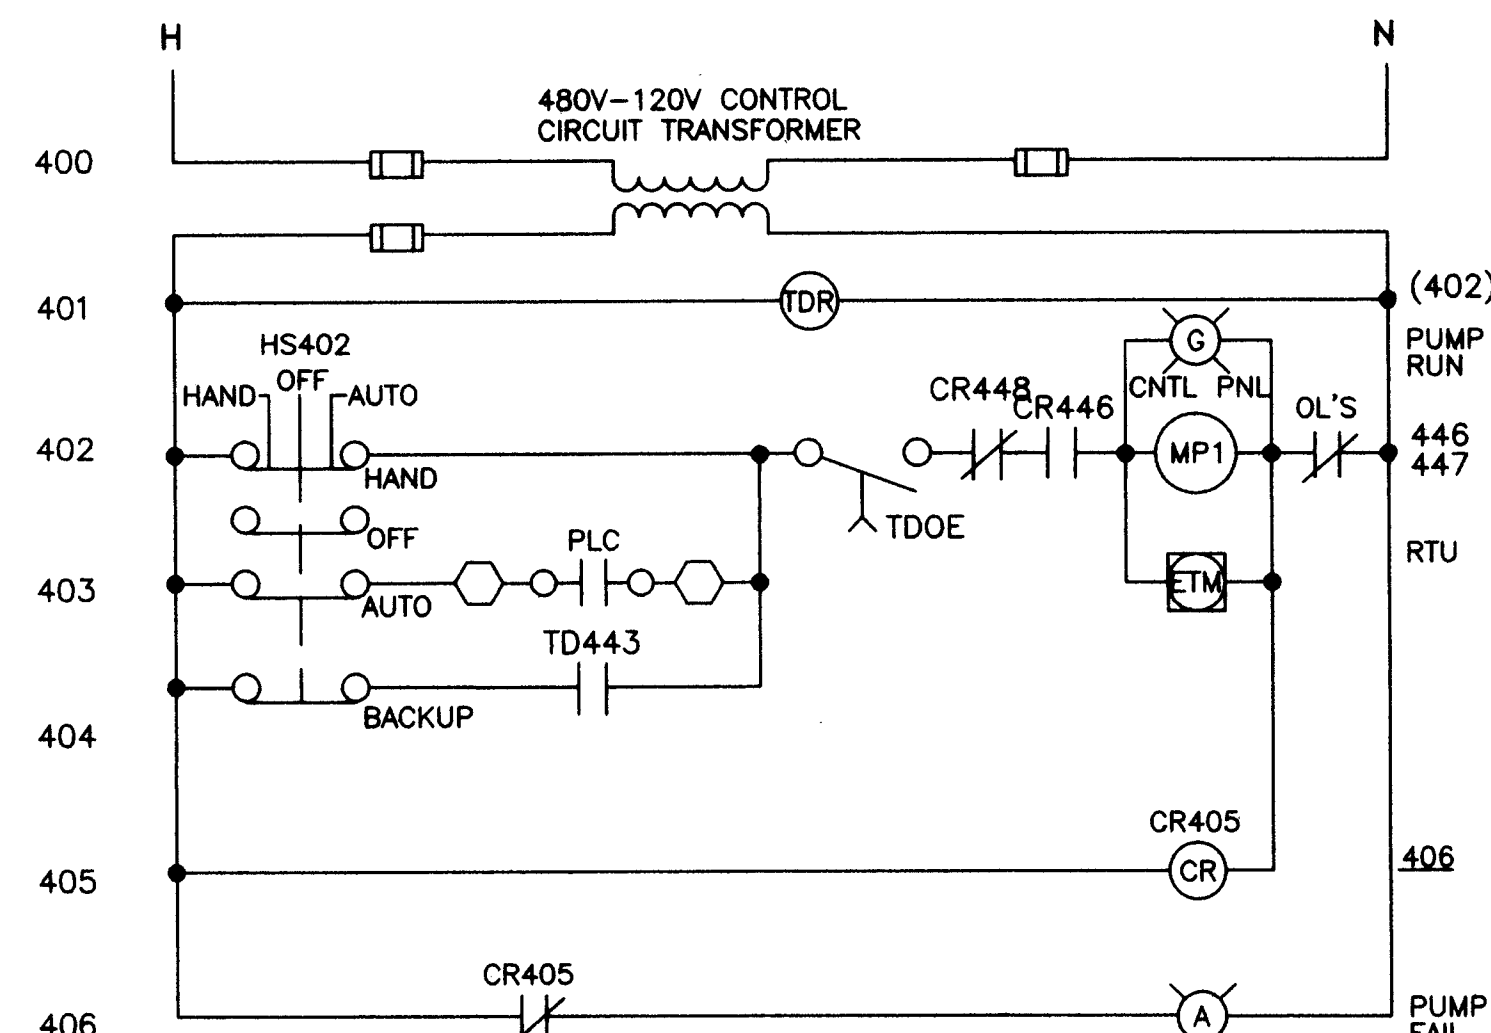


**PUMP #1 CONTROL**  
120V

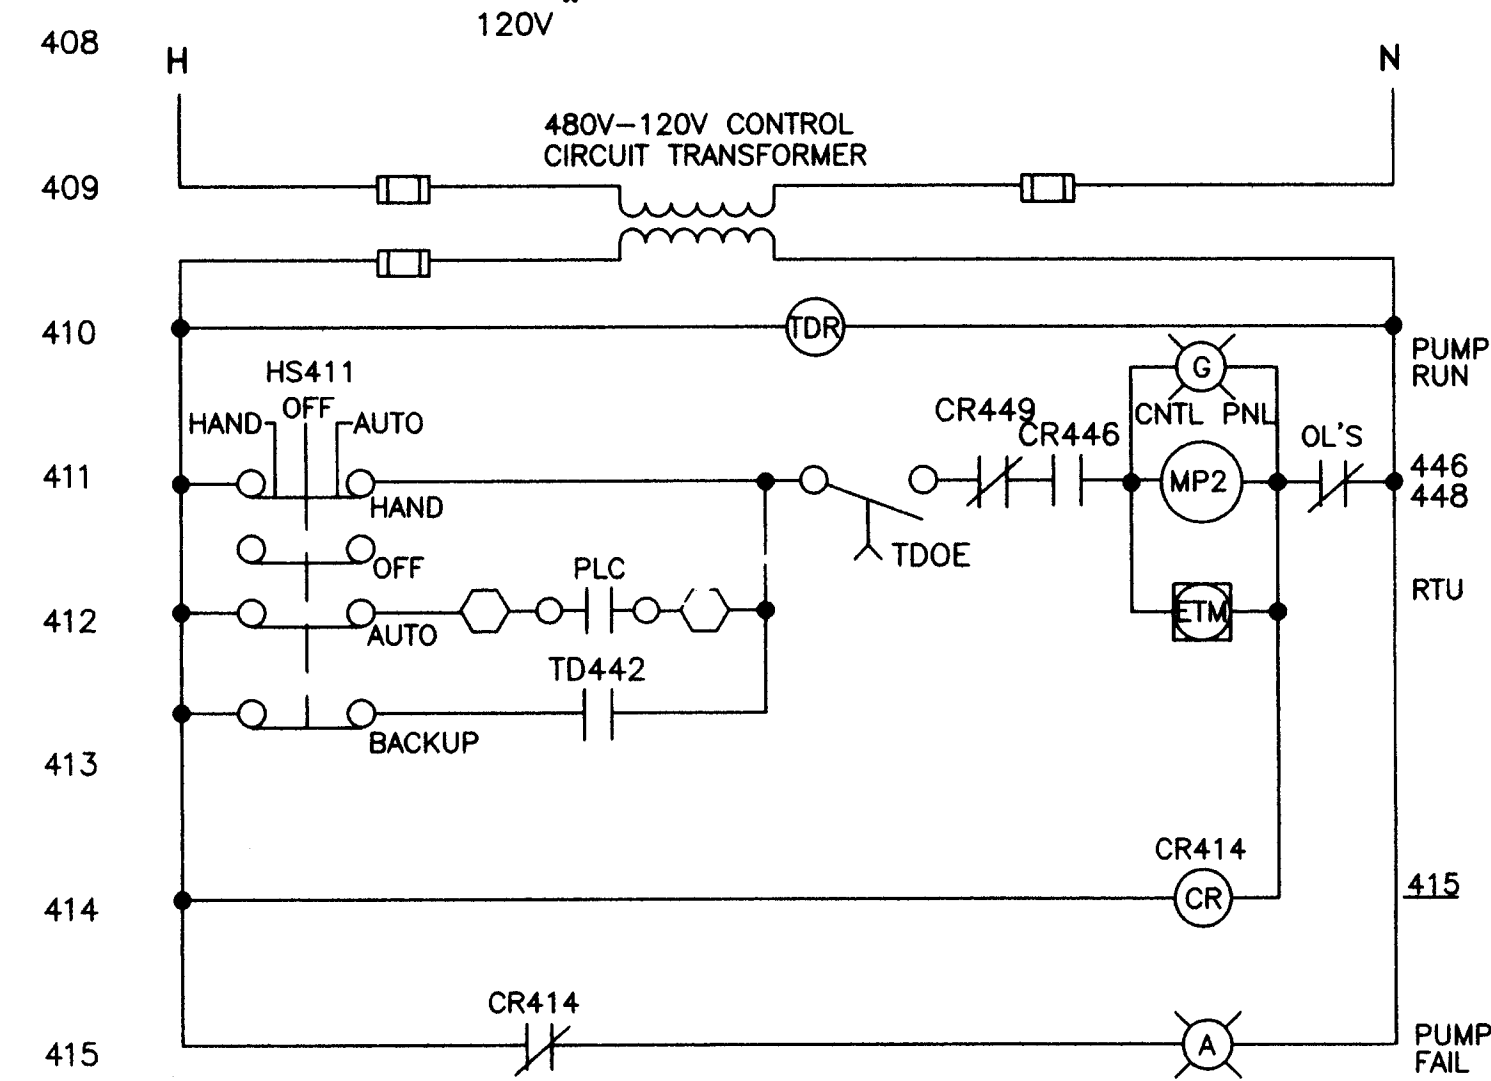

**PUMP #2 CONTROL**  
120V

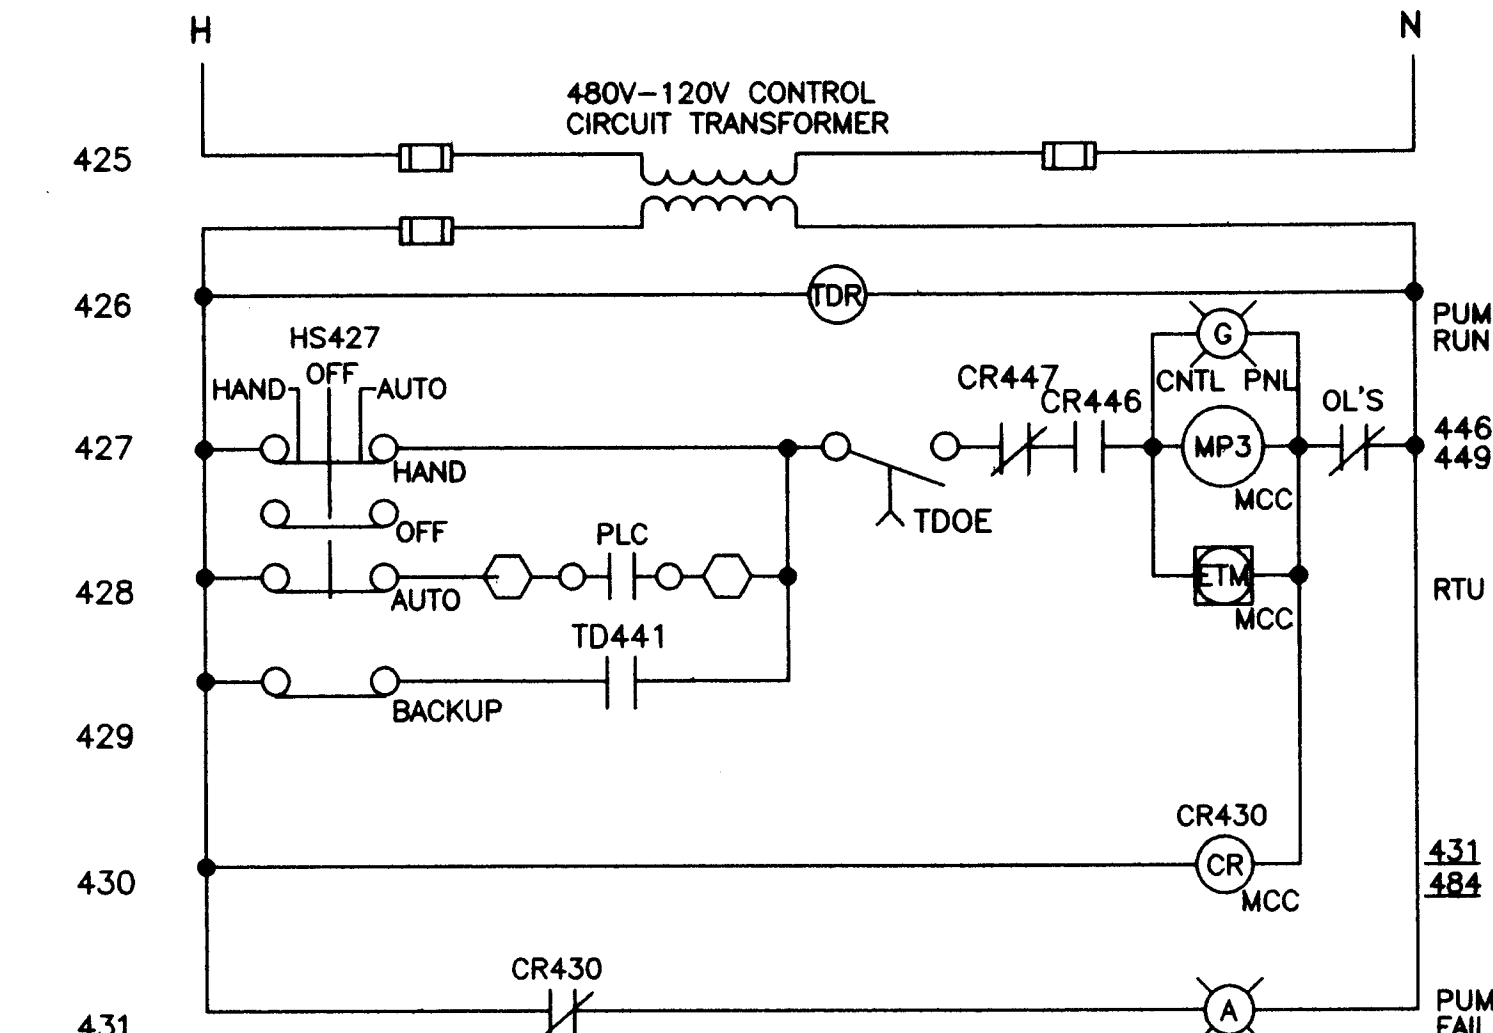

**PUMP #3 CONTROL**  
120V

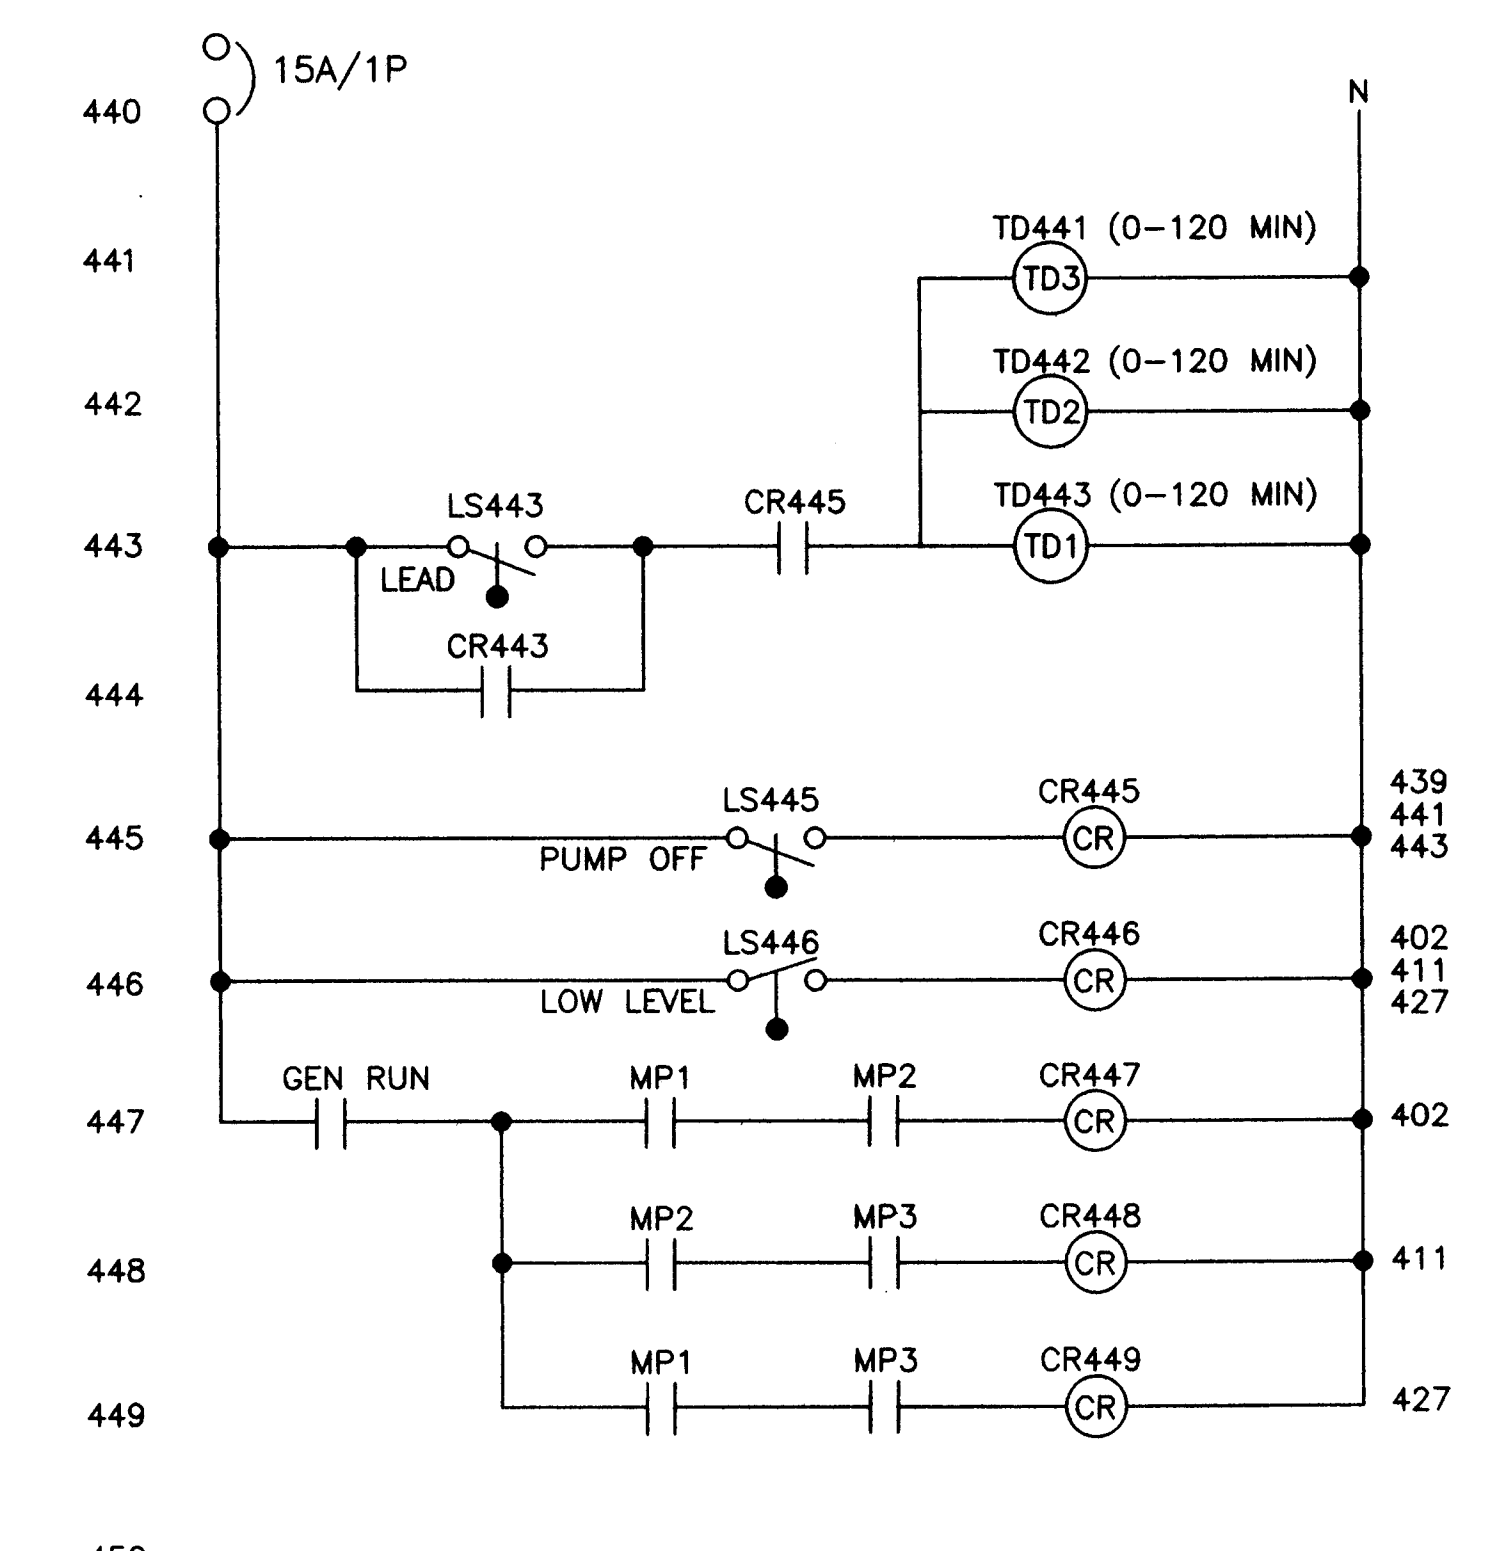

**STORMWATER PUMPS INTERLOCK SCHEMATICS**

- NOTE:**
- SEE SHT. I1 FOR FULL CONTROL AND PROCESS/ INSTRUMENTATION DRAWINGS
  - THIS SCHEMATIC IS SHOWN ONLY FOR LOCKOUT INSTALLATION PURPOSES. MOTOR CONTROL SCHEMATICS SHALL BE CONFIRMED WITH MCC AND MOTOR SUBMITTALS PRIOR TO CONSTRUCTION.

**RECORD DRAWINGS**  
9-09

NO	BY	DATE	REVISIONS
1			
2			
3			
4			
5			


EDH 04/04	PER CITY COMMENTS

PREPARED BY: RONALD S. WRIGHT  
 PROJECT ENGINEER  
 P.C.E. NO. 013216  
 EXP. 9/30/2005

SCALE: E.D.H.  
 DRAWN BY: R.J.A.  
 DESIGNED BY: R.S.W.  
 DATE: May, 2005

**CYPRESS GROVE  
 STORM WATER PUMP  
 STATION ELECTRICAL PLANS  
 SCHEMATICS**

**PACIFIC ADVANCED  
 CIVIL ENGINEERING  
 CORPORATION**  
 17520 NEWHOPE STREET, SUITE 200  
 FOUNTAIN VALLEY, CA 92708  
 PH (714) 461-7300 FAX (714) 461-7299

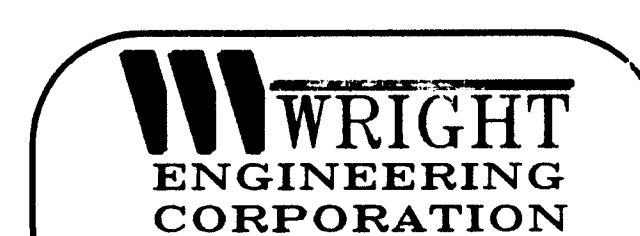

165 EAST CHILTON DRIVE PHONE 480.497.5829  
 CHANDLER, ARIZONA 85225 FAX 480.497.5807

WEC JOB# 04410

SHEET  
**E1.4**  
 JCS NO. 8072-E









**TOP**  
**NO. 57-T3660**  
 Locking Steel Cover  
 2,500 lbs.


**BASE**  
**NO. 575-BL**  
 7,450 lbs.

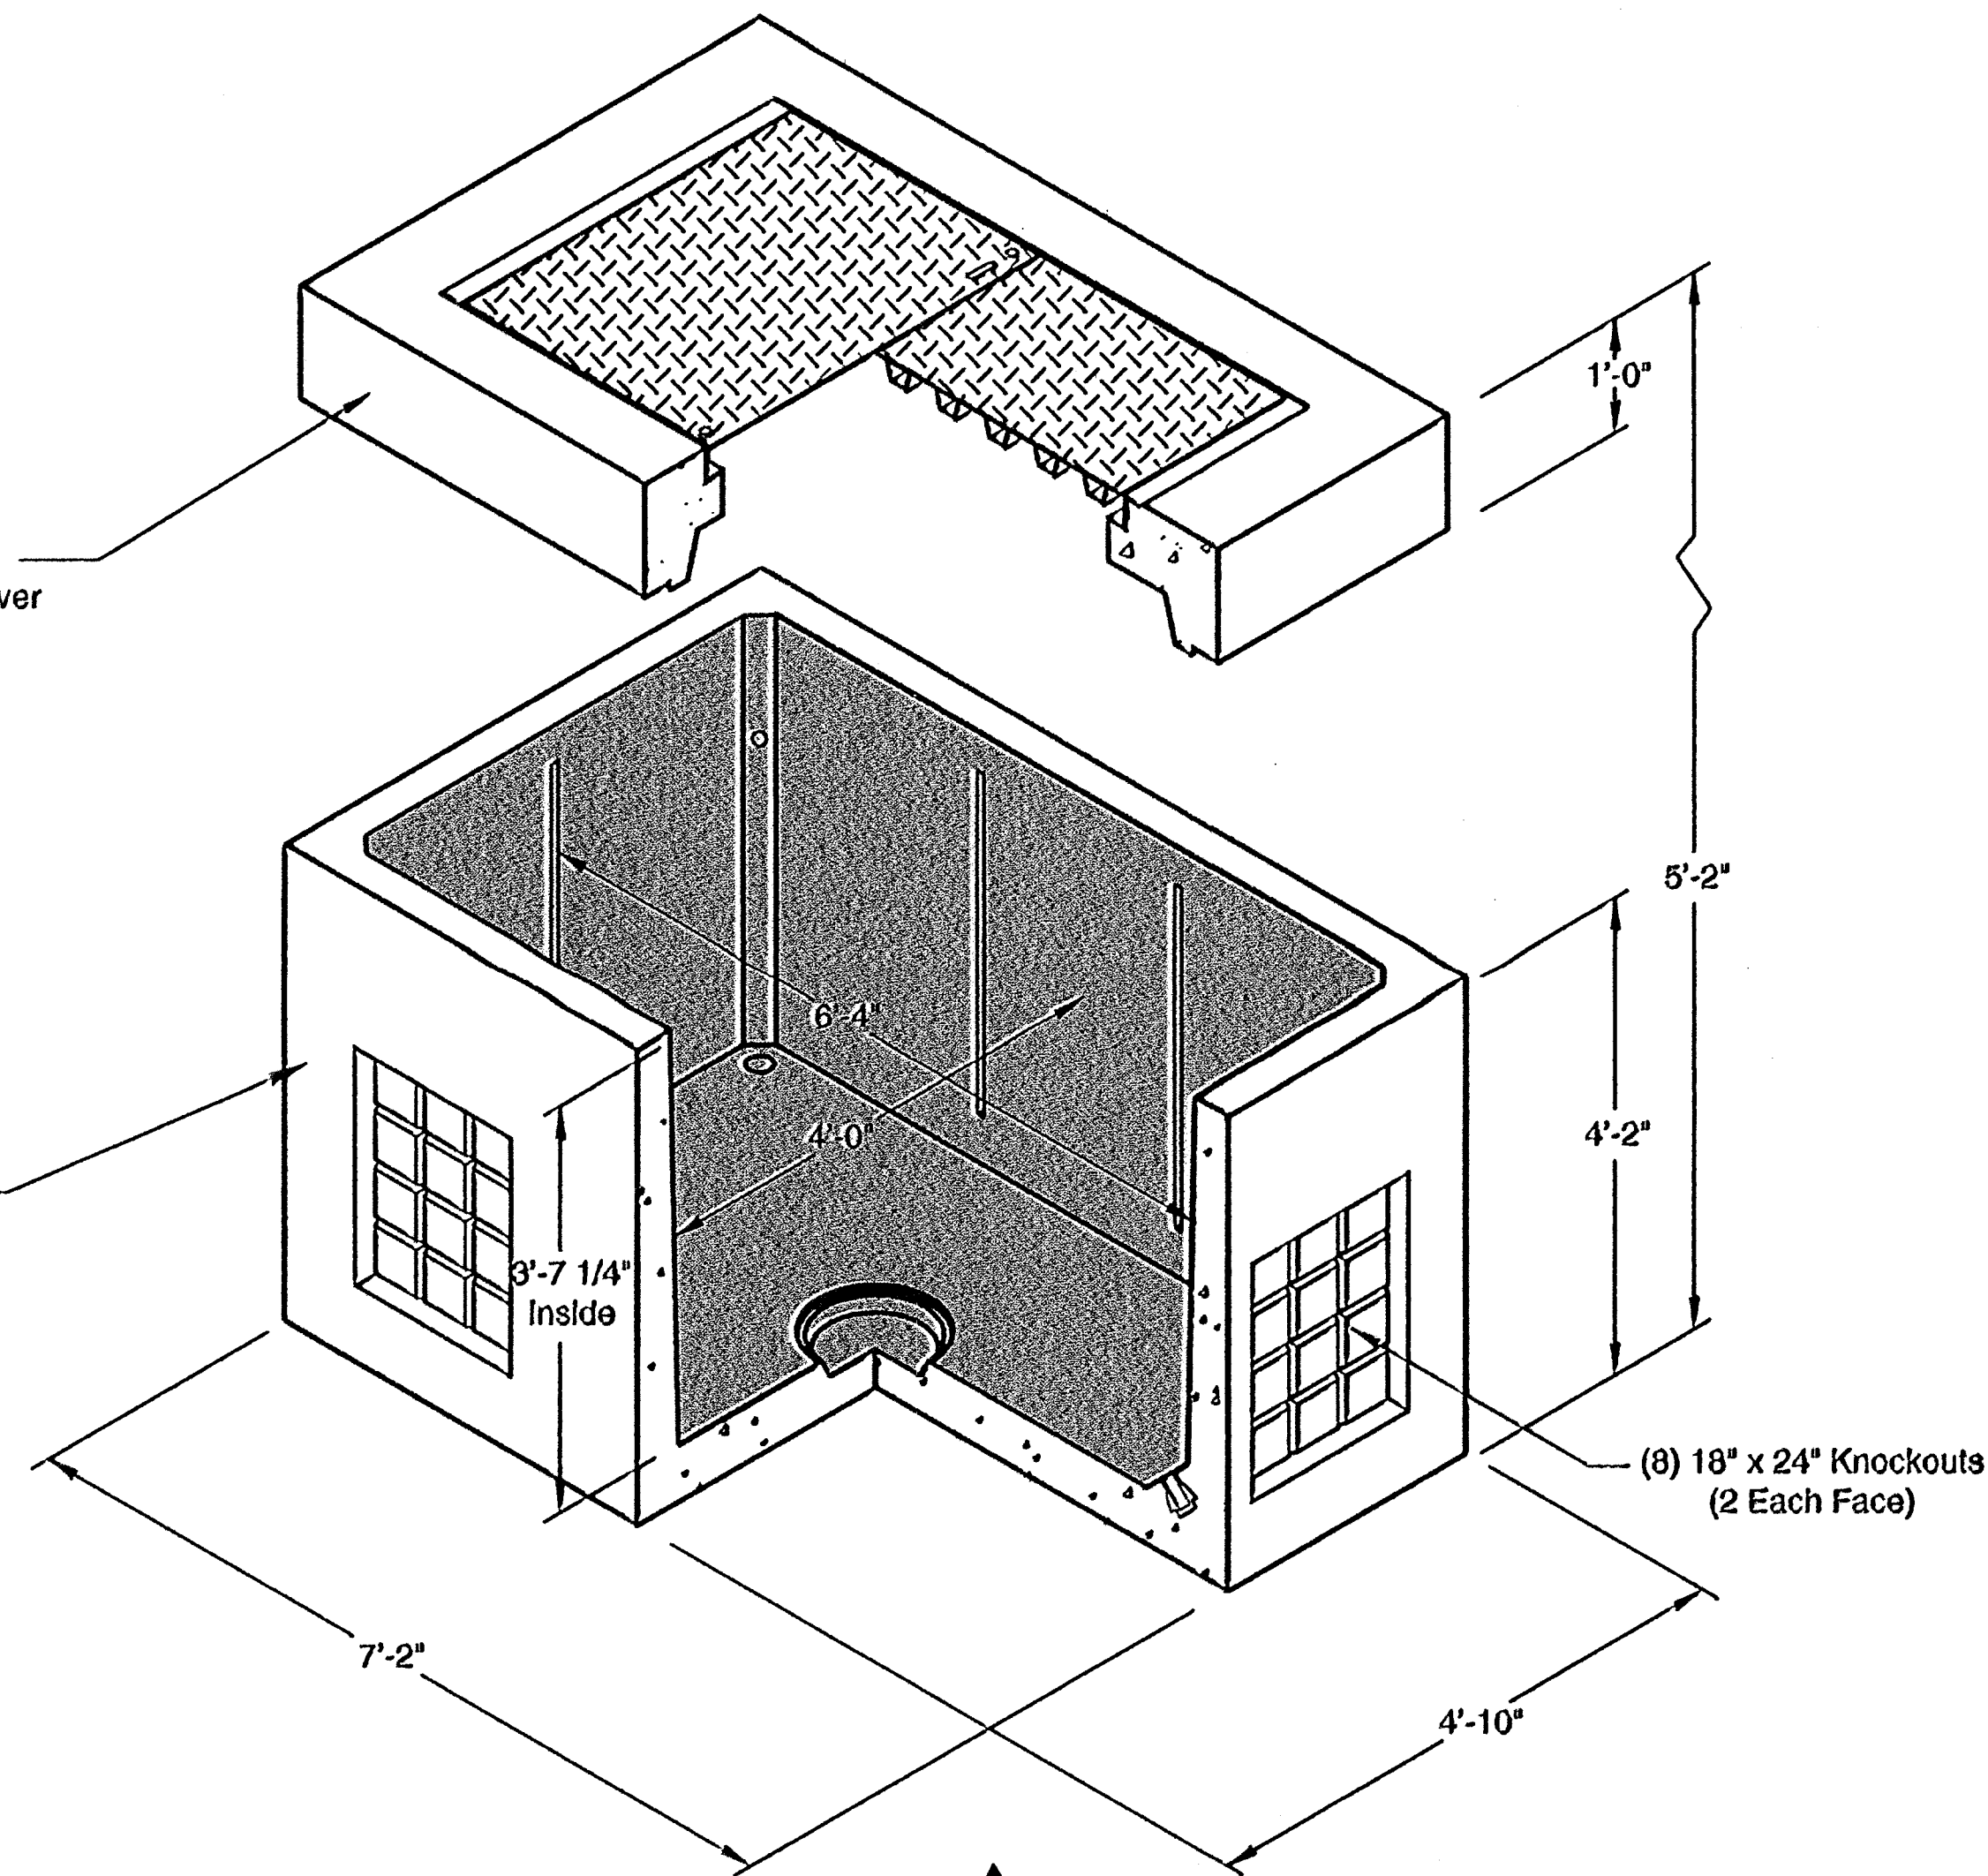

NOTE:  
 CONTRACTOR TO COORDINATE w/ PRECAST VAULT  
 MANUFACTURER 4" THICK BAFFLE WALL TO BE  
 CAST WITH VAULT AND ALL PIPE PENETRATIONS  
 CONTRACTOR TO PROVIDE LOCKING MECHANISM.

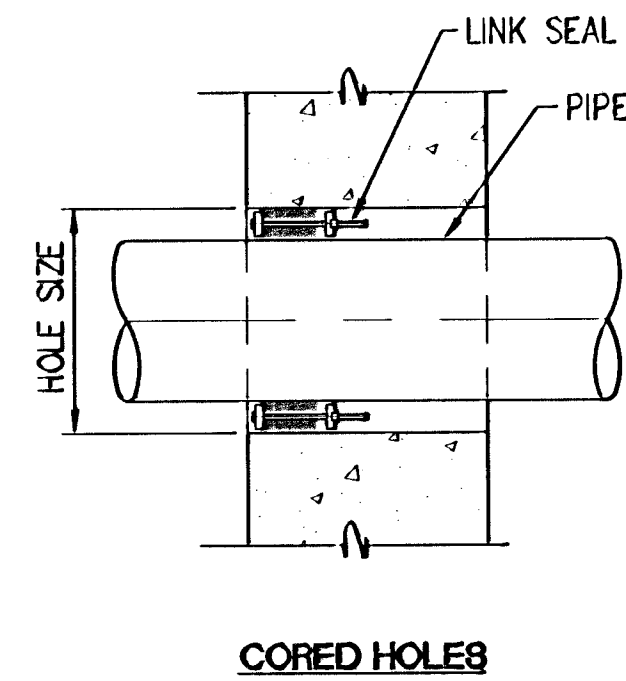

CORED HOLES			
PIPE SIZE	HOLE SIZE	MODEL NO.	NO. OF LINKS
1"	2 1/2"	LS - 200C	5
1 1/2"	3"	LS - 200C	7
2"	4"	LS - 300C	6
2 1/2"	4"	LS - 200C	9
3"	5"	LS - 300C	8
4"	6"	LS - 300C	10
5"	9"	LS - 475-C	8
6"	10"	LS - 400-C	7
8"	12"	LS - 475-C	12
10"	14"	LS - 400-C	10
12"	16"	LS - 400-C	12

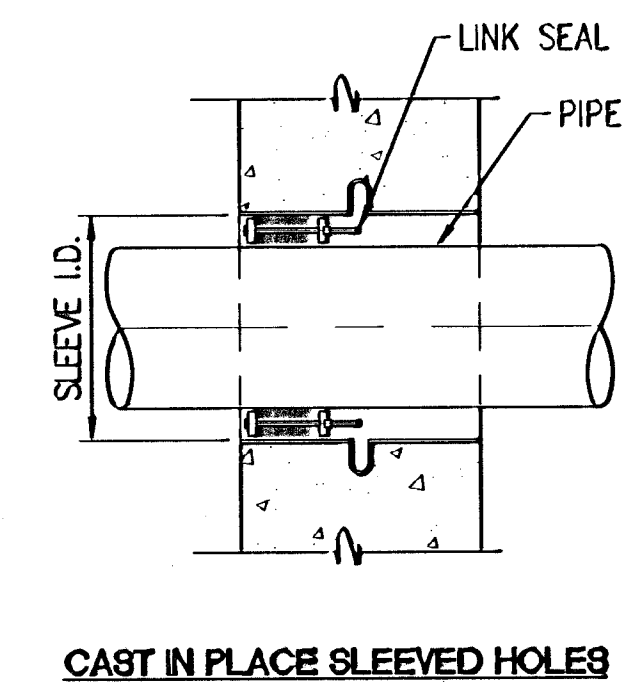


CAST IN PLACE SLEEVED HOLES					
PIPE SIZE NOMINAL	ACTUAL O.D.	CENTURY-LINE SLEEVE MODEL	SLEEVE I.D.	LINK-SEAL MODEL	LINKS PER SEAL
1/2"	.840	CS - 2	1.875	LS200	4
3/4"	1.050	CS - 3	2.812	LS300	4
1"	1.315	CS - 3	2.812	LS300	4
1 1/4"	1.660	CS - 3 1/2"	3.312	LS300	5
1 1/2"	1.900	CS - 3 1/2"	3.312	LS300	5
2"	2.375	CS - 4	4.000	LS200	6
2 1/2"	2.875	CS - 4	4.000	LS200	9
3"	3.500	CS - 5	5.125	LS300	8
3 1/2"	4.000	CS - 6	6.125	LS325	5
4"	4.500	CS - 6	6.125	LS300	11
5"	5.560	CS - 8	8.250	LS425	6
6"	6.625	CS - 8	8.250	LS300	15
6"	6.625	CS - 10	10.250	LS475	10
8"	8.625	CS - 12	12.250	LS475	12
10"	10.750		14.187	LS400	10
12"	12.750	CS - 16	16.250	LS400	12

NOTE:  
 PIPE THROUGH WALL SHOULD BE SEALED WITH LINK  
 SEALS BEFORE CONNECTION TO OTHER PIPES.

**UTILITY VAULT 575-LA**


N.T.S. **A** **LINK SEAL**

N.T.S. **B**

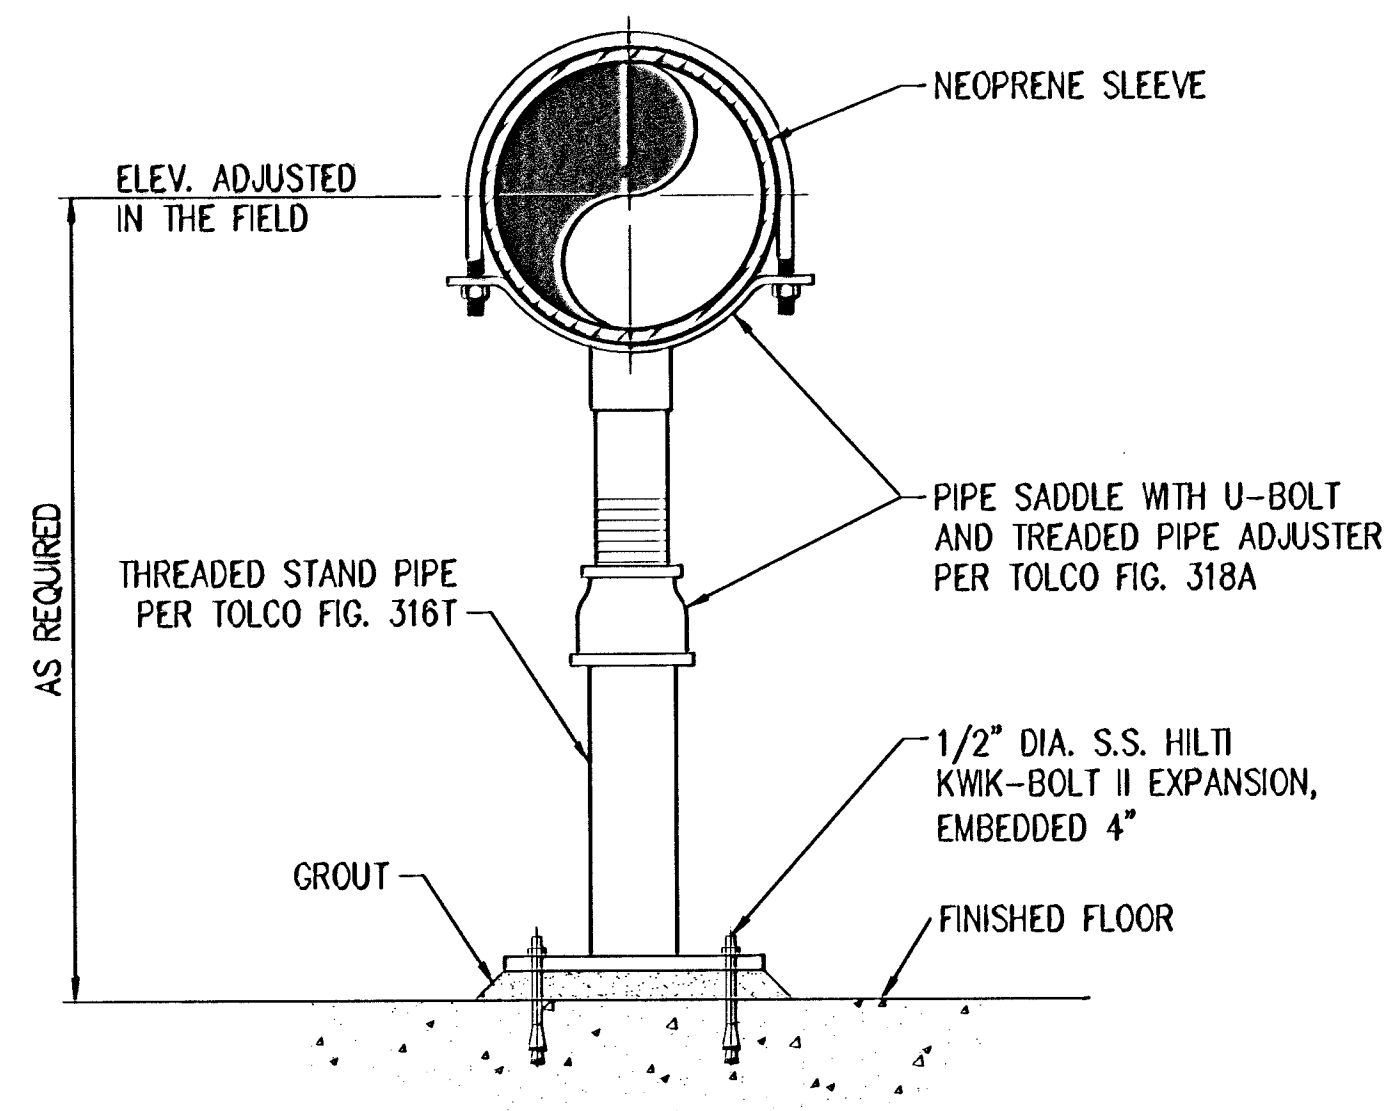


**PIPE SUPPORT**

N.T.S. **C** **PRESSURE GAUGE**

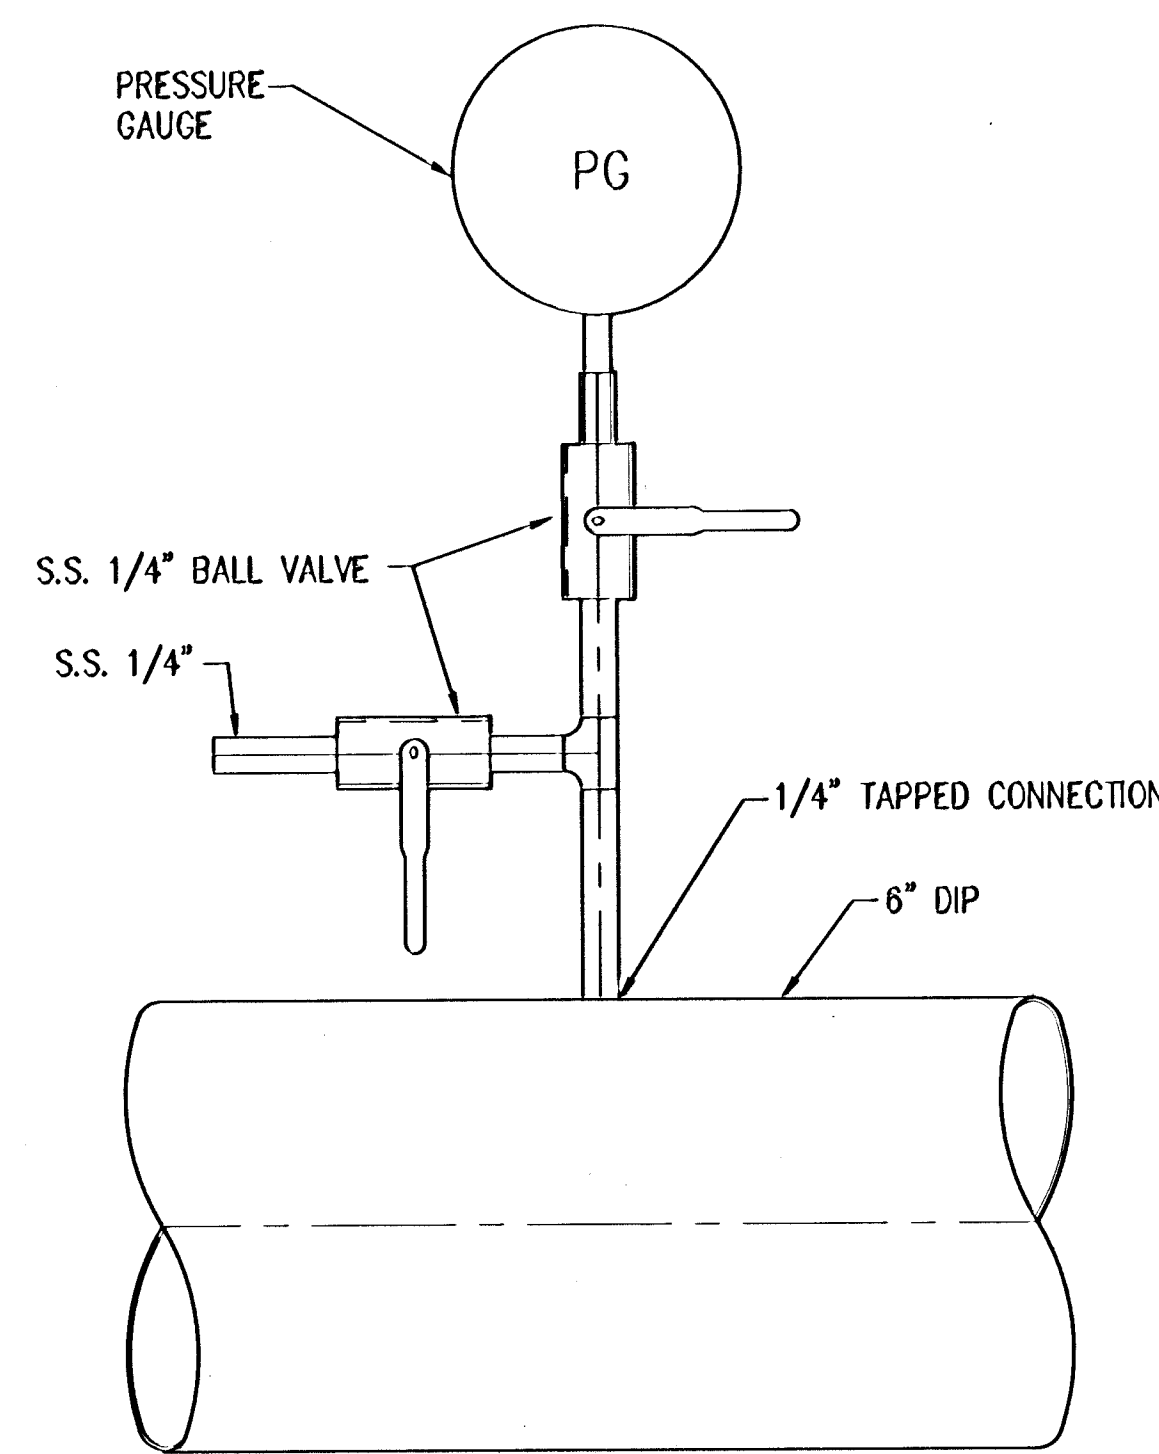

N.T.S. **D** **PITLESS ADAPTER**

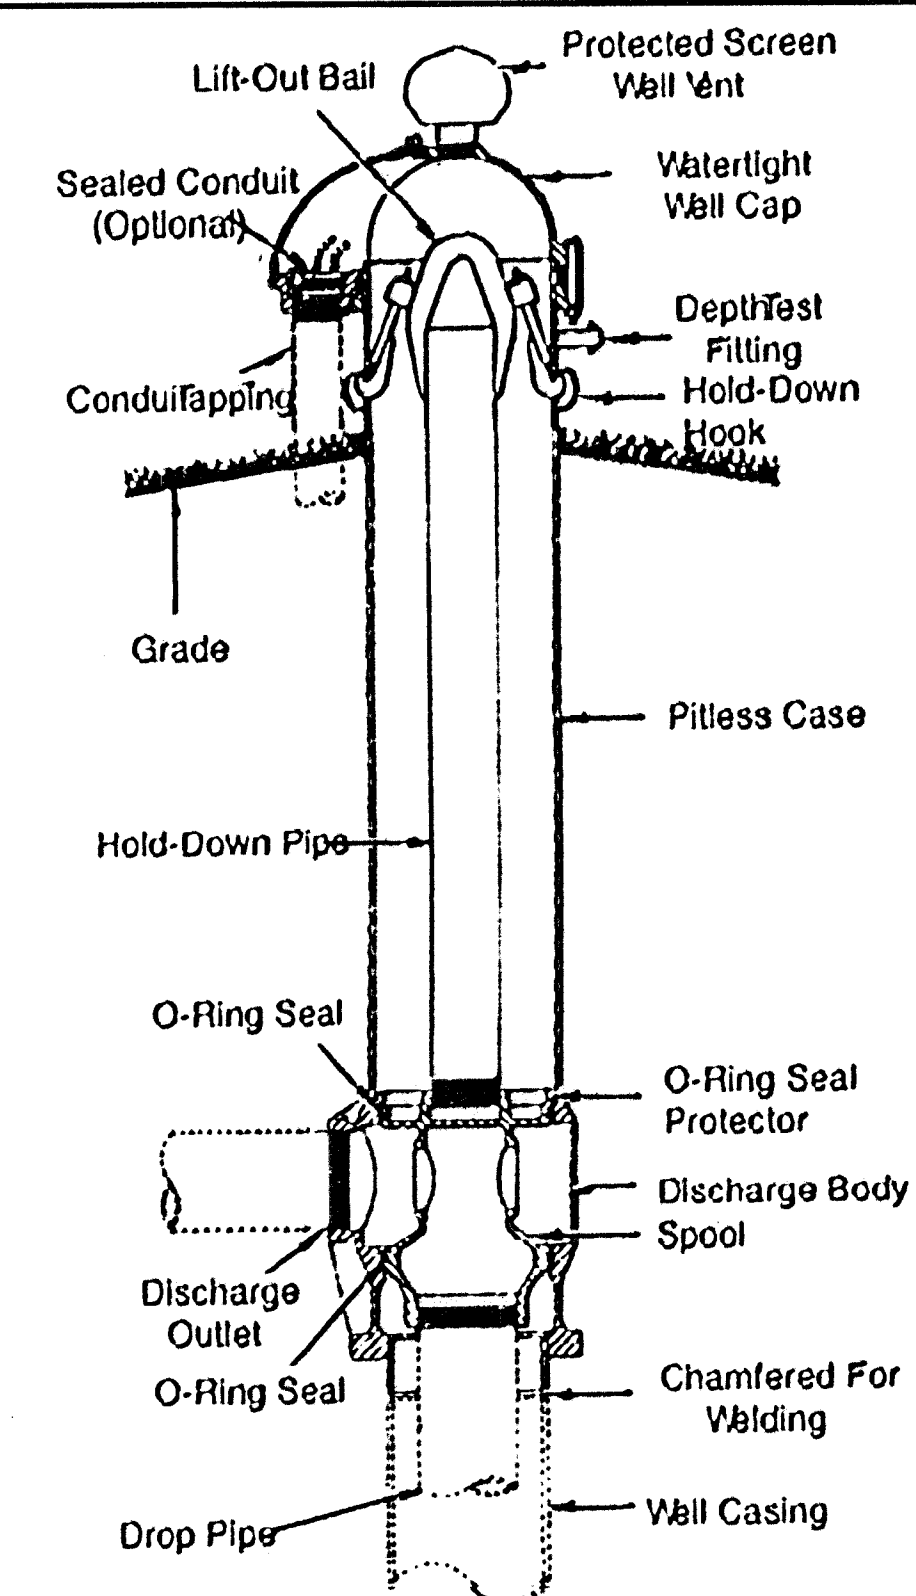

N.T.S. **E**

**RECORD DRAWING**

ATK	4/8	PER CITY COMMENTS	NO. BY	DATE	REVISIONS	DATE	APP.
1							
2							
3							
4							
5							
6							
7							
8							
9							
10							
11							
12							

DESIGNED BY: ANDREW T. KOMOR  
 PROJECT ENGINEER  
 P.E. NO. 1-17000  
 EXP. 9/20/07

SCALE: AS SHOWN  
 DRAWN: TAC  
 CHECKED: ATK  
 DATE: APR 2005

**DETAILS**


**CYPRESS GROVE**  
**WELL PUMP STATION**

**PACIFIC ADVANCED CIVIL ENGINEERING**  
 17520 NEWTROPIC STREET, SUITE 200  
 FOUNTAIN VALLEY, CA 92708  
 PH: (714) 461-7500 FAX: (714) 461-7299

SHEET **W2**  
 JOB NO. 8138-E

Xrefs: 8138-80-Block.dwg: 8138-UV275-LA.dwg  
 Date: 04/20/05 11:10 AM  
 Plot: 04/20/05 11:10 AM  
 Scale: 1:1  
 Plot Scale: 1:1  
 Plotter: HP DesignJet 500

P:\8138\Engineering\8138-80\WELL P5\Sheet\8138-80-W2.dwg - Tab: Layout1 By: gilliano on May 04, 2005 at 05:46 PM

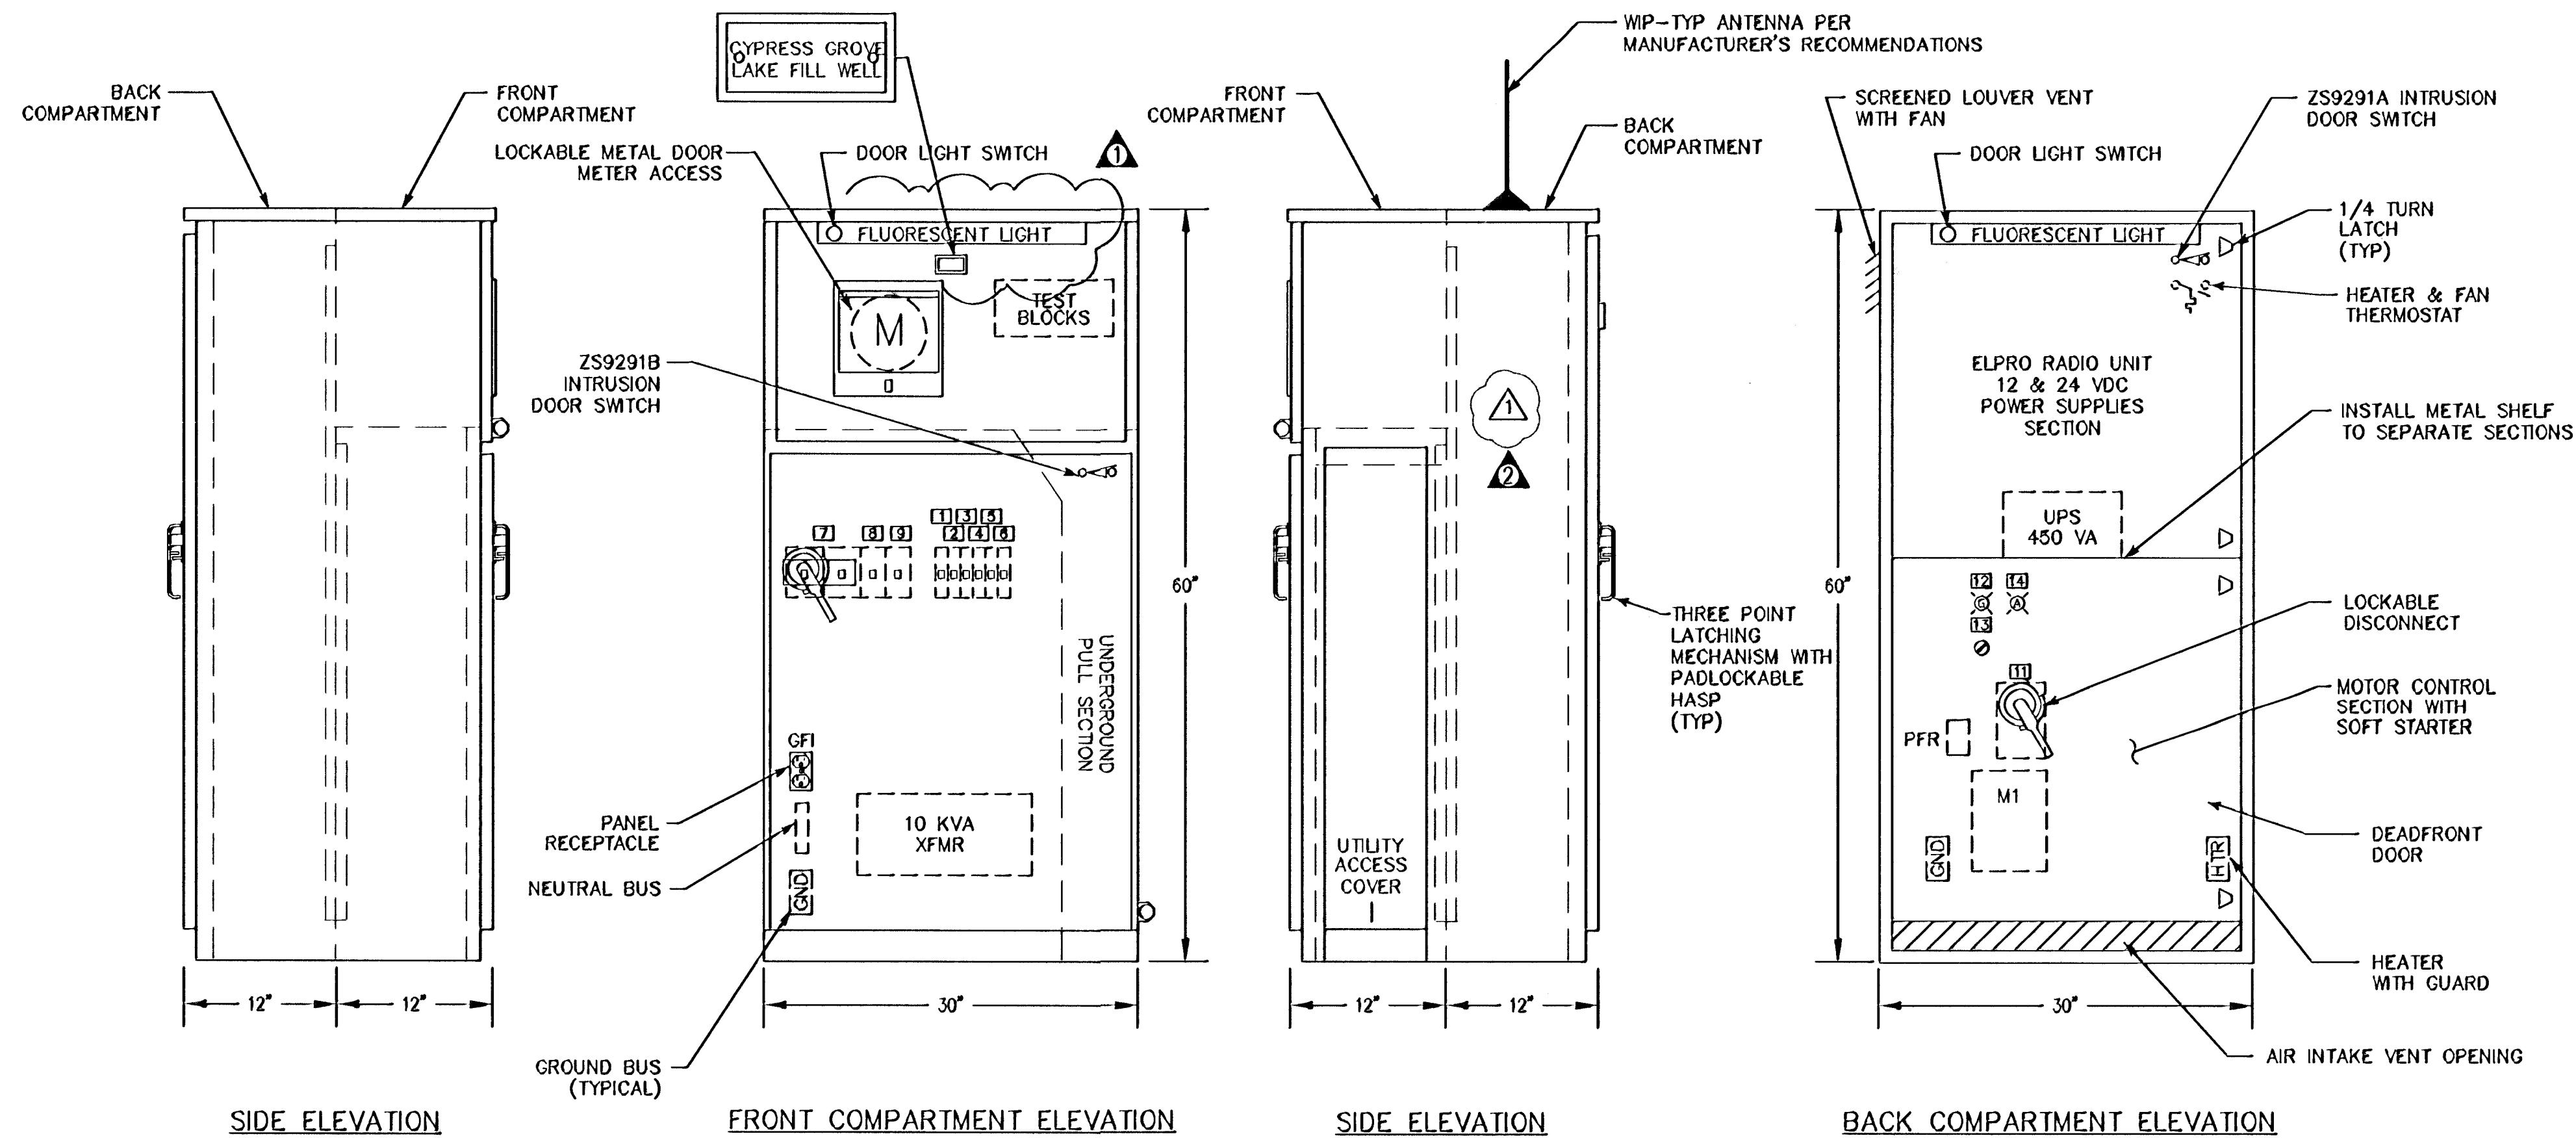


**SES LOAD CALCS**

WELL PUMP 1 (30HP)	=	40.0 AMPS
10 KVA / 1P XFMR	=	20.8 AMPS
25% LARGEST LOAD	=	10.0 AMPS
<b>TOTAL</b>	=	<b>70.8 AMPS</b>


**NAMEPLATE SCHEDULE**

KEY	DEVICE	ENGRAVING	NAMEPLATE SIZE (H x W)	LETTER SIZE
1	BREAKER	HEATER & FAN	1" x 2-1/2"	3/16"
2	BREAKER	RECEPTACLES	1" x 2-1/2"	3/16"
3	BREAKER	LIGHTS	1" x 2-1/2"	3/16"
4	BREAKER	CONTROLS - ELPRO RADIO W/UPS	1" x 2-1/2"	3/16"
5	BREAKER	VAULT INTRUSION/FLOOD	1" x 2-1/2"	3/16"
6	BREAKER	CONTROL PANEL INTRUSION	1" x 2-1/2"	3/16"
7	BREAKER	MAIN BREAKER	1" x 2-1/2"	3/16"
8	BREAKER	XFMR PRI DISC	1" x 2-1/2"	3/16"
9	BREAKER	XFMR SEC DISC	1" x 2-1/2"	3/16"
11	BREAKER	PUMP DISCONNECT	1" x 2-1/2"	3/16"
12	INDICATOR LIGHT	RUN	9/16" x 3/4"	3/16"
13	SELECTOR SWITCH	HAND - OFF - AUTO	9/16" x 3/4"	3/16"
14	INDICATOR LIGHT	FAIL	9/16" x 3/4"	3/16"

NOTES: ITEMS DRAWN IN DASHED LINES ARE TO BE LOCATED BEHIND DEADFRONT DOORS. OUTER DOORS ARE NOT SHOWN FOR ELEVATION CLARITY.

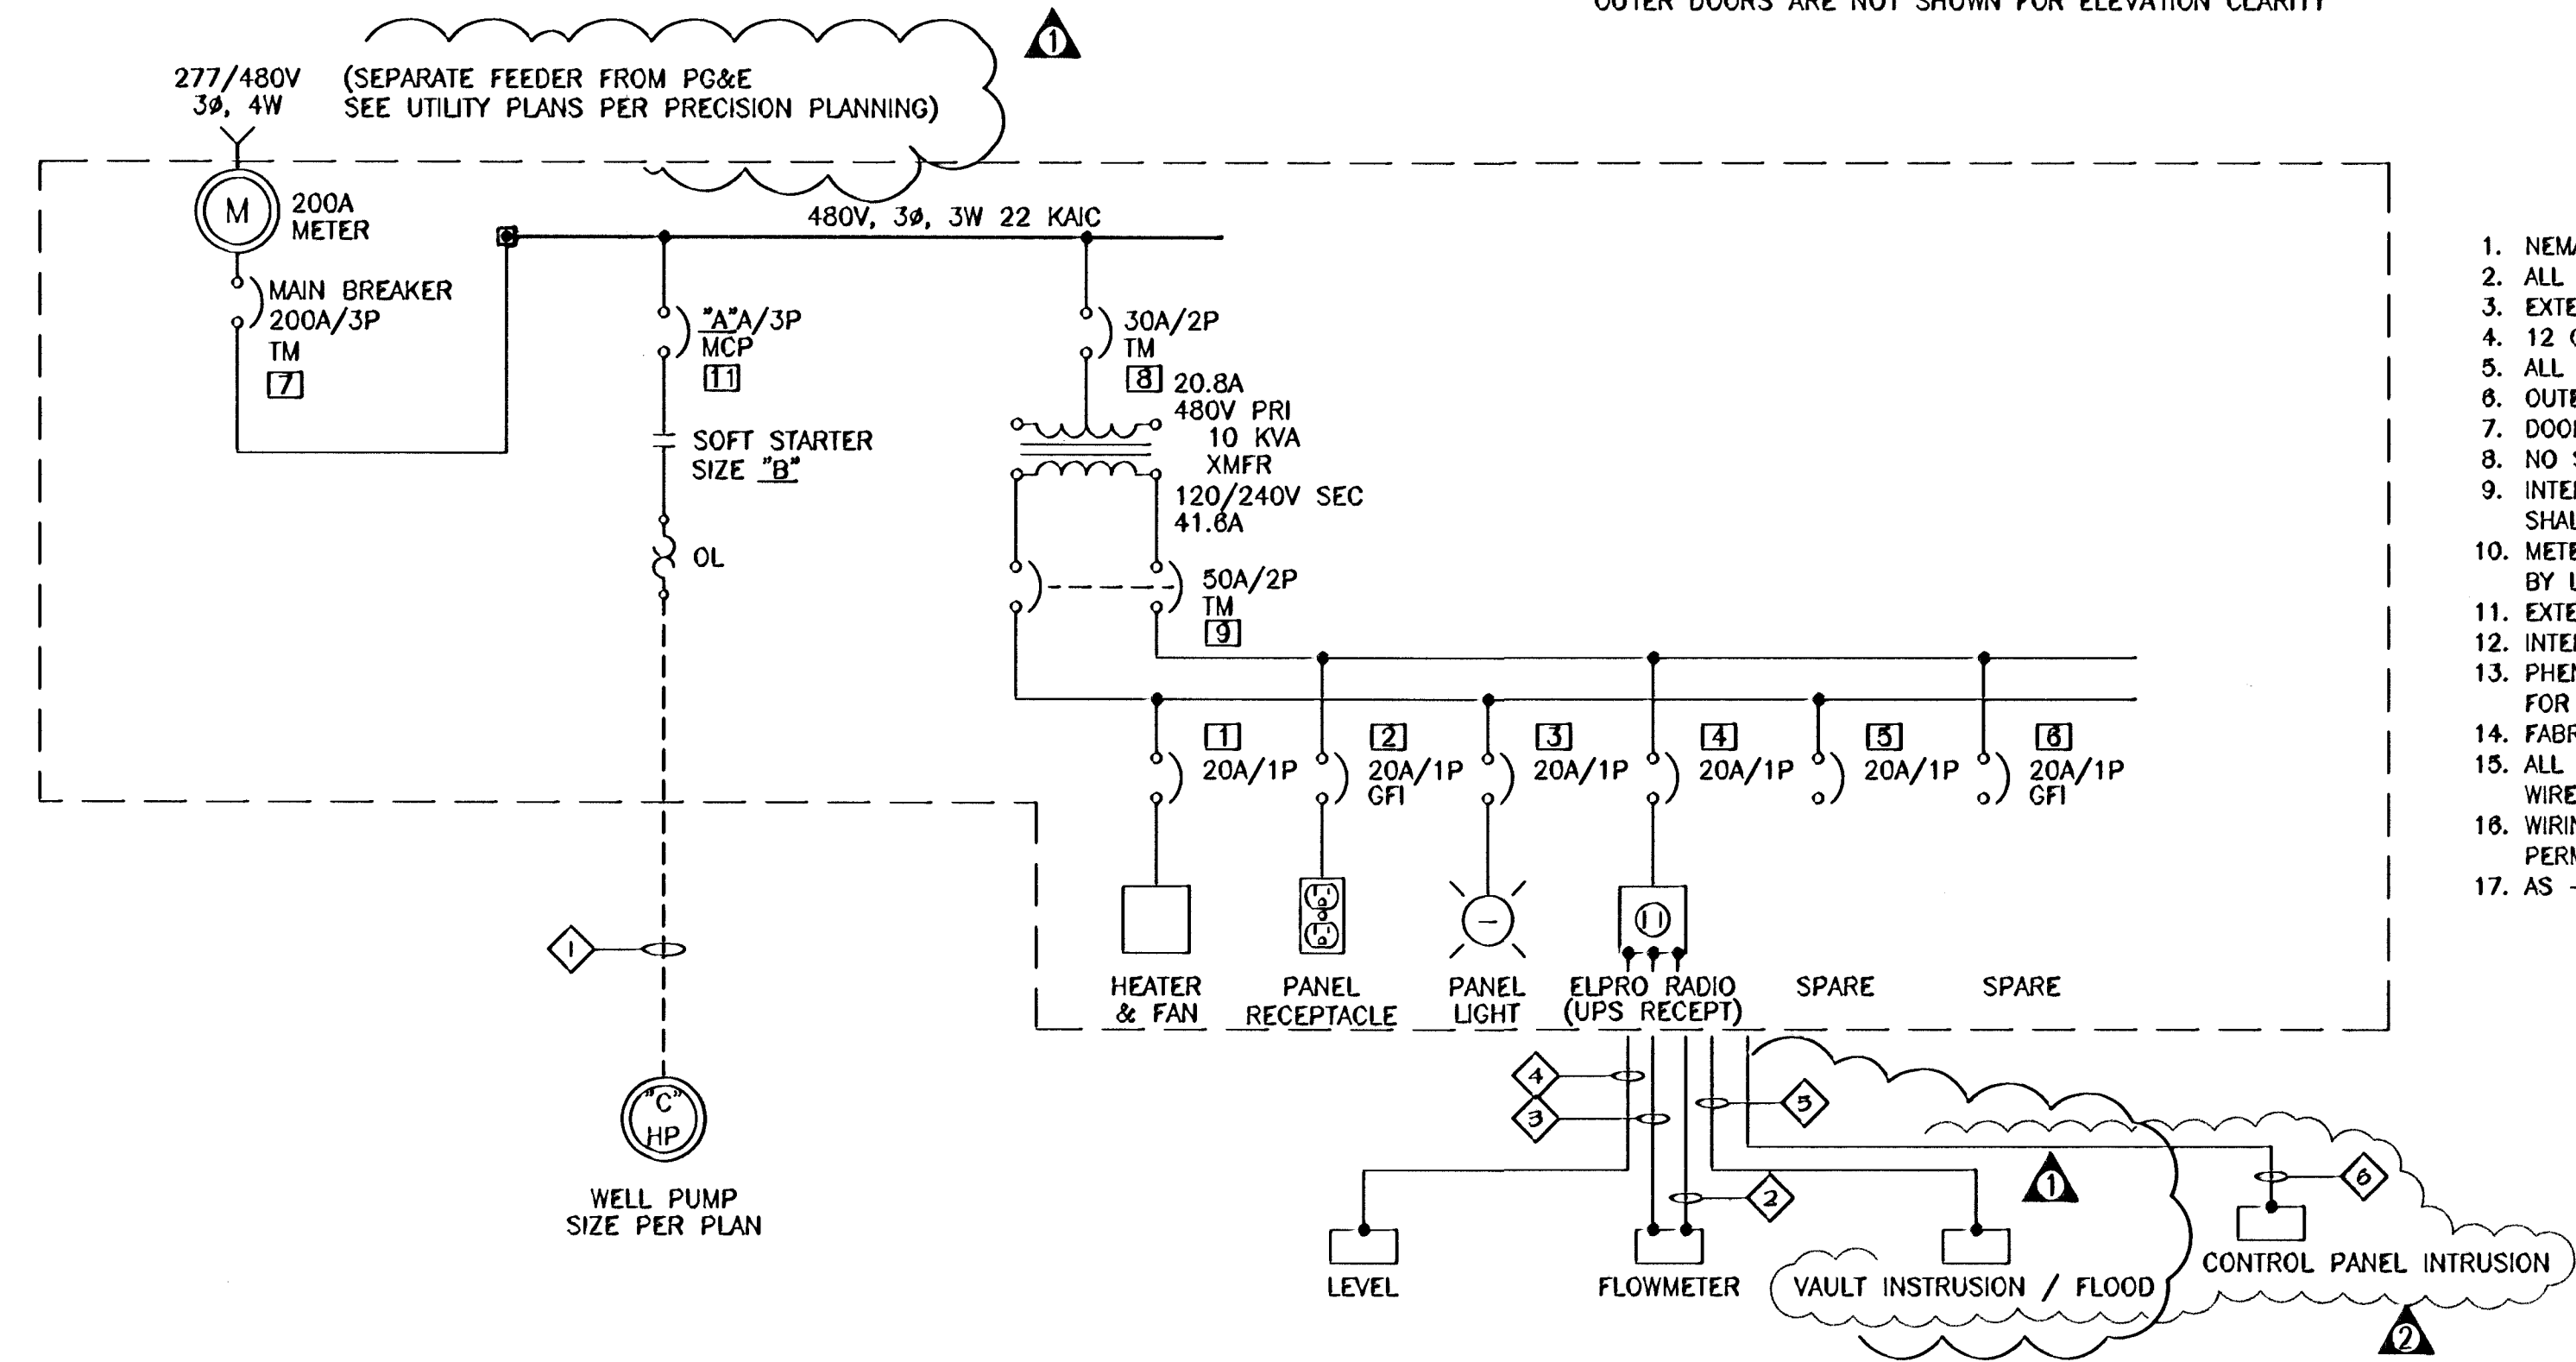

- PEDESTAL FABRICATION METHODS**
- NEMA 3R WEATHER-PROOFED FOR OUTSIDE INSTALLATION.
  - ALL OUTER DOORS SEALED WITH PERMANENT TYPE GASKETING.
  - EXTERIOR FABRICATED FROM HOT DIPPED GALVANIZED SHEET STEEL.
  - 12 GAUGE EXTERIOR AND 14 GAUGE INTERIOR.
  - ALL SEAMS CONTINUOUS WELDED.
  - OUTER DOORS TO BE PADLOCKABLE WITH HEAVY DUTY 3 POINT LATCHES.
  - DOOR HINGES AND PINS SHALL BE 316 STAINLESS STEEL.
  - NO SCREWS, RIVETS, OR BOLTS SHALL PROTRUDE EXTERNALLY.
  - INTERNAL SCREWS, RIVETS, BOLTS, AND NUTS SHALL BE STAINLESS STEEL.
  - METERING SHALL BE U.L. LABELED AND APPROVED IN WRITING BY LOCAL POWER UTILITY.
  - EXTERIOR PANEL COLOR: ANSI 61 LIGHT GREY.
  - INTERIOR DEADFRONT DOOR COLOR: WHITE.
  - PHENOLIC SCREW MOUNTED NAMEPLATES SHALL BE PROVIDED FOR ALL DEVICES ON DEADFRONT.
  - FABRICATION AND WIRING SHALL CONFORM TO U.L. AND NEMA STANDARDS.
  - ALL WIRING SHALL BE PERMANENTLY LABELED WITH WIRE MARKERS ON BOTH ENDS.
  - WIRING DIAGRAMS SHALL BE PLACED IN A PLASTIC DRAWING HOLDER PERMANENTLY ATTACHED TO THE INSIDE OF THE FRONT DOOR.
  - AS - BUILT WIRING DIAGRAMS SHALL BE SHIPPED WITH EQUIPMENT.

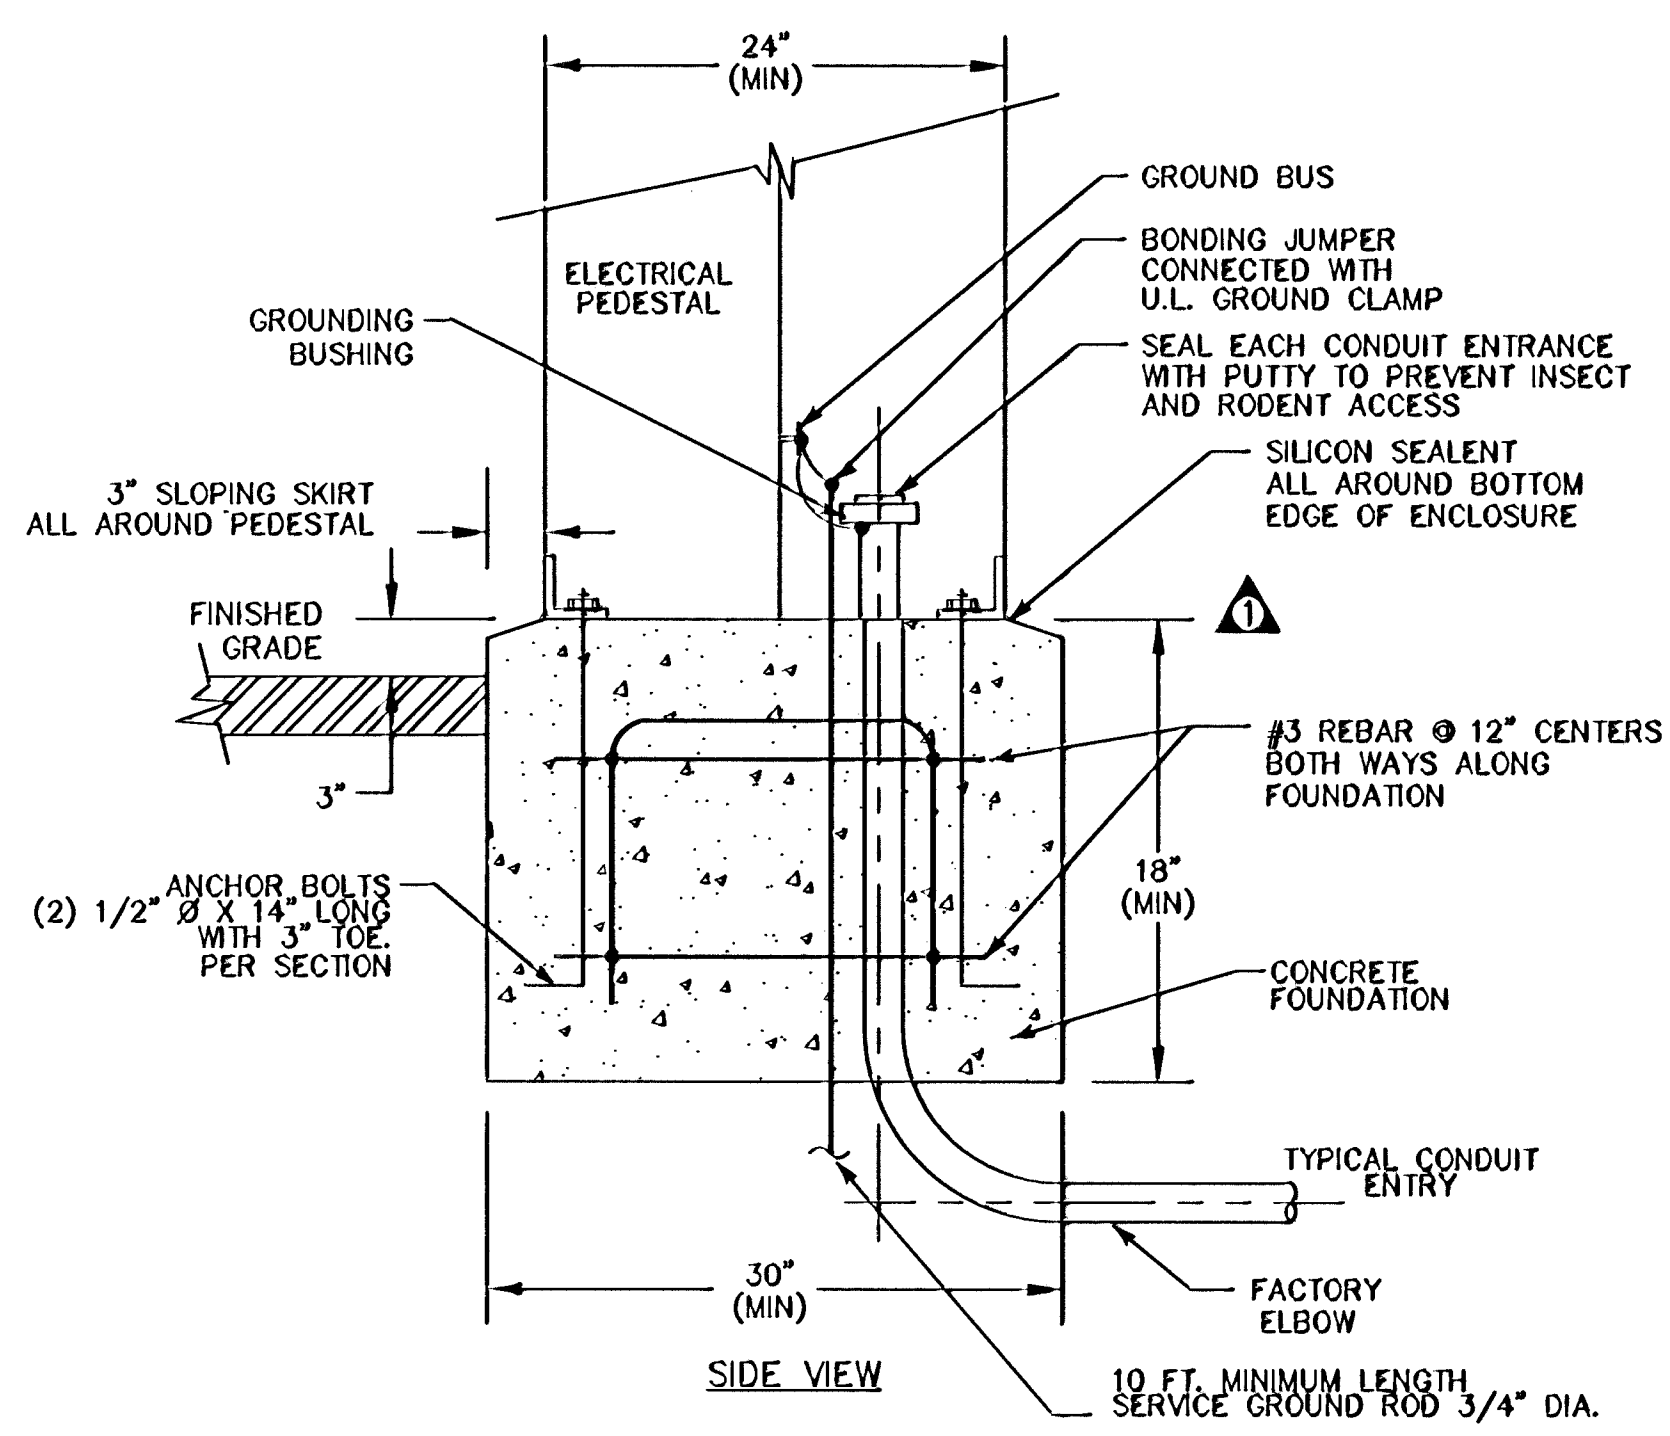

**PEDESTAL BASE DETAIL**  
NOT TO SCALE

**ELECTRICAL PEDESTAL ELEVATION & ONE LINE DIAGRAM**

\* TO BE VERIFIED BY WELL INSTALLATION CONTRACTOR

#	STATION ID	BREAKER AMP RATING "A"	STARTER SIZE "B"	MOTOR SIZE "C"	CONDUIT SIZE "D"	WIRE SIZE "E"
1	WELL PUMP	200	30HP S.S.	30	1 1/2"	(3)#3 + (1)#8 CU.
2	FLOWMETER				3/4" PVC	(4)#14 + (1)#14 GND
3	FLOWMETER				3/4" PVC	1 TSP SHIELDED #18
4	LEVEL				3/4" PVC	FACTORY CABLE
5	VAULT INTRUSION / FLOOD				3/4" PVC	4 #14s + #14 GND
6	CONTROL PANEL INTRUSION					2 #14s + #14 GND

ATK 4/8 PER CITY COMMENTS  
DC 4/27/05 PER CITY COMMENTS  
DC 5/05/05 PER CITY COMMENTS

NO. BY DATE REVISIONS DATE APP.

5-4-05

PREPARED BY: ANDREW T. KOMAR  
PROJECT ENGINEER  
R.C.E. NO. - # C 64928  
EXP. 6/30/07

SCALE  
DRAWN: JAC  
CHECKED: ATK  
DATE: APR 2005  
ORDERED: ATK

**CONTROL & SES PEDESTALS**

**CYPRESS GROVE WELL PUMP STATION**


**PACIFIC ADVANCED CIVIL ENGINEERING**  
1720 NEVADALE STREET, SUITE 200  
FOUNTAIN VALLEY, CA 92708  
PH (714) 481-7300 FAX (714) 481-7299

SHEET **W3**

JOB NO. 8138-E


THESE DRAWINGS ARE THE PROPERTY OF P.A.C.E. AND SHALL NOT BE REPRODUCED IN ANY MANNER NOR BE USED FOR CONSTRUCTION UNLESS STAMPED "ISSUED FOR CONSTRUCTION".



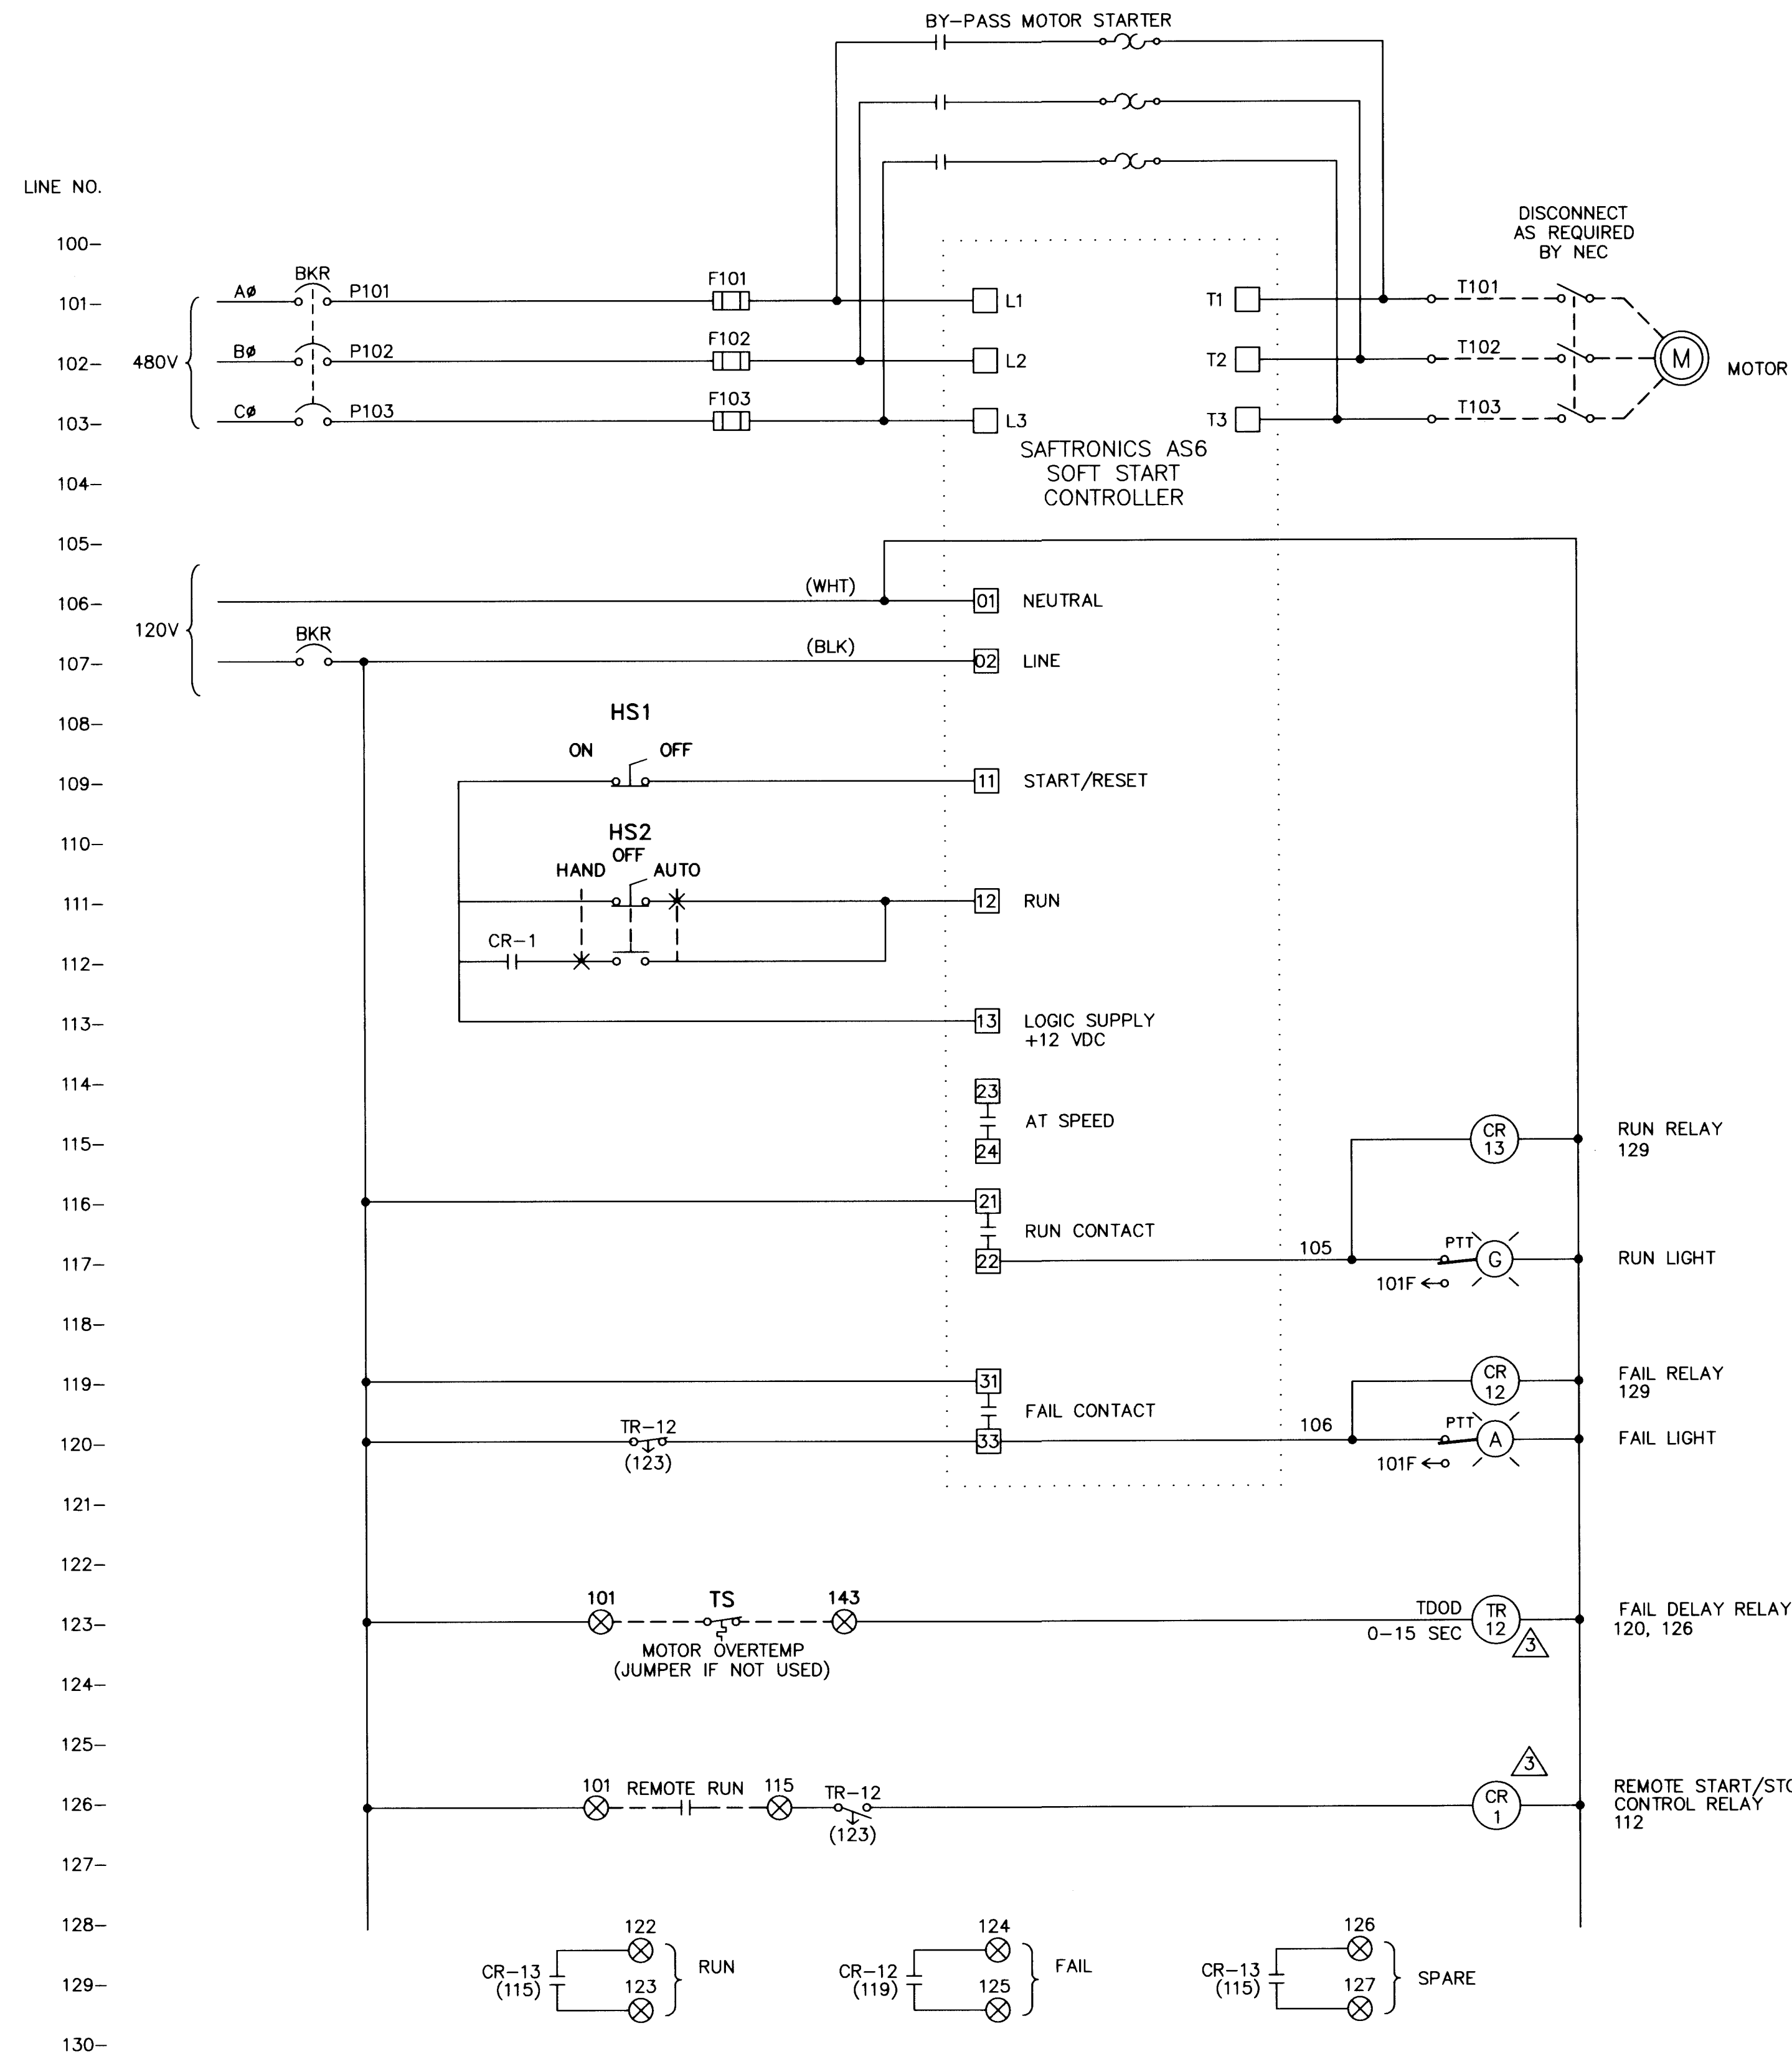

WELL SOFT START ELEMENTARY DIAGRAM

- NOTE: 1. REMOTE SHUTDOWN XS => LSSL, ZSHH, PSHH, ETC., PER P&ID, JUMPER IF NOT USED. THESE ARE TO BE CONTACTS OFF OF AUXILIARY RELAY CONTACTS LOCATED IN MCC CONTROL PANEL DRIVEN FROM FIELD DEVICE.
2. USE 100 SERIES WIRES & TERMINAL #s FOR MCC 1, 200 SERIES FOR MCC 2, 300 SERIES FOR MCC 3, ETC.
3. USE STANDARD RELAYS WITH COIL, DO NOT USE SOLID STATE RELAYS.
4. MANUAL SPEED CONTROL LOCATED ON HIM.

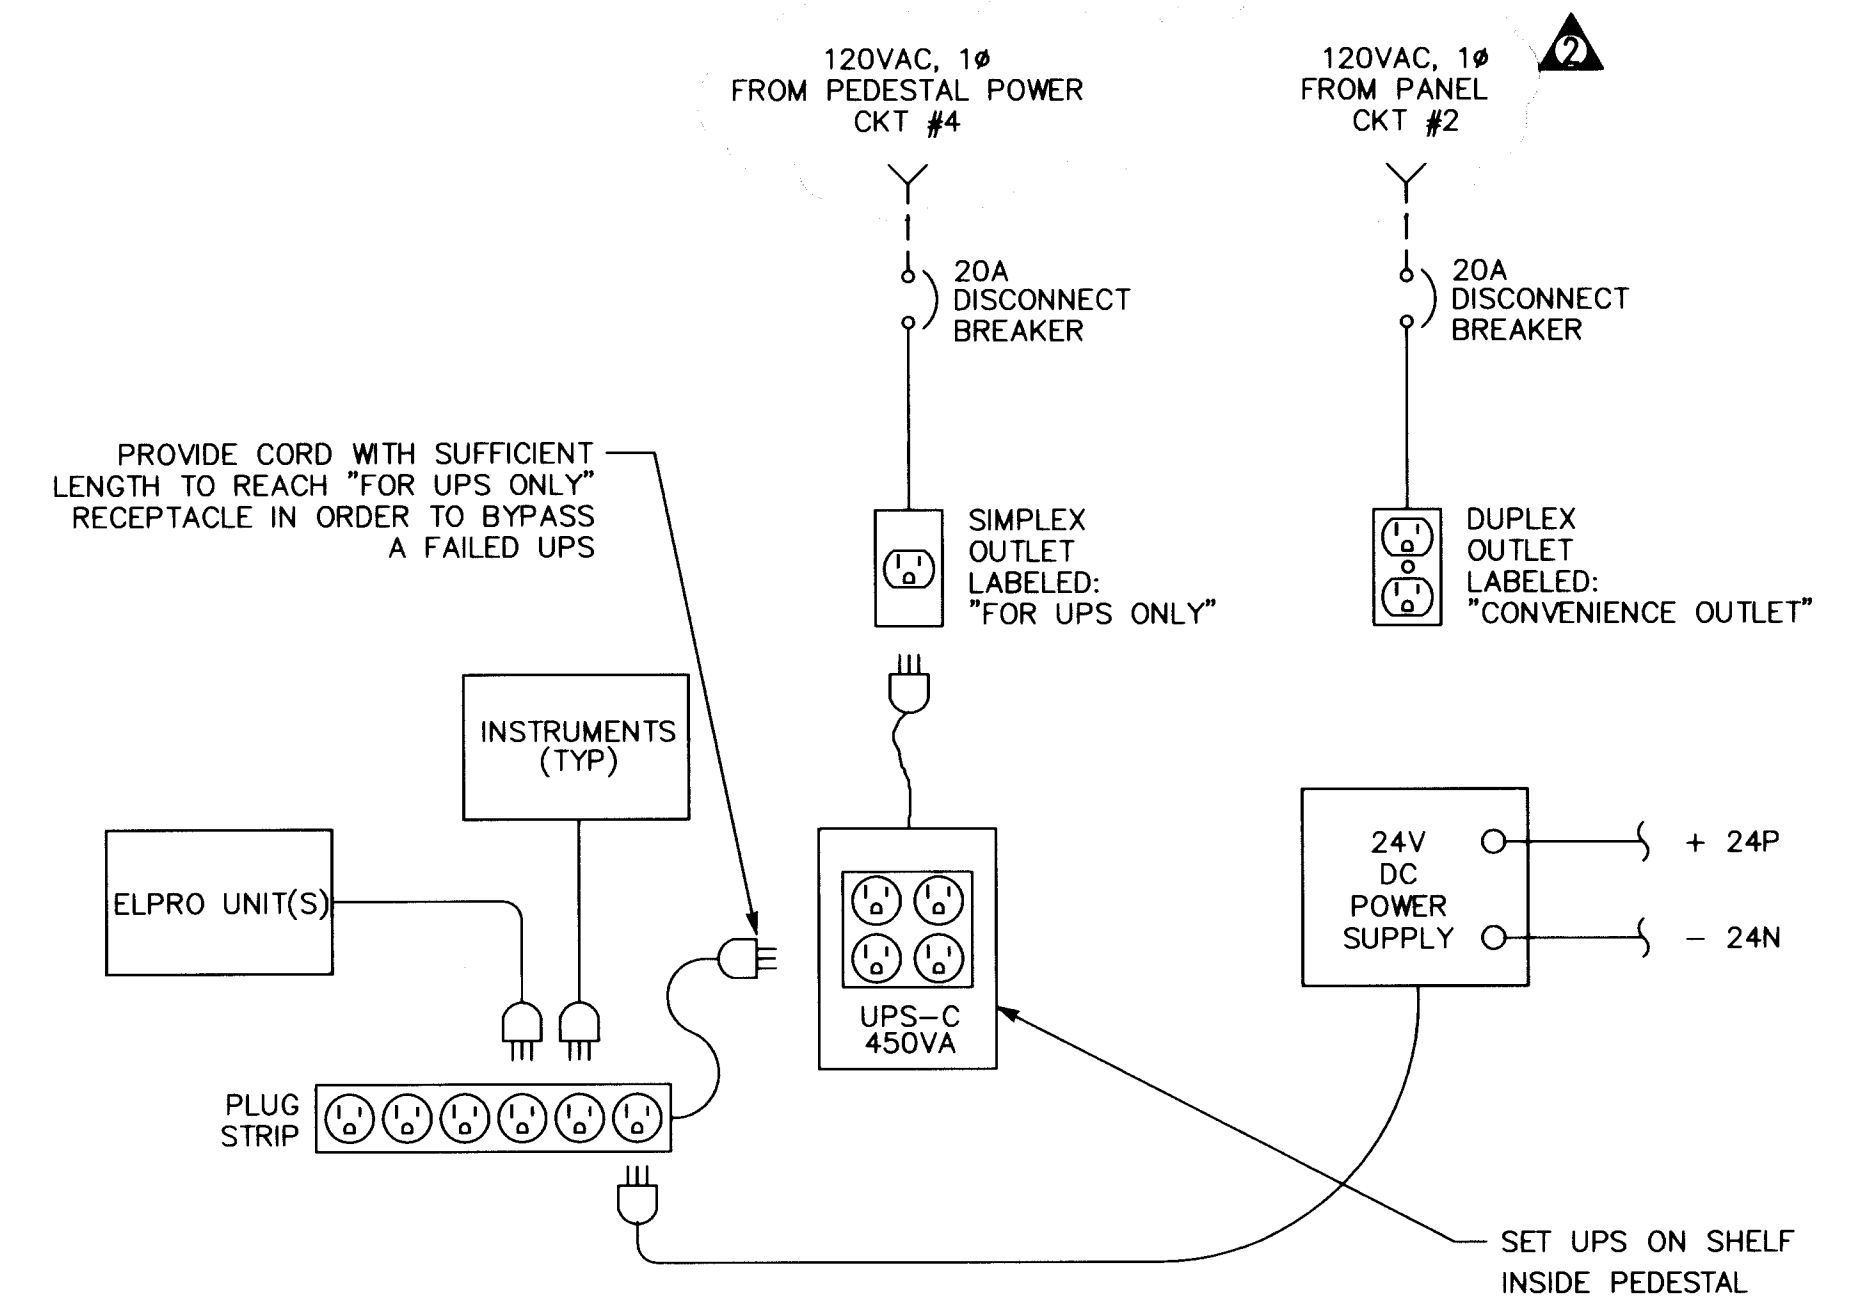

PEDESTAL POWER DISTRIBUTION BLOCK DIAGRAM

**RECORD DRAWING**

DATE	BY	NO.	REVISIONS	DATE	APP.
4/8	ATK	1	PER CITY COMMENTS		
4/27/05	DC	2	PER CITY COMMENTS		

PREPARED BY ANDREW T. KOMOR	PROJECT ENGINEER R.C.E. NO. --- # C 64928	SCALE NONE	DATE APR 2005
DESIGNED ATK	CHECKED ATK		


**WELL ELEMENTARY & DIAGRAM & POWER DISTRIBUTION**

**GYPRESS GROVE WELL PUMP STATION**

**PACIFIC ADVANCED CIVIL ENGINEERING**  
 17520 N. WHITTAKER STREET, SUITE 200  
 FOUNTAIN VALLEY, CA 92708  
 PH: (714) 481-7300 FAX (714) 481-7299

SHEET  
**W4**  
JOB NO. 8138-E








Xrefs: 8138-80-Title.dwg  
 Dimscale = 1, Ltscale = 0.5, Ptscale = 1, Acad Ver. = 16.0a (US, Tech), Version = 1

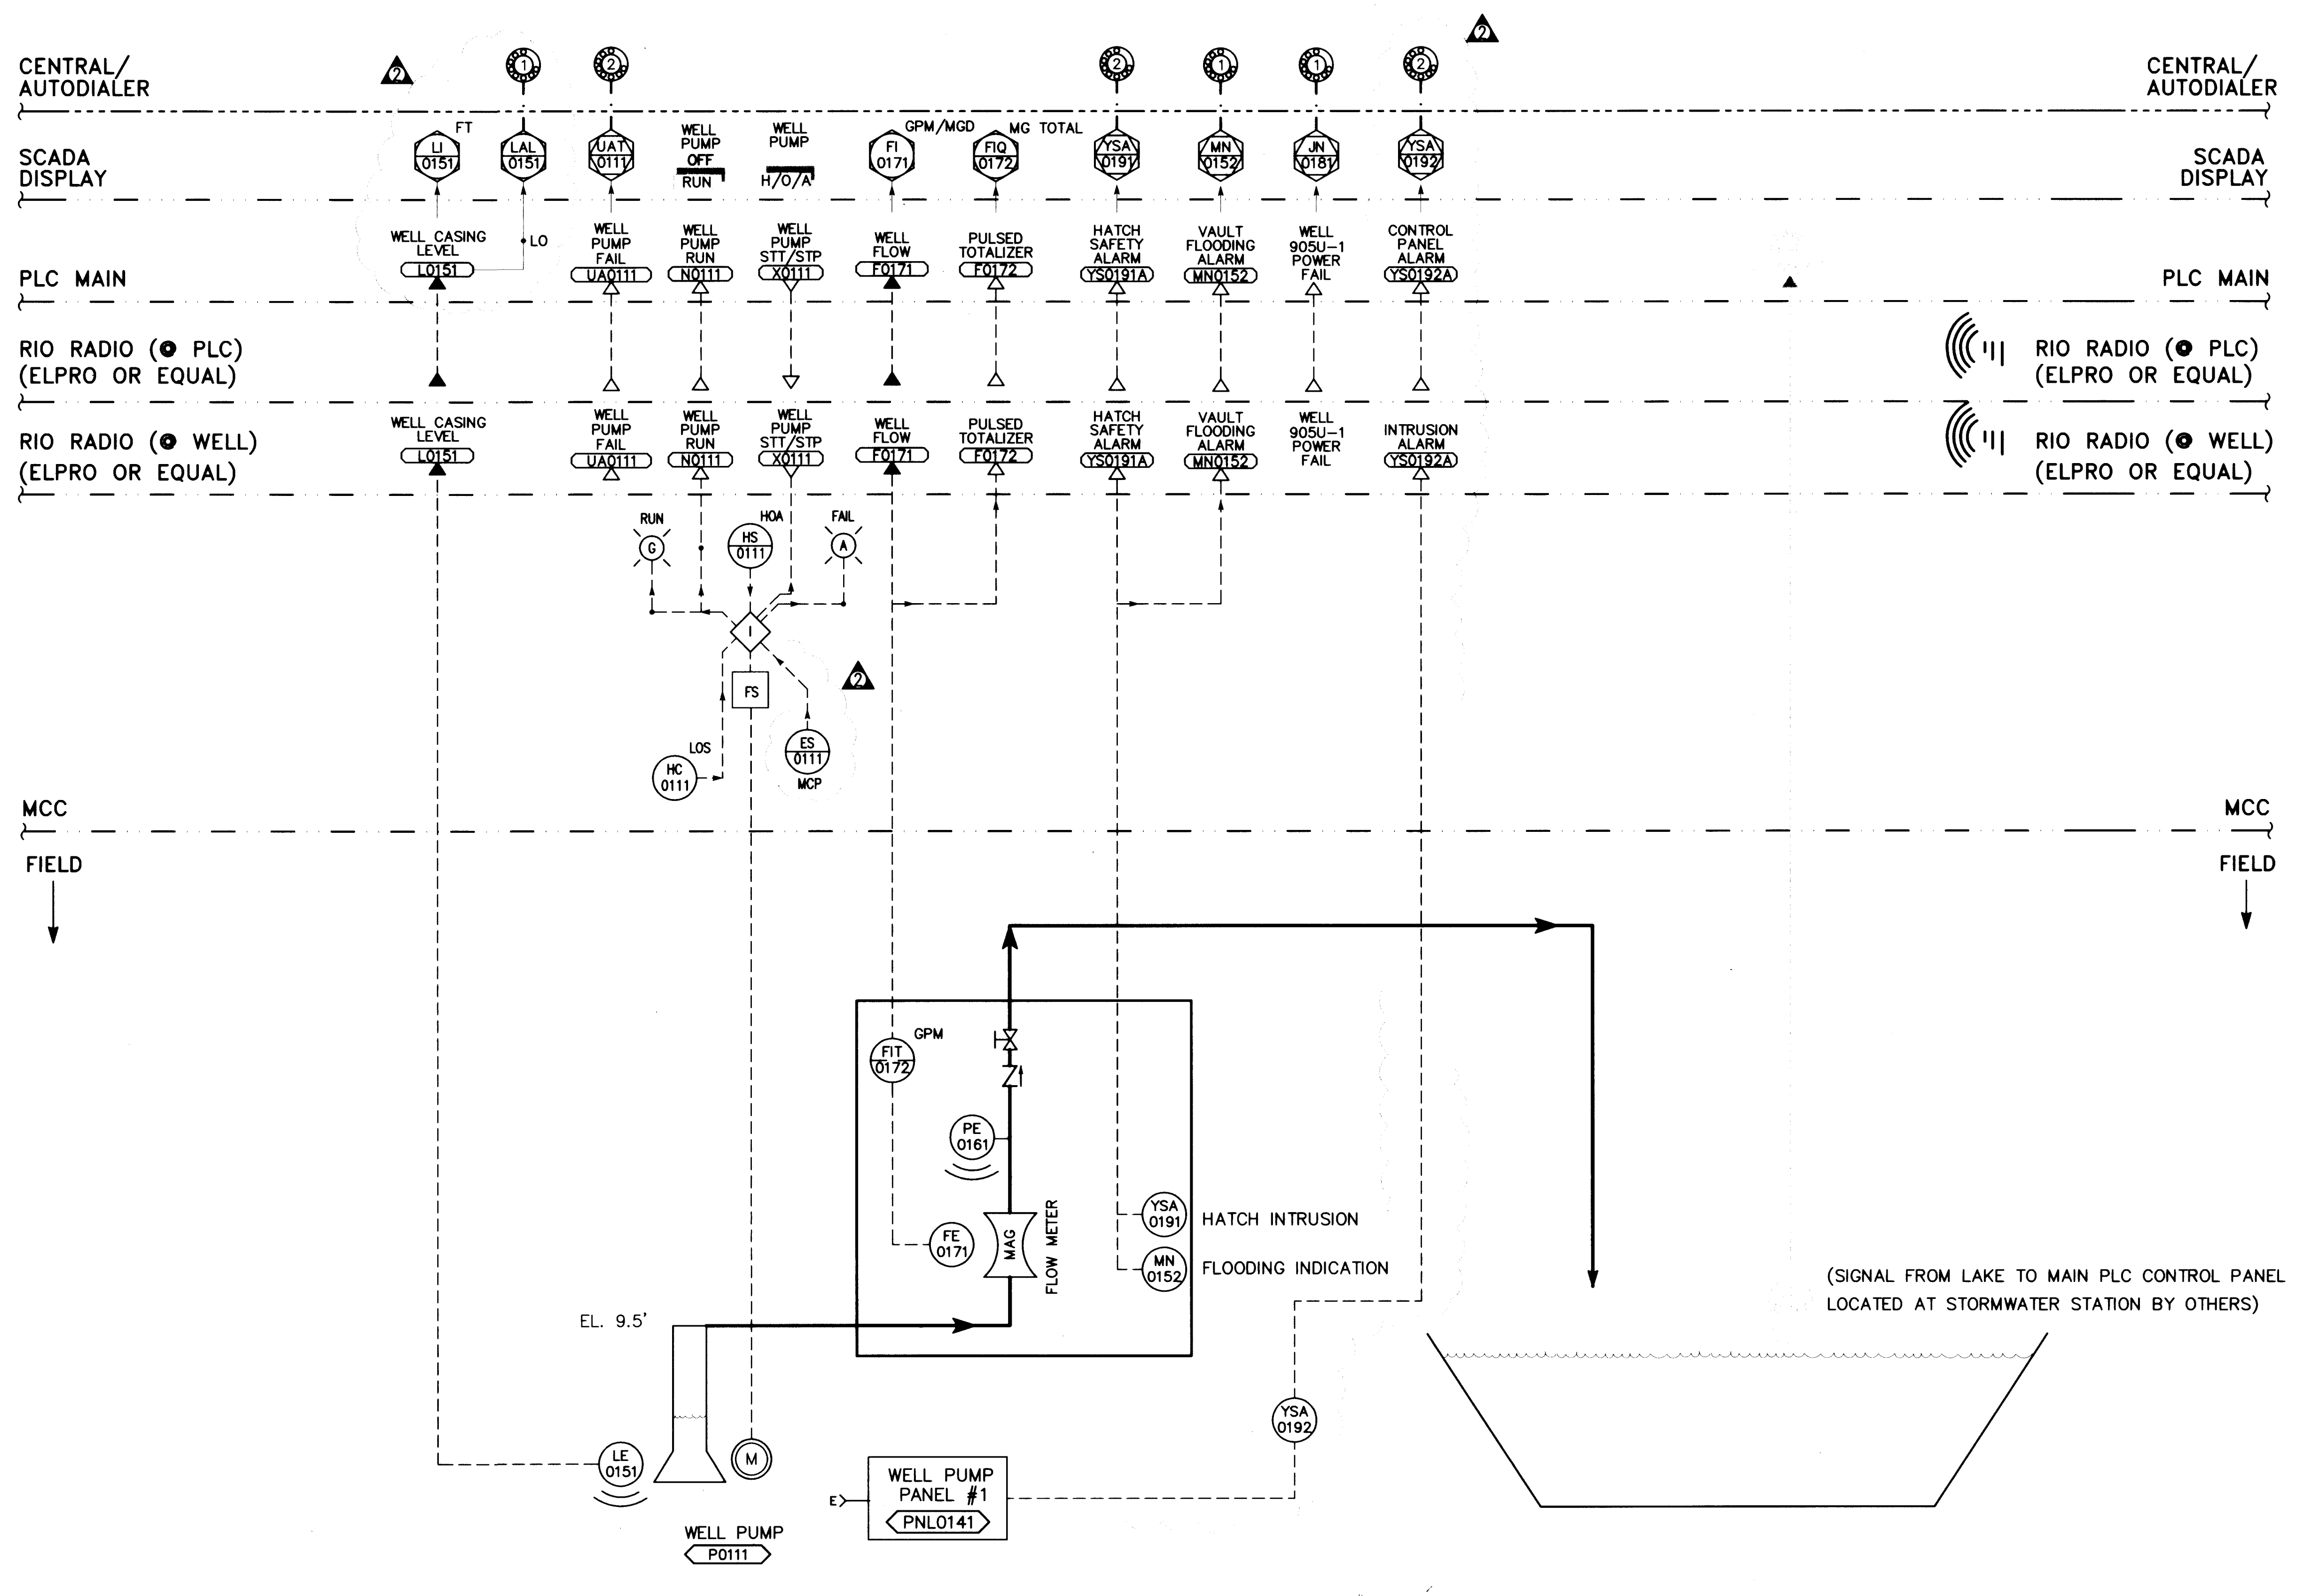

**RECORD DRAWING**

<b>PREPARED BY</b> ANDREW J. KOMOR	<b>PROJECT ENGINEER</b> R.C.E. 6/19/28	<b>SCALE</b> NONE	<b>DATE</b> APR 2005	<b>NO</b> BY DATE	<b>REVISIONS</b>	<b>DATE</b> APP.
<b>EXP.</b> 6/30/07	<b>TAC</b> ATK	<b>DESIGNED</b> ATK	<b>CHECKED</b> ATK	<b>NO</b> BY DATE	<b>REVISIONS</b>	<b>DATE</b> APP.
<b>WELL ELEMENTARY P&amp;ID</b>						
<b>CYPRESS GROVE WELL PUMP STATION</b>						
PACIFIC ADVANCED CIVIL ENGINEERING 17520 NEWHOPE STREET, SUITE 200 PH (714) 481-7300 FAX (714) 481-7299						
SHEET <b>W5</b>						
JOB NO. 8138-E						

THESE DRAWINGS ARE THE PROPERTY OF P.A.C.E. AND SHALL NOT BE REPRODUCED IN ANY MANNER NOR BE USED FOR CONSTRUCTION UNLESS STAMPED "ISSUED FOR CONSTRUCTION".  
 P:\8138\Engineering\8138-80 (WELL PS)\sheet\8138-80-W5.dwg - Tab: Layout1 By: gilliland on May 04, 2005 at 05:35 pm

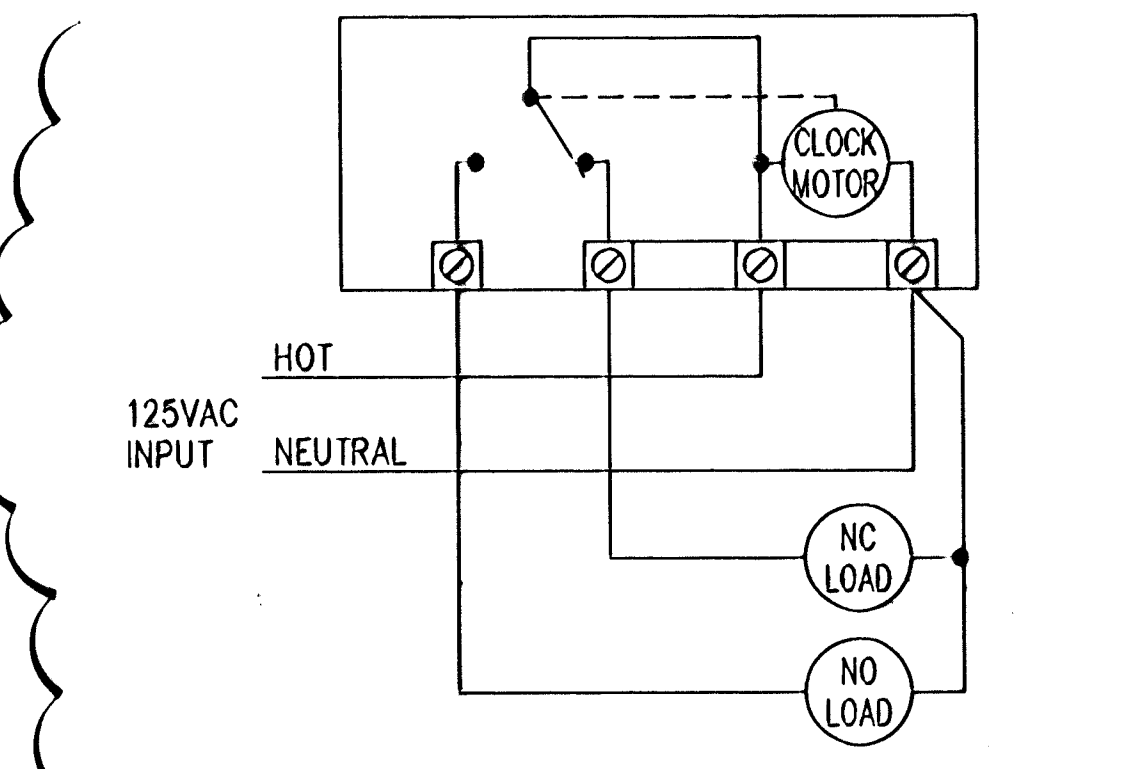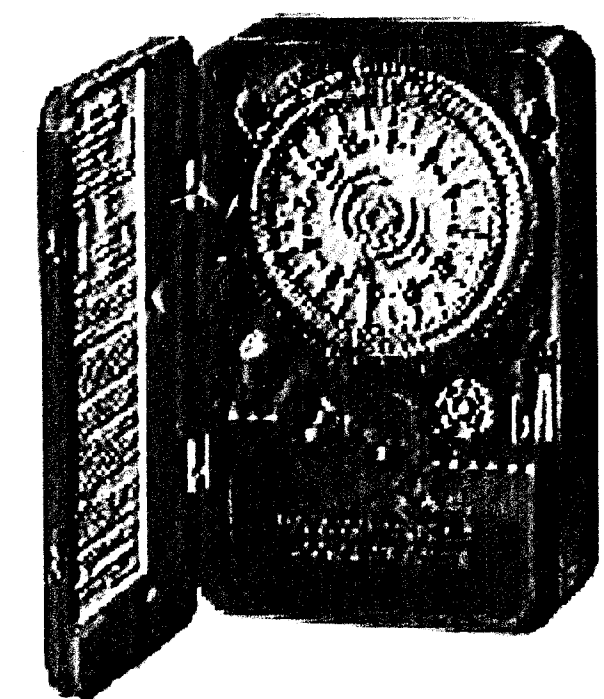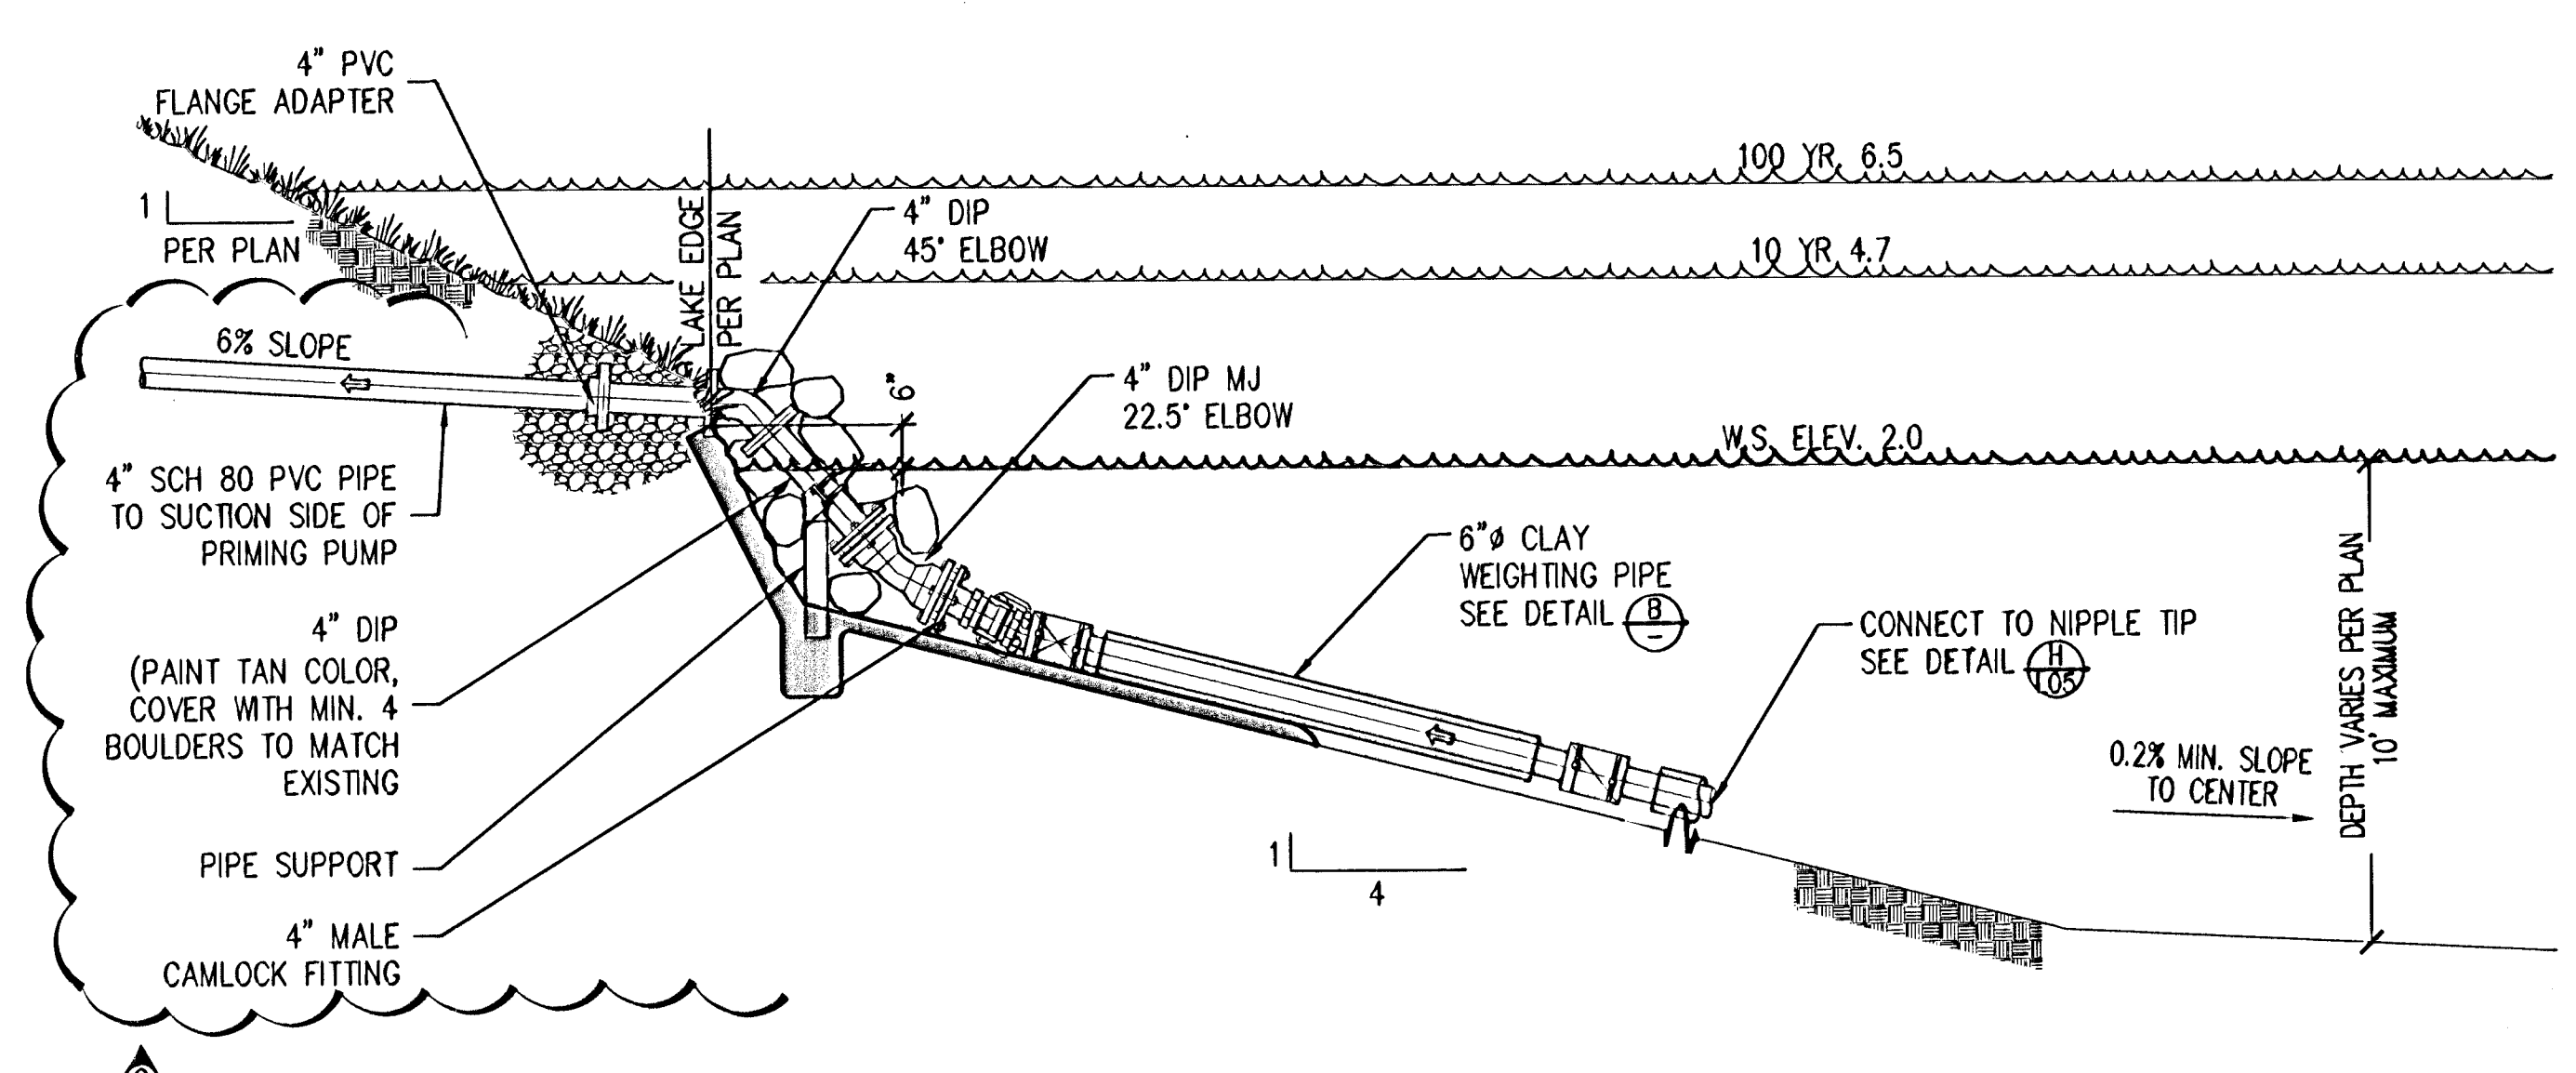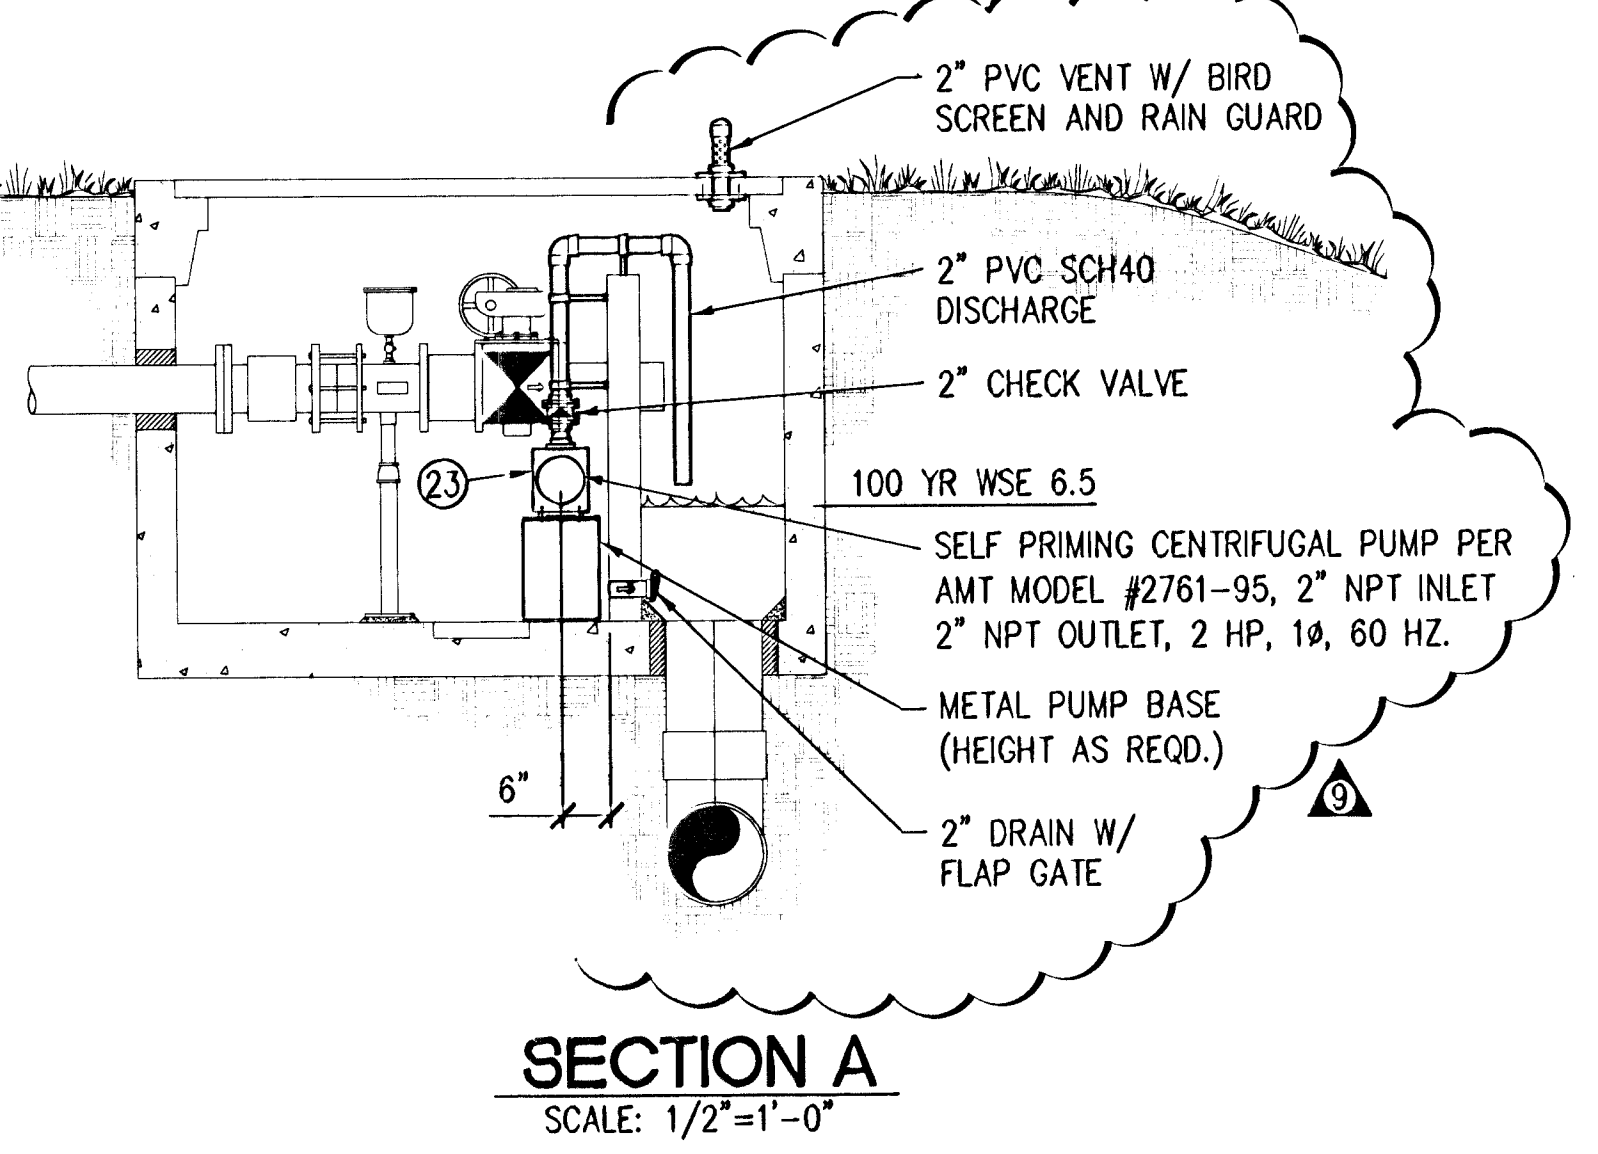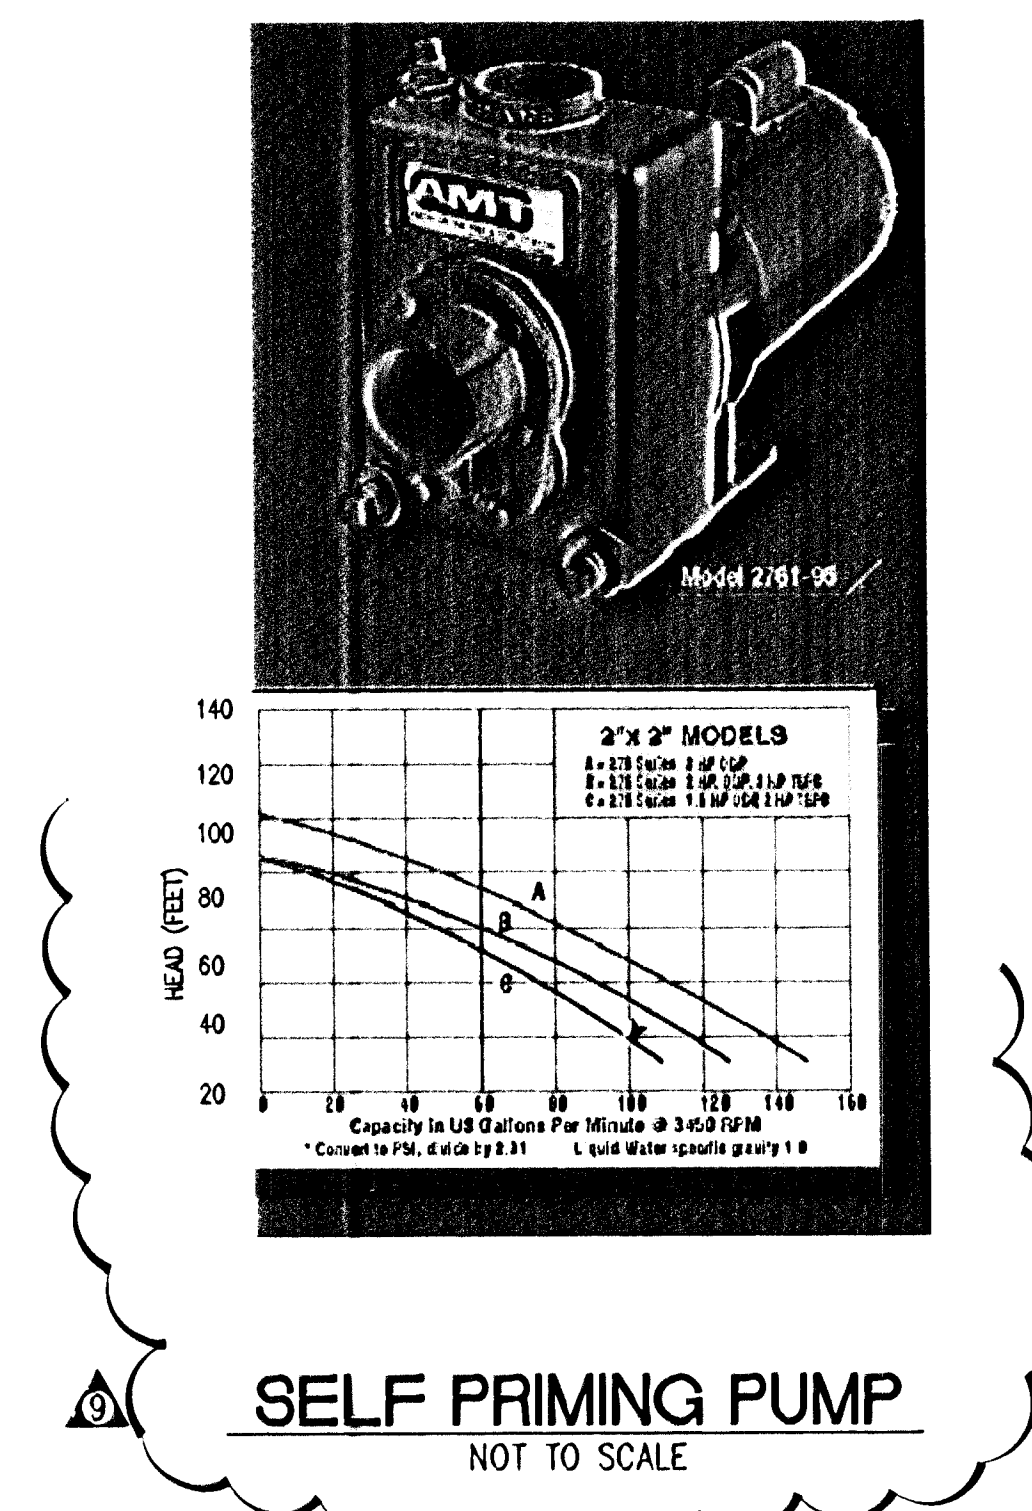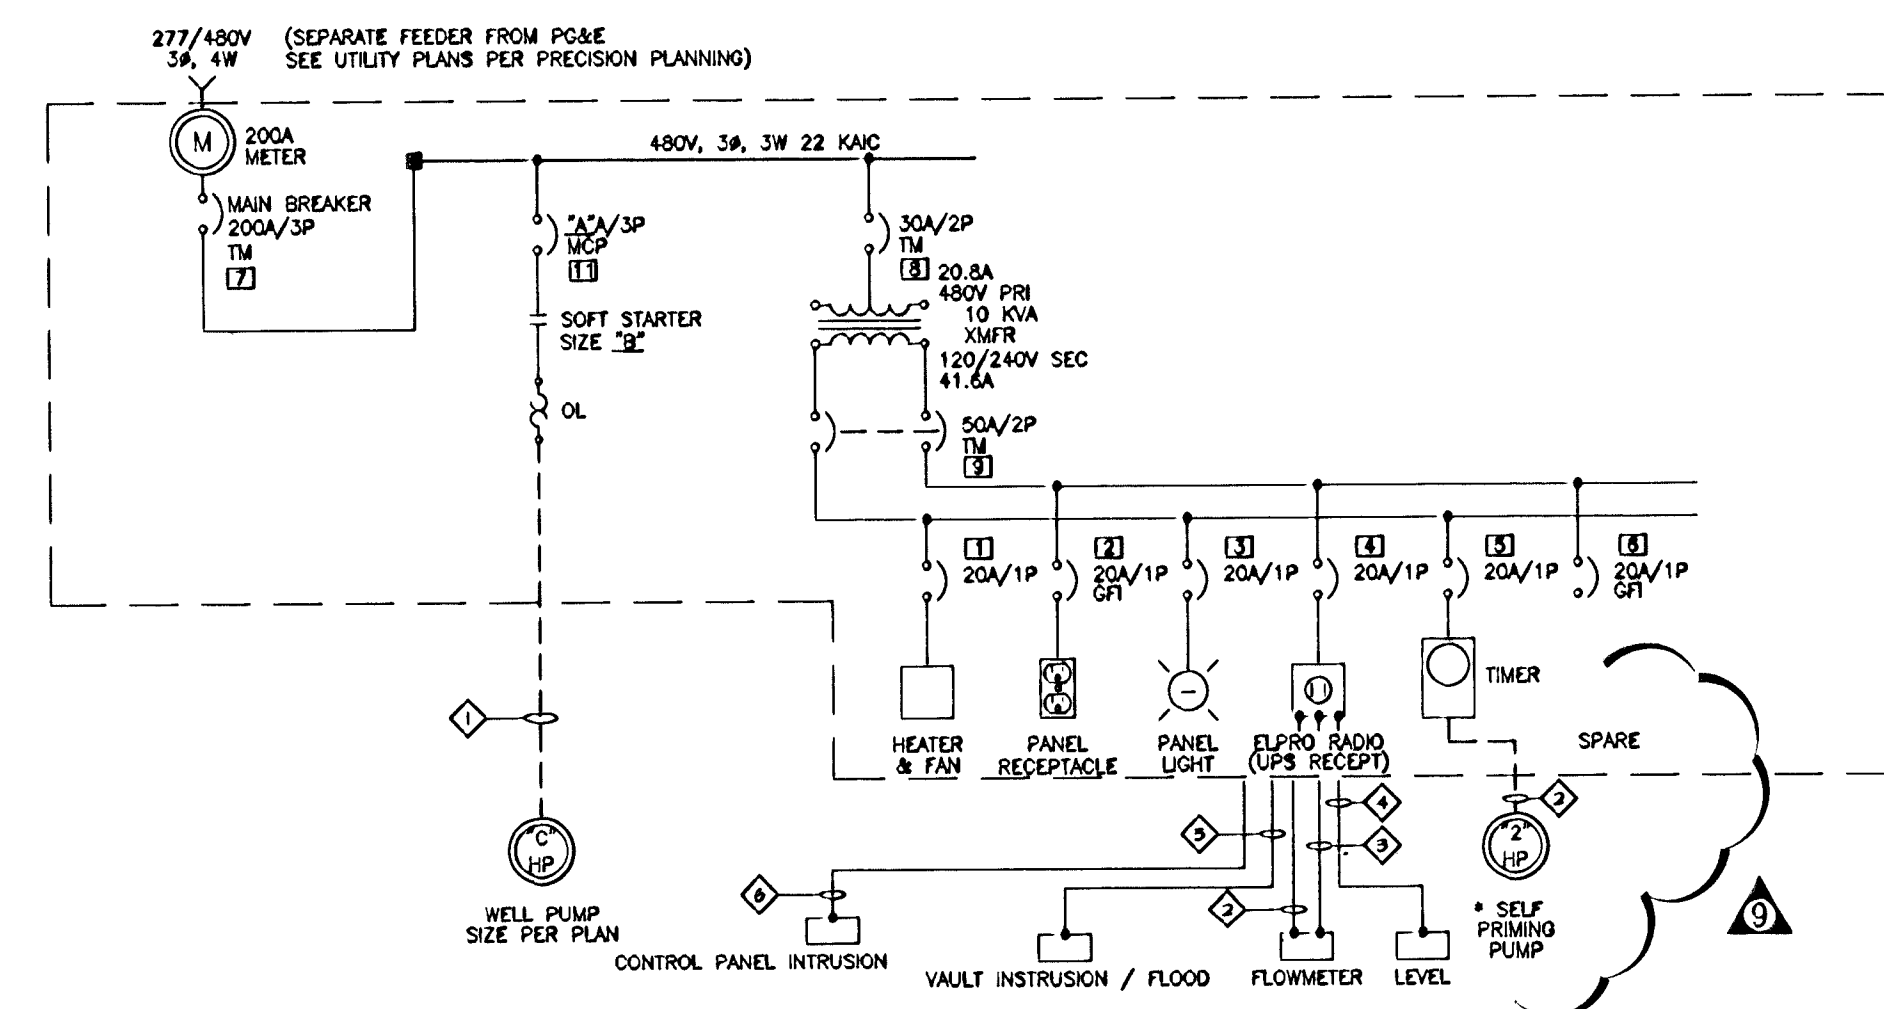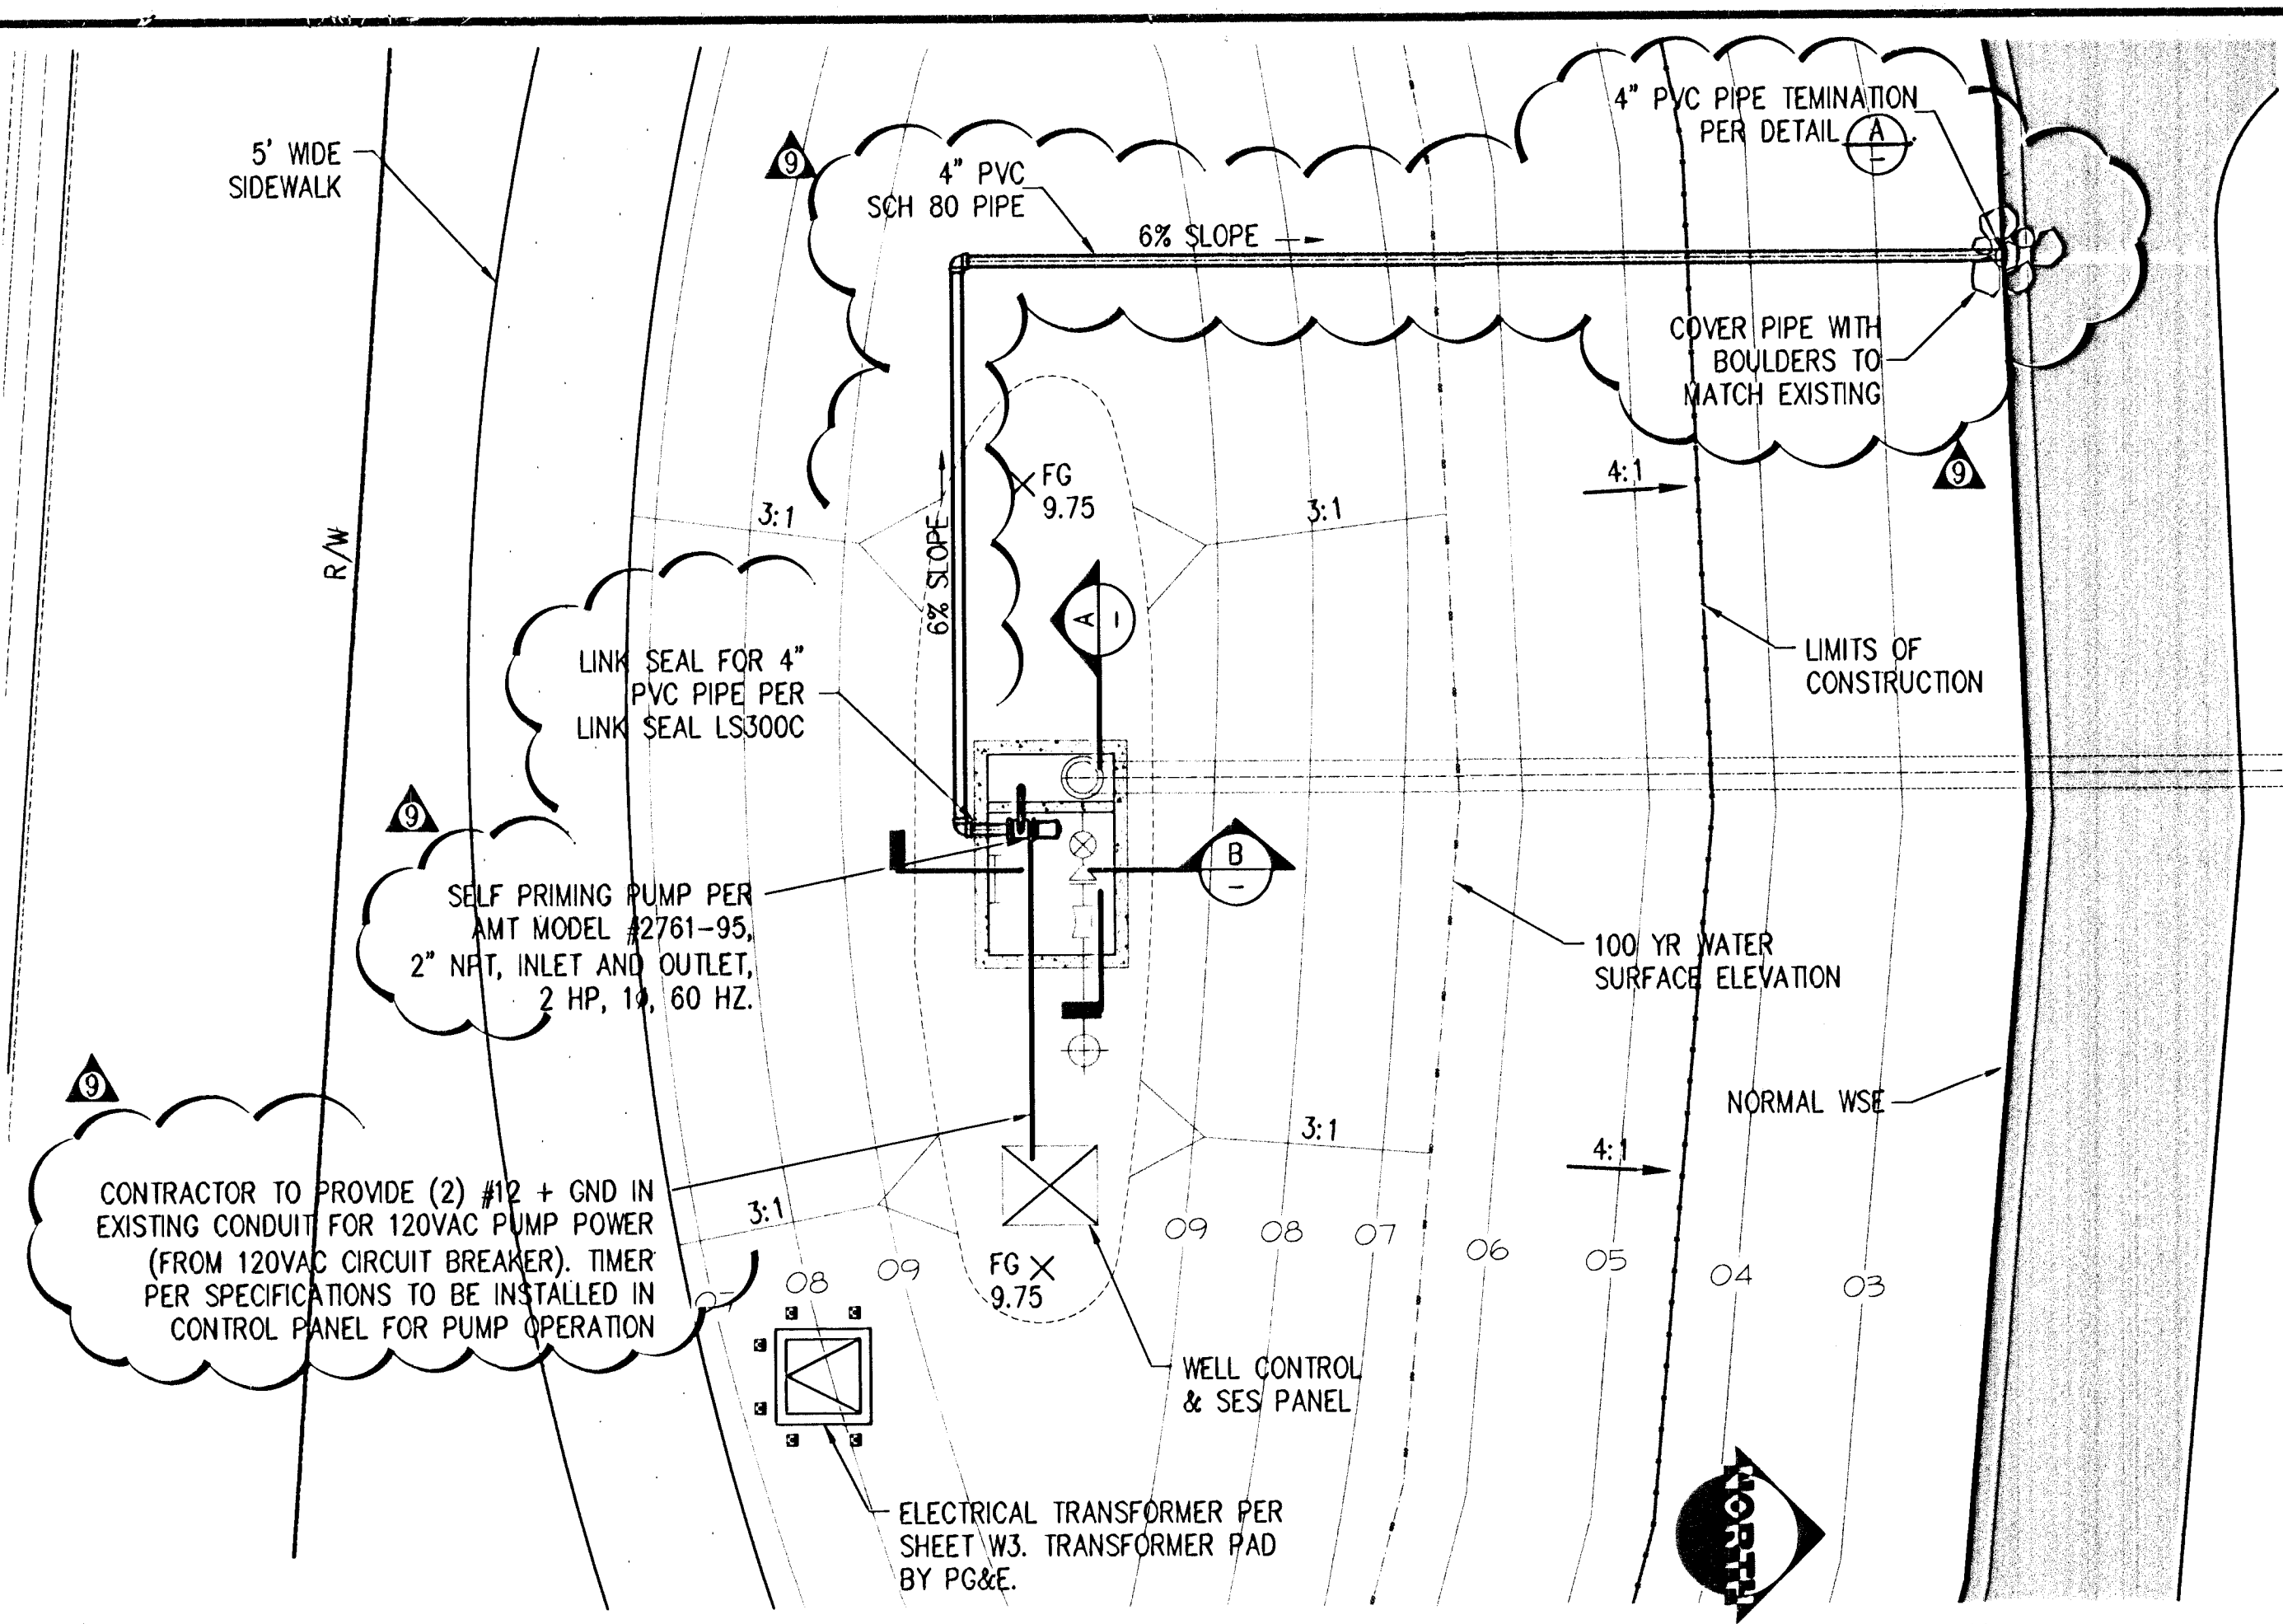


**SEQUENCE OF OPERATION**

THE PRIMING PUMP SHALL BE CONTROLLED BY A 24 HOUR TIMER SET TO TURN ON EVERY 4 HOURS AND SHALL BE ADJUSTABLE PER MAINTENANCE STAFF. THE DURATION OF OPERATION FOR EACH CYCLE SHALL BE 1 HOUR AND SHALL ALSO BE ADJUSTABLE BY MAINTENANCE STAFF. SEE ELECTRICAL DRAWING SHEET W03 FOR DETAILS.


**SELF PRIMING PUMP TIMER**

NOT TO SCALE

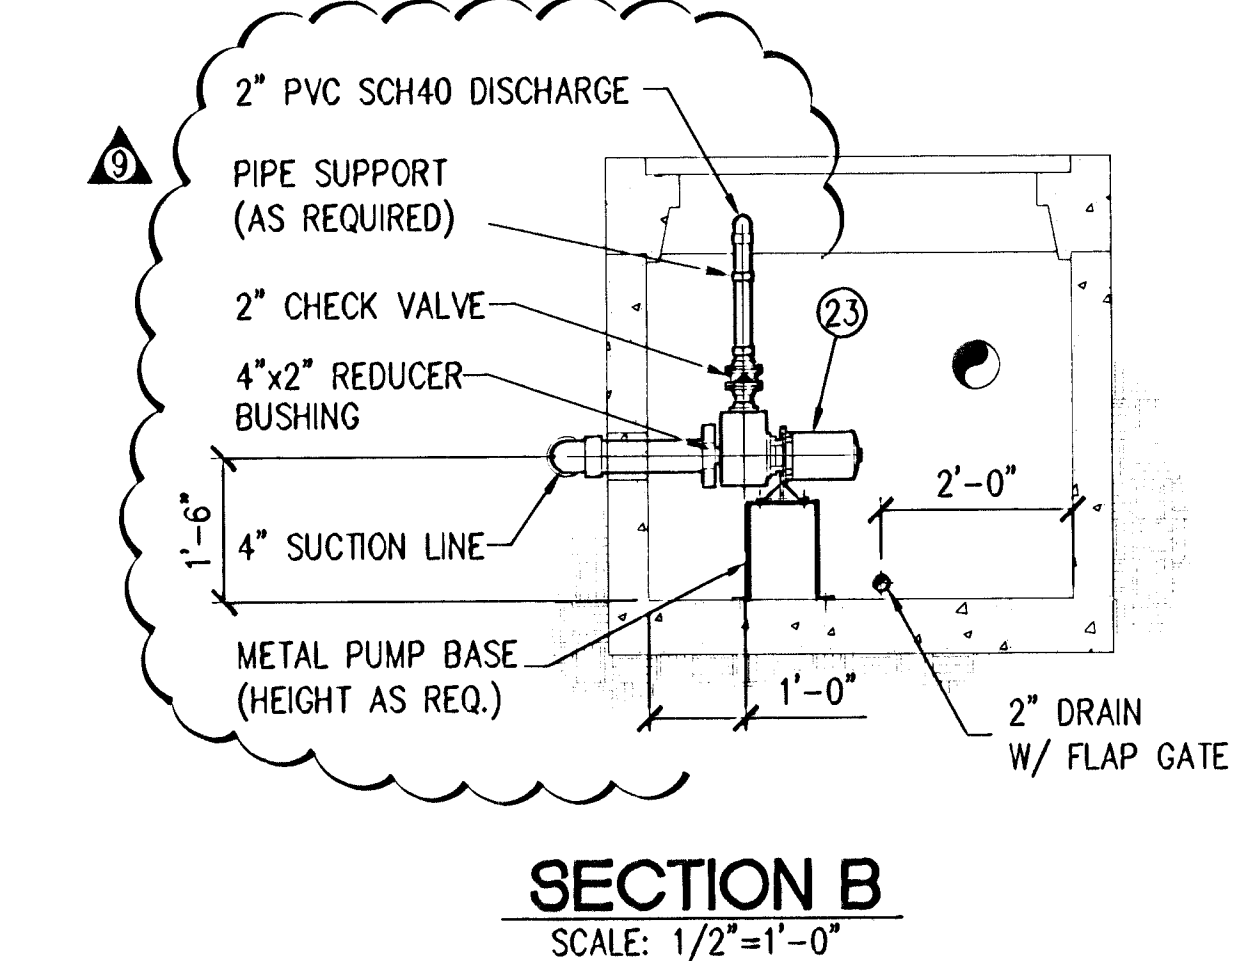

BUOYANCY FOR 17 FEET 4" HOSE:  
 $(3.14/4) \times (4/12)^2 \times 17 \times 62.4 = 76.2\#$   
 BUOYANCY FOR 30 FEET 6" CLAY PIPE:  
 $(3.14/4) \times (6/12)^2 \times 30 \times 62.4 = 367.4\#$   
 TOTAL BUOYANCY = 76.2 + 367.4 = 443.6#

TOTAL WEIGHT OF 4"Ø PVC HOSE = 4.8x17=76.5#  
 TOTAL WEIGHT OF 6"Ø CLAY PIPE = 15.5x30=465.0#  
 TOTAL WEIGHT = 76.5 + 465.0 = 541.5#

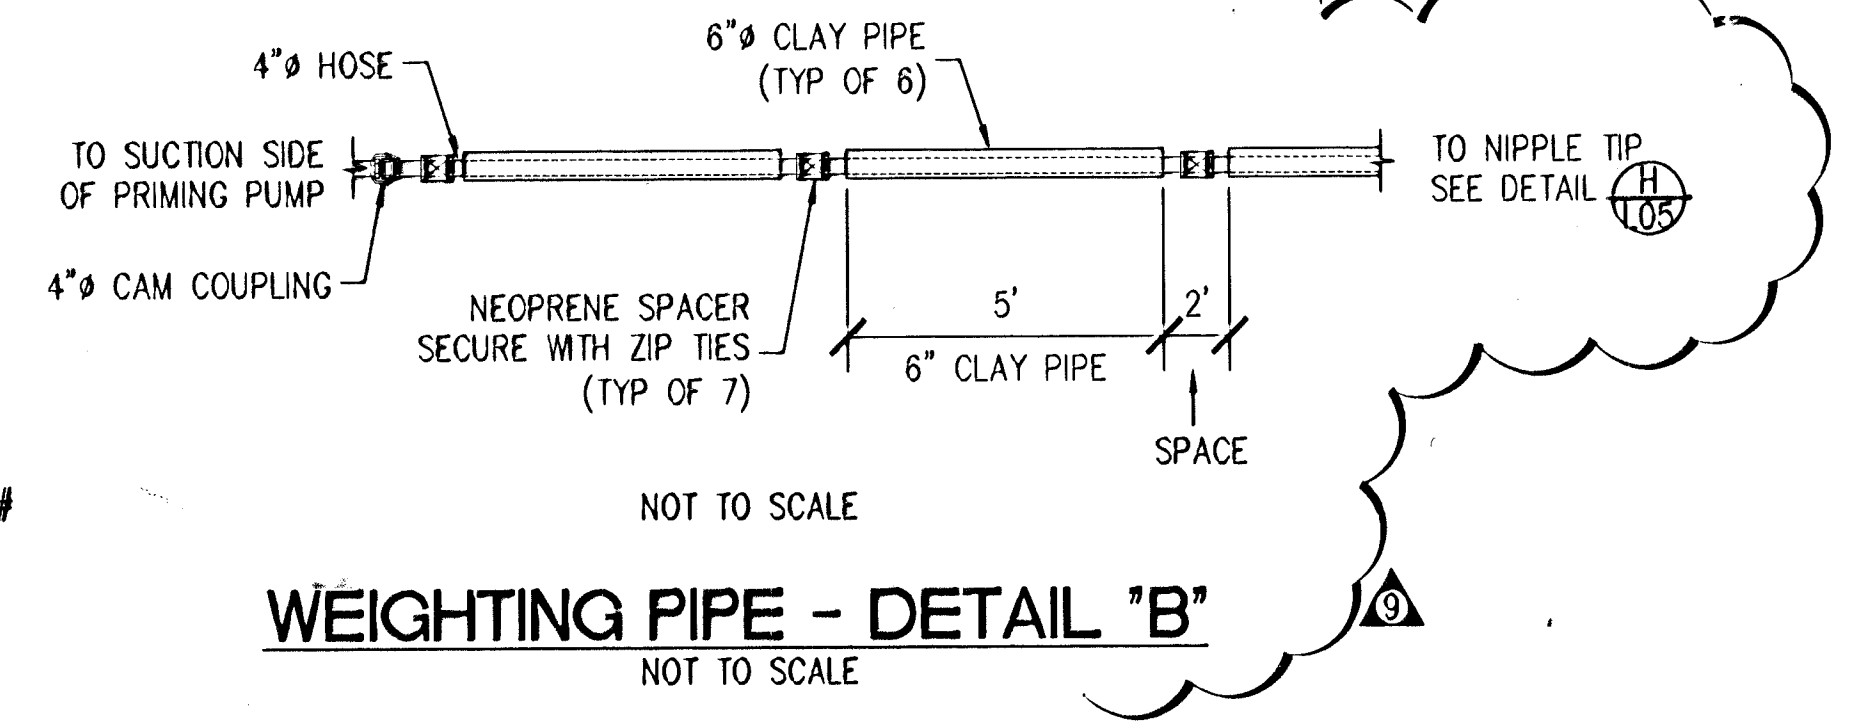

**WEIGHTING PIPE - DETAIL "B"**

NOT TO SCALE

ATK	4/8	PER CITY COMMENTS		DATE	APP.
DC	4/27/05	PER CITY COMMENTS		REVISIONS	
SL	7/19/06	LAKE DEGASSING PS		NO	BY DATE

7-51-06

PREPARED BY: ANDREW T. KOMOR  
 PROJECT ENGINEER: # C 04928  
 DATE: 07/20/07

SCALE: AS SHOWN

DESIGNED BY: ATK  
 CHECKED BY: ATK  
 DATE: APR 2005

LAKE LINER DEGASSING SYSTEM

GYPRESS GROVE WELL PUMP STATION

**PACIFIC ADVANCED CIVIL ENGINEERING**  
 17520 N. MILORE STREET, SUITE 200  
 FOUNTAIN VALLEY, CA 92705  
 PH: (714) 481-7300 FAX: (714) 481-7299

SHEET **W6**

JOB NO. 8138-E

Notes: 8138-00-Title.dwg; 8138-00.dwg; 8138-well-site.dwg; 8117-dwg.dwg  
 Date: 07/20/07; 07/20/07; 07/20/07; 07/20/07  
 Drawn: ATK; Checked: ATK; Date: 07/20/07

THESE DRAWINGS ARE THE PROPERTY OF PACIFIC AND SHALL NOT BE REPRODUCED IN ANY MANNER NOR BE USED FOR CONSTRUCTION UNLESS STAMPED "ISSUED FOR CONSTRUCTION"